



PLANNING & DEVELOPMENT DEPARTMENT

STATEMENT OF FINANCIAL INTEREST

Case Number: VAR-35745 APN: 125-13-801-006
Name of Property Owner: KATHRYN LENHART/DARRELL PARSONS
Name of Applicant: KATHRYN LENHART/DARRELL PARSONS
Name of Representative: CHUCK LENHART

To the best of your knowledge, does the Mayor or any member of the City Council or Planning Commission have any financial interest in this or any other property with the property owner, applicant, the property owner or applicant's general or limited partners, or an officer of their corporation or limited liability company?

_____ Yes

X No

If yes, please indicate the member of the City Council or Planning Commission who is involved and list the name(s) of the person or persons with whom the City Official holds an interest. Also list the Assessor's Parcel Number if the property in which the interest is held is different from the case parcel.

City Official: _____

Partner(s): _____

APN: 125-13-801-006


Signature of Property Owner: Kathryn L. Lenhart Darrell Parsons


Print Name: Kathryn L. Lenhart / Darrell R. Parsons

Subscribed and sworn before me

This 11 day of Aug, 2009

Notary Public in and for said County and State

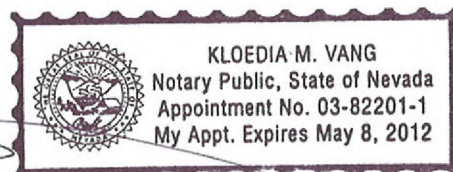

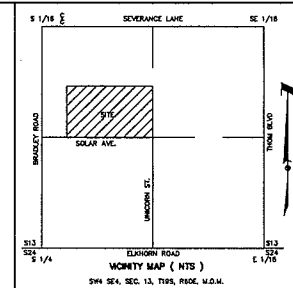[illegible]

Existing Home 2300 Square Feet
Existing Workshop 1375 Square Feet
Tack Room/Barn 680 Square Feet
Hay Barn 680 Square Feet
Chicken Coop 425 Square Feet

ROBERT J. LANGAN
ENGINEERING

3305 Spring Mountain Road - Suite 21
Las Vegas, Nevada 89102
Tel (702) 318-8462 Fax 318-8465

RL

PLOT PLAN	NAME OF PROJECT: D. PARSONS & K. LENHART 5300 SOLAR AVENUE	ASSESSOR PAMELL MAURER
	GOVERNING ENTITY:	

 $1'' = 30'$

ENGINEER'S SEAL

SHEET NO

1

1 of 1 SHEET

CLV DRAWING #

VAR-35745
REVISED
10/08/09 PC


RECEIVED
SEP 21 2009

Larry J. Gendard 6/2/09
 Darrell Parsons 6/3/09

JUN-02-2009 17:54

GOLDEN WEST HOMES

P.005

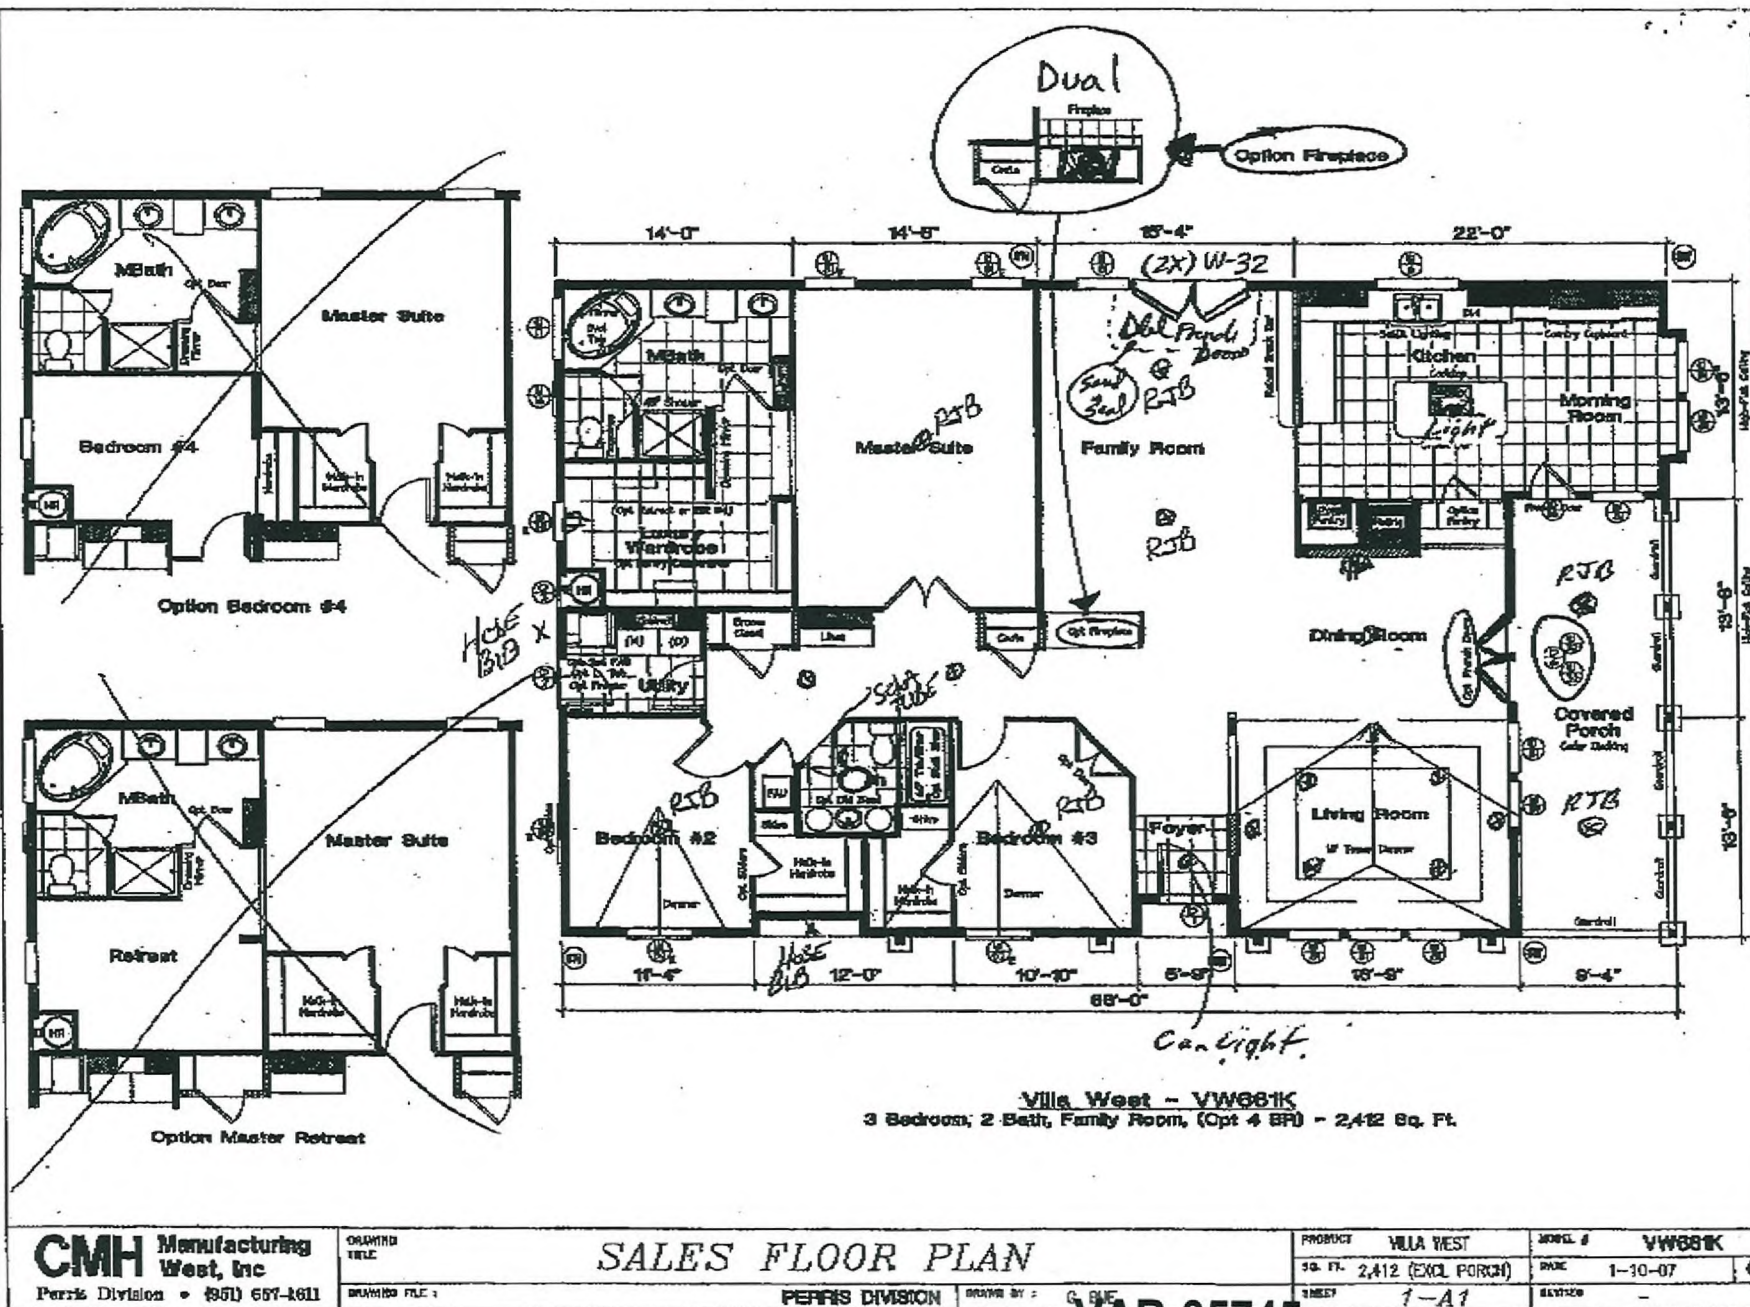

RECEIVED

AUG 25 2009