



PLANNING & DEVELOPMENT DEPARTMENT

STATEMENT OF FINANCIAL INTEREST

Case Number: **SUP-35731** APN: 138-23-201-008

Name of Property Owner: _____

Name of Applicant: Ivan Trujillo

Name of Representative: Law Offices of Jay Brown

To the best of your knowledge, does the Mayor or any member of the City Council or Planning Commission have any financial interest in this or any other property with the property owner, applicant, the property owner or applicant's general or limited partners, or an officer of their corporation or limited liability company?

☐ Yes

☒ No

If yes, please indicate the member of the City Council or Planning Commission who is involved and list the name(s) of the person or persons with whom the City Official holds an interest. Also list the Assessor's Parcel Number if the property in which the interest is held is different from the case parcel.

City Official: _____

Partner(s): _____

APN: _____


Signature of Property Owner: *Victor Martinez* **MANAGER MEMBER**

Print Name: Victor Martinez



Subscribed and sworn before me

This 3 day of march, 20 08

Kathryn L. Davis
Notary Public in and for said County and State

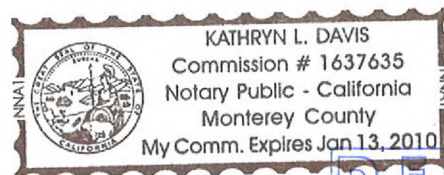

LA LUPITA - SUP FOR OFF-SALE BEER & WINE

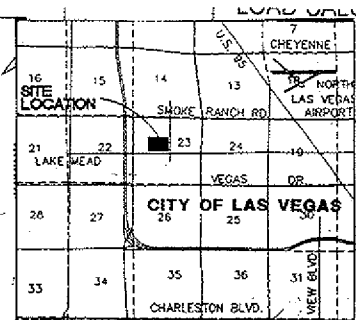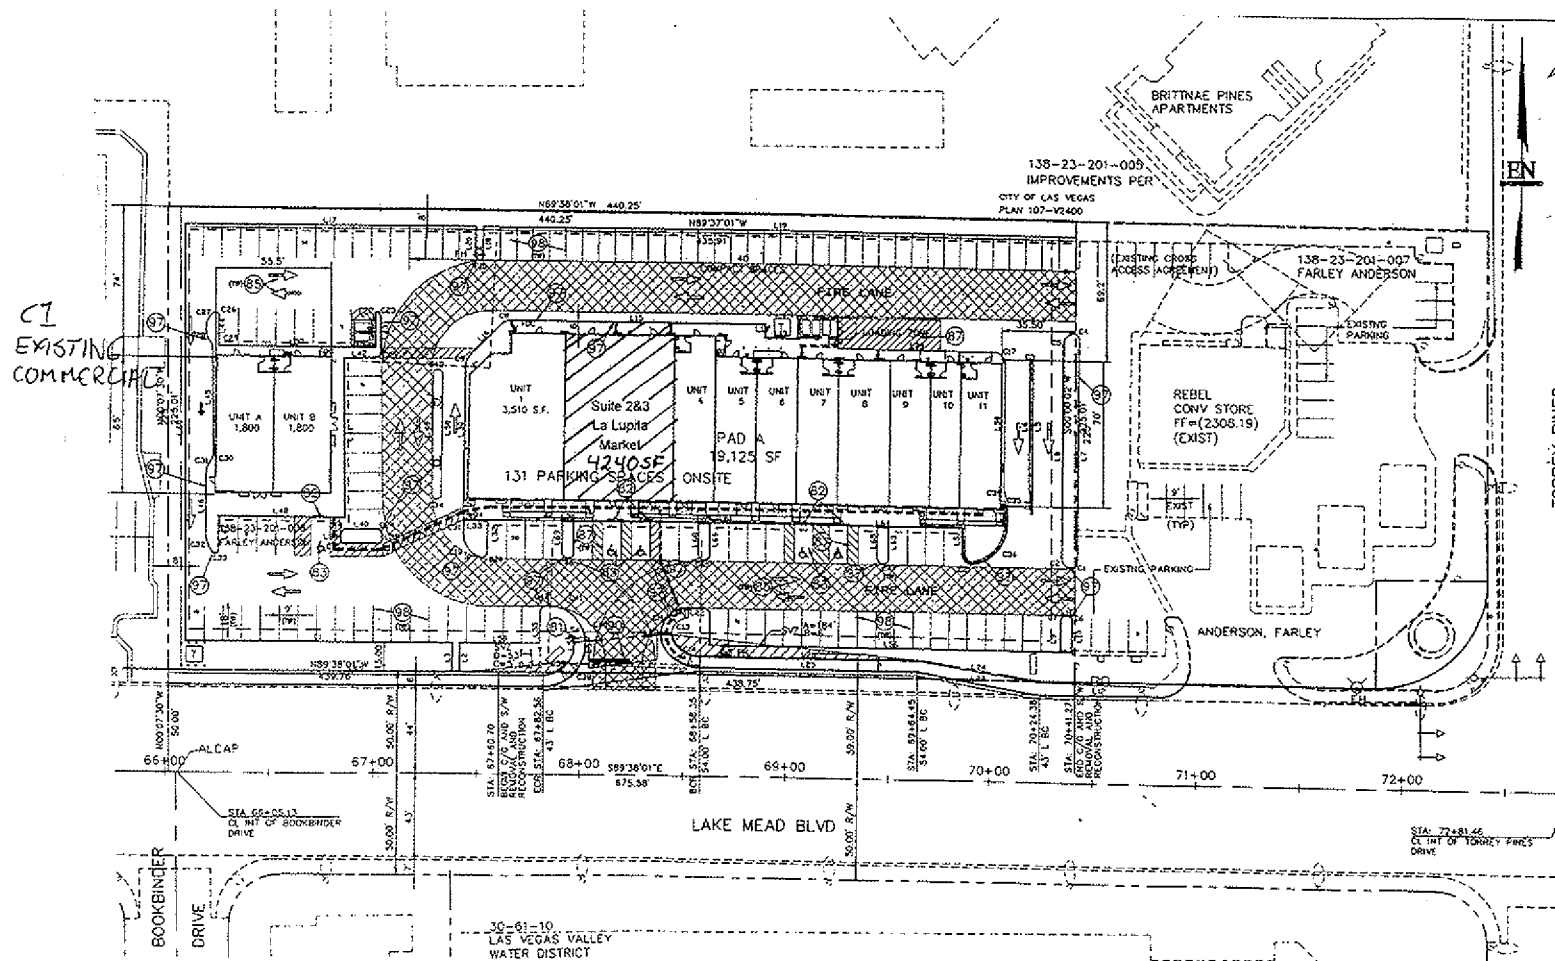

SITE DATA

ZONE: C1

PARCEL: 138-23-201-009

ADDRESS: 6430


WEST LAKE MEAD #115
LAS VEGAS, NV,

PARKING ANALYSIS

REQUIRED: 1 SPACE PER
250 SF

= 91 SPACES

PROVIDED: 130 SPACES

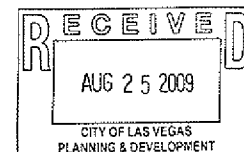

SUP-35731
10/08/09 PC

