



PLANNING & DEVELOPMENT DEPARTMENT

STATEMENT OF FINANCIAL INTEREST

Case Number: **GPA-35866** APN: 138-03-201-009

Name of Property Owner: CT-1, LLC

Name of Applicant: CT-1, LLC

Name of Representative: Warren Hardy

To the best of your knowledge, does the Mayor or any member of the City Council or Planning Commission have any financial interest in this or any other property with the property owner, applicant, the property owner or applicant's general or limited partners, or an officer of their corporation or limited liability company?

☐ Yes

☒ No

If yes, please indicate the member of the City Council or Planning Commission who is involved and list the name(s) of the person or persons with whom the City Official holds an interest. Also list the Assessor's Parcel Number if the property in which the interest is held is different from the case parcel.

City Official: _____

Partner(s): _____

APN: _____


Signature of Property Owner: *Bradley Shults*

Print Name: Bradley Shults


Subscribed and sworn before me

This 21 day of August, 2009

Notary Public in and for said County and State

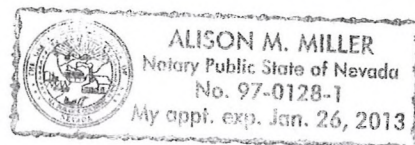

GENERAL PLAN AMENDMENT

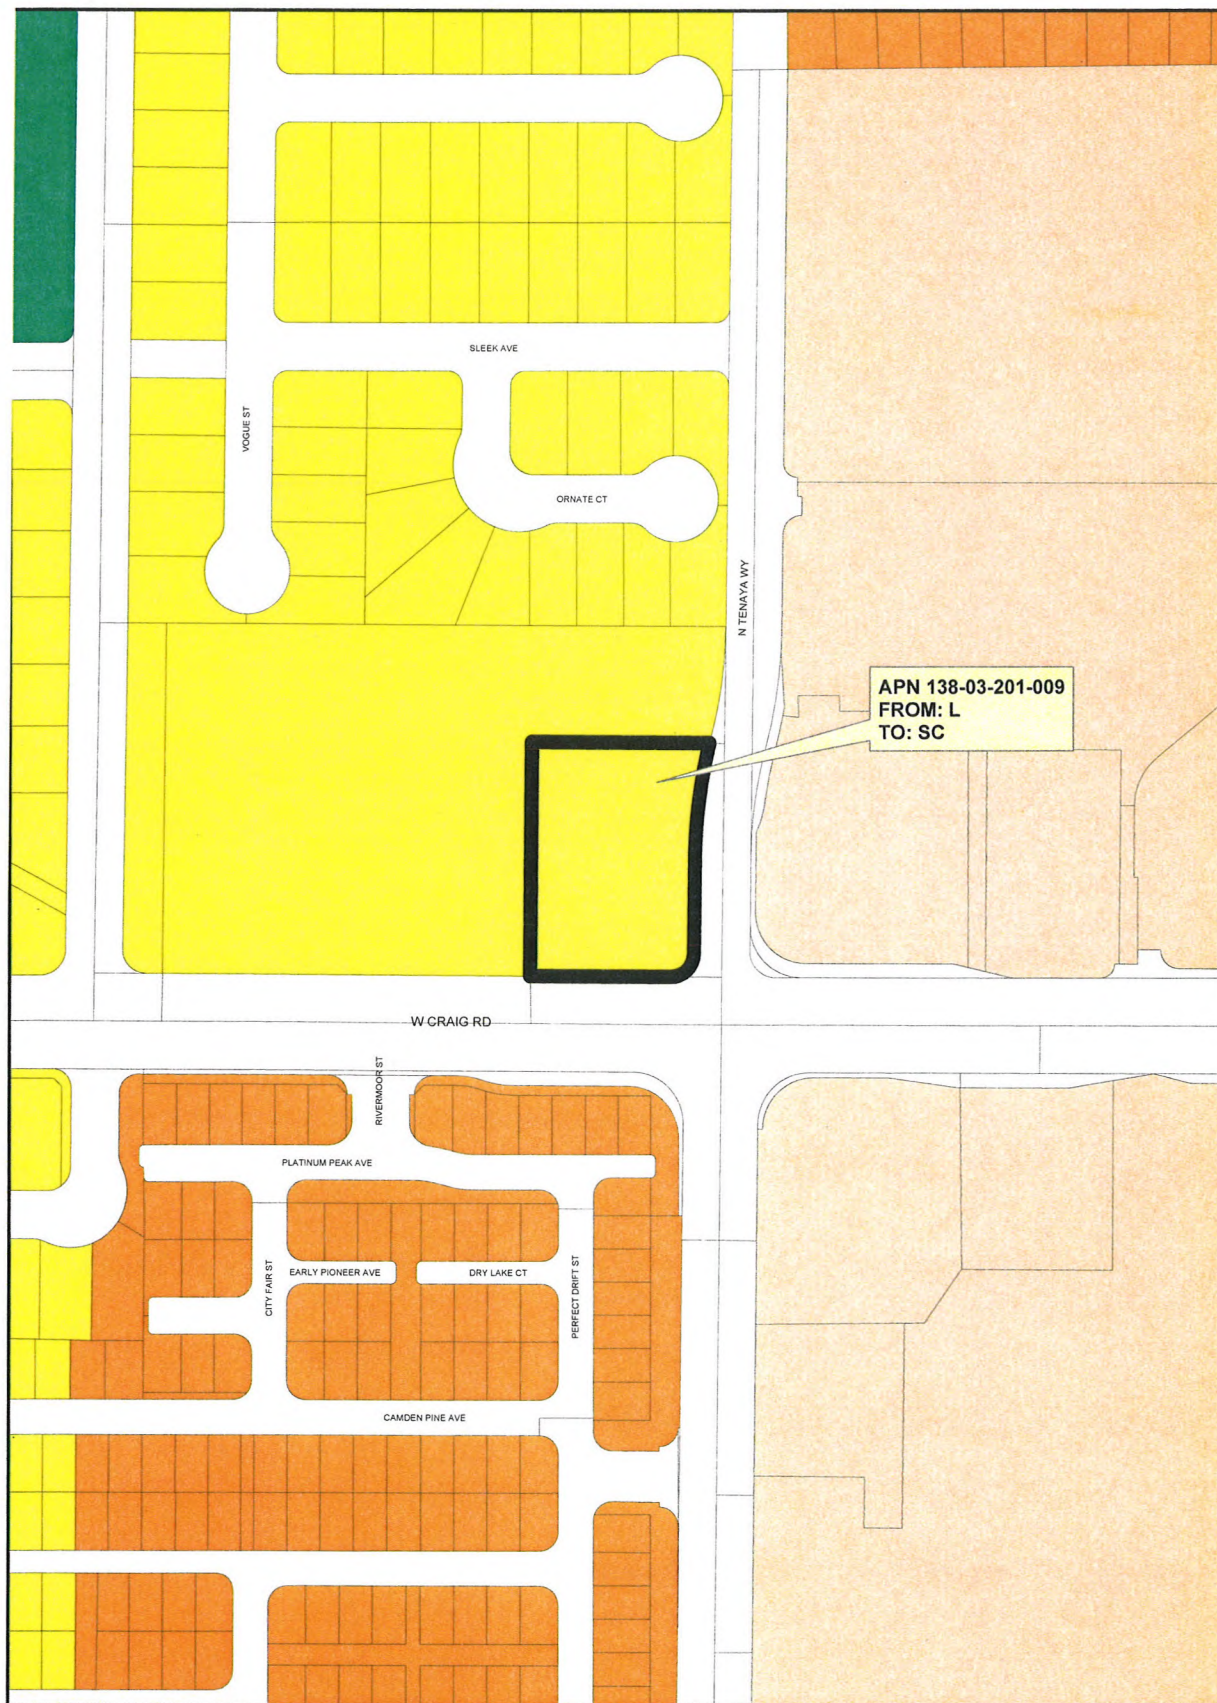

APN 138-03-201-009
FROM: L
TO: SC

	Rural Neighborhood Preservation		Medium		Light Industrial / Research		Town Center
	Rural Estates		High		Planned Community Development		Resource Conservation
	Desert Rural		Office		Downtown Redevelopment Area		Downtown - Commercial
	Rural		Service Commercial		Park / Recreation / Open Space		Downtown - Mixed Use
	Low		General Commercial		Public Facility		Not in City
	Medium - Low		Tourist Commercial		Public Facility - School		Right-of-Way
	Medium - Low Attached		Las Vegas Medical District		Public Facility - Clark County		

REVISED

GPA-35866
10/22/09 PC

Data Current as of: September 17, 2009



GIS maps are normally produced only to assist the staff of the City. Due to continuous development activity, this map is for reference only. Geographic Information System Planning & Development Dept. 702-225-6301

