



PLANNING & DEVELOPMENT DEPARTMENT

STATEMENT OF FINANCIAL INTEREST

Case Number: **GPA-35866** APN: 138-03-201-009

Name of Property Owner: CT-1, LLC

Name of Applicant: CT-1, LLC

Name of Representative: Warren Hardy

To the best of your knowledge, does the Mayor or any member of the City Council or Planning Commission have any financial interest in this or any other property with the property owner, applicant, the property owner or applicant's general or limited partners, or an officer of their corporation or limited liability company?

☐ Yes

☒ No

If yes, please indicate the member of the City Council or Planning Commission who is involved and list the name(s) of the person or persons with whom the City Official holds an interest. Also list the Assessor's Parcel Number if the property in which the interest is held is different from the case parcel.

City Official: _____

Partner(s): _____

APN: _____


Signature of Property Owner: *Bradley Shults*

Print Name: Bradley Shults


Subscribed and sworn before me

This 21 day of August, 2009

Notary Public in and for said County and State

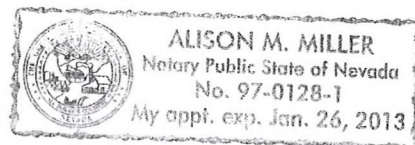

GENERAL PLAN AMENDMENT

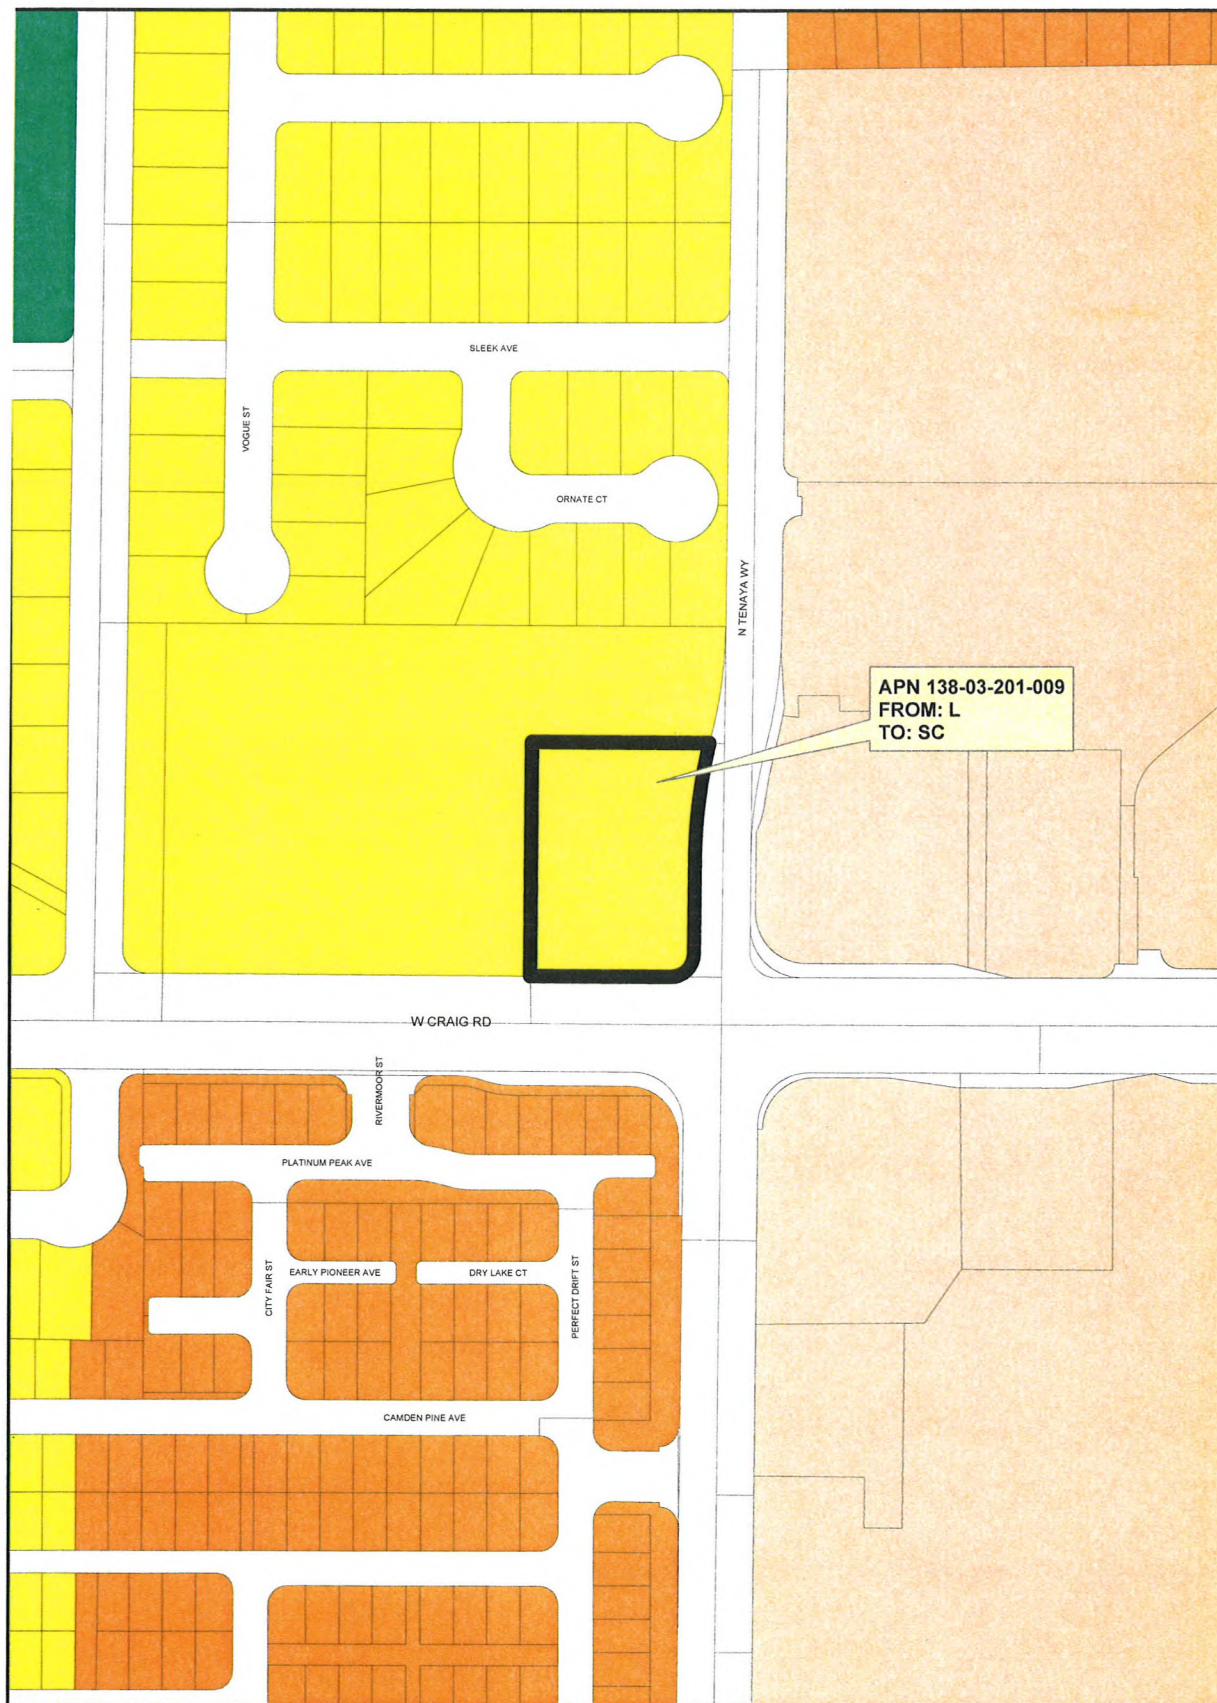

Rural Neighborhood Preservation
 Rural Estates
 Desert Rural
 Rural
 Low
 Medium - Low
 Medium - Low Attached

Medium
 High
 Office
 Service Commercial
 General Commercial
 Tourist Commercial
 Las Vegas Medical District

Light Industrial / Research
 Planned Community Development
 Downtown Redevelopment Area
 Park / Recreation / Open Space
 Public Facility
 Public Facility - School
 Public Facility - Clark County

Town Center
 Resource Conservation
 Downtown - Commercial
 Downtown - Mixed Use
 Not in City
 Right-of-Way

REVISED

GPA-35866
10/22/09 PC

Data Current as of: September 17, 2009



GIS maps are normally produced only to meet the needs of the City. Due to continuous development activity, this map is for reference only. Geographic Information System Planning & Development Dept. 702-225-6301

