



PLANNING & DEVELOPMENT DEPARTMENT

STATEMENT OF FINANCIAL INTEREST

Case Number: **VAR-35857** APN: 139-25-601-004
Name of Property Owner: Wetherbee Properties LLC
Name of Applicant: Fidencio Garcia
Name of Representative: Patricia Beyer

To the best of your knowledge, does the Mayor or any member of the City Council or Planning Commission have any financial interest in this or any other property with the property owner, applicant, the property owner or applicant's general or limited partners, or an officer of their corporation or limited liability company?

_____ Yes


_____ X No

If yes, please indicate the member of the City Council or Planning Commission who is involved and list the name(s) of the person or persons with whom the City Official holds an interest. Also list the Assessor's Parcel Number if the property in which the interest is held is different from the case parcel.

City Official: _____


Partner(s): _____


APN: _____

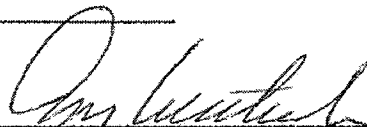Signature of Property Owner: 

Print Name: ANTHONY WETHERBEE


Subscribed and sworn before me

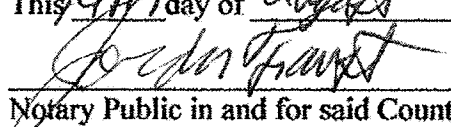This 4th day of August, 2009

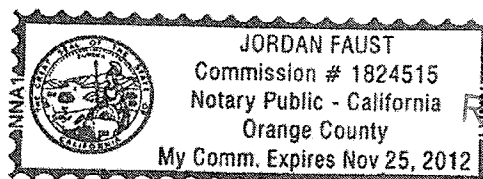Notary Public in and for said County and State



RECEIVED

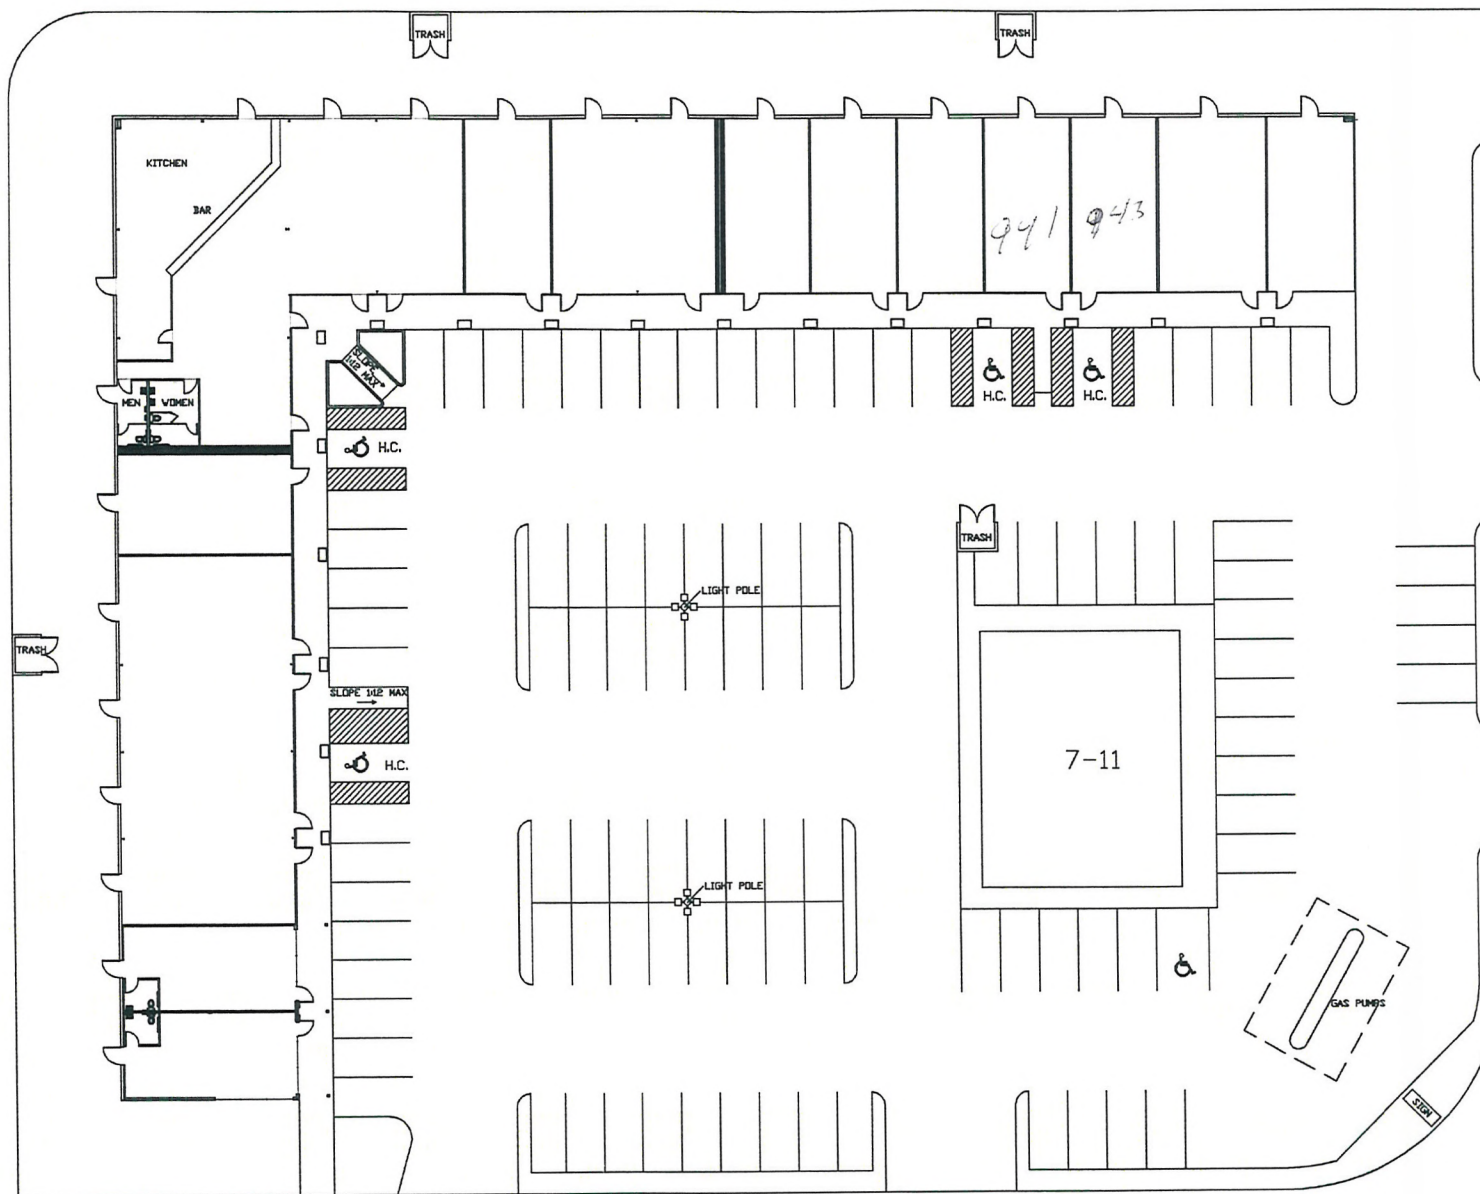Agosto 3-14



WASHINGTON AVENUE

VAR-35857

10/22/09 PC


Fax: (702) 388-0004
ph: (702) 388-0002

DAVID McKee
architect
AIA/ NCARB

RECEIVED



SEP 02 2009



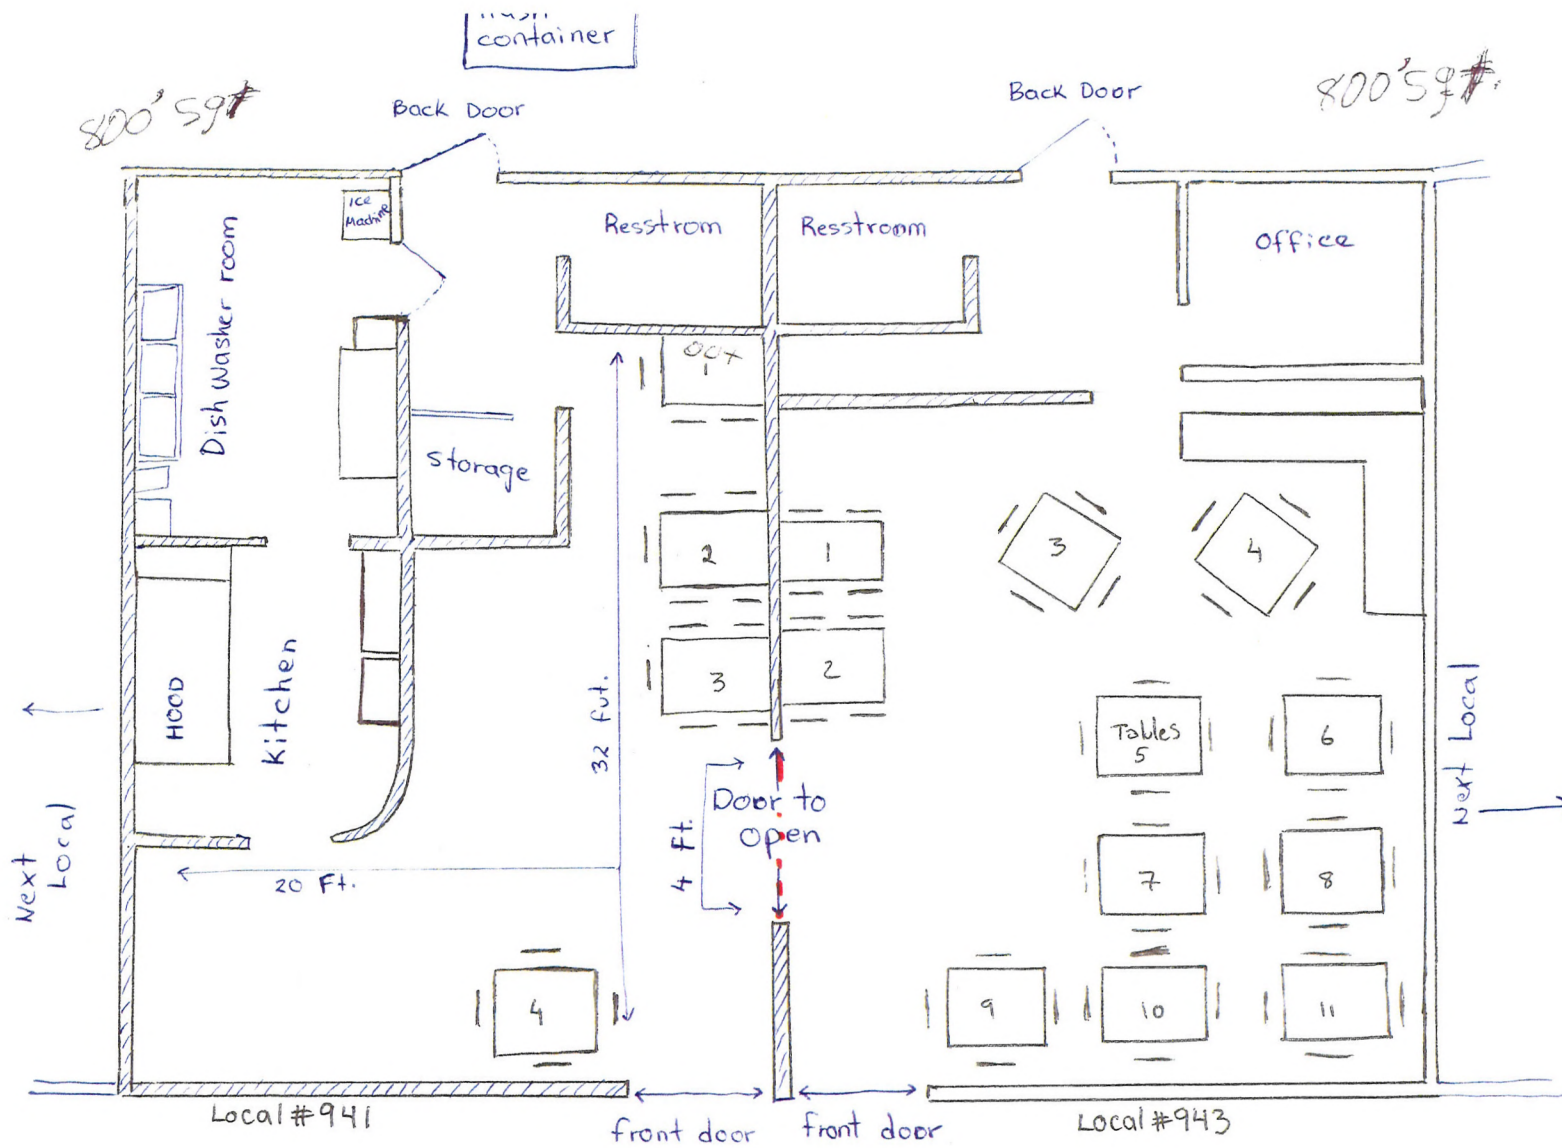

RECEIVED
SEP 02 2009


VAR-35857
10/22/09 PC

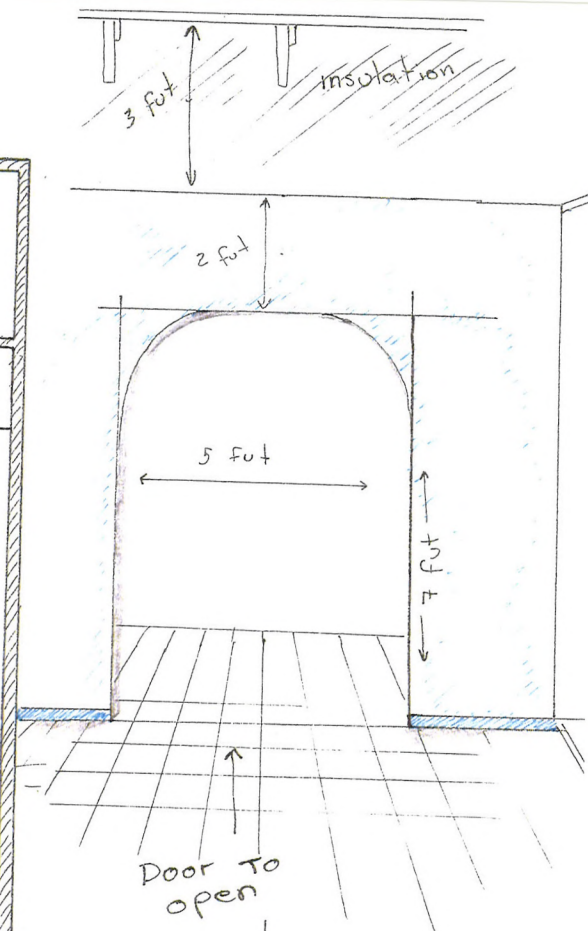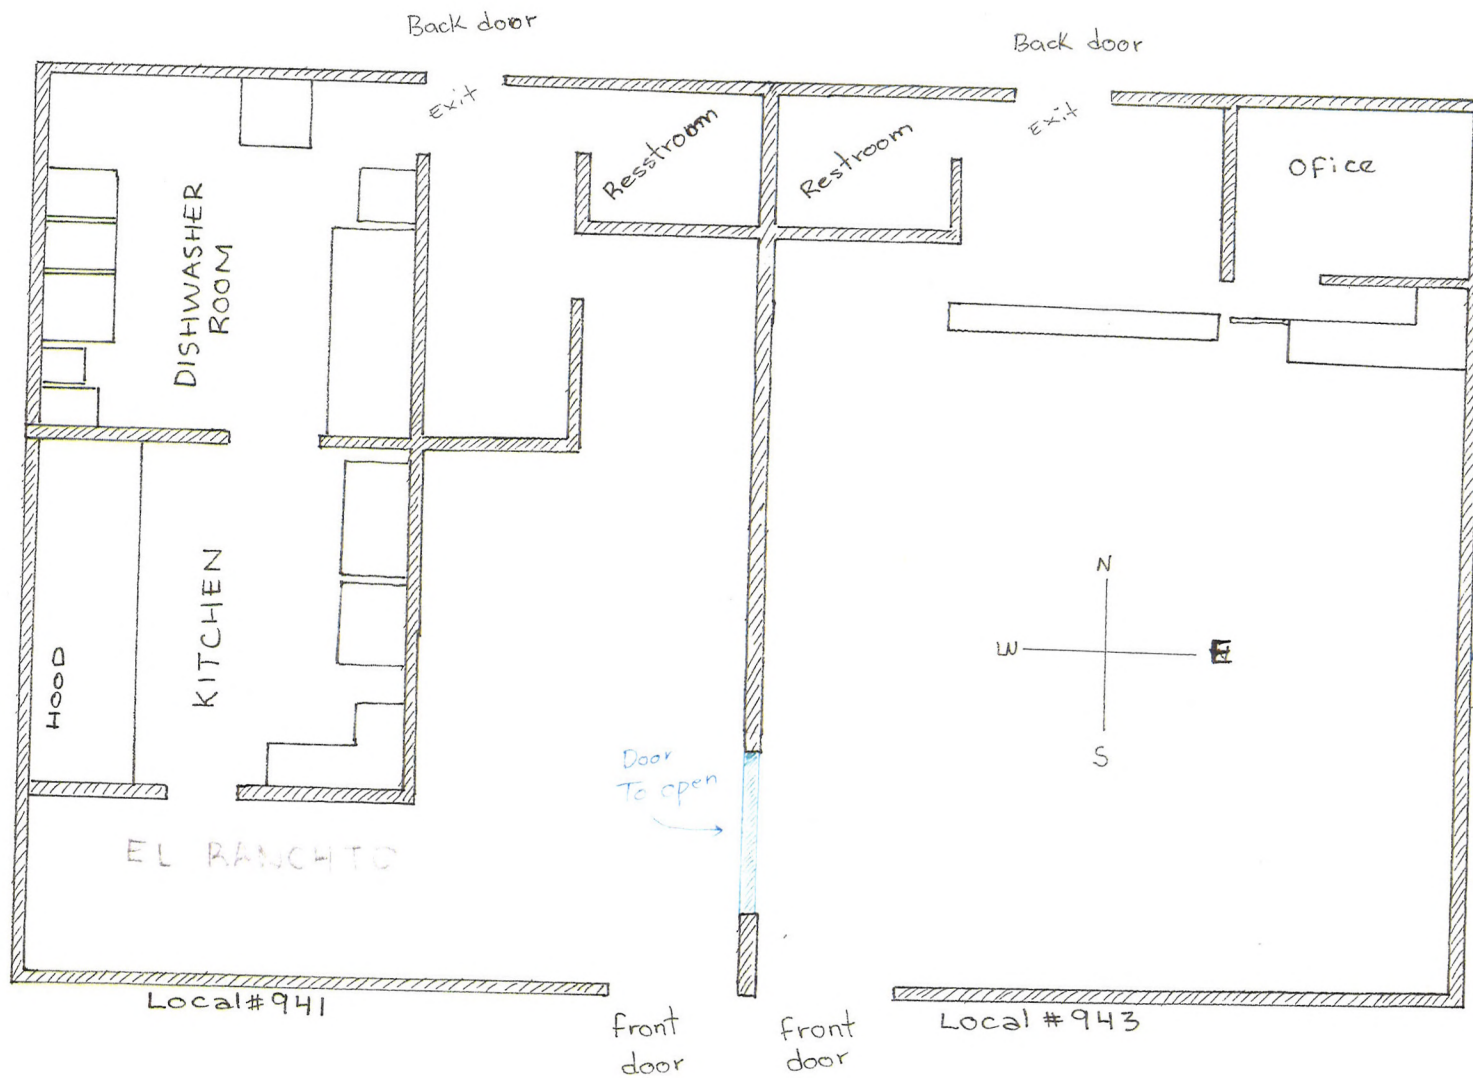

VAR-35857
10/22/09 PC

RECEIVED

SEP 02 2009

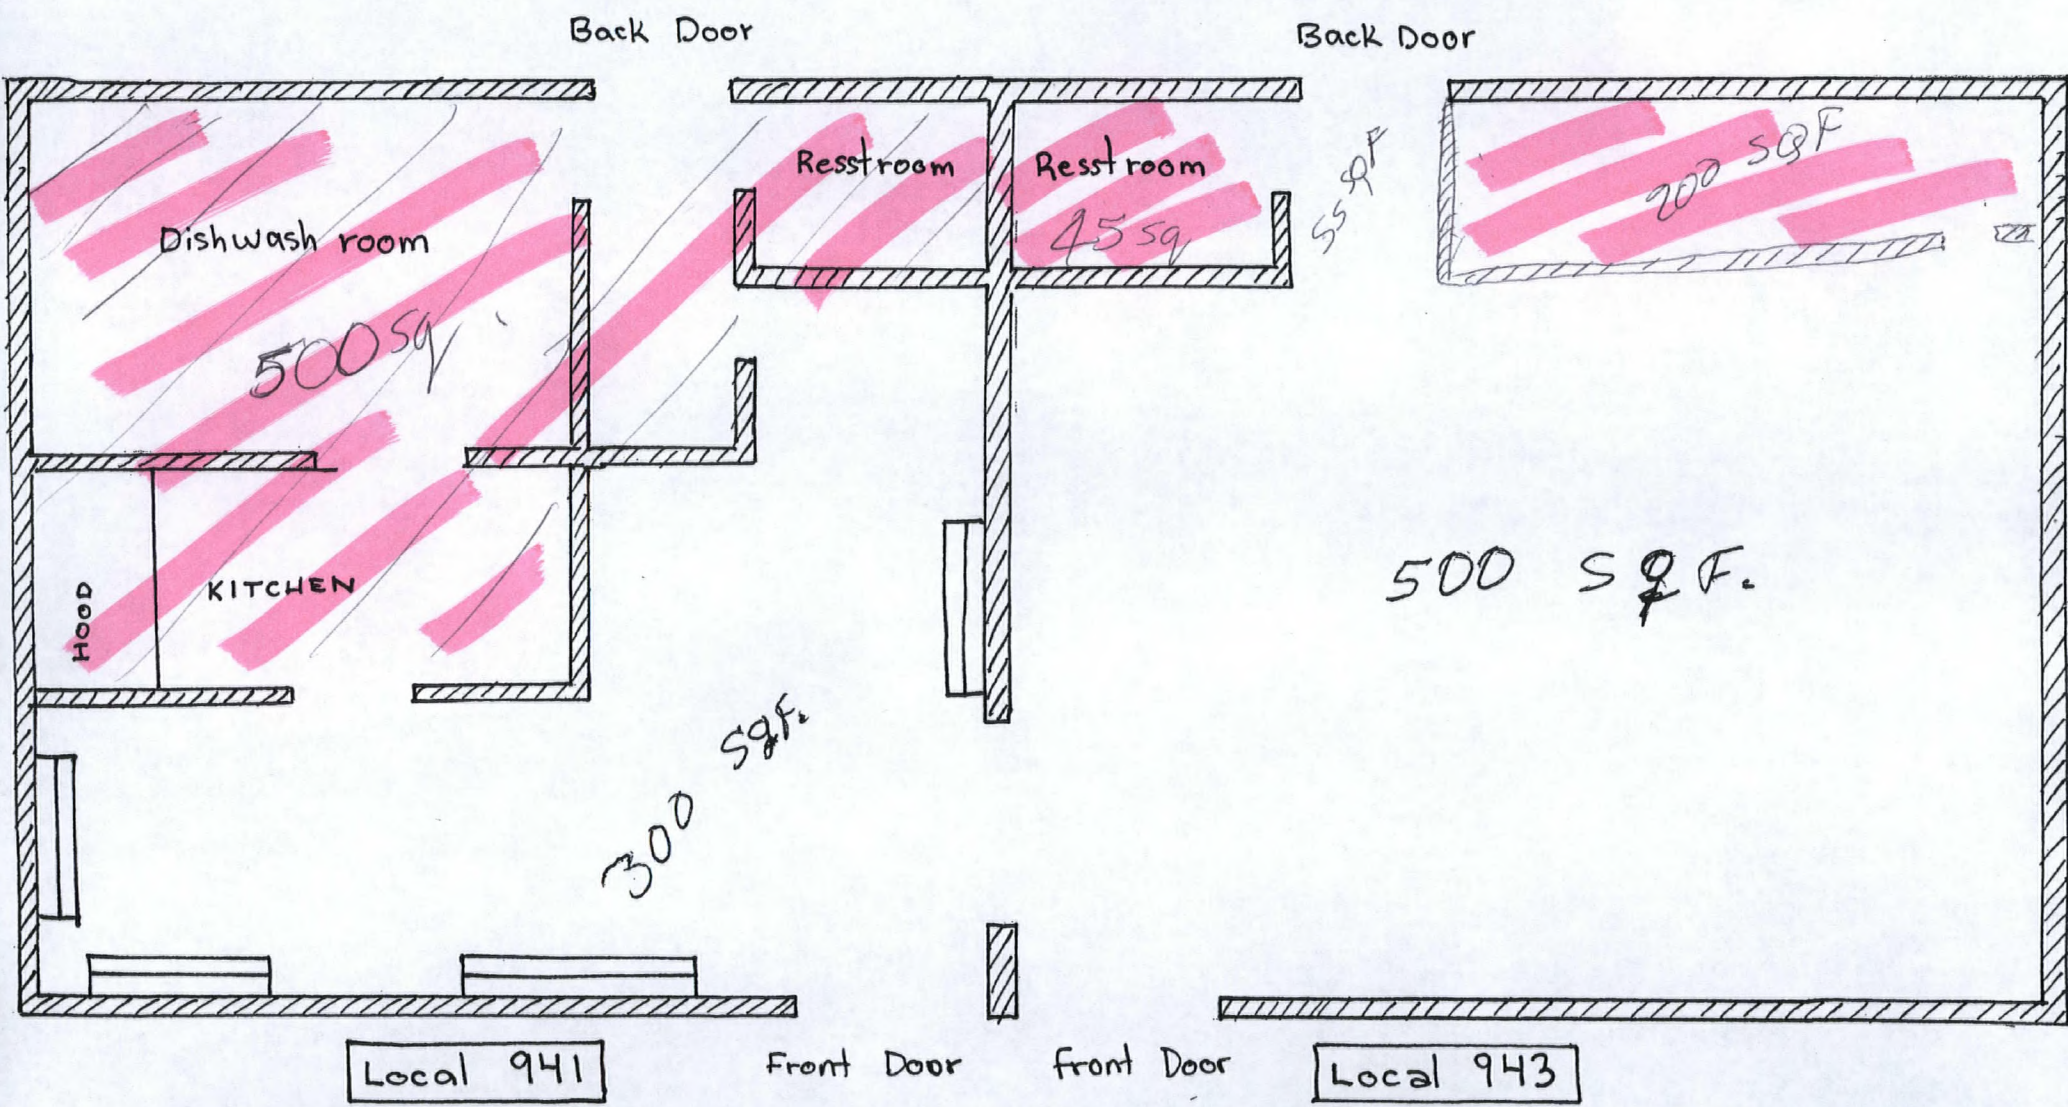

VAR-35857
REVISED
10/22/09 PC

RECEIVED
SEP 21 2009