



PLANNING & DEVELOPMENT DEPARTMENT

STATEMENT OF FINANCIAL INTEREST

Case Number: VAR-36109 APN: 125-24-302-012

Name of Property Owner: CECIL FREDI

Name of Applicant: CECIL FREDI

Name of Representative: _____

To the best of your knowledge, does the Mayor or any member of the City Council or Planning Commission have any financial interest in this or any other property with the property owner, applicant, the property owner or applicant's general or limited partners, or an officer of their corporation or limited liability company?

_____ Yes

_____ ☒ No

If yes, please indicate the member of the City Council or Planning Commission who is involved and list the name(s) of the person or persons with whom the City Official holds an interest. Also list the Assessor's Parcel Number if the property in which the interest is held is different from the case parcel.

City Official: _____

Partner(s): _____

APN: _____


Signature of Property Owner: Cecil Fredi


Print Name: CECIL FREDI

Subscribed and sworn before me

This 8th day of September, 2009

Maria Cortez Clark/NV
Notary Public in and for said County and State

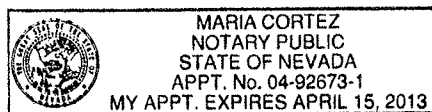

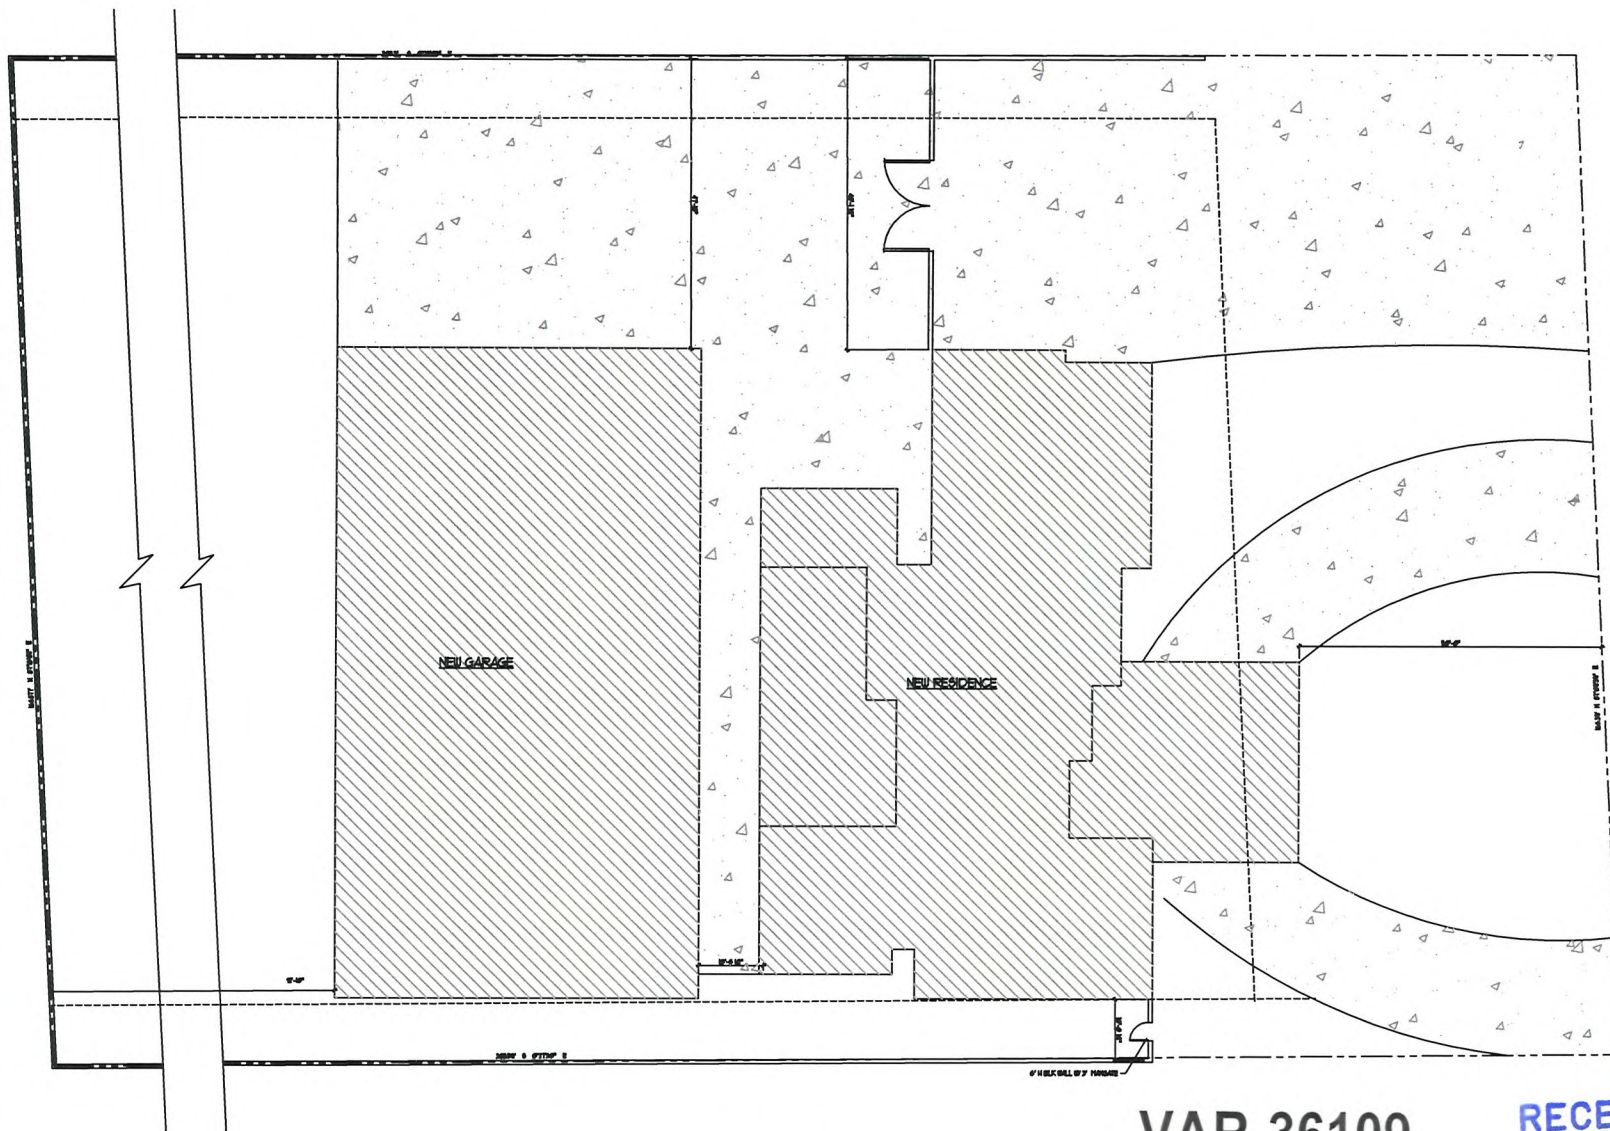

MELLO AVE

1 PLOT PLAN
SCALE: 1/8"=1'-0"

VAR-36109
11/05/09 PC

RECEIVED
SEP 21 2009

REVISIONS

DATE
JOB NO.
DRAWN

SHEET TITLE
PLOT PLAN

PROJECT
A NEW GARAGE
FOR
FREDI RESIDENCE
5410 MELLO AVE
LAS VEGAS, NEVADA

SHEET NO.

1

REVISIONS
 DATE
 JOB NO.
 DRAWN


SHEET TITLE
EXTERIOR ELEVATIONS


PROJECT
A NEW GARAGE
 FOR
 FREDI RESIDENCE
 5410 MELLO AVE
 LAS VEGAS, NEVADA

SHEET NO.
 4

RECEIVED
 SEP 21 2009

VAR-36109
 11/05/09 PC

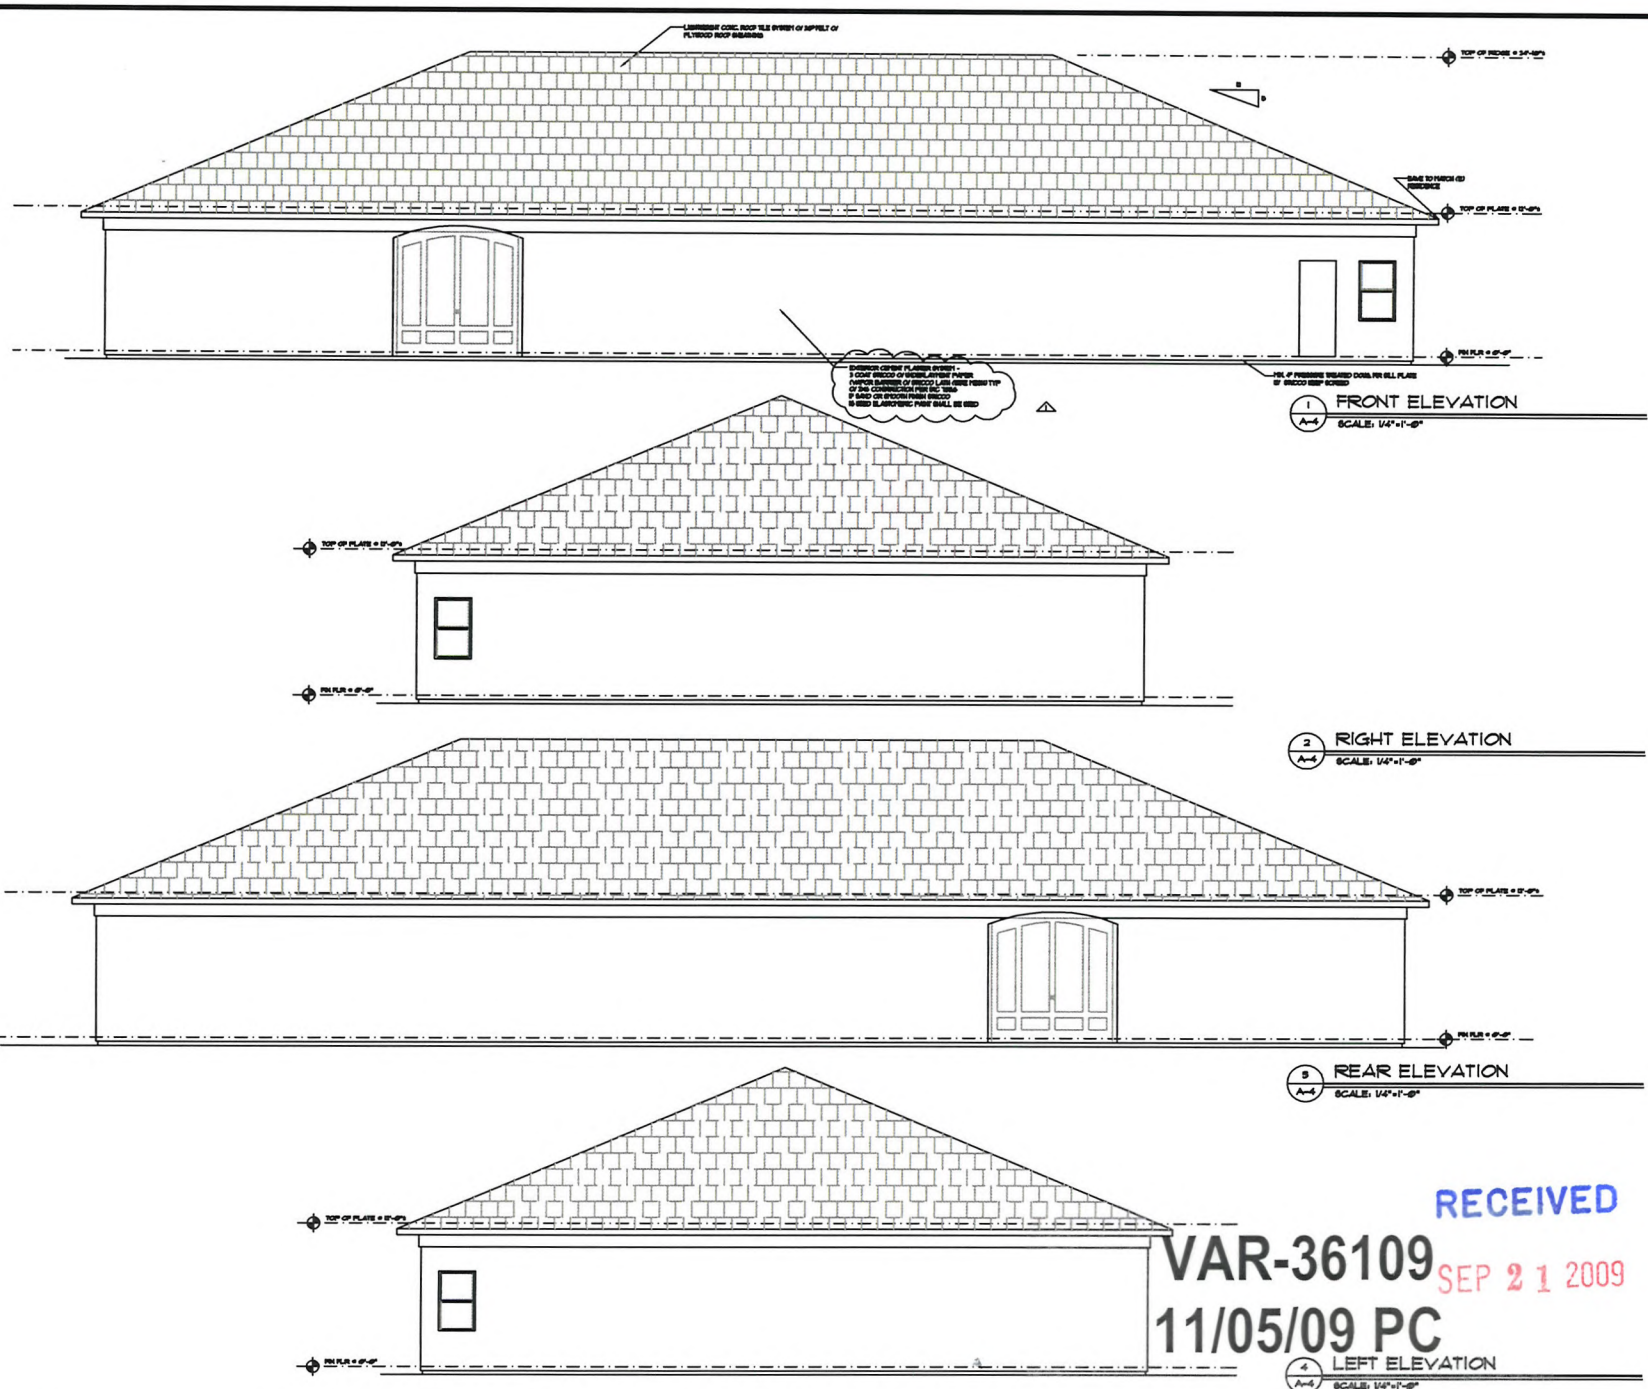

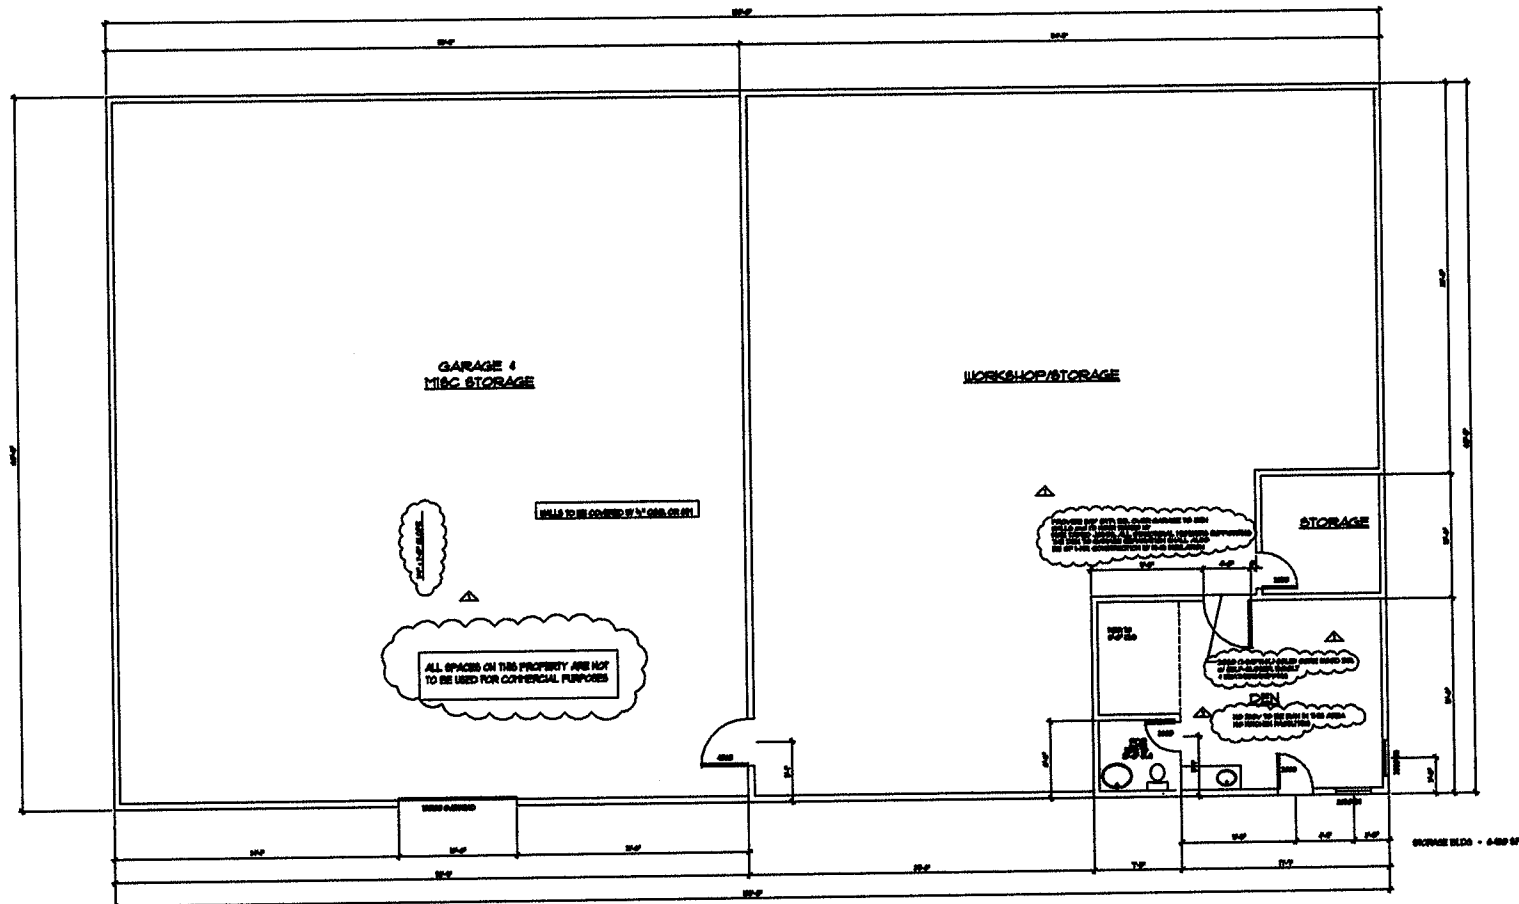

VAR-36109
REVISED
11/05/09 PC

RECEIVED
OCT 12 2009

1 FLOOR PLAN
A-9 SCALE: 1/4\"

REVISIONS

DATE
JOB NO.
DRAWN

DATE

JOB NO.

DRAWN

SHEET TITLE
FLOOR PLAN

P 1 A NEW ACCESSORY STRUCTURE/GARAGE
CLASS II
AREA RESIDENCE
1/2\"

SHEET NO.

A2