



PLANNING & DEVELOPMENT DEPARTMENT

APPLICATION / PETITION FORM

Application/Petition For: RE-OPEN SUPERCLUB w/ Addition
 Project Address (Location) 3190 W. SAHARA
 Project Name ZODIAC Proposed Use SUPERCLUB
 Assessor's Parcel #(s) 162-05-403-001 Ward # _____
 General Plan: existing C-1 proposed C-1 Zoning: existing C-1 proposed C-1
 Commercial Square Footage 18,178 Floor Area Ratio 36%
 Gross Acres 1.03 + 2.72 = 3.75 Lots/Units _____ Density _____
 Additional Information _____

PROPERTY OWNER SPANISH VILLAS AT SAHARA, LLC Contact HOWARD MANN
 Address 11620 WILSHIRE BLVD #800 Phone: 310 477 6944 Fax: 310 473-0595
 City LOS ANGELES State CALIF Zip 90045
 E-mail Address hmann@JLMREALTY.COM

APPLICANT LOVETT COMPANIES Contact BRENT LOVETT
 Address 2340 PASEO DEL PRADO D206 Phone: 702 966 5432 Fax: 702 441 8838
 City LAS VEGAS State NV Zip 89102
 E-mail Address BRENT@LOVETT.TV

REPRESENTATIVE N/A Contact _____
 Address _____ Phone: _____ Fax: _____
 City _____ State _____ Zip _____
 E-mail Address _____

Property Owner Signature* Howard S. Mann

*An authorized agent may sign in lieu of the property owner for Final Maps, Tentative Maps, and Parcel Maps.

Print Name HOWARD S. MANN

Subscribed and sworn before me on the basis of satisfactory evidence to be the person who appeared before me
 This 1st day of December, 2009

Elena Ong Dizon

Notary Public in and for said County and State

FOR DEPARTMENT USE ONLY

Case # SUP-37068

Meeting Date: 02/11/09

Total Fee: \$ 1280.00


Date Accepted: 12/30/09

Accepted By: CV Van


*The application will not be deemed complete until the submitted materials have been reviewed by the Planning and Development for consistency with applicable sections for the Zoning Ordinance.

f:\depot\Application Packet\Application Form.doc



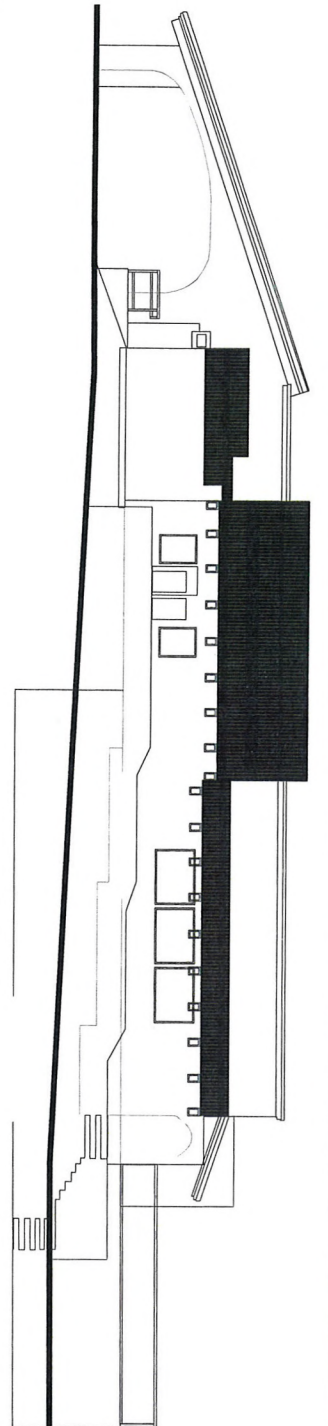

SOUTH ELEVATION

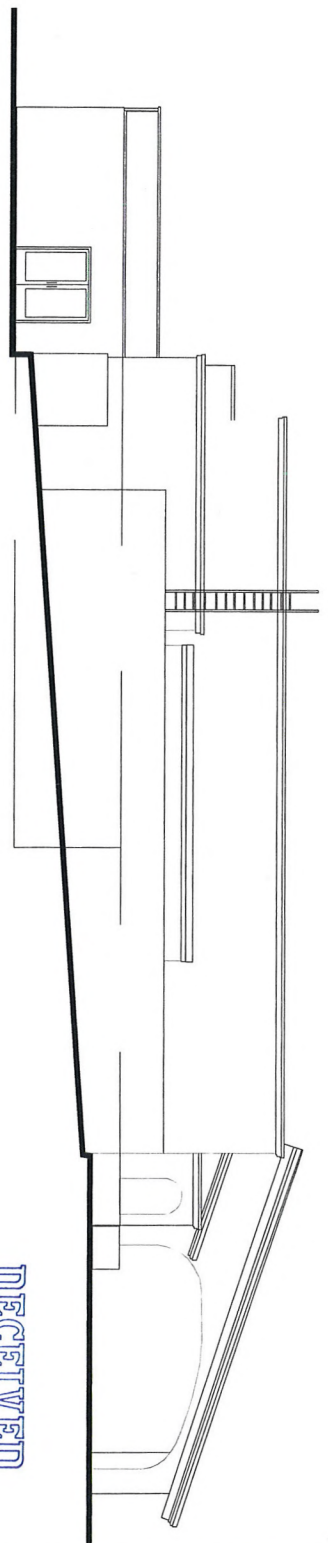

NORTH ELEVATION

SUP-37068
REVISED
02/11/10 PC

RECEIVED
JAN 20 2010

THESE PLANS ARE PREPARED & SUBMITTED BY THE CONTRACTOR AS AN EXEMPTION TO NRS 629.580 FOR WORK UNDER THE CONTRACTORS LICENSE CATEGORY AUTHORIZED UNDER NRS 624. Altan Construction Ltd. BUILDERS NO. # 00033000 PLANS PREPARED BY: Brent C. Lovett

DESIGNED BY: Brent Lovett
DRAWN BY: Brent Lovett
CHECKED BY: Brent Lovett
DATE ISSUED: Aug 1 2009
JOB NUMBER: 2009-1258
SCALE: as noted

Elevations
Zodiac
3190 West Sahara Ave
Las Vegas, Nevada 89102



REV.	DATE	BY	REVISION




SHEET #
A-04

RECEIVED
JAN 20 2010

REV.	DATE	BY:	REVISION:
------	------	-----	-----------

THE CONTRACTOR SHALL CHECK AND VERIFY ALL DIMENSIONS AND REPORT ALL ERRORS TO STAD PRIOR TO COMMENCING WORK. THESE DRAWINGS ARE NOT TO BE SCALED. ALL DIMENSIONS, SPECIFICATIONS AND COPIES THEREOF FURNISHED BY STAD ARE AND SHALL REMAIN THE SOLE PROPERTY. LISTS, BONDS BY THE PREVALING ENTITIES THESE PLANS ARE TO BE CONSIDERED PRELIMINARY AND USED AT THE OWNER/DEVELOPER/CONTRACTORS RISK. THESE DOCUMENTS ARE TO BE RETURNED OR SUTAINLY ACCOUNTED FOR TO STAD ON REQUEST ANY USE OF THIS DRAWING IN WHOLE OR IN PART, BY ANY MEANS, WITHOUT THE WRITTEN CONSENT OF STAD, STAD HEREBY EXPRESSLY RESERVES THEIR COMMON LAW COPYRIGHT AND OTHER PROPERTY RIGHTS IN THESE DOCUMENTS.

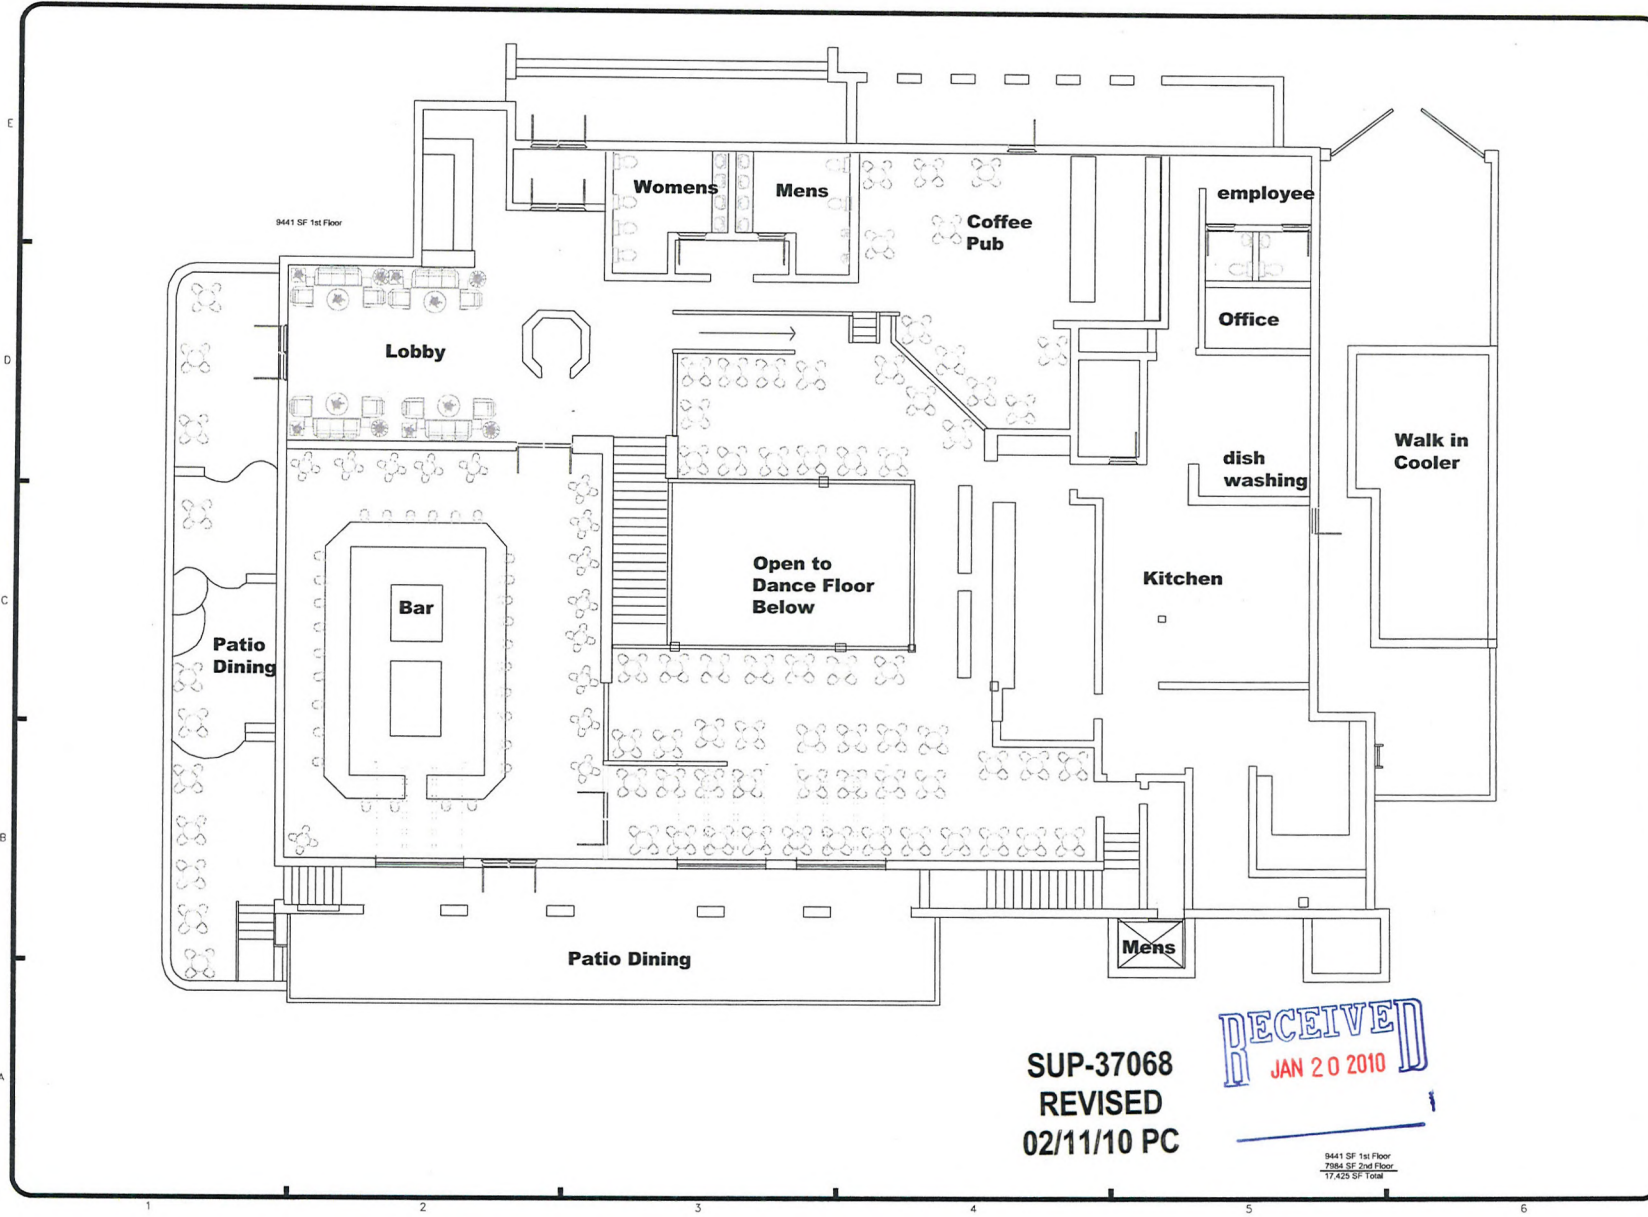

SUP-37068
REVISED
02/11/10 PC

RECEIVED
JAN 20 2010

9441 SF 1st Floor
17,425 SF Total

REV.	DATE	BY	REVISION





1st Floor Plan
Zodiac
3100 West Sahara Ave
Las Vegas, Nevada 89102

DESIGNED BY: Brent Lovett
DRAWN BY: Brent Lovett
CHECKED BY: Brent Lovett
DATE ISSUED: Aug 1 2009
JOB NUMBER: 2009-1258
SCALE: as noted



SHEET #
A-01

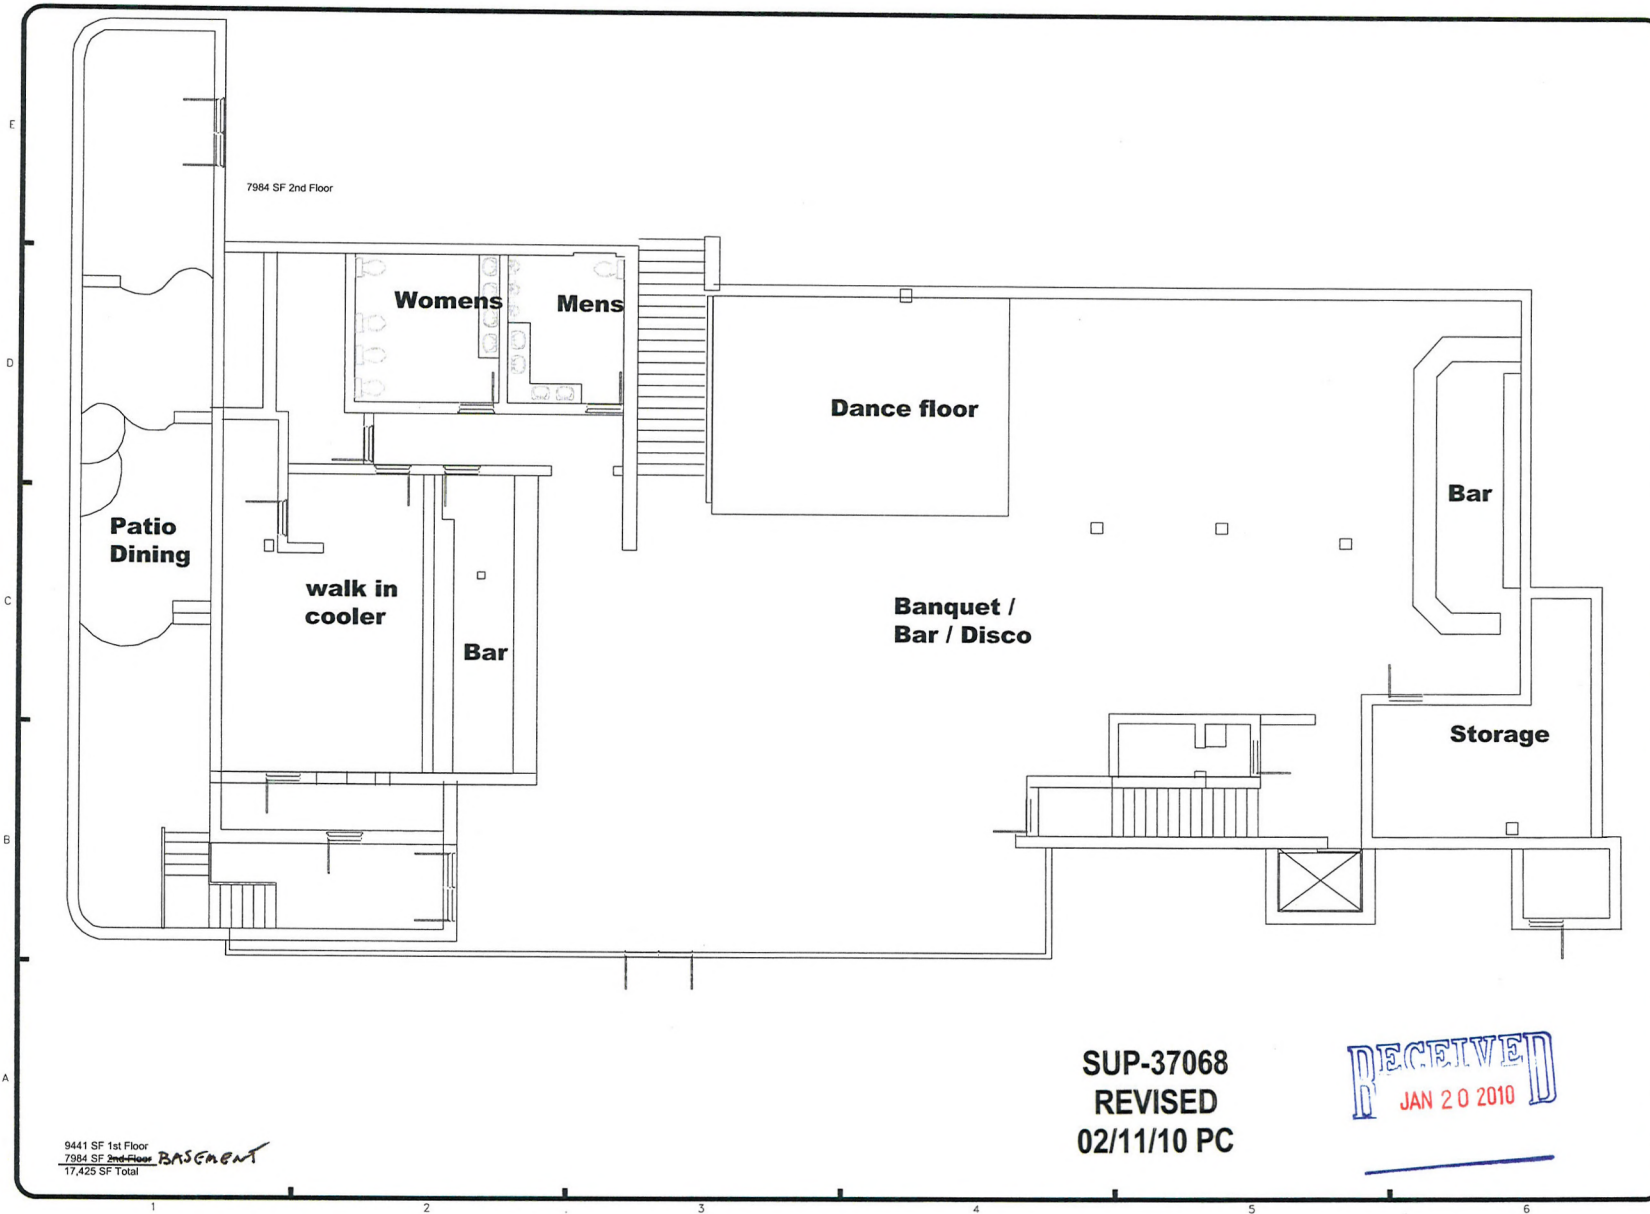

REV.	DATE	BY	REVISION




Basement Plan

Zodiac

3190 West Sahara Ave
Las Vegas, Nevada 89102

DESIGNED BY: Brent Lovett
DRAWN BY: Brent Lovett
CHECKED BY: Brent Lovett
DATE ISSUED: Aug 1, 2009
JOB NUMBER: 2009-1258
SCALE: as noted




SHEET #
A-02