



PLANNING & DEVELOPMENT DEPARTMENT

STATEMENT OF FINANCIAL INTEREST

Case Number: **SUP-37358** APN: 138-20-614-004
Name of Property Owner: Biotron I, LLC.
Name of Applicant: Yeon S. Mun
Name of Representative: _____

To the best of your knowledge, does the Mayor or any member of the City Council or Planning Commission have any financial interest in this or any other property with the property owner, applicant, the property owner or applicant's general or limited partners, or an officer of their corporation or limited liability company?

☐ Yes

☒ No

If yes, please indicate the member of the City Council or Planning Commission who is involved and list the name(s) of the person or persons with whom the City Official holds an interest. Also list the Assessor's Parcel Number if the property in which the interest is held is different from the case parcel.

City Official: _____

Partner(s): _____

APN: _____

Signature of Property Owner: Biotron I, LLC

By Elbert L. Adams G.R.

RECEIVED
FEB 11 2010


Subscribed and sworn before me

This 4th day of February, 2010

Los Angeles, California

Notary Public in and for said County and State

Linda Cade

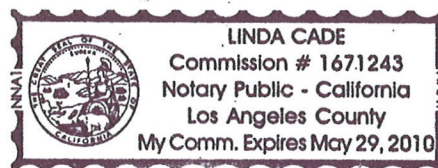

Revised 11-14-06

F:\depot\Application Packet\Statement of Financial Interest.pdf

RECEIVED
FEB 11 2010



PLANNING & DEVELOPMENT DEPARTMENT

APPLICATION / PETITION FORM

Application/Petition For: BEER AND WINE LICENSE
Project Address (Location): 8427 W. LAKE MEAD BLVD, LAS VEGAS, NV 89128
Project Name: "THE SUSHI" Proposed Use: RESTAURANT
Assessor's Parcel #(s): _____ Ward #: _____
General Plan: existing ☒ proposed _____ Zoning: existing ☒ proposed _____
Commercial Square Footage: 3,833 Floor Area Ratio: _____
Gross Acres: _____ Lots/Units: _____ Density: _____
Additional Information: _____

PROPERTY OWNER: BIOTRON I LLC Contact: _____
Address: _____ Phone: _____ Fax: _____
City: _____ State: _____ Zip: _____
E-mail Address: _____

APPLICANT: YEON MUN, INC. Contact: YEON S. MUN
Address: 44 SULLY CREEK CT. Phone: (702) 325-6117 Fax: _____
City: LAS VEGAS, NV 89148 State: NV Zip: 89148
E-mail Address: LEESJ68B@YAHOO.COM

REPRESENTATIVE: _____ Contact: _____
Address: _____ Phone: _____ Fax: _____
City: _____ State: _____ Zip: _____
E-mail Address: _____

Elbert K Adams
Property Owner Signature* Biotron I, LLC

*An authorized agent may sign in lieu of the property owner for Final Maps, Tentative Maps, and Parcel Maps.

Print Name: BIOTRON I, LLC - ELBERT K ADAMS

Subscribed and sworn before me

This 4th day of February, 2010

Linda Cade

Notary Public in and for said County and State

Los Angeles
California

Revised 10/27/08



FOR DEPARTMENT USE ONLY


Case # SUP-37358
Meeting Date: 3/25/10
Total Fee: _____
Date Received: *
Received By: _____

*The application will not be deemed complete until the submitted materials have been reviewed by the Planning and Development Department for consistency with applicable sections of the Zoning Ordinance.

F:\depo\Application Packet\Application Form.pdf

RECEIVED
FEB 11 2010


Scholar Lane

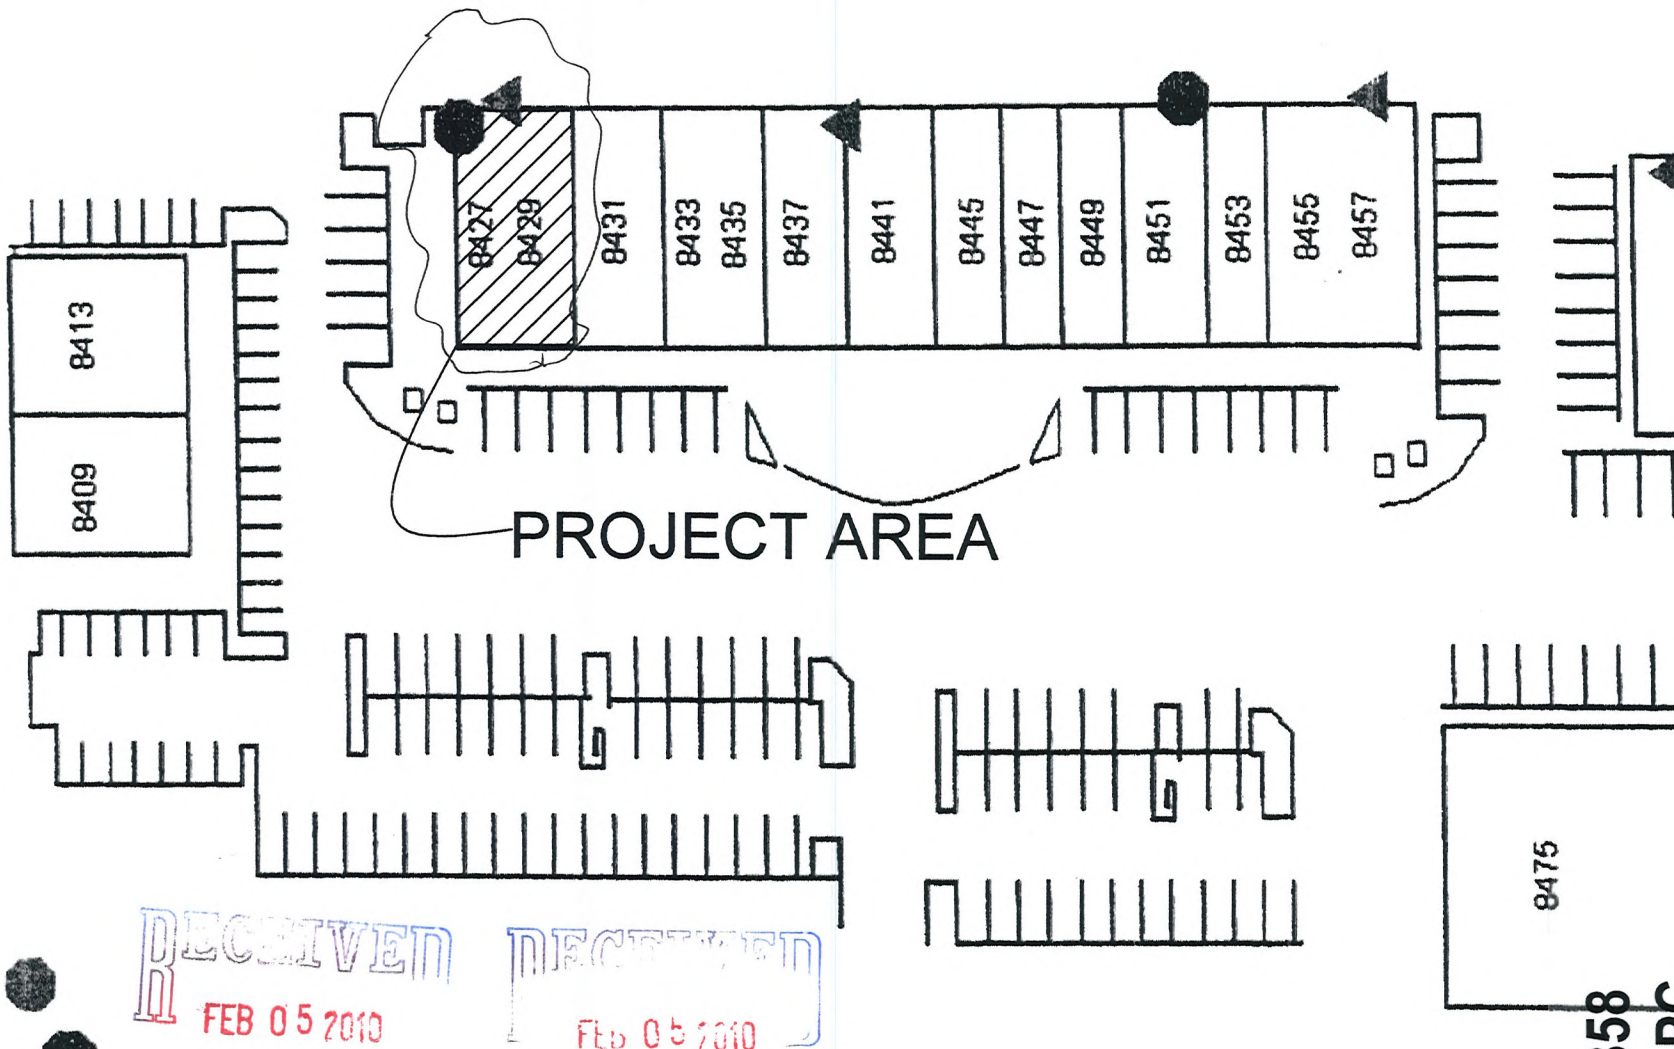

project AD : 8427 w. lake mead.

Lake Mead

SUP-37358
03/25/10 PC

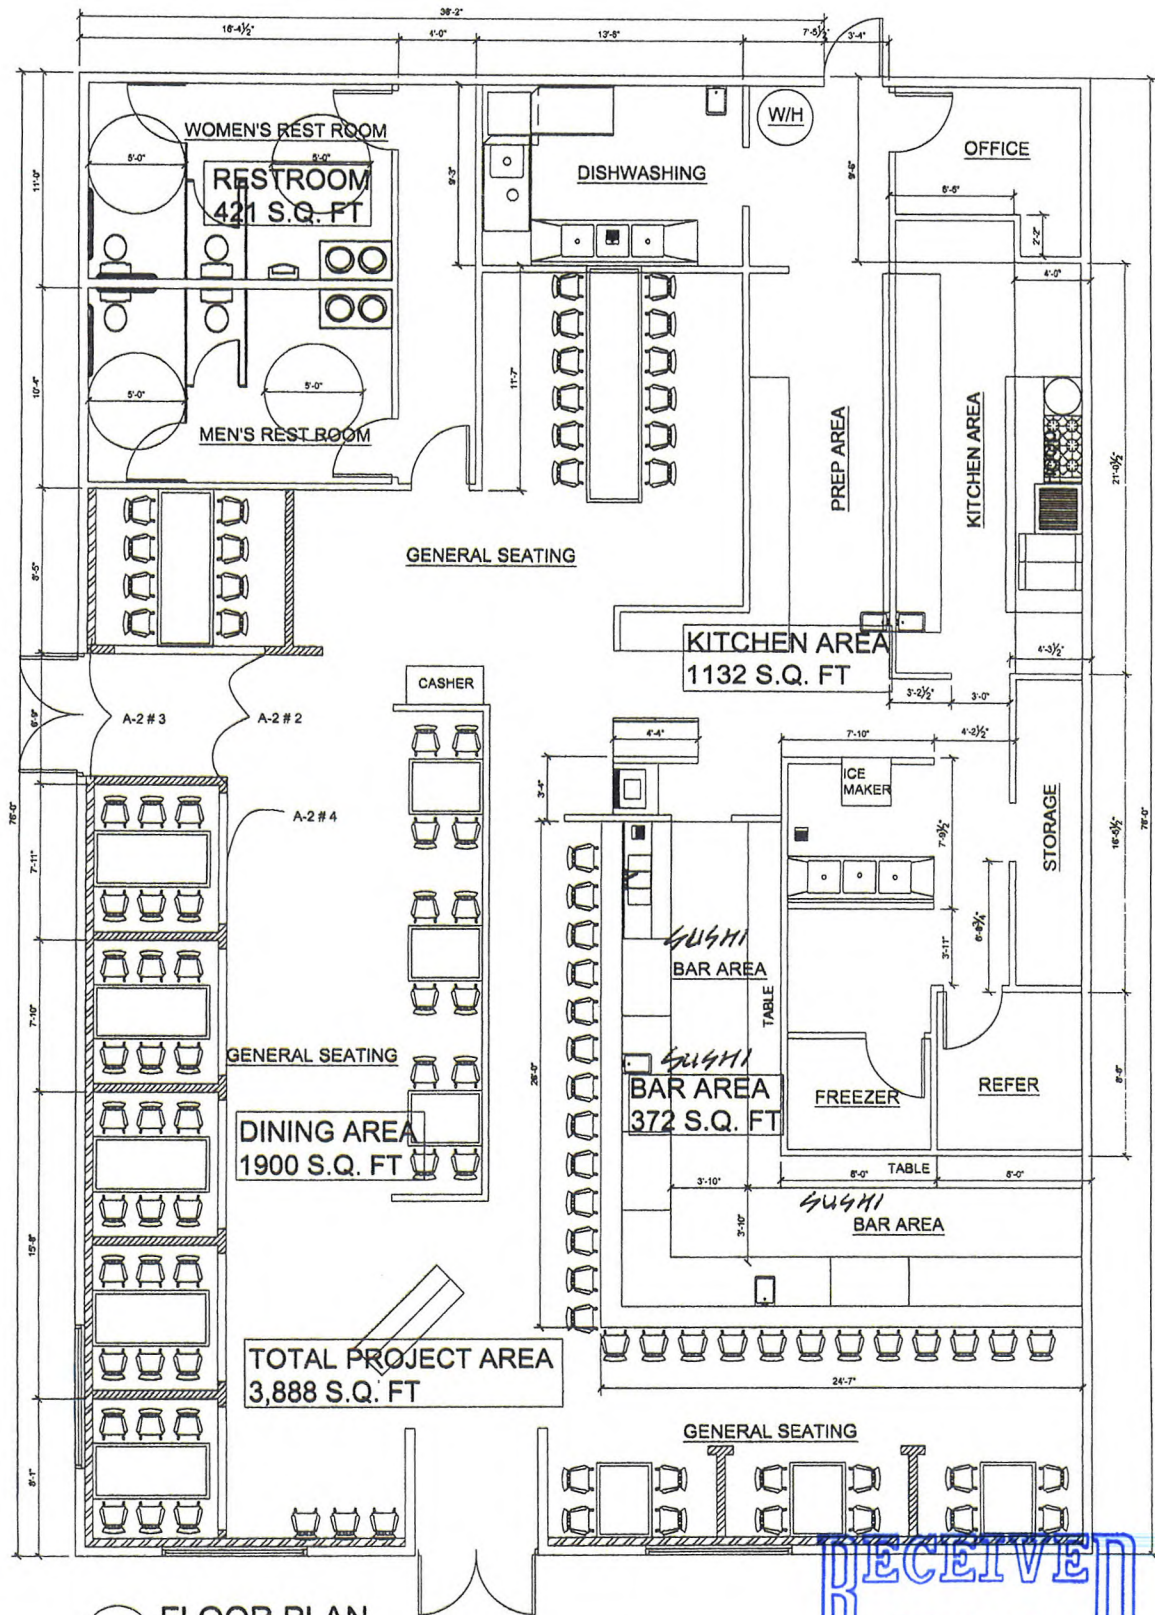

FLOOR PLAN
1/4" = 1'-0"

Bar:
25 seats
Dining:
75 seats

RECEIVED
FEB 25 2010

SUP-37358
REVISED
03/25/10 PC