



PLANNING & DEVELOPMENT DEPARTMENT

STATEMENT OF FINANCIAL INTEREST

Case Number: **SUP-37566** APN: 138-18-821-005

Name of Property Owner: A & M Lake Mead LLC

Name of Applicant: Walgreen Co.

Name of Representative: Lionel Sawyer & Collins

To the best of your knowledge, does the Mayor or any member of the City Council or Planning Commission have any financial interest in this or any other property with the property owner, applicant, the property owner or applicant's general or limited partners, or an officer of their corporation or limited liability company?

☐ Yes

☒ No

If yes, please indicate the member of the City Council or Planning Commission who is involved and list the name(s) of the person or persons with whom the City Official holds an interest. Also list the Assessor's Parcel Number if the property in which the interest is held is different from the case parcel.

City Official: _____

Partner(s): _____

APN: _____

Signature of Property Owner: _____

*State of California
County of Los Angeles*

Print Name: _____


ALBERT GHAM

Subscribed and sworn before me

This 5th day of November, 2009, by Albert Ghiam proved to me on the basis of satisfactory evidence to be the person who appeared before me

Clare Jordan
Notary Public in and for said County and State

Revised 11-14-06

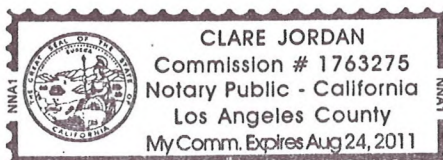

f:\depot\Application Packet\Statement of Financial Interest.pdf

RECEIVED
MAR 04 2010

PLANNING & DEVELOPMENT DEPARTMENT

APPLICATION / PETITION FORM

Application/Petition For: SUP: Retail Establishment with Accessory Package Liquor Off-Sale
 Project Address (Location) 9420 West Lake Mead
 Project Name Walgreens Proposed Use Drug Store (existing)
 Assessor's Parcel #(s) 138-18-821-005 Ward # 4
 General Plan: existing XX proposed _____ Zoning: existing P-C proposed _____
 Commercial Square Footage _____ Floor Area Ratio _____
 Gross Acres _____ Lots/Units _____ Density _____
 Additional Information _____

PROPERTY OWNER A & M Lake Mead LLC Contact Albert Ghiam
 Address 23462 Palm Drive Phone: (818) 225-2253 Fax: (818) 225-0864
 City Calabasas State CA Zip 91302
 E-mail Address none

APPLICANT Walgreen Co. Contact Rebecca Lidskin, Attorney
 Address 104 Wilnot Road, M.S. #1420 Phone: (847) 315-4651 Fax: (847) 315-4825
 City Deerfield State Illinois Zip 60015
 E-mail Address Rebecca.Lidskin@walgreens.com

REPRESENTATIVE Lionel Sawyer & Collins Contact Jennifer Roberts
 Address 300 South Fourth Street #1700 Phone: (702) 383-8946 Fax: (702) 671-2490
 City Las Vegas State Nevada Zip 89101
 E-mail Address jroberts@lionelsawyer.com

Property Owner Signature* [Signature]

* An authorized agent may sign in lieu of the property owner for Final Maps, Tentative Maps, and Parcel Maps.

Print Name ALBERT GHIAM


Subscribed and sworn before me

This 03 day of November, 20 09

Anna Shamiryan

Notary Public in and for said County and State

Revised 10/27/08

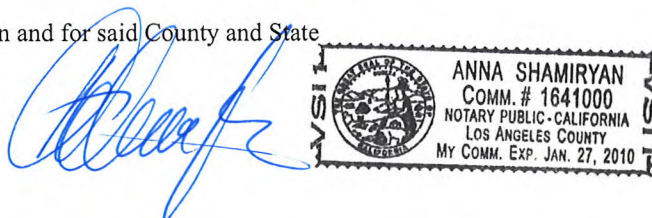



FOR DEPARTMENT USE ONLY

Case #	<u>SUP-37566</u>
Meeting Date:	<u>4/22/10</u>
Total Fee:	<u>\$ 1280.00</u>
Date Received:*	<u>3/3/10</u>
Received By:	<u>[Signature]</u>

*The application will not be deemed complete until the submitted materials have been reviewed by the Planning and Development Department for consistency with applicable sections of the Zoning Ordinance.

f:\depot\Application Packet\Application Form.pdf

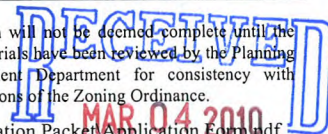

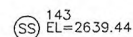

⑤ 142
EL=2637.15

SITE PLAN
SCALE: 1" = 20'-0"
SUP-37566

04/22/10 PC



RECEIVED A001-1457-DW-1400-01 VOID PLOT SUPERSEDES PLAN DATED:	DRAWN BY: K. THALMANN COS	A0.1
	DATE: 11-16-09	
REVIEWED BY:		


MAR 04 2010



SUP-37566
04/22/10 PC

DATE: 11-11-09
REVIEWED BY: [Signature]
SUPERSEDES PLAN DATED: [Blank]
NORTH
RECEIVED
MAR 04 2010





NO.	DATE	BY	DESCRIPTION	CON.
REVISONS				
CERTIFICATION AND SEAL.				
I HEREBY CERTIFY THAT THIS PLAN AND SPECIFICATION WAS PREPARED BY ME OR UNDER MY DIRECT SUPERVISION AND THAT I AM A FULLY REGISTERED ARCHITECT OR ENGINEER UNDER THE LAWS OF THE STATE OF XXXXXXXXX AS SIGNED BY MY HAND AND SEAL.				
STORE NUMBER 04242				
PROJECT NAME WALGREENS STORE 9420 W LAKE MEAD BLVD LAS VEGAS, NV				
DRAWING TITLE				
LANDSCAPE PLAN				
CAD D PLOT: 04242-L-18W-19NOV09	SCALE: 1"=20'-0" DRAWN BY: K. THALMANN COS.			
VOID PLOT:	DATE: 11-16-09			
SUPERSEDES PLAN DATED:	REVIEWED BY:			
	L1 OF TWO			

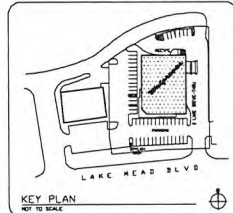

EXECUTIVE APPROVAL		DATE
EXEC. VICE PRESIDENT DRUG STORE OPERATIONS	G. KRACKE	12-4
SIR. VICE PRESIDENT FACILITIES DEVELOPMENT	W. SHIEL	11-20
VICE PRESIDENT DRUG STORE OPERATIONS	J. KARLIN	1-8
REGIONAL VICE PRESIDENT		
SIR. MANAGER PLANNING & DESIGN	A. HADY	12-

RELEASED TO
CONSTRUCTION

RECEIVED SUP-37566
APR 12 2010

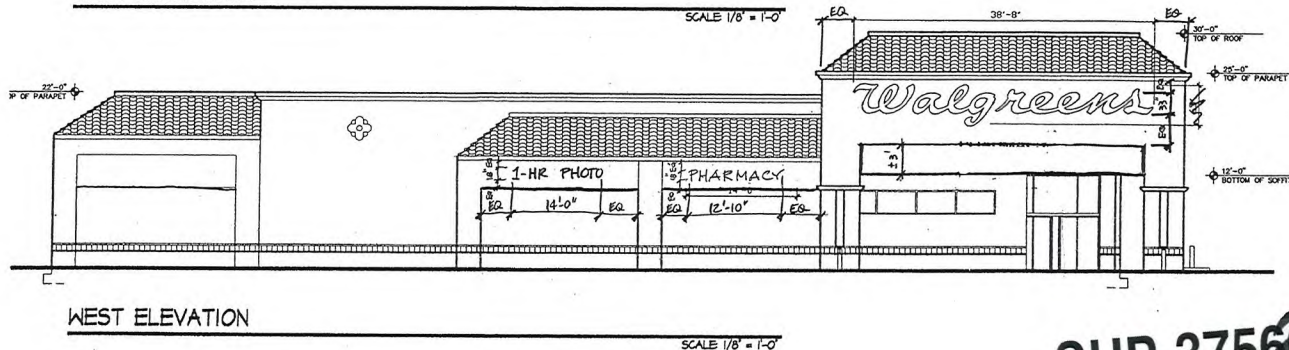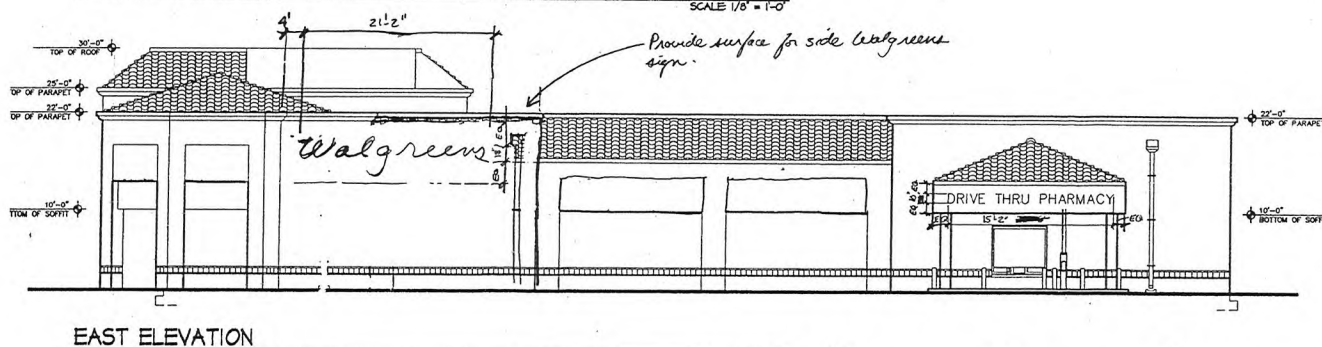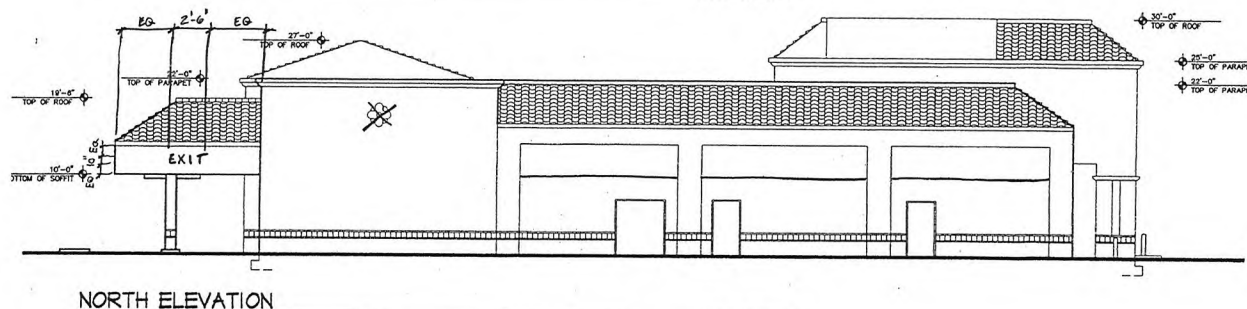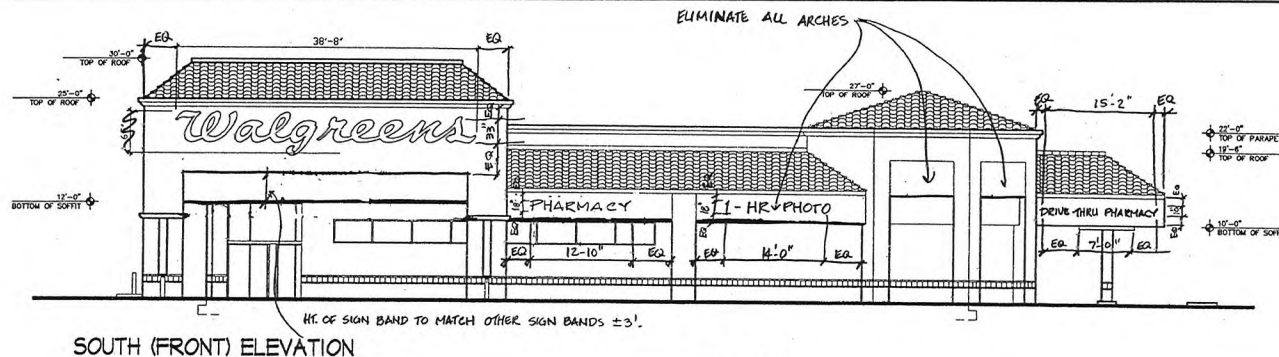

NO.	DATE	BY	DESCRIPTION	CONST
-----	------	----	-------------	-------

REVISIONS

CERTIFICATION AND SEAL

I HEREBY CERTIFY THAT THIS PLAN AND SPECIFICATION WAS PREPARED BY ME OR UNDER MY DIRECT SUPERVISION AND THAT I AM A DULY REGISTERED ARCHITECT OR ENGINEER UNDER THE LAWS OF THE STATE OF ILLINOIS AS SIGNIFIED BY MY HAND AND SEAL.

STORE NUMBER 04242

PROJECT NAME
WALGREENS STORE
9420 W LAKE MEAD BLVD
LAS VEGAS, NV

DRAWING TITLE
EXTERIOR ELEVATIONS

CADD PLOT: 4242.A21-SW-15NOV09
VOID PLOT: K:ITALIANWOODS
DATE: 11-15-09
SUPERSEDES: PLAN DATED:
SCALE: AS SHOWN
DRAWN BY: K:ITALIANWOODS
REVIEWED BY: R: FAWCETT
DRAWING NO. A2.1

SUP-37566
04/22/10 PC

RECEIVED
MAR 04 2010