



PLANNING & DEVELOPMENT DEPARTMENT

STATEMENT OF FINANCIAL INTEREST

Case Number: **SUP-38275** APN: 162 021 1000 7
Name of Property Owner: NERCES S. HIMIDIAN
Name of Applicant: WorldWide AS Jewelry, LLC
Name of Representative: _____

To the best of your knowledge, does the Mayor or any member of the City Council or Planning Commission have any financial interest in this or any other property with the property owner, applicant, the property owner or applicant's general or limited partners, or an officer of their corporation or limited liability company?

☐ Yes

☒ No

If yes, please indicate the member of the City Council or Planning Commission who is involved and list the name(s) of the person or persons with whom the City Official holds an interest. Also list the Assessor's Parcel Number if the property in which the interest is held is different from the case parcel.

City Official: _____

Partner(s): _____

APN: _____


Signature of Property Owner: _____

Print Name: NERCES S HIMIDIAN

Subscribed and sworn before me

This 15th day of June, 20 10

[Signature]
Notary Public in and for said County and State

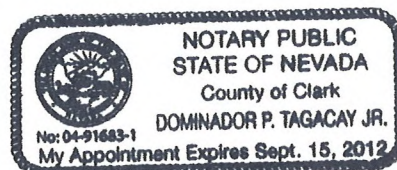



PLANNING & DEVELOPMENT DEPARTMENT

APPLICATION / PETITION FORM

Application/Petition For: SECONDHAND DEALER / JEWELRY CLASS III
Project Address (Location): 1444 E. CHARLESTON BLVD. LV, NV 89104
Project Name: WORLDWIDE A'S JEWELRY, LLC Proposed Use: _____
Assessor's Parcel #(s): 16202110007 Ward #: _____
General Plan: existing _____ proposed _____ Zoning: existing _____ proposed _____
Commercial Square Footage: _____ Floor Area Ratio: _____
Gross Acres: _____ Lots/Units: _____ Density: _____
Additional Information: _____

PROPERTY OWNER: NERCES S. HIMIDIAN Contact: 250-3013 CL
Address: 1426 E. CHARLESTON BLVD. Phone: 250-3013 Fax: N/A
City: LAS VEGAS, NV 89104 State: NV Zip: 89104
E-mail Address: N/A

APPLICANT: WORLDWIDE A'S JEWELRY, LLC Contact: LILIBETH GONZALEZ
Address: 1444 E. CHARLESTON BLVD Phone: (702) 380-8491 Fax: (702) 380-8301
City: LAS VEGAS State: NV Zip: 89104
E-mail Address: WORLDWIDEJEWELRY@YAHOO.COM


REPRESENTATIVE: _____ Contact: _____
Address: _____ Phone: _____ Fax: _____
City: _____ State: _____ Zip: _____
E-mail Address: _____

Property Owner Signature* [Signature]
Print Name: NERCES S. HIMIDIAN

Subscribed and sworn before me

This 15th day of June

Notary Public in and for said County and State

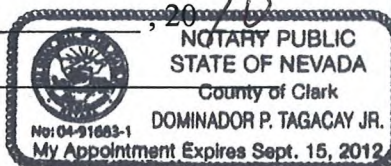

FOR DEPARTMENT USE ONLY

Case #: SUP-38275
Meeting Date: 7/29/10
Total Fee: \$1030
Date Accepted: 6/17/10
Accepted By: Romeo



*The application will not be deemed complete until the submitted materials have been reviewed by the Planning and Development for consistency with applicable sections for the Zoning Ordinance.

TABLE 720.1(2) - continued
RATED FIRE-RESISTANCE PERIODS FOR VARIOUS WALLS AND PARTITIONS ***

MATERIAL	ITEM NUMBER	CONSTRUCTION	MINIMUM FINISHED THICKNESS FACE-TO-FACE* (Inches)			
			4 hour	2 hour	1 hour	
14. Wood studs-interior partition with gypsum wallboard each side	14-1.1A	2" x 4" wood studs 16" on center with two layers of 5/8" regular gypsum wallboard" each side, 4d cooler" or wallboard" nails at 8" on center first layer, 5d cooler" or wallboard" nails at 8" on center second layer with laminating compound between layers, joints staggered. First layer applied full length vertically, second layer applied horizontally or vertically	---	---	---	5
	14-1.2A	2" x 4" wood studs 16" on center with two layers 1/2" regular gypsum wallboard" applied vertically or horizontally each side, joints staggered. Nail base layer with 5d cooler" or wallboard" nails at 8" on center face layer with 8d cooler" or wallboard" nails at 8" on center	---	---	---	5 1/2
	14-1.3A	2" x 4" wood studs 24" on center with 1/2" Type X gypsum wallboard" applied vertically or horizontally nailed with 6d cooler" or wallboard" nails at 7" on center with end joints on nailing members. Stagger joints each side.	---	---	---	4 1/2
	14-1.4	2" x 4" fire-retardant-treated wood studs spaced 24" on center with one layer of 1/2" Type X gypsum wallboard" applied with face paper grain (long dimension) parallel to studs. Wallboard attached with 6d cooler" or wallboard" nails at 7" on center.	---	---	---	4 1/4
	14-1.5A	2" x 4" wood studs 16" on center with two layers 1/2" Type X gypsum wallboard" each side. Base layers applied vertically and nailed with 6d cooler" or wallboard" nails at 9" on center. Face layer applied vertically or horizontally and nailed with 8d cooler" or wallboard" nails at 7" on center. For nail-adhesive application, base layers are nailed 6" on center. Face layers applied with coating of approved wallboard adhesive and nailed 12" on center.	---	---	---	6
	14-1.6	2" x 3" fire-retardant-treated wood studs spaced 24" on center with one layer of 1/2" Type X gypsum wallboard" applied with face paper grain (long dimension) at right angles to studs. Wallboard attached with 6d cement-coated box nails spaced 12" on center.	---	---	---	3 1/2
	15-1.1A	Exterior surface with 1/2" drop siding over 1/2" gypsum sheathing on 2" x 4" wood studs at 16" on center; interior surface treatment as required for 1-hour-rated exterior or interior 2" x 4" wood stud partitions. Gypsum sheathing nailed with 1 1/2" by No. 11 gage by 1/2" lead galvanized nails at 8" on center. Siding nailed with 7d galvanized smooth box nails.	---	---	---	Varies
	15-1.2A	2" x 4" wood studs 16" on center with metal lath and 1/2" cement plaster on each side. Lath attached with 6d common nails 7" on center driven to 1" minimum penetration and bent over. Plaster mix 1:4 for scratch coat and 1:5 for brown coat, by volume, cement to sand.	---	---	---	5 1/2
	15-1.3A	2" x 4" wood studs 16" on center with 1/2" cement plaster (measured from the face of studs) on the exterior surface with interior surface treatment as required for interior wood stud partitions in this table. Plaster mix 1:4 for scratch coat and 1:5 for brown coat, by volume, cement to sand.	---	---	---	Varies
15. Exterior or interior walls	15-1.4	3/4" No. 16 gage noncombustible studs 16" on center with 1/2" cement plaster (measured from the face of the studs) on the exterior surface with interior surface treatment as required for interior, nonbearing, noncombustible stud partitions in this table. Plaster mix 1:4 for scratch coat and 1:5 for brown coat, by volume, cement to sand.	---	---	---	Varies

(continued)

TABLE 720.1(2) ITEM # 14-1.5

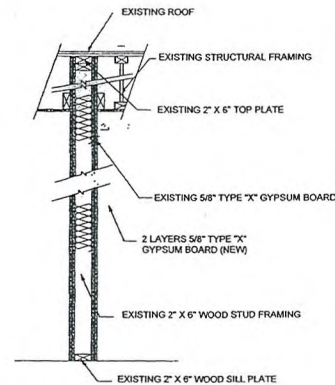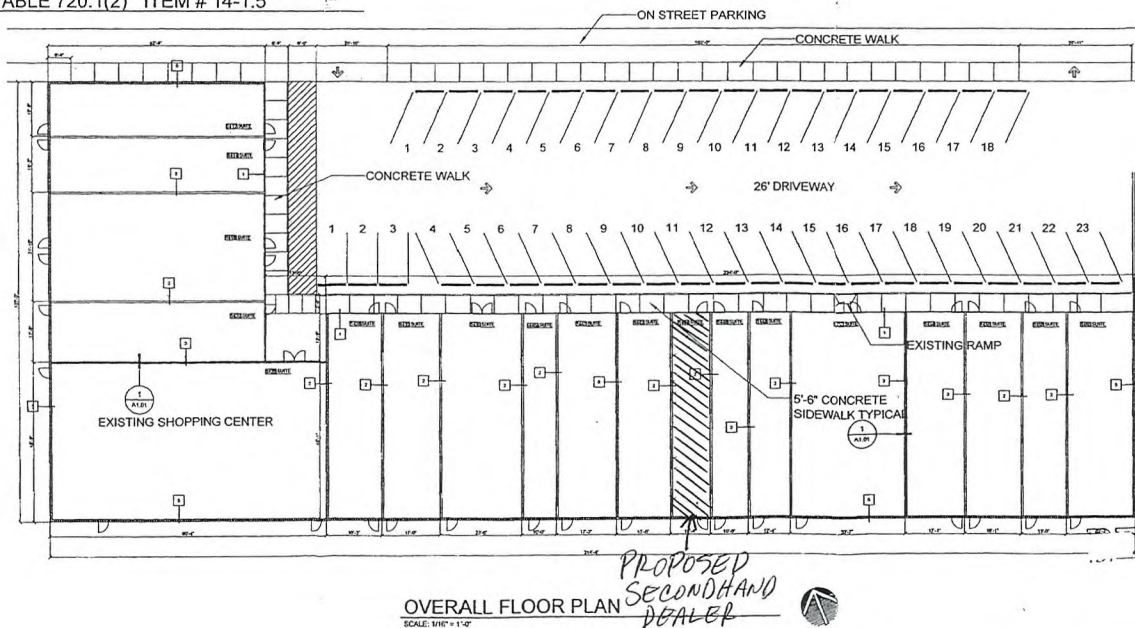

1 WALL PARTITION
A1.01 1/2" = 1'-0"

CHARLESTON BLVD.

WALL TYPES

- ☐ STORE FRONT WINDOW SYSTEM WITH 2"X6" WOOD STUDS WITH MP 3 COAT STUCCO.
- ☐ EXISTING DEMISING WALLS
- ☐ MGA SEPARATION WALLS (SHEET A1.01 2003 BC FIRE-RATING TABLE 720.1(2))
- ☐ NOT USED
- ☐ EXISTING CMU WALL

NOTE:

LEGEND


- AREA SEPARATION WALLS
- INDICATES EXISTING CMU WALL
- EXISTING DEMISING WALLS

GENERAL NOTES


CEILING TYPE SCHEDULE

- ☐ GYPSUM BOARD CEILING OR RAFTER
- ☐ PENDANT DIRECTLY EXPOSED EXISTING LIGHT FIXTURE
- ☐ CEILING HEIGHT
- ☐ NEW RECESSED EXPOSED FAN 1/8"X1/8"
- ☐ EXISTING SURFACE MOUNTED FIXTURE

CEILING NOTES

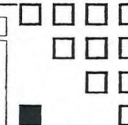

REVISIONS	BY

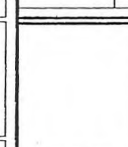

MGA Mechanical & Electrical, Inc.
2249 E. 3RD STREET, SUITE 100, LAS VEGAS, NV 89101 • (702) 365-1811
FAX: (702) 365-1812



RECEIVED
JUN 17 2010



PROJECT: LAFAYETTE SQUARE
1444 E. CHARLESTON BLVD.
LAS VEGAS, NEVADA
OVERALL FLOOR PLAN & DETAIL

DATE:	06-30-04
SCALE:	AS INDICATED
DRAWN:	AGRW
JOB NO.:	2004-0431
SHEET	A1.01
OF SHEETS	

SUP-38275

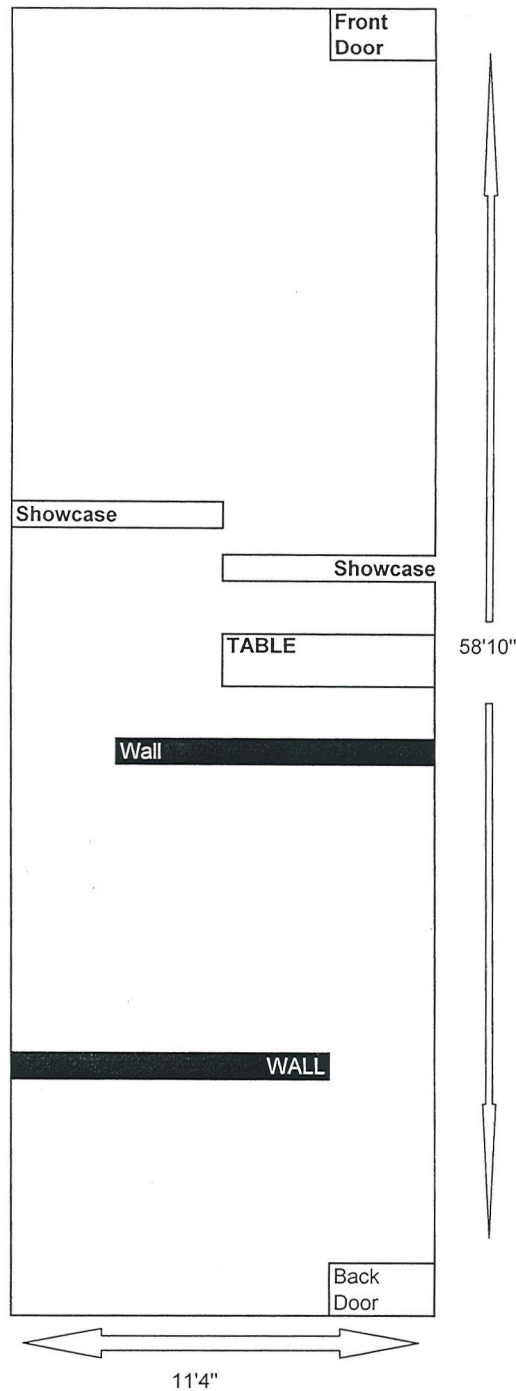

WORLDWIDE A'S JEWELRY LLC
1444 E CHARLESTON BLVD
LAS VEGAS, NV 89104

RECEIVED
JUN 17 2010

↑
N

SUP-38275