



PLANNING & DEVELOPMENT DEPARTMENT

STATEMENT OF FINANCIAL INTEREST

Case Number: **SUP-38806** APN: 125-36-301-001
Name of Property Owner: BABB Investments, LLC
Name of Applicant: Challenger School
Name of Representative: Fred Healey

To the best of your knowledge, does the Mayor or any member of the City Council or Planning Commission have any financial interest in this or any other property with the property owner, applicant, the property owner or applicant's general or limited partners, or an officer of their corporation or limited liability company?

☐ Yes

☒ No

If yes, please indicate the member of the City Council or Planning Commission who is involved and list the name(s) of the person or persons with whom the City Official holds an interest. Also list the Assessor's Parcel Number if the property in which the interest is held is different from the case parcel.

City Official: _____

Partner(s): _____

APN: _____



Signature of Property Owner: _____

Print Name: Barbara B Baker

Subscribed and sworn before me

This 6th day of July, 20 10

Notary Public in and for said County and State

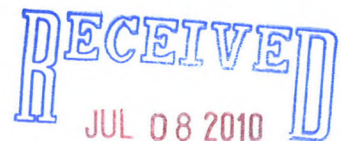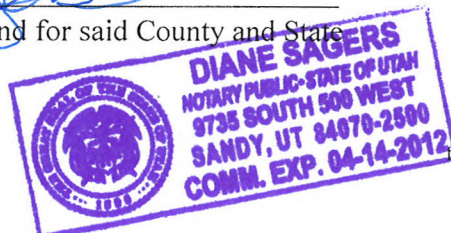

PLANNING & DEVELOPMENT DEPARTMENT

APPLICATION / PETITION FORM

Application/Petition For: Challenger School
 Project Address (Location) 5150 North Jones Blvd. LAS Vegas NV
 Project Name Challenger - Los PRADOS Proposed Use Kindergarten - 1st
 Assessor's Parcel #(s) 125-36-301-001 Ward # _____
 General Plan: existing X proposed _____ Zoning: existing X ~~RE~~ proposed _____
 Commercial Square Footage _____ Floor Area Ratio _____
 Gross Acres 2.24 Lots/Units N/A Density N/A
 Additional Information _____

PROPERTY OWNER BABB Investments, LLC Contact Robert K. Burr
 Address 9735 S. 500 West Phone: 801-569-2700 Fax: 801-569-3094
 City SANDY State UT Zip 84070
 E-mail Address RBURR@ChallengerSchool.com

APPLICANT Challenger School Contact Fred Healey
 Address 9735 S. 500 W. Phone: _____ Fax: _____
 City SANDY State UT Zip 84070
 E-mail Address FHealey@challengerschool.com

REPRESENTATIVE Fred Healey Contact _____
 Address 9735 S. 500 W Phone: 801-599-5588 Fax: 801-569-3094
 City SANDY State UT Zip 84070
 E-mail Address FHEALEY@Challengerschool.com

Property Owner Signature* Barbara B. Baker


* An authorized agent may sign in lieu of the property owner for Final Maps, Tentative Maps, and Parcel Maps.

Print Name Barbara B. Baker

Subscribed and sworn before me

This 6th day of July, 20 10

Notary Public in and for said County and State

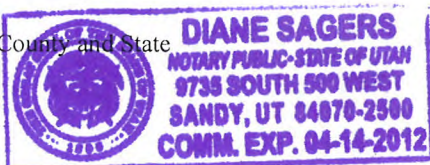


Revised 10/27/08

FOR DEPARTMENT USE ONLY

Case #	<u>SUP - 38806</u>
Meeting Date:	<u>8/26/10</u>
Total Fee:	<u>\$1,030</u>
Date Received:*	<u>7/8/10</u>
Received By:	<u>[Signature]</u>


*The application will not be deemed complete until the submitted materials have been reviewed by the Planning and Development Department for consistency with applicable sections of the Zoning Ordinance.

f:\depot\Application Packet\Application Form.pdf

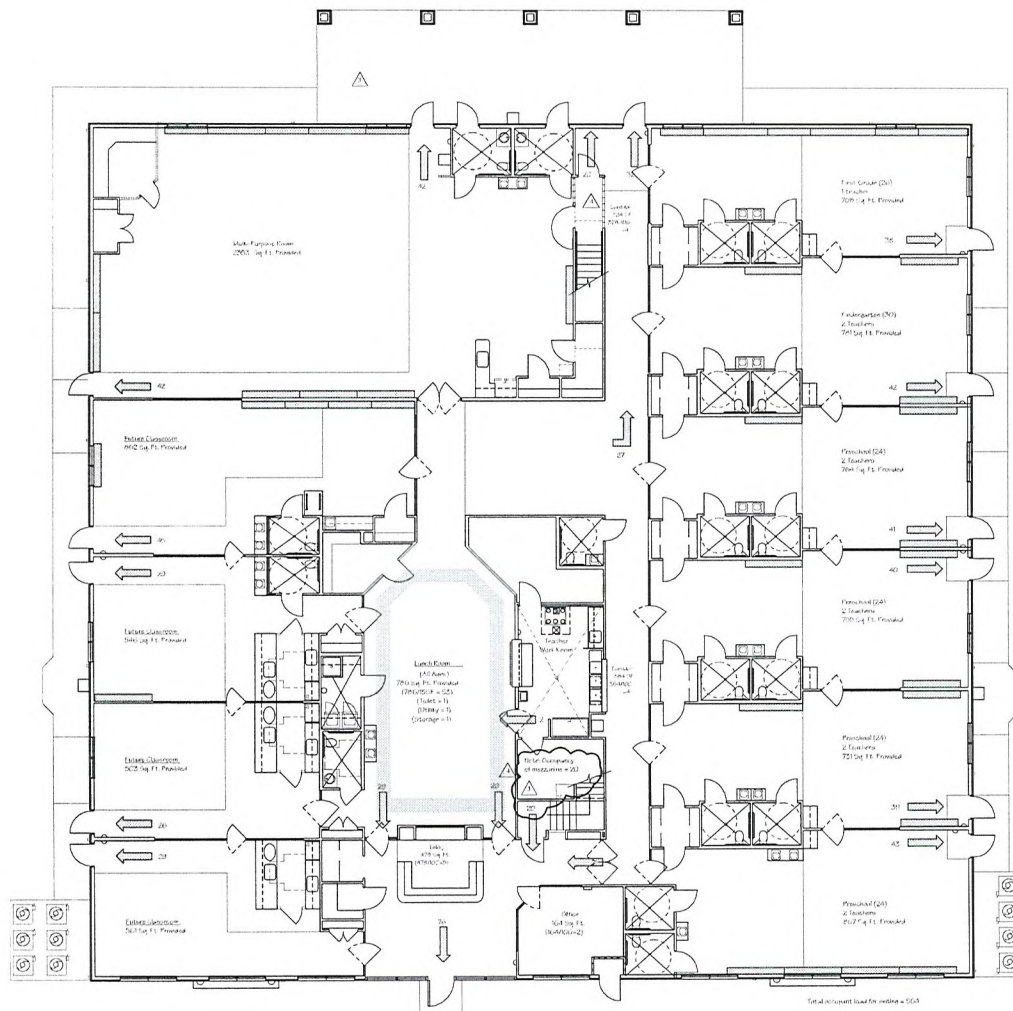

Safety Plan Schedule
 Primary Exit →

1
 A4.2 Licensing and Safety Plan
 1/8" = 1'-0"

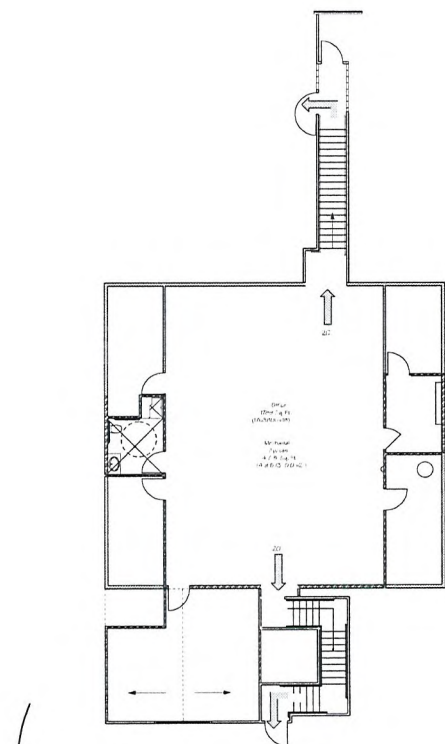

2
 A4.2 2nd Floor Licensing and Safety Plan
 1/8" = 1'-0"

RECEIVED
 JUL 08 2010

No construction alterations may be made, varying from the design in these drawings, without prior written authorization from both F&B "F" File, International, Inc. and Howard S. Baker.

Revisions		
No.	Date	Description
1	2/17/06	City Comments
2	3/6/06	City Comments
3	6/15/06	10th Dept. & 2nd P.
4	10/24/06	Second Floor

HOWARD S. BAKER & ASSOCIATES
 550 W. HARRIS AVENUE, SUITE 100
 LAS VEGAS, NV 89102
 702.799.1122

Drawings For A New
Challenger School
 Washburn Road and Jones Boulevard • Las Vegas, Nevada

SHEET TITLE	
Licensing and Exiting Plan	
PROJECT NUMBER	97004.07
DATE	09 / 21 / 05
SHEET NUMBER	A 4.2

SUP-38806