



PLANNING & DEVELOPMENT DEPARTMENT

STATEMENT OF FINANCIAL INTEREST

Case Number: **SUP-38815** APN: 125-16-318-011

Name of Property Owner: Barbara Aluffi, Ardilla Camarlinghi

Name of Applicant: Angela Horva

Name of Representative: _____

To the best of your knowledge, does the Mayor or any member of the City Council or Planning Commission have any financial interest in this or any other property with the property owner, applicant, the property owner or applicant's general or limited partners, or an officer of their corporation or limited liability company?

☐ Yes

☒ No

If yes, please indicate the member of the City Council or Planning Commission who is involved and list the name(s) of the person or persons with whom the City Official holds an interest. Also list the Assessor's Parcel Number if the property in which the interest is held is different from the case parcel.

City Official: _____

Partner(s): _____

APN: _____

Signature of Property Owner: Barbara Aluffi Ardilla Camarlinghi


Print Name: BARBARA ALUFFI
ARDILLA CAMARLINGHI

Subscribed and sworn before me

This 29th day of June, 2010

C. J. Maffia
Notary Public in and for said County and State
County of Santa Cruz
State of California

Revised 11-14-06

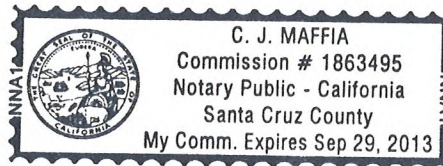

f:\depot\Application Packet Statement of Financial Interest.pdf

RECEIVED
JUL 08 2010

PLANNING & DEVELOPMENT DEPARTMENT

APPLICATION / PETITION FORM

Application/Petition For: Special Use Permit
 Project Address (Location): 7501 N. Cimarron Ste 106 Las Vegas, NV 89131
 Project Name: From Diapers To Dorns Proposed Use: Secondhand Shop
 Assessor's Parcel #(s): 125-16-318-011 Ward #: 6
 General Plan: existing PCD proposed _____ Zoning: existing C1 proposed _____
 Commercial Square Footage: 1400 sq. ft. Floor Area Ratio: _____
 Gross Acres: 1.4 acres Lots/Units: _____ Density: _____
 Additional Information: _____

PROPERTY OWNER: Barbara Aluffi Contact: Barbara Aluffi
 Address: 225 Mt. Herman Rd #73 Phone: 263-6848 Fax: _____
 City: Scotts Valley State: Ca Zip: 95066
 E-mail Address: BELLA22802@aol.com

APPLICANT: Angela Hovda w/From Diapers To Dorns Contact: Angela Hovda
 Address: 8940 Happy Stream Avenue Phone: 702-430-6193 Fax: _____
 City: Las Vegas State: NV Zip: 89143
 E-mail Address: angelahovda@gmail.com

REPRESENTATIVE: Same Contact: _____
 Address: _____ Phone: _____ Fax: _____
 City: _____ State: _____ Zip: _____
 E-mail Address: _____

Arilla Capacci
 Property Owner Signature*: Barbara Aluffi
 *An authorized agent may sign in lieu of the property owner for Final Maps, Tentative Maps, and Parcel Maps.
 Print Name: BARBARA ALUFFI
ARDILLA CAMARLINGHI
 Subscribed and sworn before me
 This 29th day of June, 2010
C. J. Maffia

Notary Public in and for said County and State
County of Santa Cruz
 Revised 10/27/08
State of California

FOR DEPARTMENT USE ONLY


Case #: SVP-38815
 Meeting Date: 8/26/10
 Total Fee: \$1,030
 Date Received: 7/8/10
 Received By: Ben S.

*The application will not be deemed complete until the submitted materials have been reviewed by the Planning and Development Department for consistency with applicable sections of the Zoning Ordinance.

Upload Application Packet Application Form pdf

C. J. MAFFIA
 Commission # 1863495
 Notary Public - California
 Santa Cruz County
 My Comm. Expires Sep 29, 2013

RECEIVED
 JUL 08 2010

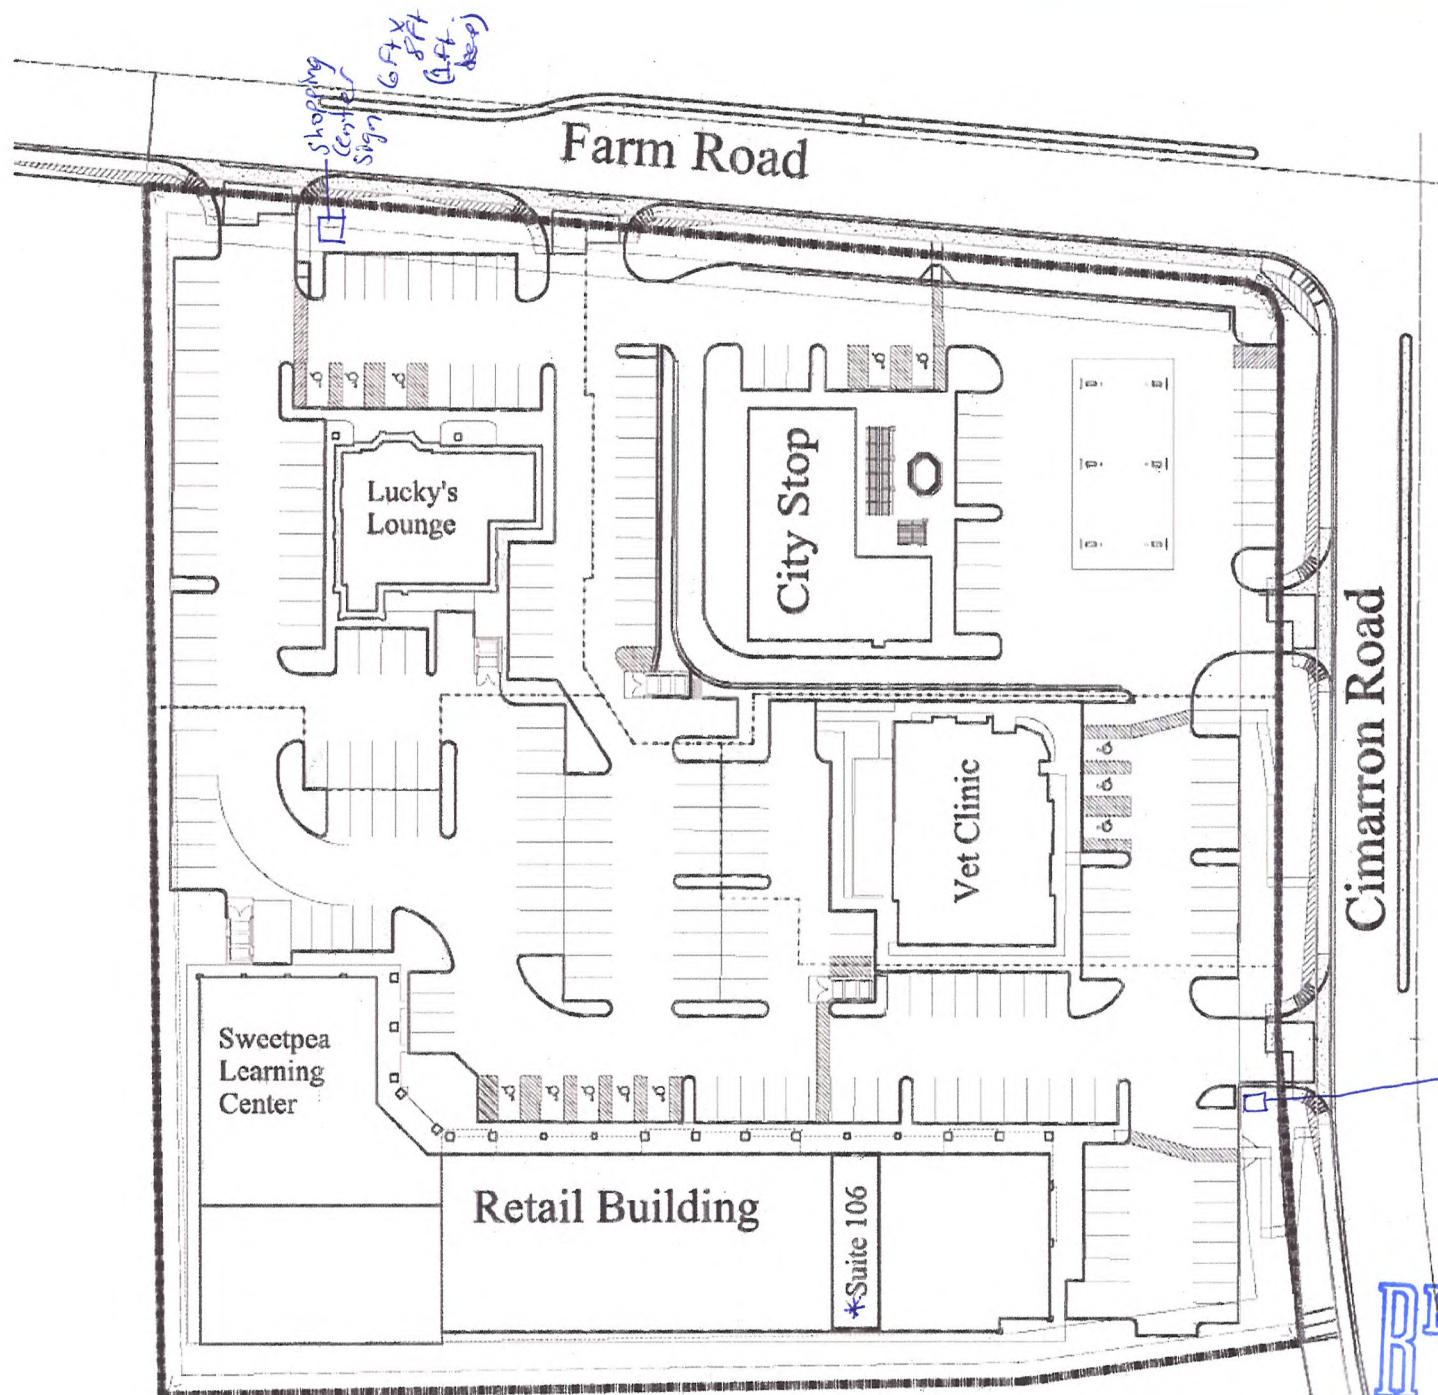

SITE PLAN


SCALE 1"=80'-0"



Shopping center
sign
(1 ft. deep)

RECEIVED
JUL 08 2010

SUP-38815

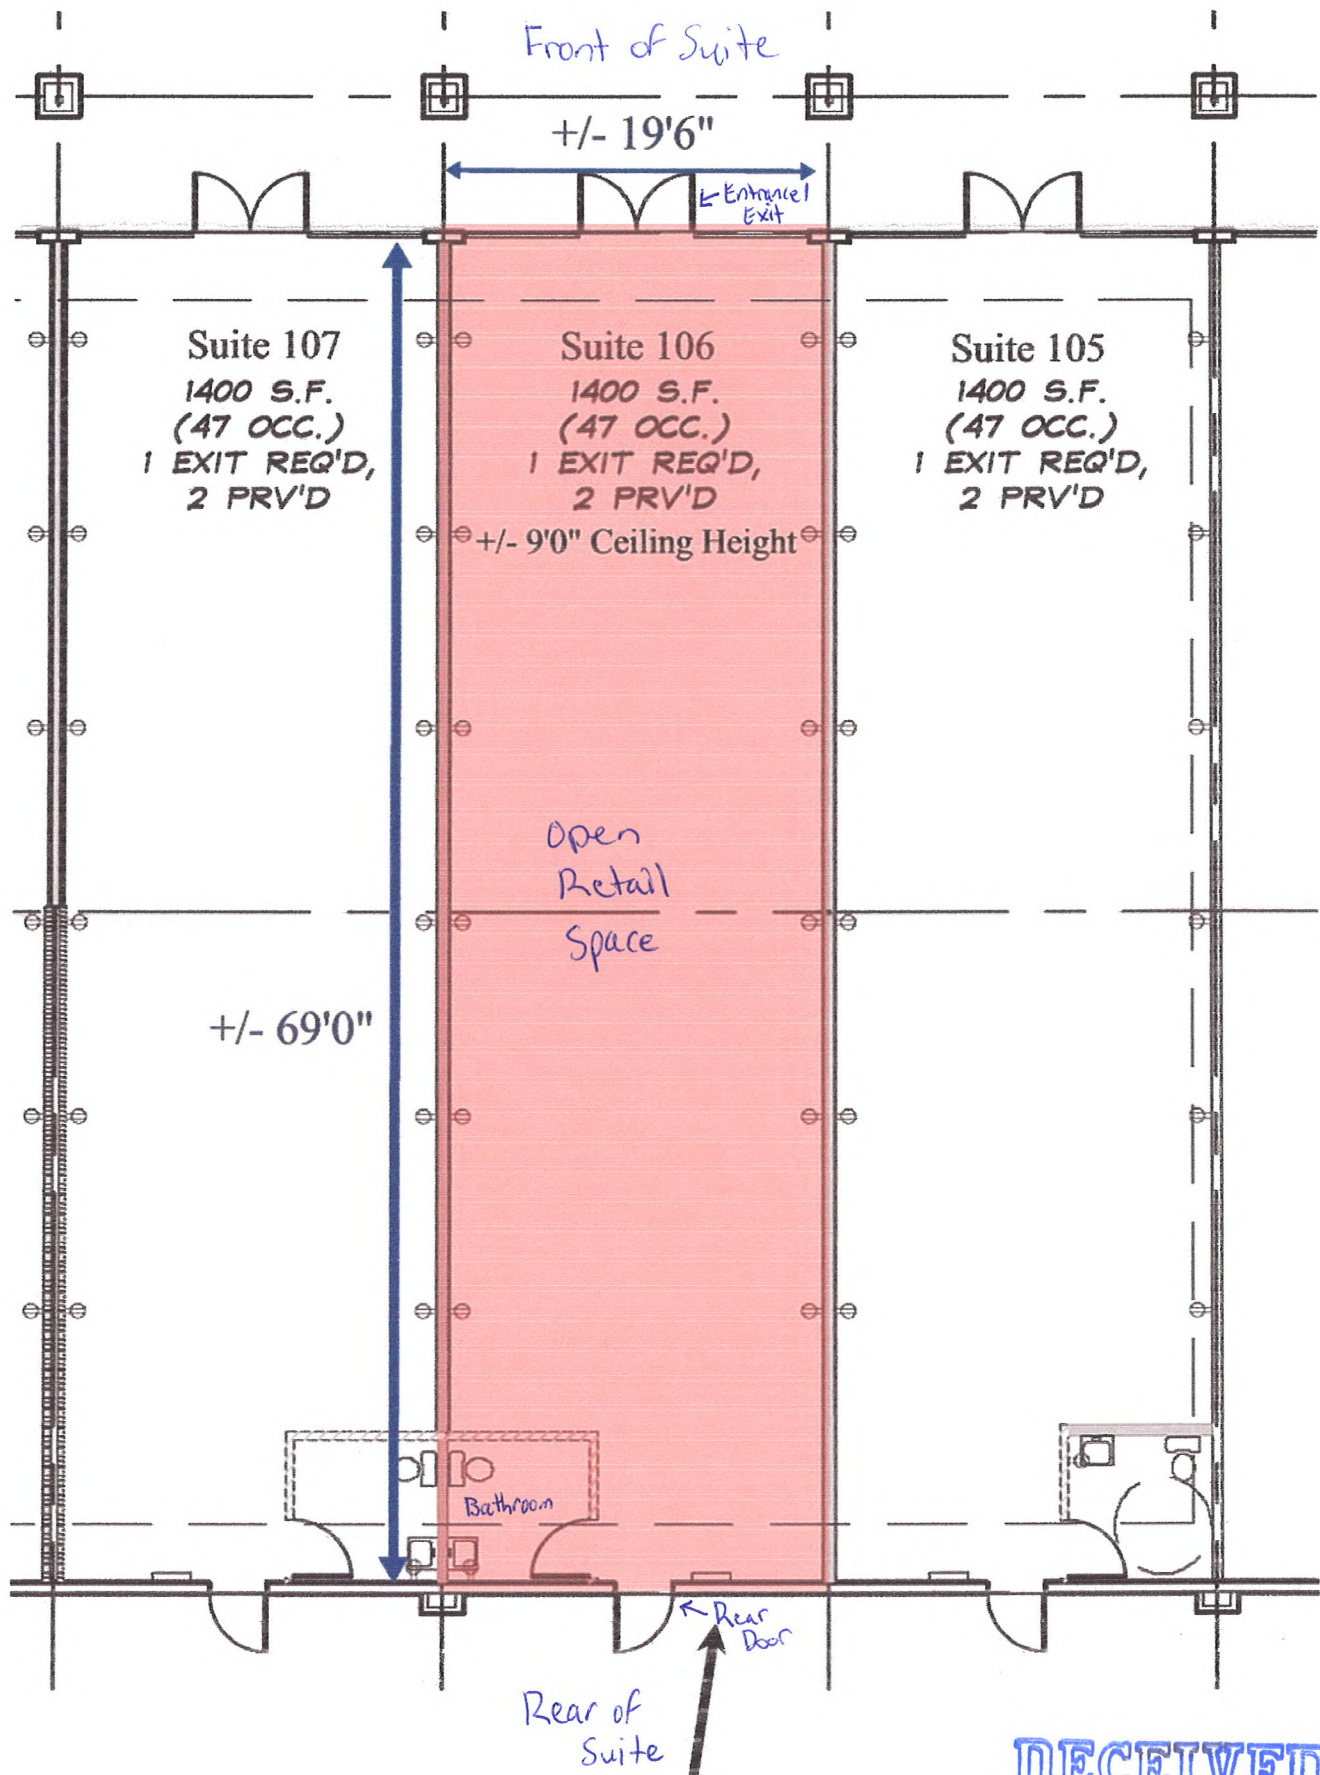

Suite 106

RECEIVED
JUL 08 2010
SUP-38815