



PLANNING & DEVELOPMENT DEPARTMENT

STATEMENT OF FINANCIAL INTEREST

Case Number: **SUP-38996** APN: 138-36-701-018

Name of Property Owner: Charleston Heights Shopping Center, LLC

Name of Applicant: RP Slots, LLC

Name of Representative: _____

To the best of your knowledge, does the Mayor or any member of the City Council or Planning Commission have any financial interest in this or any other property with the property owner, applicant, the property owner or applicant's general or limited partners, or an officer of their corporation or limited liability company?

☐ Yes


☒ No

If yes, please indicate the member of the City Council or Planning Commission who is involved and list the name(s) of the person or persons with whom the City Official holds an interest. Also list the Assessor's Parcel Number if the property in which the interest is held is different from the case parcel.

City Official: _____

Partner(s): _____


APN: _____

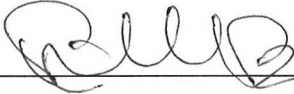Signature of Property Owner: 

Print Name: Barry W. Becker

Subscribed and sworn before me

This 01 day of July, 2010

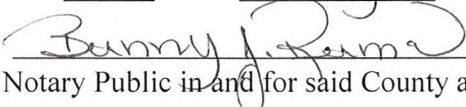
Notary Public in and for said County and State



RECEIVED
JUL 27 2010

PLANNING & DEVELOPMENT DEPARTMENT

APPLICATION / PETITION FORM

Application/Petition For: RP Slots LLC
 Project Address (Location) 542 S. Decatur
 Project Name RP Slots, LLC Proposed Use Gaming General Business
 Assessor's Parcel #(s) 13836701018 Ward # 1
 General Plan: existing SC proposed _____ Zoning: existing C-1 proposed _____
 Commercial Square Footage 6440 sq ft Floor Area Ratio _____
 Gross Acres 1.16 Lots/Units _____ Density _____
 Additional Information _____

PROPERTY OWNER Charleston Heights Shopping Center, LLC Contact _____
 Address 50 S. Jones Phone: _____ Fax: _____
 City Las Vegas State NV Zip 89107
 E-mail Address _____

APPLICANT RP Slots, LLC Contact Roger Szepelak
 Address 542 S. Decatur Phone: 283-1088 Fax: 870-1063
 City Las Vegas State NV Zip 89107
 E-mail Address RM5264@hotmail.com

REPRESENTATIVE _____ Contact _____
 Address _____ Phone: _____ Fax: _____
 City _____ State _____ Zip _____
 E-mail Address _____

Property Owner Signature* [Signature]

* An authorized agent may sign in lieu of the property owner for Final Maps, Tentative Maps, and Parcel Maps.

Print Name Bunny W. Becker


Subscribed and sworn before me

This 21 day of July, 20 10

Bunny J. Reiman

Notary Public in and for said County and State

Revised 10/27/08

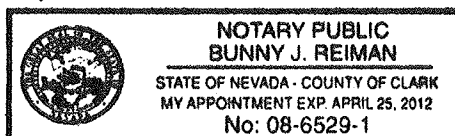

FOR DEPARTMENT USE ONLY

Case #	<u>SUP-38996</u>
Meeting Date:	<u>9/23/10 PL</u>
Total Fee:	<u>\$1,030</u>
Date Received:	<u>7/27/10</u>
Received By:	<u>[Signature]</u>

*The application will not be deemed complete until the submitted materials have been reviewed by the Planning and Development Department for consistency with applicable sections of the Zoning Ordinance.

f:\depot\Application Packet\Application Form.pdf


138-36-701-018

Building setback: 120 ft.

Building setback: 130 ft.

ADA-compliant
entrance.


TOTAL SELF PARKING = 952 SPAC
TOTAL EMPLOYEE PARKING = 284 SPAC
TOTAL VALET PARKING = 194 SPAC
TOTAL ON-SITE PARKING = 1,430 SPAC

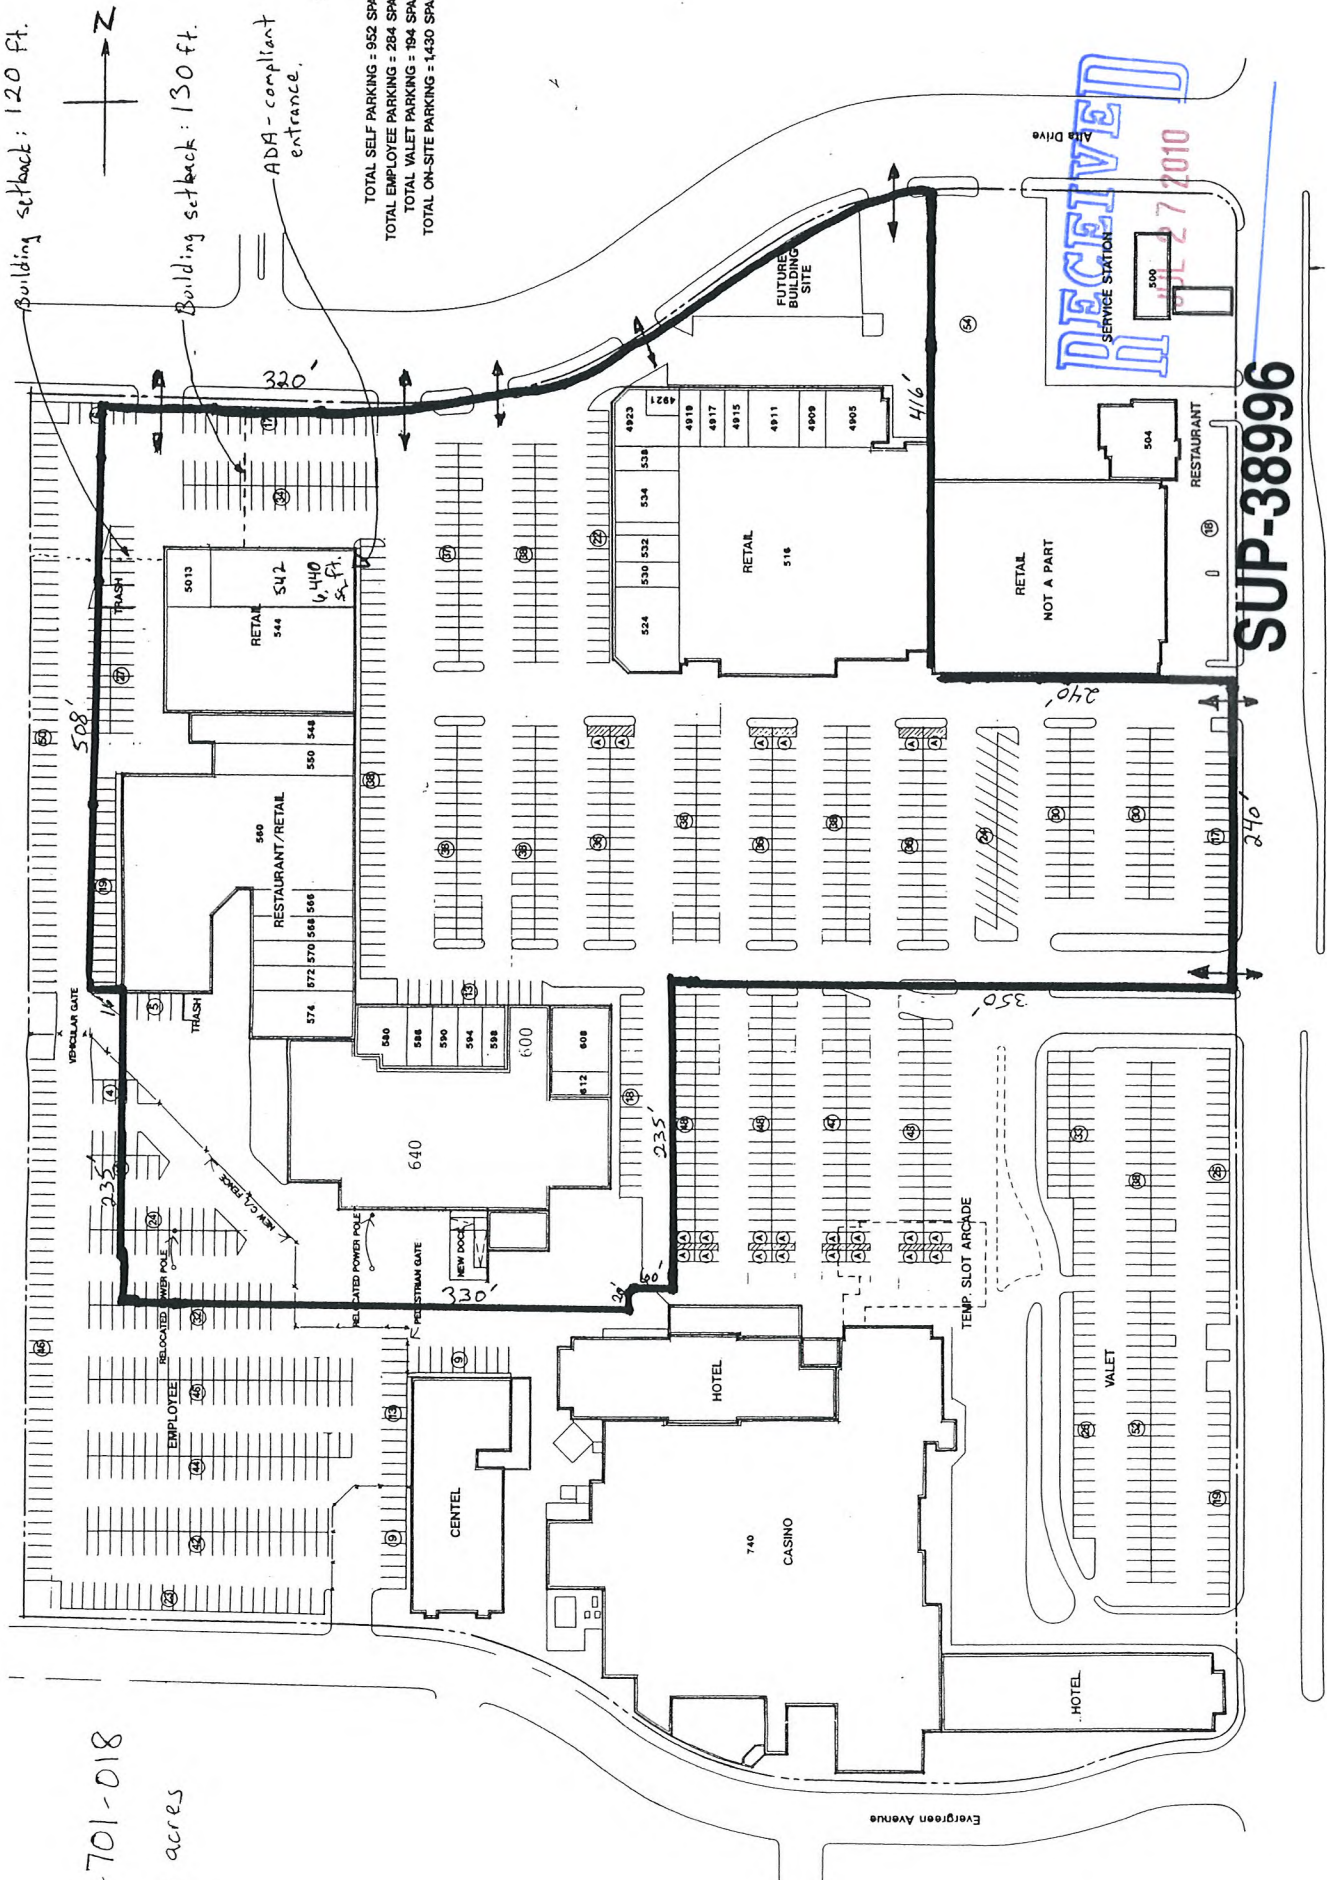

SUP-38996

DECATUR URUG
542 S. Decatur
Las Vegas

N
↑

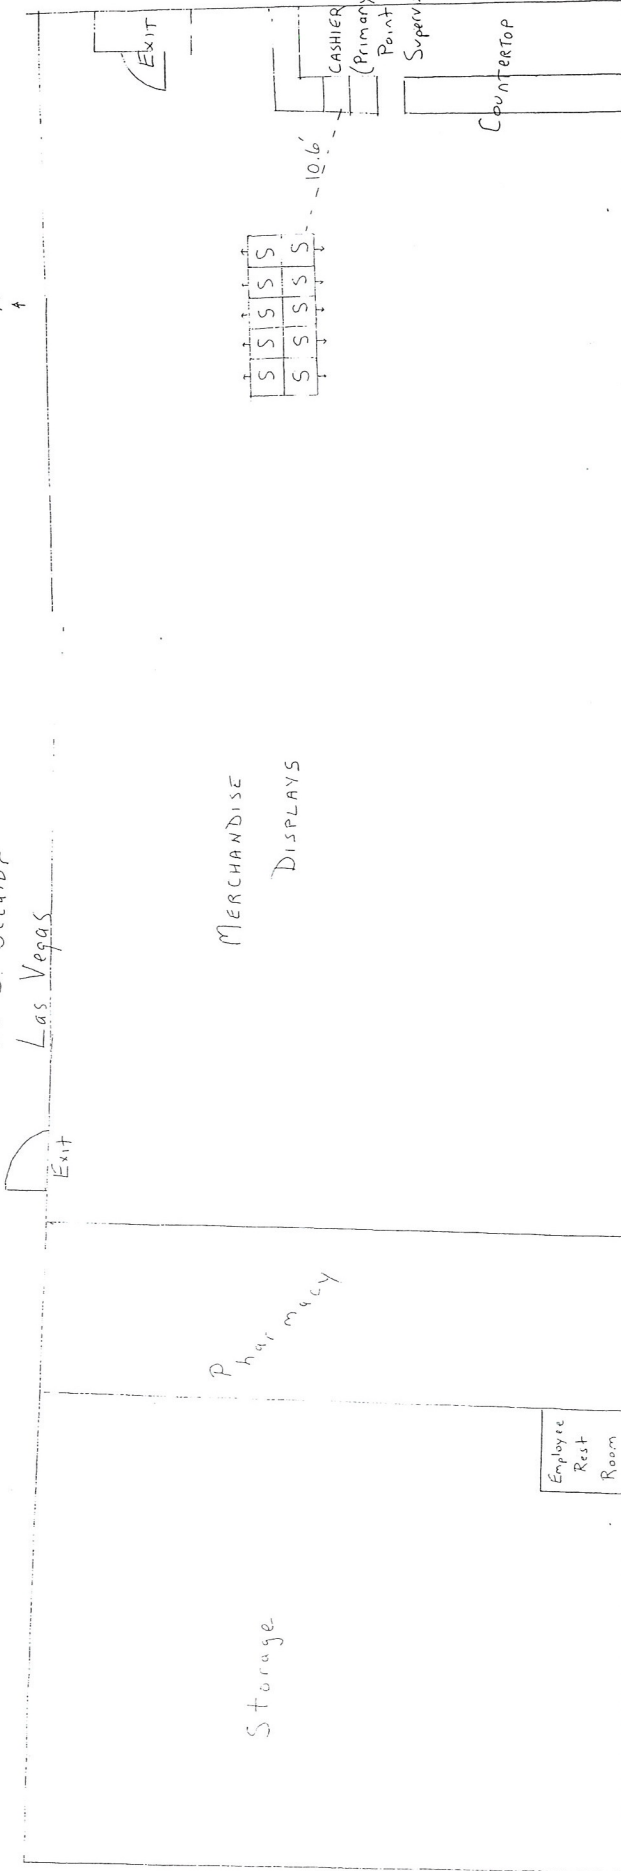

LENGTH = 140' WIDTH = 40'
Sq Ft = 6,440 sq ft

Public Space: 4,300 sq ft

5-22-07

RECEIVED
JUL 27 2010
SUP-38996