



PLANNING & DEVELOPMENT DEPARTMENT

STATEMENT OF FINANCIAL INTEREST

Case Number: **SUP-42254** APN: 138-22-610-012
Name of Property Owner: CHZ HSUAN WU.
Name of Applicant: GLORIELL HOLDINGS, LLC
Name of Representative: _____

To the best of your knowledge, does the Mayor or any member of the City Council or Planning Commission have any financial interest in this or any other property with the property owner, applicant, the property owner or applicant's general or limited partners, or an officer of their corporation or limited liability company?

☐ Yes

☒ No

If yes, please indicate the member of the City Council or Planning Commission who is involved and list the name(s) of the person or persons with whom the City Official holds an interest. Also list the Assessor's Parcel Number if the property in which the interest is held is different from the case parcel.

City Official: _____

Partner(s): _____

APN: _____

Signature of Property Owner: Chi Hsuan Wu.

Print Name: CHZ HSUAN WU.

Subscribed and sworn before me


This 7th day of June, 20 11

[Signature]
Notary Public in and for said County and State

RECEIVED

JUN 23 2011

City of Las Vegas

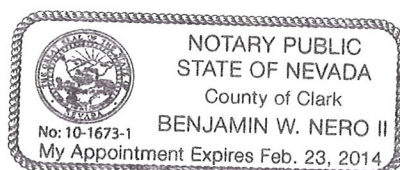

PLANNING & DEVELOPMENT DEPARTMENT

APPLICATION / PETITION FORM

Application/Petition For: SPECIAL USE PERMIT BEER/WINE-COOLER ON-SALE EST.
 Project Address (Location) 2131 ROCK SPRINGS DR. LAS VEGAS, NV 89128
 Project Name PANCIT-ADOBO FILIPINO RESTAURANT Proposed Use _____
 Assessor's Parcel #(s) 138-22-610-012 Ward # 1-TARKANIAN
 General Plan: existing ISC proposed NO CHANGE Zoning: existing C1 proposed NO CHANGE
 Commercial Square Footage _____ Floor Area Ratio _____
 Gross Acres 1.13 Lots/Units _____ Density _____
 Additional Information _____

PROPERTY OWNER CHIT I-SHAN WU Contact _____
 Address 76 Copper Fountain St Phone: 360-2225 Fax: _____
 City Las Vegas State N.V. Zip 89138
 E-mail Address _____

APPLICANT GLORIA ROSELL-ENSLER Contact GLORIA ROSELL-ENSLER
(GLORIELL HOLDINGS, LLC)
 Address 9904 CHARLEMONT DR Phone: 702-452 Fax: _____
3626
 City LAS VEGAS, NV State NV Zip 89134
 E-mail Address MABUHAY@PANCIT-ADOBO.COM

REPRESENTATIVE _____ Contact _____
 Address _____ Phone: _____ Fax: _____
 City _____ State _____ Zip _____
 E-mail Address _____

Property Owner Signature* Chit I-Shan Wu


* An authorized agent may sign in lieu of the property owner for Final Maps, Tentative Maps, and Parcel Maps.

Print Name CHIT I-SHAN WU

Subscribed and sworn before me

This 7th day of June, 20 11

Notary Public in and for said County and State

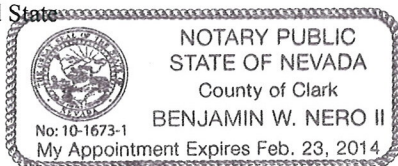

Revised 10/27/08

FOR DEPARTMENT USE ONLY

Case # 54P-42254
 Meeting Date: 8/9/11
 Total Fee: 8,280
 Date Received: 6/23/11
 Received By: Ben

*The application will not be deemed complete until the submitted materials have been reviewed by the Planning and Development Department for consistency with applicable sections of the Zoning Ordinance.


f:\depot\Application Packet\Application Form.pdf

JUN 23 2011

City of Las Vegas




SCALE: 1" = 20'-0"

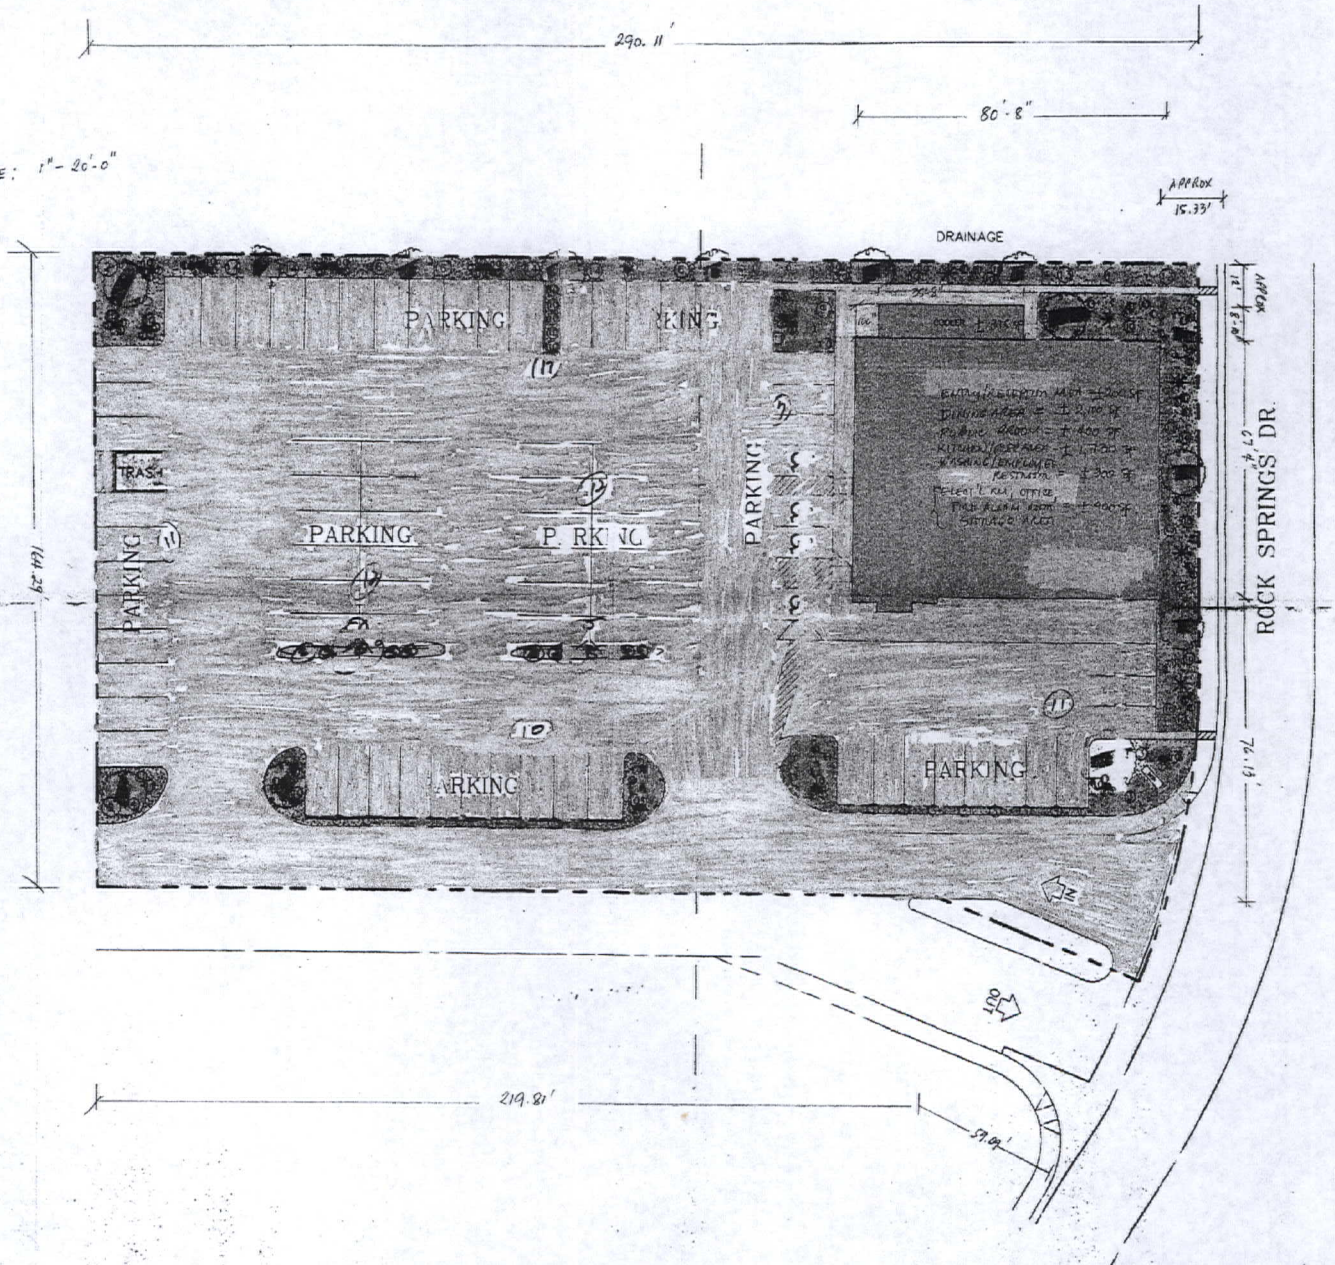

PANUT-ADOBO FILIPINO RESTAURANT

RECEIVED
JUL 05 2011

SUP-42254
REVISED

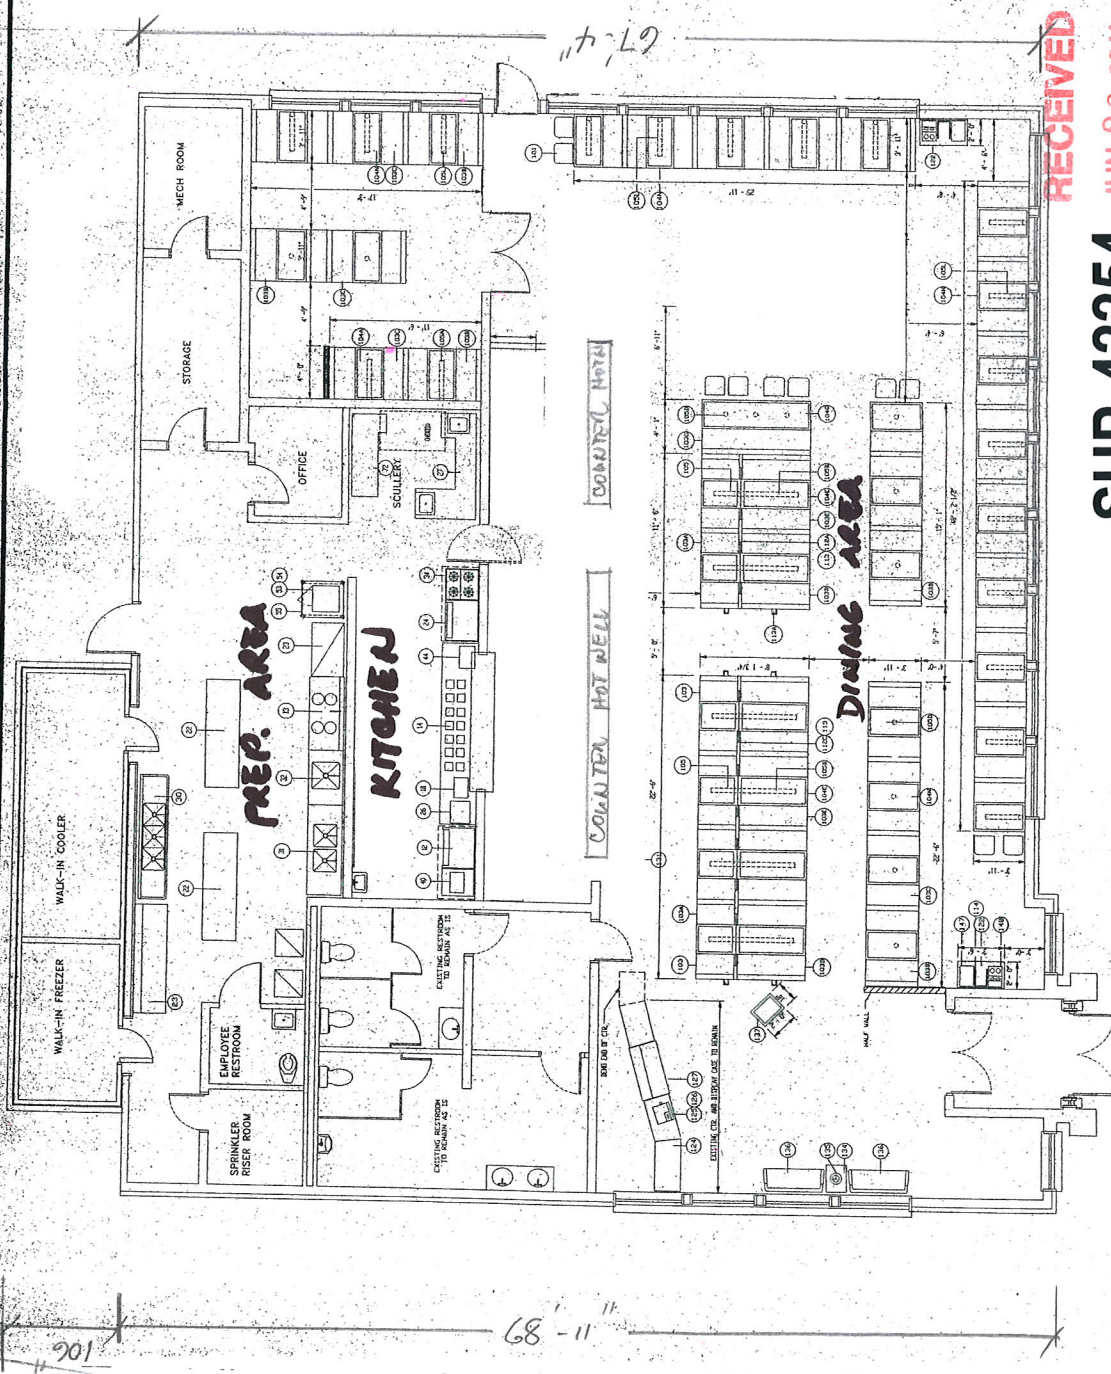



SEATING & TABLE SCHEDULE

TABLE TYPE	TOP	SEAT
STAINLESS	000	000
2 TOPS	6	12
3 TOPS	000	000
4 TOPS	32	128
5 TOPS	0	0
6 TOPS	6	36
TOTALS	44	176

PROJECT - ABOVE
FR. 2557

2131 ROCK SPRINGS ROAD
 LAS VEGAS, NV

SCALE:
 1/4" = 1'-0"

RECEIVED
SUP-42254
JUN 23 2011
 City of Las Vegas

80'-0"

89'-11"