



DEPARTMENT OF PLANNING

STATEMENT OF FINANCIAL INTEREST

Case Number: **GPA-41958** APN: _____

Name of Property Owner: Various

Name of Applicant: City of Las Vegas, Jorge Cervantes

Name of Representative: City of Las Vegas, Randy Fultz

To the best of your knowledge, does the Mayor or any member of the City Council or Planning Commission have any financial interest in this or any other property with the property owner, applicant, the property owner or applicant's general or limited partners, or an officer of their corporation or limited liability company?

☐ Yes

☒ No

If yes, please indicate the member of the City Council or Planning Commission who is involved and list the name(s) of the person or persons with whom the City Official holds an interest. Also list the Assessor's Parcel Number if the property in which the interest is held is different from the case parcel.

City Official: _____

Partner(s): _____

APN: _____


Signature of Property Owner: Jorge Cervantes

Print Name: Jorge Cervantes

Subscribed and sworn before me

This 26th day of May, 2011

Rosana G. Cogle
Notary Public in and for said County and State

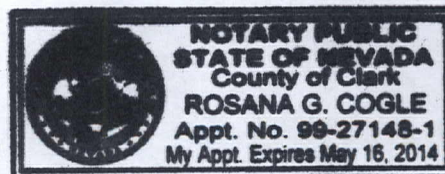

RECEIVED

MAY 26 2011

City of Las Vegas



DEPARTMENT OF PLANNING

APPLICATION / PETITION FORM

Application/Petition For: Master Plan of Streets & Highways Amendment
 Project Address (Location) Northwest Las Vegas (North of Grand Teton & West of Fort Apache)
 Project Name Sheep Mountain Parkway Realignment Proposed Use MSH
 Assessor's Parcel #(s) Various Ward # 6
 General Plan: existing N/A proposed N/A Zoning: existing N/A proposed N/A
 Commercial Square Footage N/A Floor Area Ratio N/A
 Gross Acres N/A Lots/Units N/A Density N/A
 Additional Information Realign Sheep Mountain Parkway between Grand Teton & Fort Apache and delete Master Planned Roadways within Kyle Canyon Development, see attached.

PROPERTY OWNER Various Contact _____
 Address _____ Phone: _____ Fax: _____
 City _____ State _____ Zip _____
 E-mail Address _____

APPLICANT City of Las Vegas Contact Jorge Cervantes
 Address 333 N. Rancho Drive Phone: (702) 229-6276 Fax: (702) 382-0848
 City Las Vegas State NV Zip 89106
 E-mail Address jcervantes@lasvegasnevada.gov

REPRESENTATIVE City of Las Vegas Contact Randy Fultz
 Address 333 N. Rancho Drive Phone: (702) 229-2176 Fax: (702) 382-8551
 City Las Vegas State NV Zip 89106
 E-mail Address rfultz@lasvegasnevada.gov

Property Owner Signature* Jorge Cervantes
 * An authorized agent may sign in lieu of the property owner for Final Maps, Tentative Maps, and Parcel Maps.
 Print Name Jorge Cervantes


Subscribed and sworn before me
 This 26th day of May, 20 11.
Rosana G. Cogle

Notary Public in and for said County and State


Revised 10/27/08

FOR DEPARTMENT USE ONLY

Case #	<u>GPA-4185B</u>
Meeting Date:	<u>7-12-11</u>
Total Fee:	
Date Received:	<u>5-26-11</u>
Received By:	<u>JS.</u>

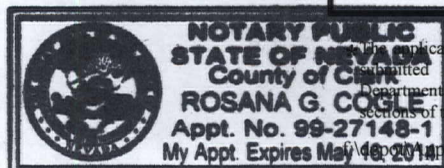


Application will not be deemed complete until the submitted materials have been reviewed by the Department of Planning for consistency with applicable sections of the Zoning Ordinance.
 Application Packet/Application Form.pdf

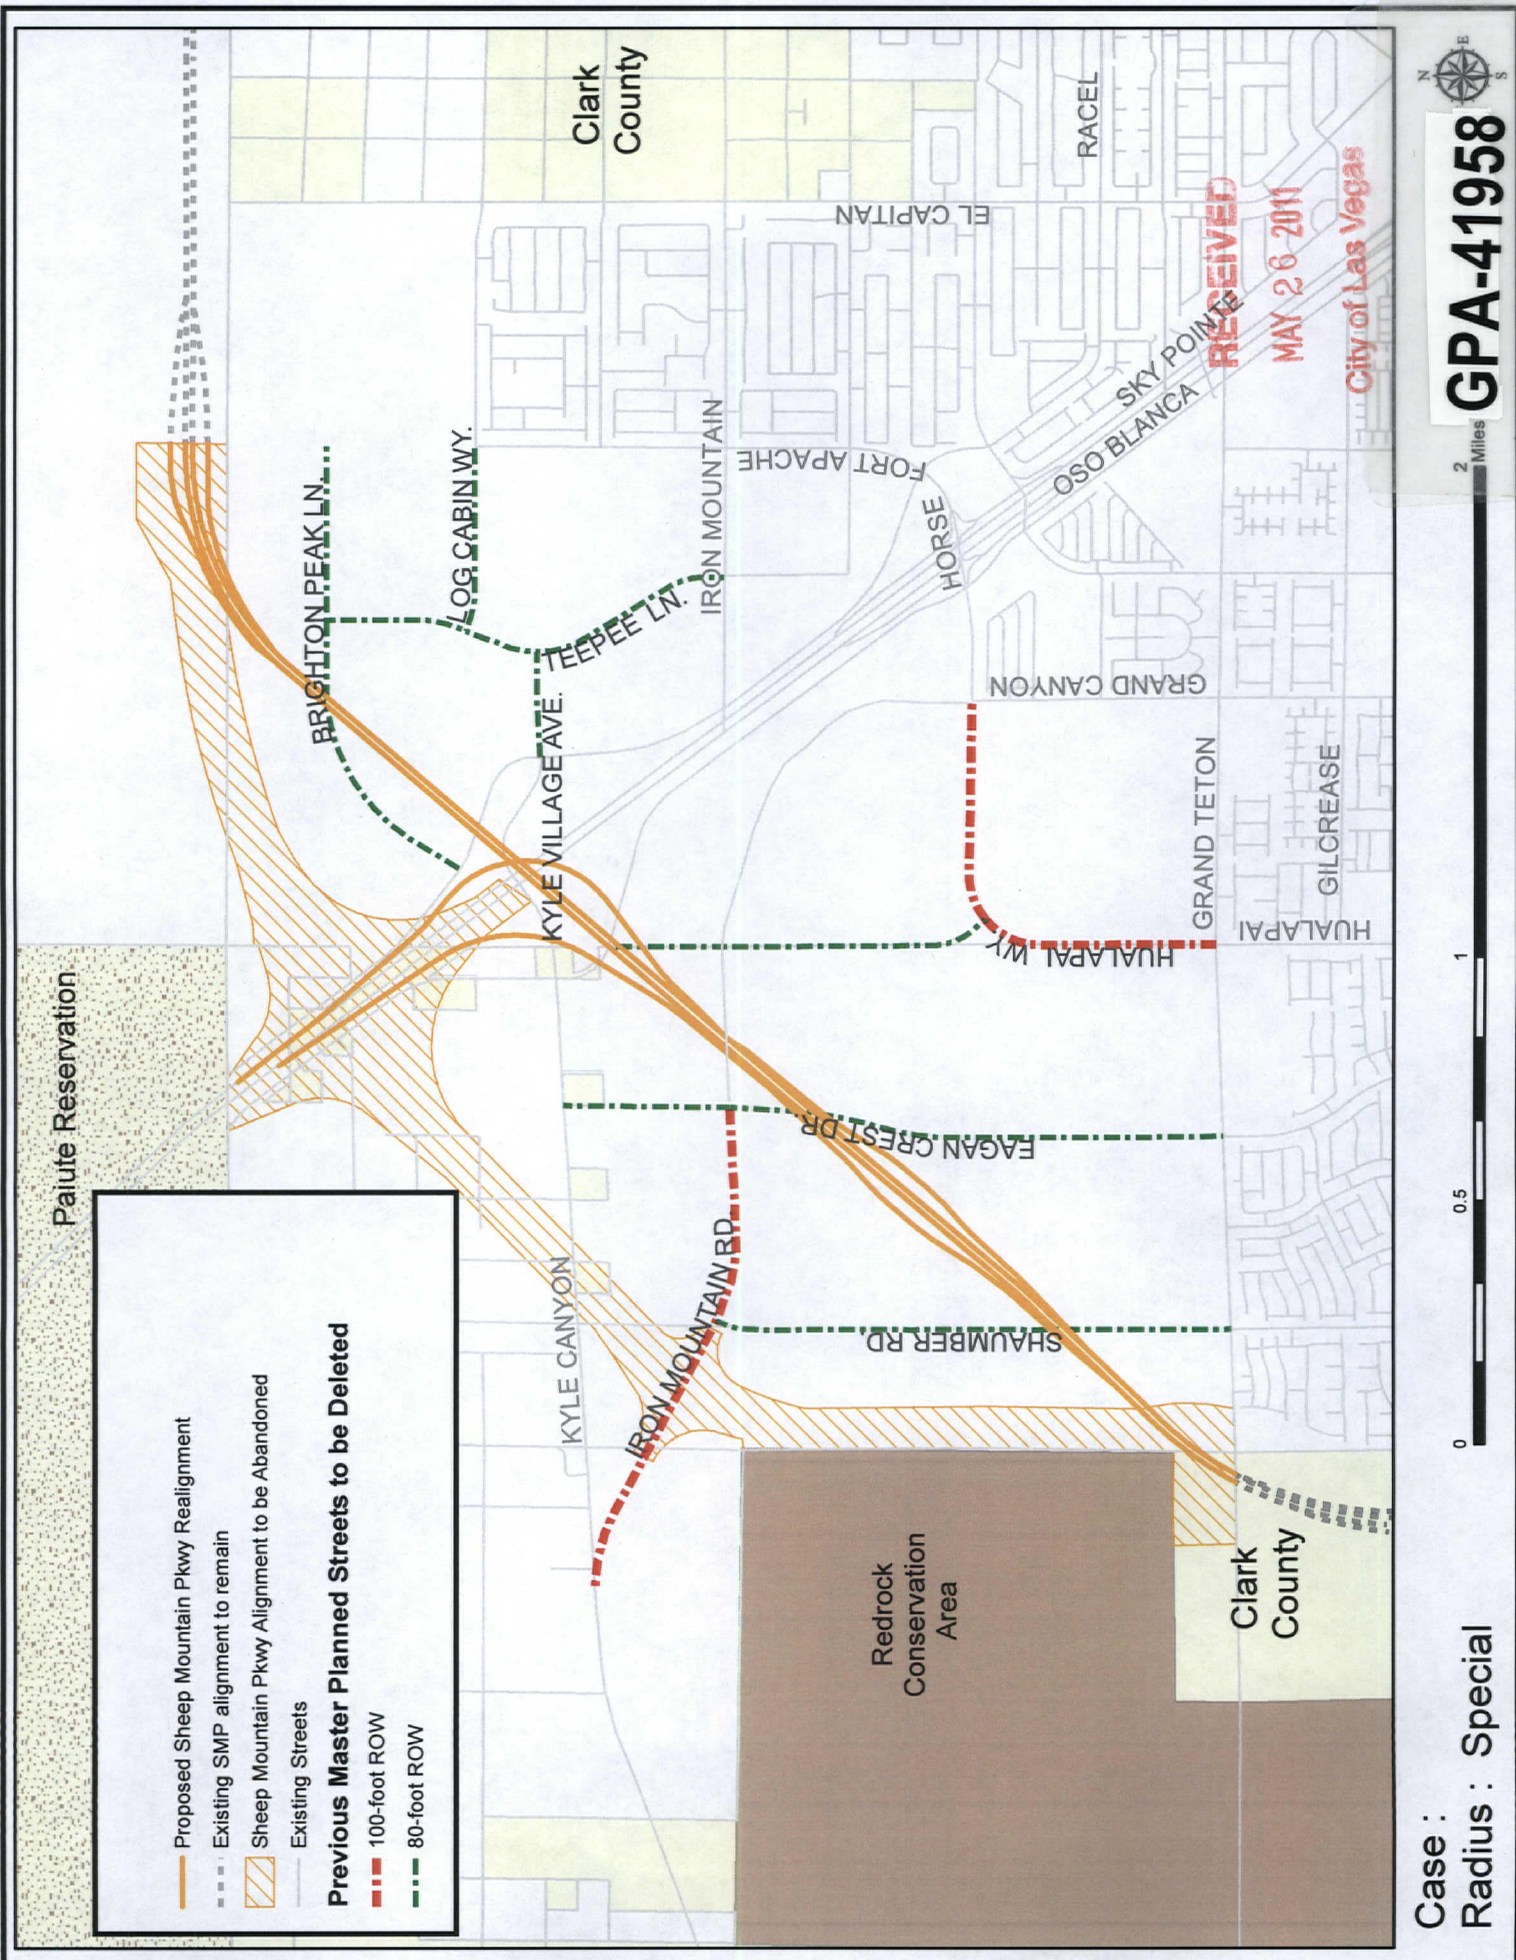

- Proposed Sheep Mountain Pkwy Realignment
 - Existing SMP alignment to remain
 - Sheep Mountain Pkwy Alignment to be Abandoned
 - Existing Streets
- Previous Master Planned Streets to be Deleted**
- 100-foot ROW
 - 80-foot ROW

Case :
Radius : Special

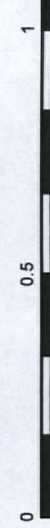

GPA-41958