



## STATEMENT OF FINANCIAL INTEREST

Name of Representative: Rod Carter

To the best of your knowledge, does the Mayor or any member of the City Council or Planning Commission have any financial interest in this or any other property with the property owner, applicant, the property owner or applicant's general or limited partners, or an officer of their corporation or limited liability company?


           Yes            **x** No

If yes, please indicate the member of the City Council or Planning Commission who is involved and list the name(s) of the person or persons with whom the City Official holds an interest. Also list the Assessor's Parcel Number if the property in which the interest is held is different from the case parcel.

City Official: \_\_\_\_\_

Partner(s): \_\_\_\_\_

APN:

 
→ Signature of Property Owner: 

Print Name: Marshall S. Willett

→ Subscribed and sworn before me

This 17<sup>th</sup> day of November, 20 11

Mary Steeb  
Notary Public in and for said County and State

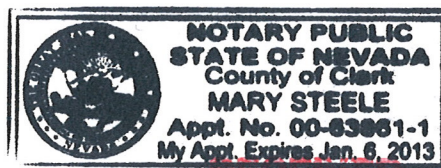

Revised 11-14-06

f:\depot\Application Packet\Statement of Financial Interest.doc

City of Las Vegas



## PLANNING & DEVELOPMENT DEPARTMENT

### APPLICATION / PETITION FORM

Application/Petition For: Required Review 32902

Project Address (Location) 3551 East Bonanza Rd

Project Name Clear Channel Outdoor existing billboard Proposed Use existing

Assessor's Parcel #(s) 140-31-121-006 Ward # 3

General Plan: existing x proposed \_\_\_\_\_ Zoning: existing x proposed \_\_\_\_\_

Commercial Square Footage \_\_\_\_\_ Floor Area Ratio \_\_\_\_\_

Gross Acres \_\_\_\_\_ Lots/Units \_\_\_\_\_ Density \_\_\_\_\_

Additional Information Required Review for an existing billboard located at 3551 E. Bonanza road

PROPERTY OWNER Willick Investments Inc Contact Seth Willick

Address 3591 East Bonanza Phone: \_\_\_\_\_ Fax: \_\_\_\_\_

City Las Vegas State NV Zip 89110

APPLICANT Clear Channel Outdoor Contact Rod Carter

Address 2880-B Meade Ave., Suite 350 Phone: (702) 238-7209 Fax: (702) 238-7266

City Las Vegas State NV Zip 89102

REPRESENTATIVE Same as Applicant Contact \_\_\_\_\_

Address \_\_\_\_\_ Phone: \_\_\_\_\_ Fax: \_\_\_\_\_

City \_\_\_\_\_ State \_\_\_\_\_ Zip \_\_\_\_\_

Property Owner Signature\* [Signature]

\* An authorized agent may sign in lieu of the property owner for Final Maps, Tentative Maps, and Parcel Maps.


→ Print Name Marsha S. Willick

→ Subscribed and sworn before me

This 7th day of November, 20 11

Mary Steele

Notary Public in and for said County and State

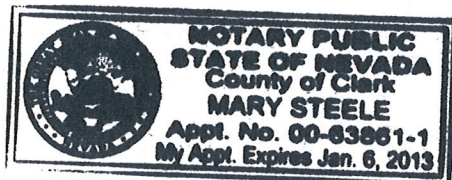

Revised 04/26/05

#### FOR DEPARTMENT USE ONLY

|                |                    |
|----------------|--------------------|
| Case #         | <u>LQR-43801</u>   |
| Meeting Date:  | <u>11/10/12</u>    |
| Total Fee:     | <u>\$800</u>       |
| Date Received: | <u>11/9/11</u>     |
| Received By:   | <u>[Signature]</u> |


\*The application will not be deemed complete until the submitted materials have been reviewed by the Planning and Development Department for consistency with applicable sections of the Zoning Ordinance.

**RECEIVED**  
**NOV 09 2011**

**City of Las Vegas**

f:\depot\Application Packet\Application Form.pdf

BONANZA ROAD

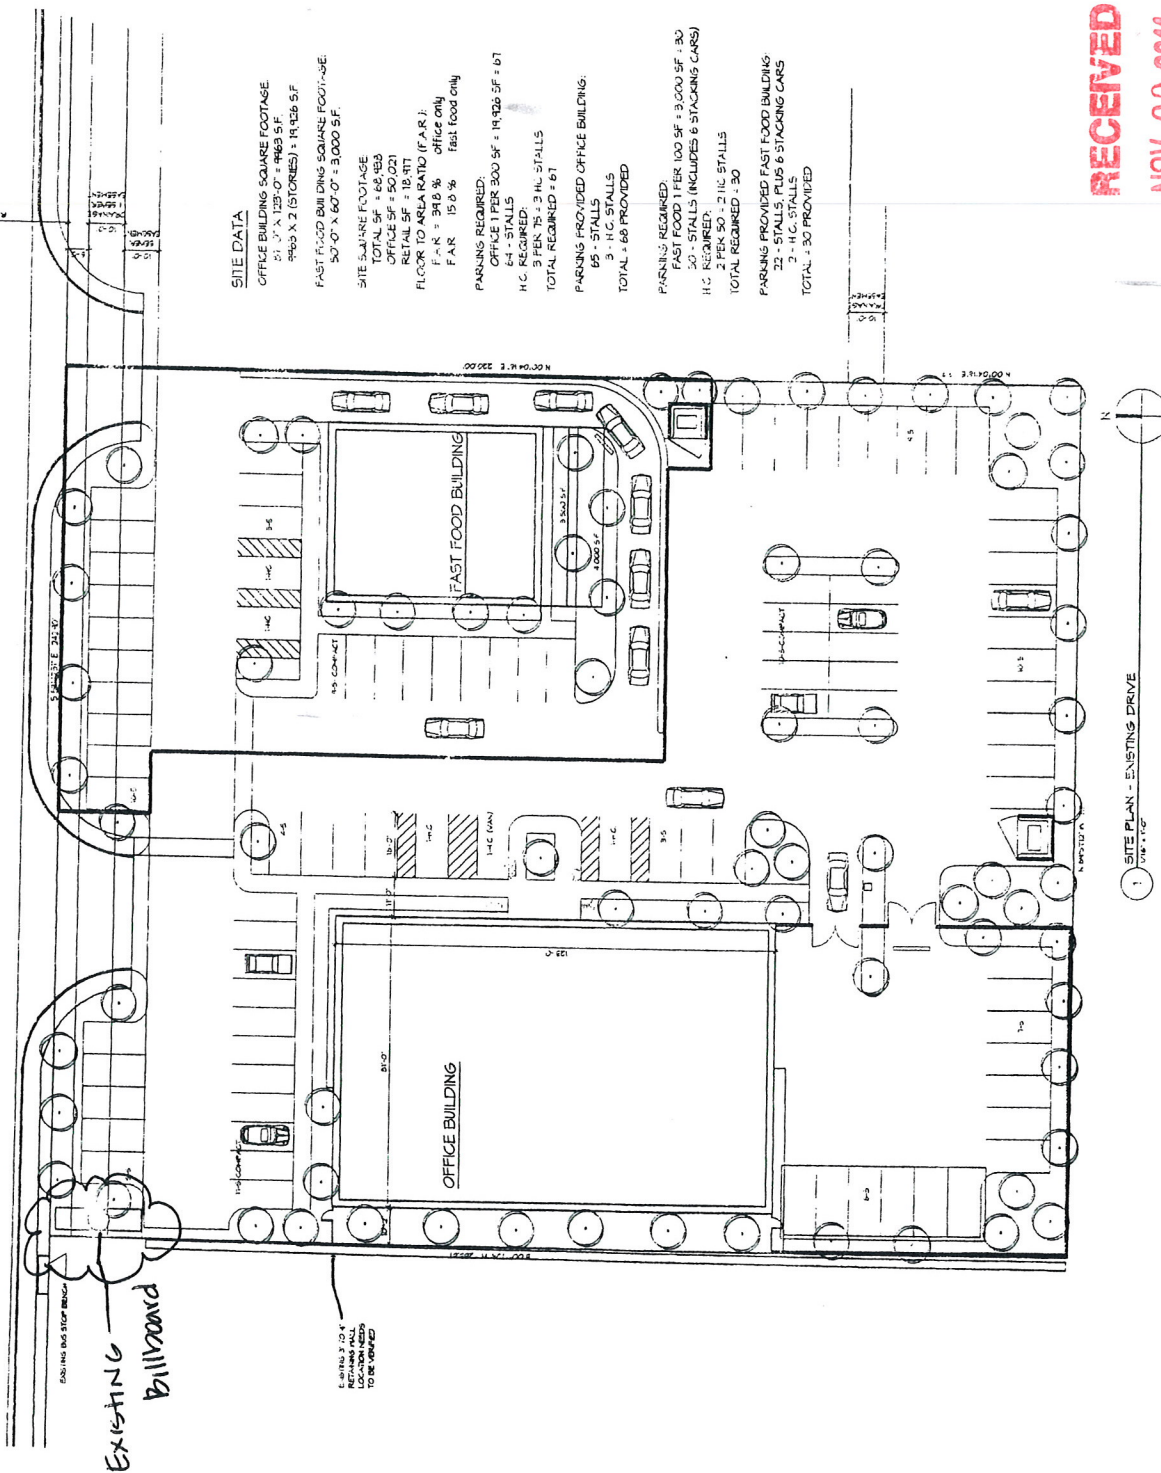

RECEIVED

NOV 09 2011

City of Las Vegas

RQR-43801