



PLANNING & DEVELOPMENT DEPARTMENT

STATEMENT OF FINANCIAL INTEREST

Case Number: ROC-182600 APN: 139-27-401-031

Name of Property Owner: City Parkway IV

Name of Applicant: CBS Outdoor

To the best of your knowledge, does the Mayor or any member of the City Council or Planning Commission have any financial interest in this or any other property with the property owner, applicant, the property owner or applicant's general or limited partners, or an officer of their corporation or limited liability company?

Yes

No

If yes, please indicate the member of the City Council or Planning Commission who is involved and list the name(s) of the person or persons with whom the City Official holds an interest. Also list the Assessor's Parcel Number if the property in which the interest is held is different from the case parcel.

City Official: _____


Partner(s): _____

APN: _____


Signature of Property Owner: *Douglas Selby*
Print Name: Douglas Selby

Subscribed and sworn before me

This 7 day of November, 2006
Kim Barrera
Notary Public in and for said County and State

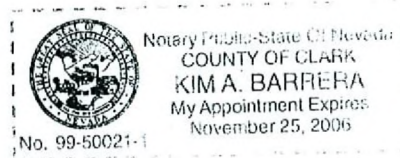

L-3626-01
JES

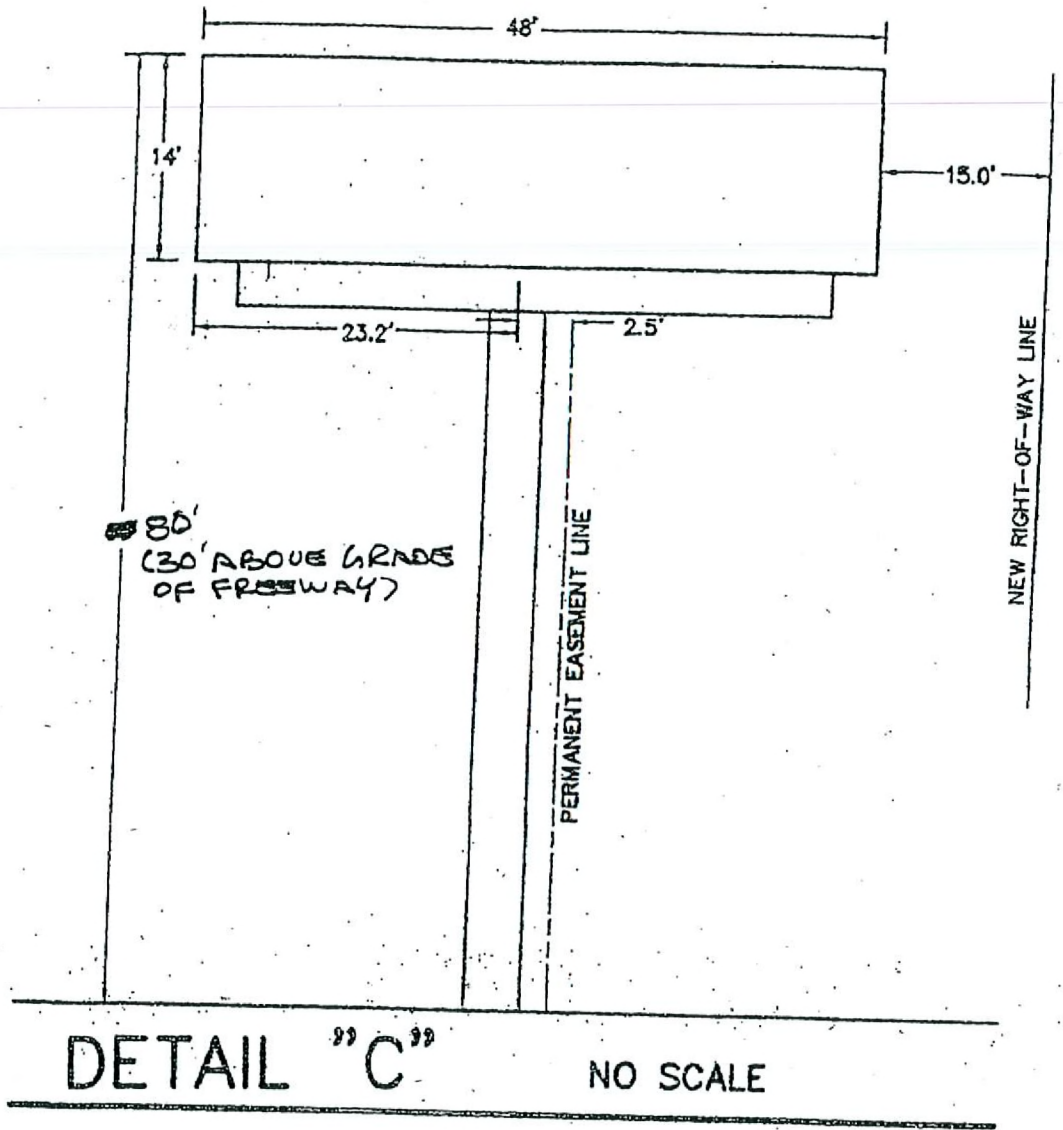


RECEIVED
MAY - 8 2001
CITY OF LAS VEGAS
CENTRAL PERMITS

Spag bowl

ROC-18260
05-02-07 CC

NOV 21

SIGN ELEVATION

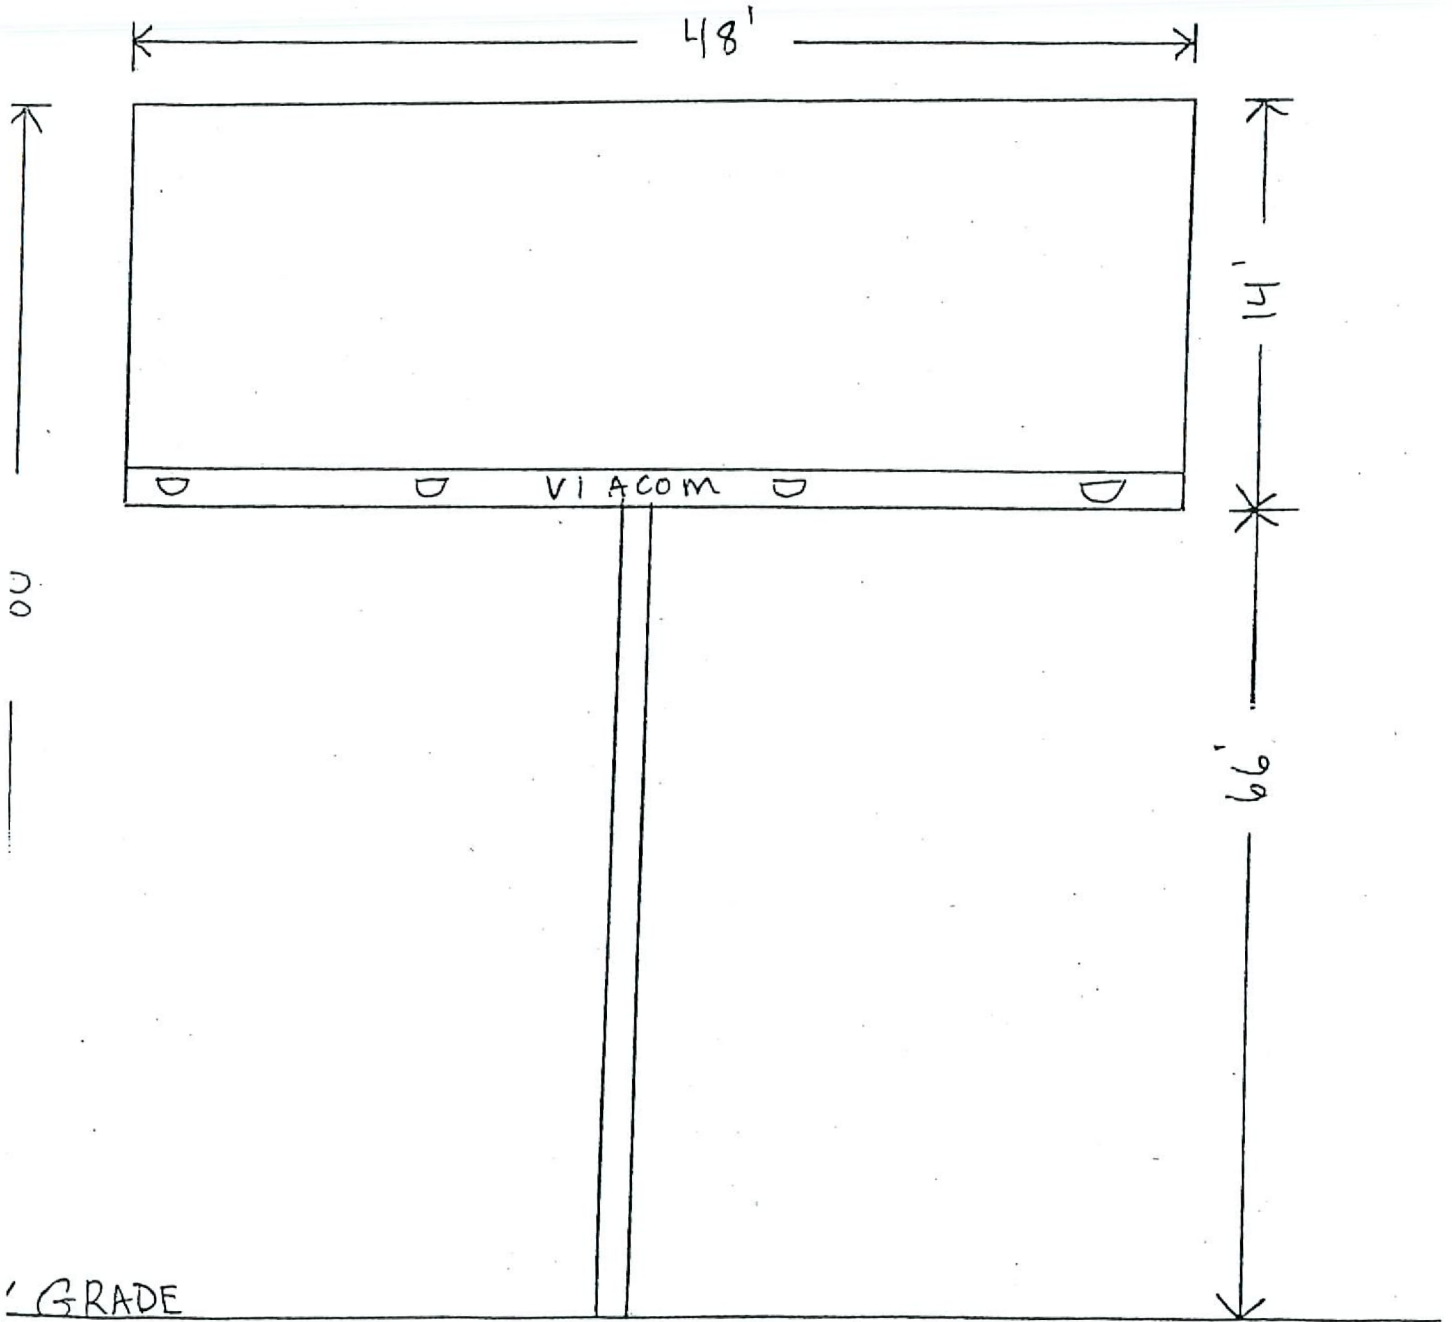

ROC-18260

05-02-07 CC

NOV 21 2006