


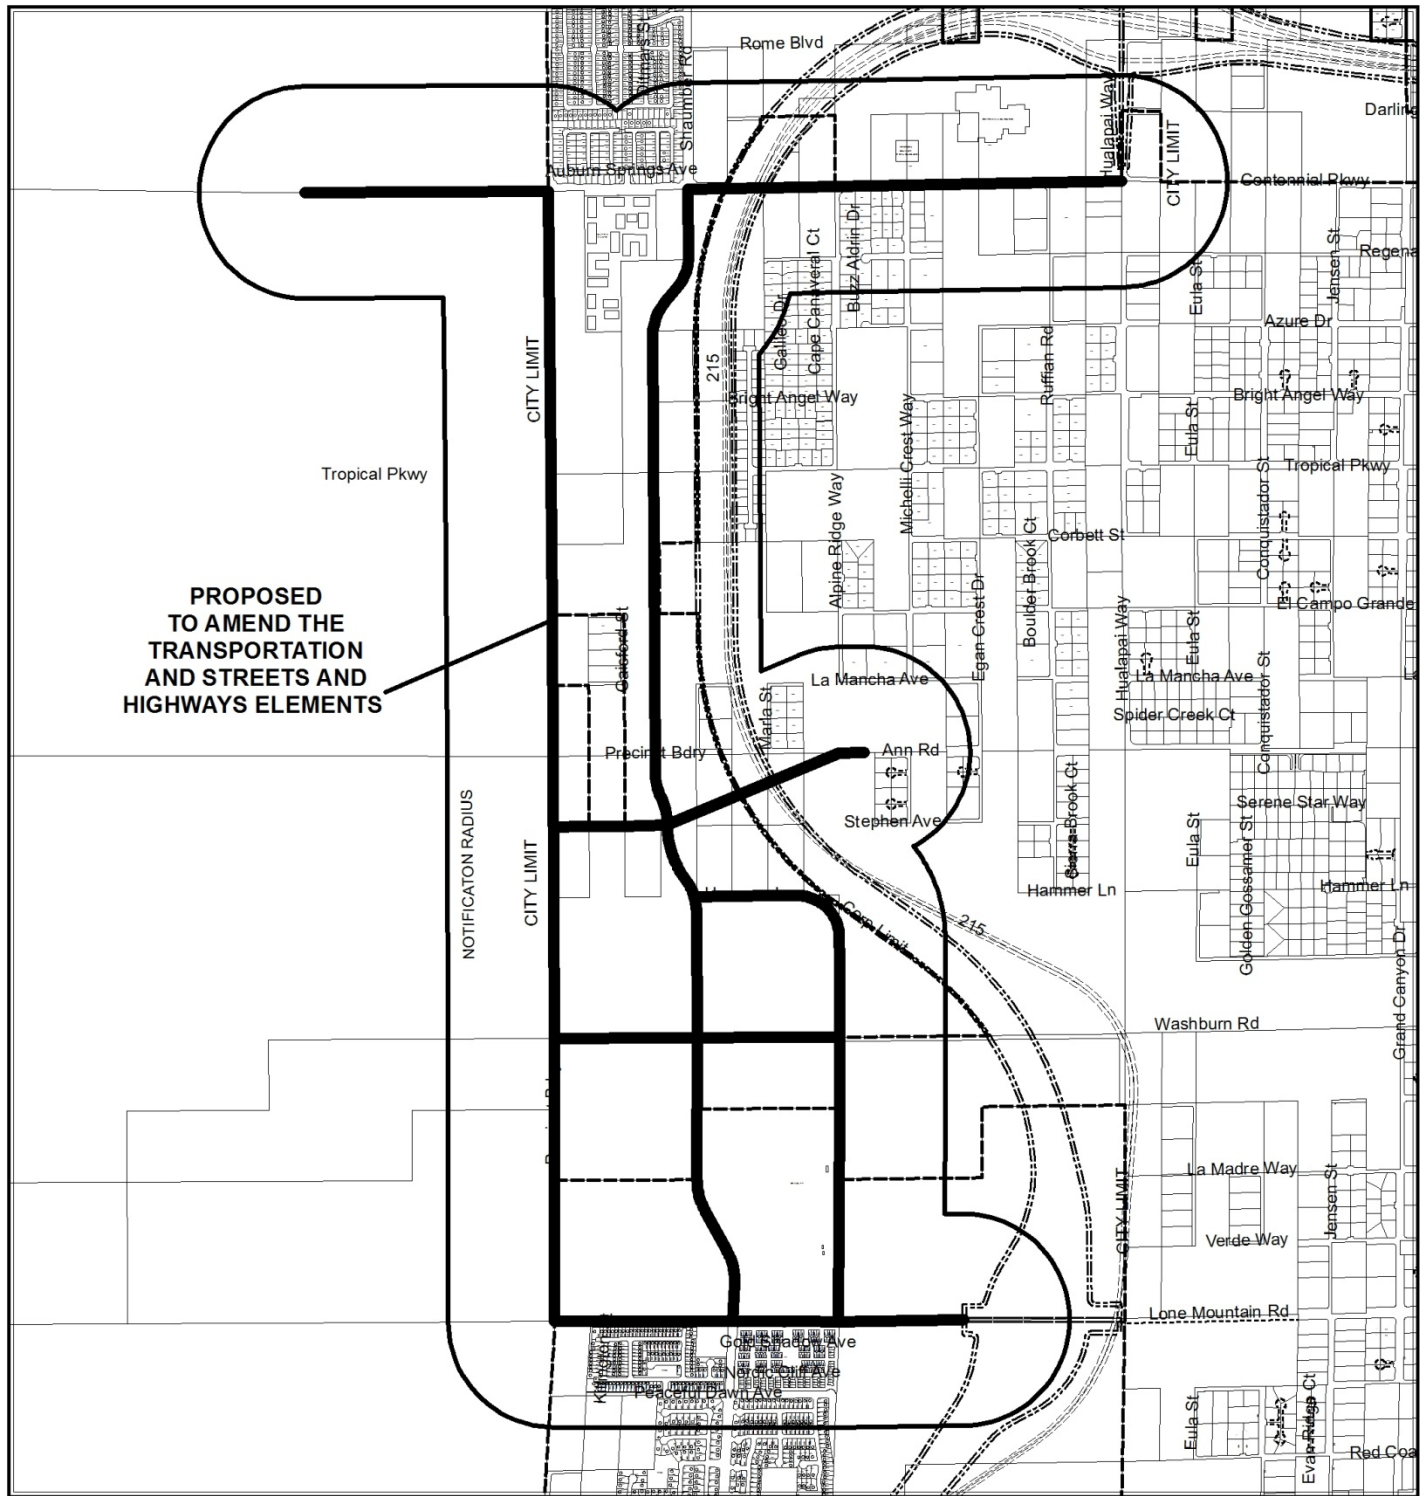

CASE: GPA-53055 (PRJ-52928)

RADIUS: 1000 FEET

