



CASE: GPA-56918 (PRJ-56917)

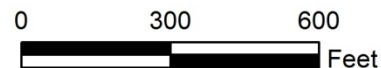

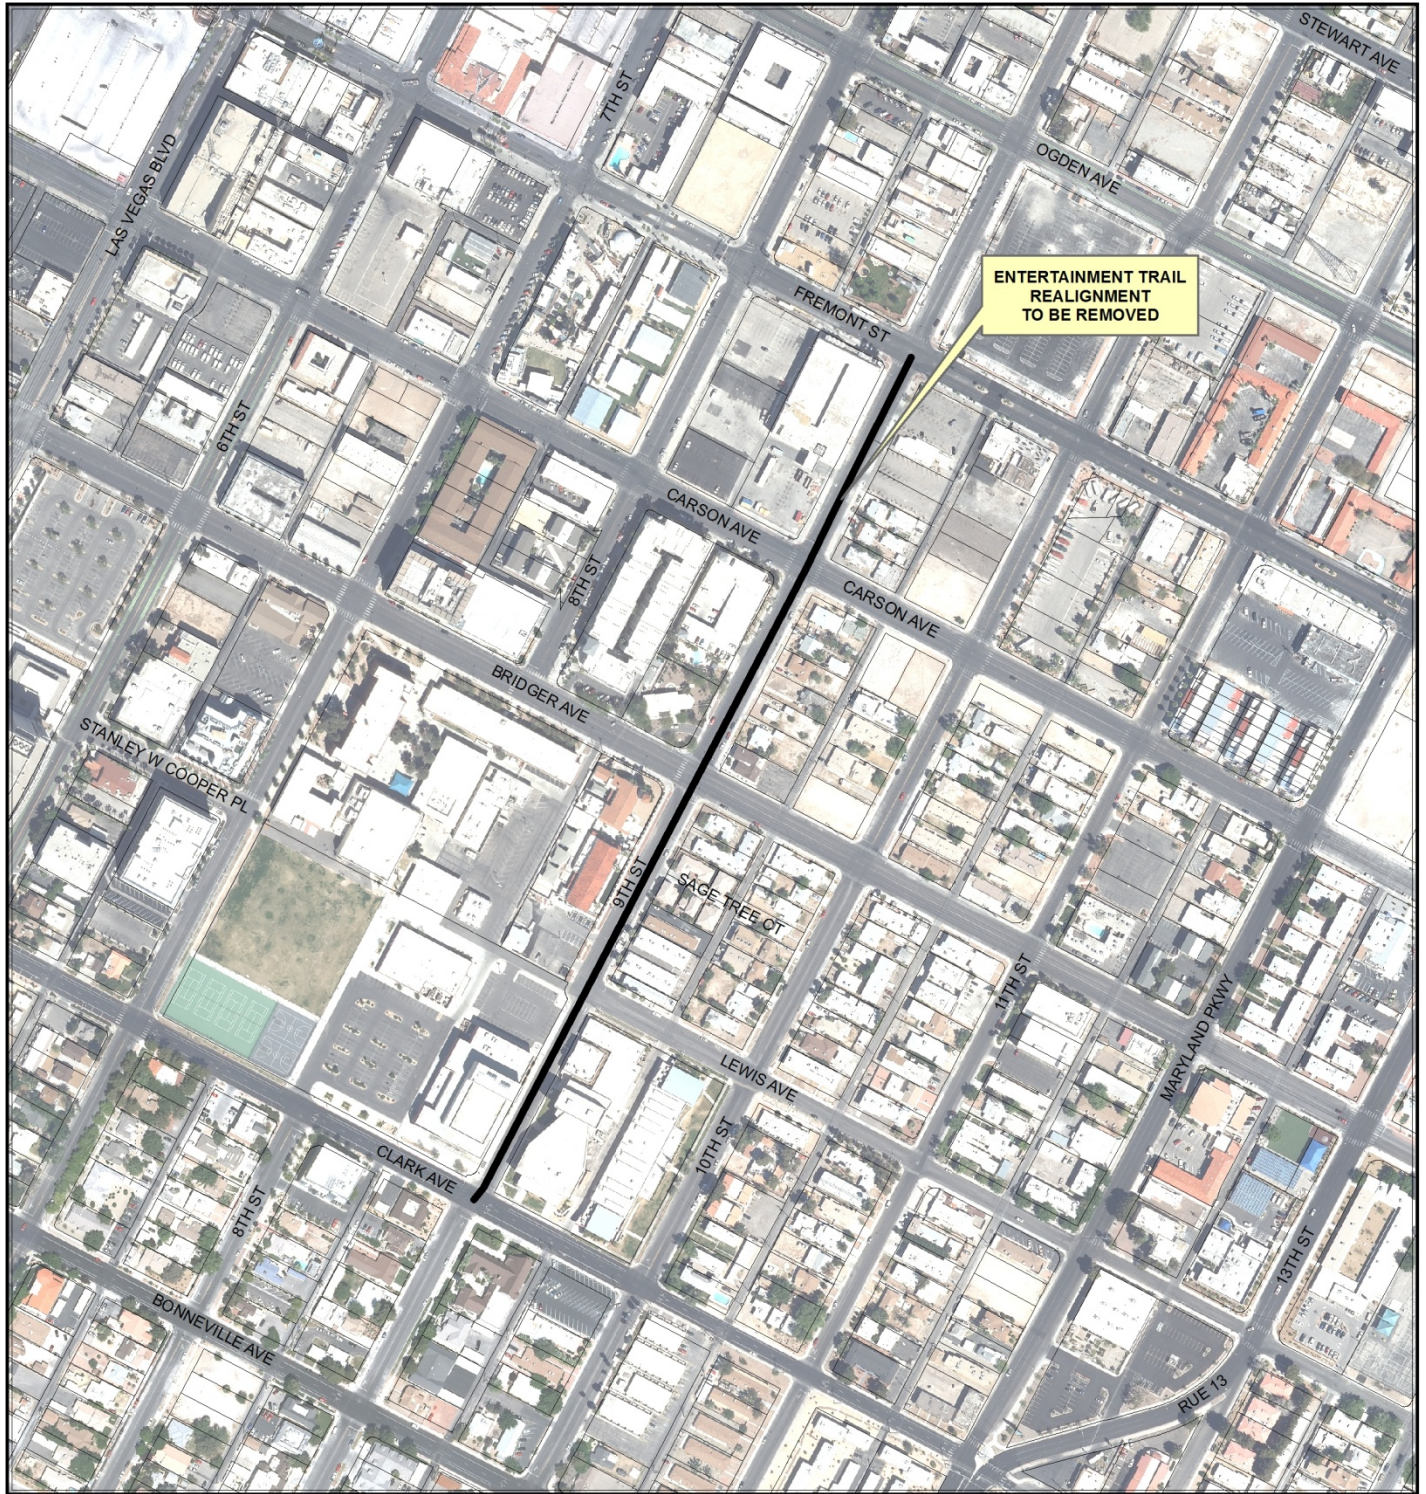

CASE: GPA-56918 (PRJ-56917)

