



DEPARTMENT OF PLANNING

STATEMENT OF FINANCIAL INTEREST

VAR-70190

Case Number: PRJ-69872 APN: _____

Name of Property Owner: GLEN E SWANSON (Koby JAKE FAMILY TRUST)

Name of Applicant: GLEN E SWANSON

Name of Representative: _____

To the best of your knowledge, does the Mayor or any member of the City Council or Planning Commission have any financial interest in this or any other property with the property owner, applicant, the property owner or applicant's general or limited partners, or an officer of their corporation or limited liability company?

☐ Yes

☒ No

If yes, please indicate the member of the City Council or Planning Commission who is involved and list the name(s) of the person or persons with whom the City Official holds an interest. Also list the Assessor's Parcel Number if the property in which the interest is held is different from the case parcel.

City Official: _____

Partner(s): _____

APN: _____


Signature of Property Owner: _____

Print Name: GLEN E SWANSON

Subscribed and sworn before me

This 19th day of April, 2017

Notary Public in and for said County and State

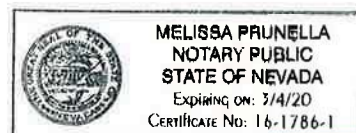

CLV Planning - Application Form

Application Number:	PRJ-69872
Application/Petition For:	PRJ 69872 VAR
ProjectAddress (Location):	7421 MYSTIC STREAM ST
Project Name	SWANSON CASITA VAR
Assessors Parcel #(s):	12515313011
Ward #:	WARD 6 (STEVEN D. ROSS)
Is the Application Information Correct:	Yes
If no, ...change what	
General Plan Designation: Proposed:	Select
Zoning District: Proposed:	Select
Gross Acres:	
Lots/Units:	
Additional Information:	
Applicant First Name:	Glen
Applicant Last Name:	Swanson
Applicant Address:	7421 Mystic Stream Street
Applicant City:	Las vegas
Applicant State:	Nevada
Applicant Zip:	89131
Applicant Phone:	702-591-4668
Applicant Fax:	702-361-8012
Applicant Email:	herb@swscontractors.com
Rep First Name:	Glen
Rep Last Name:	Swanson
Rep Address:	7421 Mystic Stream Street
Rep City:	Las vegas
Rep State:	Nevada
Rep Zip:	89131
Rep Phone:	702-591-4668
Rep Fax:	702-361-8012
Rep Email:	herb@swscontractors.com

PRJ-69872
05/01/17

CLV Planning - Application Form

I certify that I am the applicant and that the information submitted with this application is true and accurate to the best of my knowledge and belief. I understand that the City is not responsible for inaccuracies in information presented, and that inaccuracies, false information or incomplete application may cause the application to be rejected. I further certify that I am the owner or purchaser (or option holder) of the property involved in this application, or the lessee or agent fully authorized by the owner to make this submission. I Accept:	Yes
Is the Owner Information Correct:	Yes
If no, ...change what	


Owner(s)	ADDR1	ADDR2
KOBYJAKE FAMILY TRUST	7421 MYSTIC STREAM ST	LAS VEGAS, NV 89131-3376

CLVEPLAN Applicant	Company	Title	Email
Glen Swanson	Southwest Specialty Contractors	Executive Vice President	herb@swscontractors.com

VAR-70190

PRJ-69872
05/01/17

PARCEL No. 125-15-313-011
BLOCK 3 LOT 28

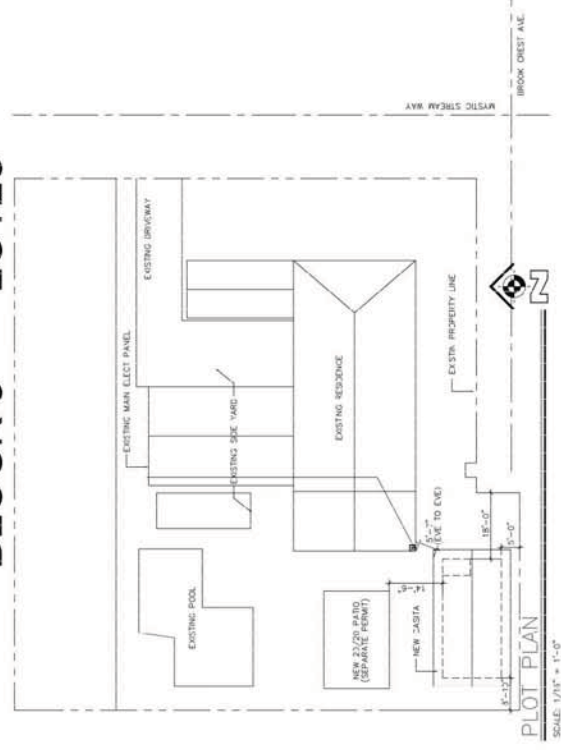

SWANSON RESIDENCE - CASITA ADDITION
7421 MYSTIC STREAM ST.
LAS VEGAS, NV 89131


Casita Plot Plan

PRJ-69872
Date: 04.24.2017
Issued: REVIEW
04/25/17

A1.02

SWANSON RESIDENCE - CASITA ADDITION
7421 MYSTIC STREAM ST.
LAS VEGAS, NV 89131

PARCEL No. 125-15-313-011
BLOCK 3 LOT28

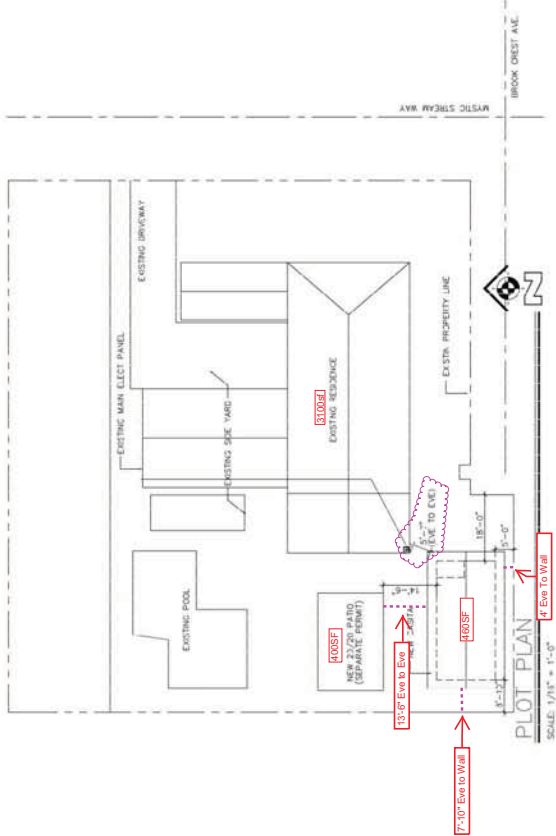


Casita Plot Plan

PRJ-69874
04/25/17

DATE: 04.24.2017
ISSUED: REVIEW

A1.02

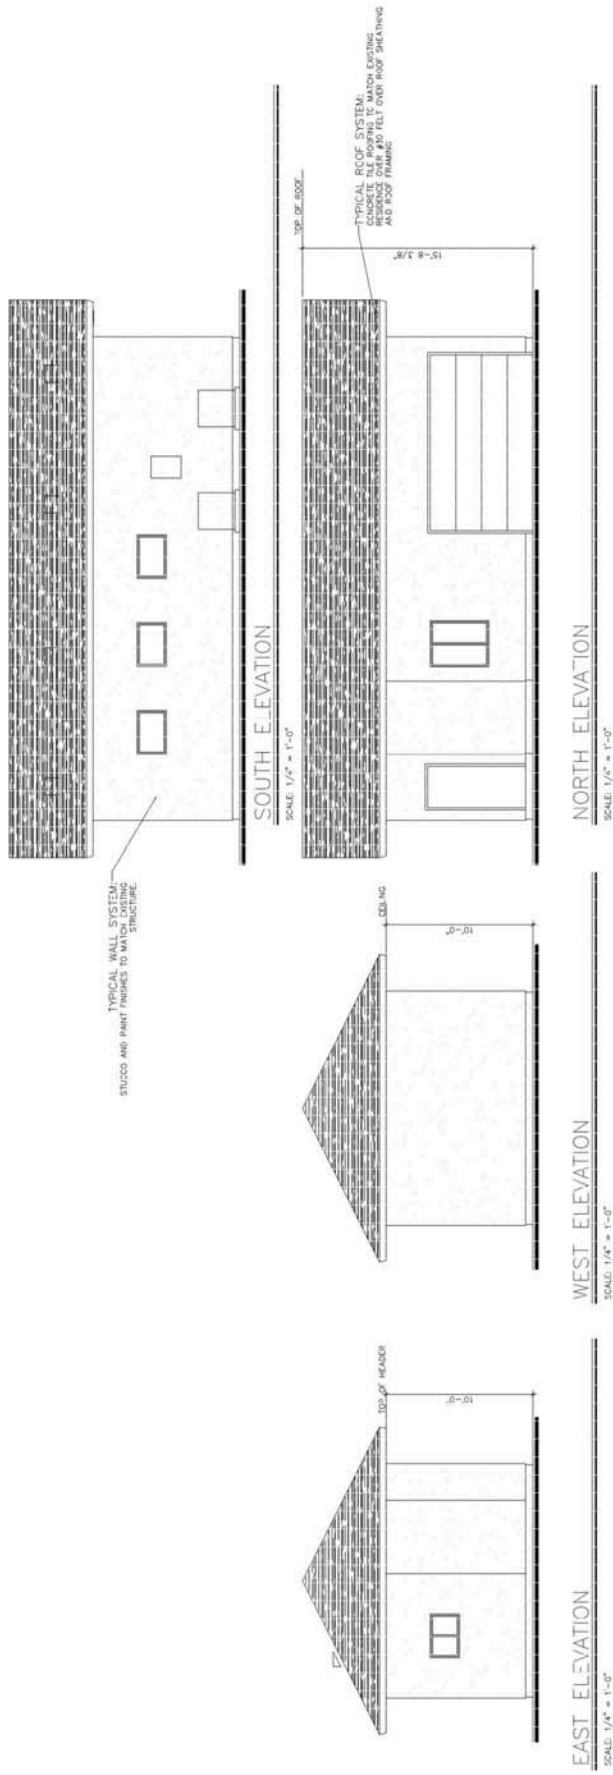


OWNER/BUILDER

SWANSON RESIDENCE - CASITA ADDITION
7421 MYSTIC STREAM ST.
LAS VEGAS, NV 89131

Casita Floor Plan

PRJ-69874
04/25/17
DWG: 04.24.2017
Issued: REVIEW

A1.03

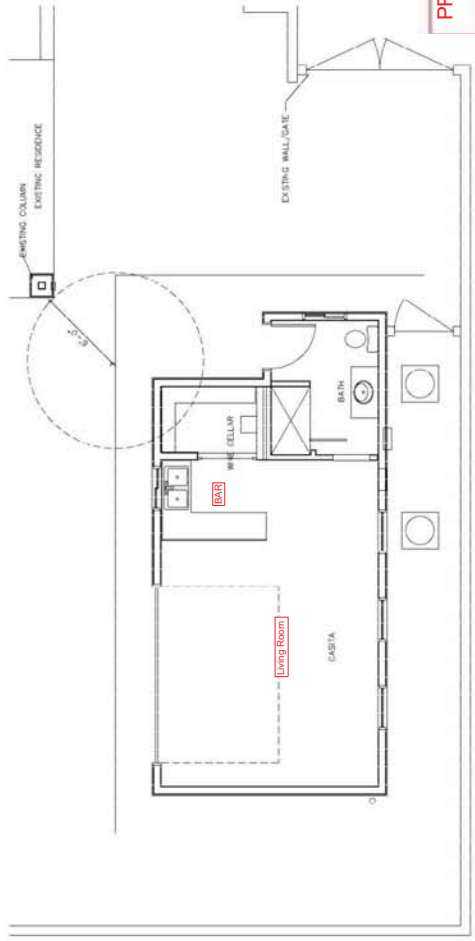

CASITA FLOOR PLAN

SCALE: 1/4" = 1'-0"

VAR-70190

