



DEPARTMENT OF PLANNING

STATEMENT OF FINANCIAL INTEREST

Case Number: **SDR-48398** APN: 139-32-705-008
Name of Property Owner: Palomino Tonopah Associates, LLC
Name of Applicant: Luther Creed, M.D.
Name of Representative: Connie Gamble **RECEIVED**

To the best of your knowledge, does the Mayor or any member of the City Council or Planning Commission have any financial interest in this or any other property with the property owner, applicant, the property owner or applicant's general or limited partners, or an officer of their corporation or limited liability company?

☐ Yes

☒ No

If yes, please indicate the member of the City Council or Planning Commission who is involved and list the name(s) of the person or persons with whom the City Official holds an interest. Also list the Assessor's Parcel Number if the property in which the interest is held is different from the case parcel.

City Official: _____

Partner(s): _____

APN: _____


Signature of Property Owner: Luther Creed

Print Name: Luther Creed, Manager

Subscribed and sworn before me

This 6th day of February, 2013
Connie Gamble

Notary Public in and for said County and State

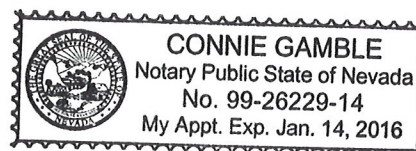



DEPARTMENT OF PLANNING

APPLICATION / PETITION FORM

- Application/Petition For: Palomino Tonopah Associates LLC
 - Project Address (Location) 2020 Palomino Lane, Las Vegas NV
 - Project Name N/A Proposed Use _____
 - Assessor's Parcel #(s) 139-32-705-008 Ward # _____
 - General Plan: existing _____ proposed _____ Zoning: existing _____ proposed _____
 - Commercial Square Footage 34,983 Floor Area Ratio _____
 - Gross Acres 1.58 Lots/Units _____ Density _____
 Additional Information Landscape Plan update

RECEIVED
FEB 19 2013

PROPERTY OWNER Palomino Tonopah Assoc. LLC Contact Connie Gamble
 Address 2200 Paseo Verde Pkwy, St 350 Phone: 702-798-7970 Fax: 702-798-1029
 City Henderson State NV Zip 89052
 E-mail Address ConnieG@VistaLV.Com

APPLICANT Palomino Tonopah Associates LLC Contact Connie Gamble
 Address Same as Above Phone: _____ Fax: _____
 City _____ State _____ Zip _____
 E-mail Address _____

REPRESENTATIVE Vista Realty, Inc Contact Connie Gamble
 Address 2200 Paseo Verde Pkwy St 350 Phone: 798-7970 Fax: 798-1029
 City Henderson State NV Zip 89052
 E-mail Address ConnieG@VistaLV.Com

I certify that I am the applicant and that the information submitted with this application is true and accurate to the best of my knowledge and belief. I understand that the City is not responsible for inaccuracies in information presented, and that inaccuracies, false information or incomplete application may cause the application to be rejected. I further certify that I am the owner or purchaser (or option holder) of the property involved in this application, or the lessee or agent fully authorized by the owner to make this submission, as indicated by the owner's signature below.

Property Owner Signature* Connie Gamble


* An authorized agent may sign in lieu of the property owner for Final Maps, Tentative Maps, and Parcel Maps.

Print Name LUTHER CREECH

Subscribed and sworn before me

This 18th day of November, 20 12.
Connie Gamble

Notary Public in and for said County and State

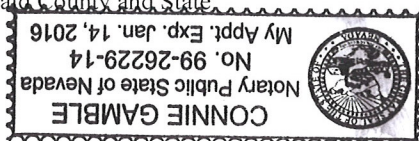

Revised 10/27/08

FOR DEPARTMENT USE ONLY

Case # SDR-48398

Meeting Date: 4/9/2013

Total Fee: 1030.00

Date Received: 2/19/2013

Received By: [Signature]


*The application will not be deemed complete until the submitted materials have been reviewed by the Department of Planning for consistency with applicable sections of the Zoning Ordinance.

f:\depot\Application Packet\Application Form.pdf

ITEM	SIZE	BOTANICAL NAME	COMMON NAME
1	24" box	NERIUM OLEANDER 'PETITE PINK'	DALE PINE
2	5 gal	LEUCOPHYLLUM	DWARF OLEANDER
3	5 gal	CONGESTUM	TEXAS RANGER, GREEN CLOUD
4	5 gal	TRICHOPHYLLUM	AFRICAN SUMAC - MULTI
5	24" box	RHUS LANCEA	STAR JASMINE
6	5 gal	MYRTUS COMMUNIS COMPACTA	MYRTLE
7	5 gal	HESPERALOE PARVIFLORA	RED YUCCA
8	5 gal	FOUQUIERIA SPP.	COCTILLO
9	5 gal	TEUCRARIUM	VERONICA
Note: 58" Palomino Coral, 2" deep in all planters unless otherwise noted.

RECEIVED

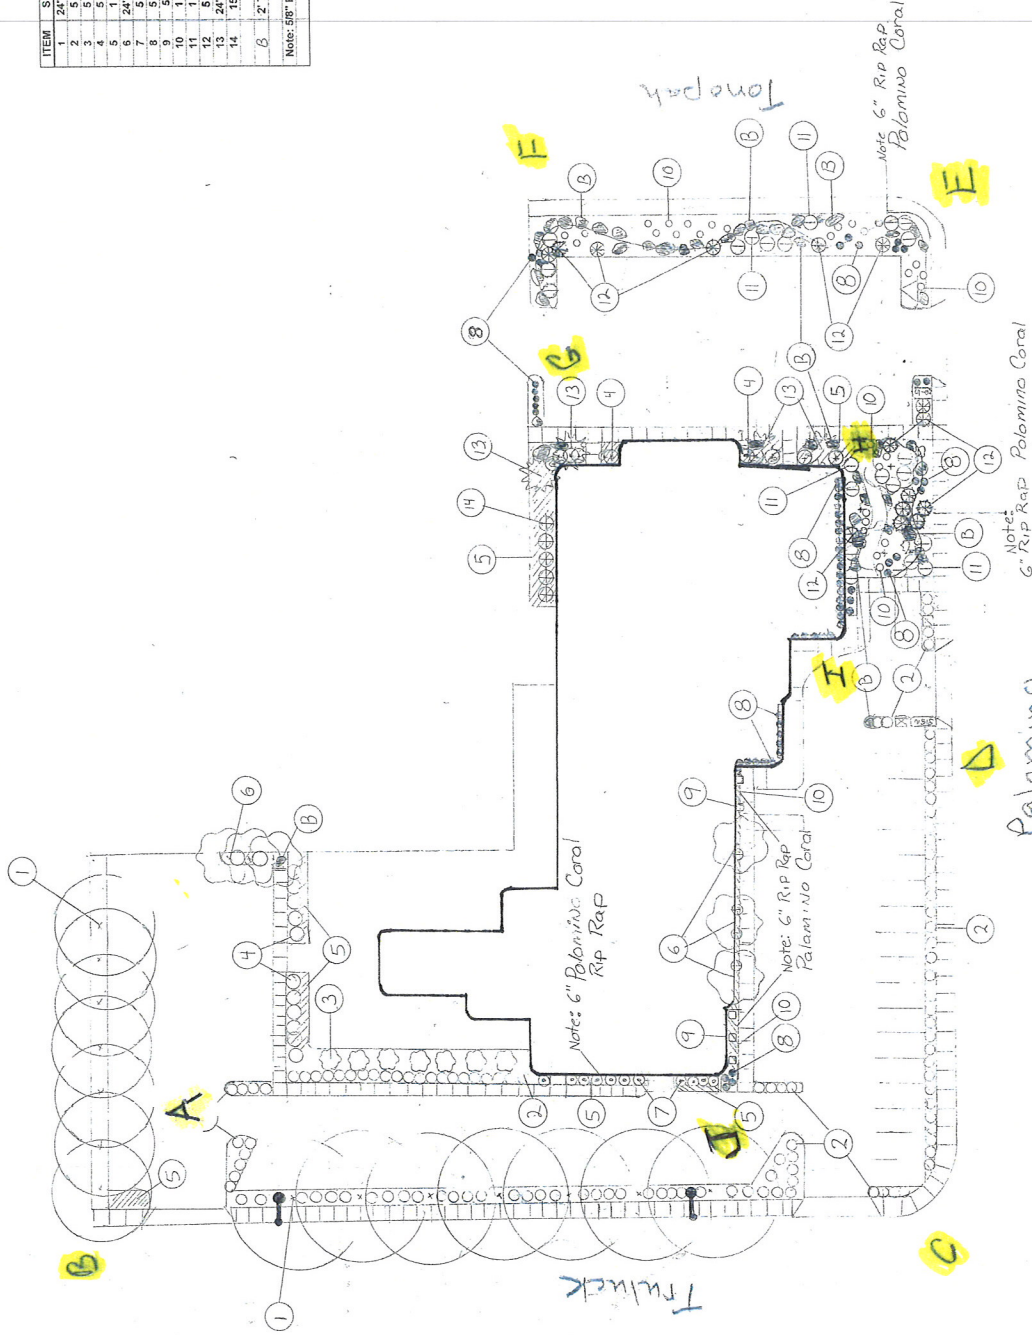

SDR-48398

Landscape Plan: #1
Desert Radiologists 2020 PALOMINO

Revision #:
Date: 12/7/2012

Landscape Design by: J Cuglietta
High Desert Landscape & Design

Scale:
0' 1" = 20' 0"