



DEPARTMENT OF PLANNING

STATEMENT OF FINANCIAL INTEREST

Case Number: **WVR-74211** APN: _____

Name of Property Owner: Hancock Property, LLC

Name of Applicant: _____

Name of Representative: _____

To the best of your knowledge, does the Mayor or any member of the City Council or Planning Commission have any financial interest in this or any other property with the property owner, applicant, the property owner or applicant's general or limited partners, or an officer of their corporation or limited liability company?

☐ Yes

☒ No

If yes, please indicate the member of the City Council or Planning Commission who is involved and list the name(s) of the person or persons with whom the City Official holds an interest. Also list the Assessor's Parcel Number if the property in which the interest is held is different from the case parcel.

City Official: _____

Partner(s): _____

APN: _____

Signature of Property Owner: _____

Print Name: Matthew Kest, Manager of Manager

Subscribed and sworn before me

This _____ day of _____, 20____

Notary Public in and for said County and State

Please See
Attached

PRJ-78842
07/26/18

CALIFORNIA JURAT WITH AFFIANT STATEMENT

GOVERNMENT CODE § 8202

- ☒ See Attached Document (Notary to cross out lines 1-6 below)
☐ See Statement Below (Lines 1-6 to be completed only by document signer[s], *not* Notary)

*Signature of Document Signer No. 1*_____
Signature of Document Signer No. 2 (if any)

A notary public or other officer completing this certificate verifies only the identity of the individual who signed the document to which this certificate is attached, and not the truthfulness, accuracy, or validity of that document.

State of California

County of Los Angeles


Subscribed and sworn to (or affirmed) before me

on this 28 day of June, 2018,
by Date Month Year(1) Matthew Kest

(and (2) _____),

*Name(s) of Signer(s)*proved to me on the basis of satisfactory evidence
to be the person(s) who appeared before me.

Signature _____

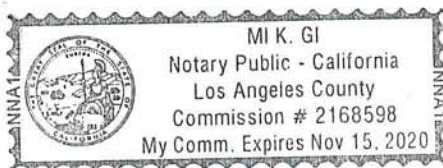Signature of Notary Public

Seal
Place Notary Seal Above

OPTIONAL

Though this section is optional, completing this information can deter alteration of the document or fraudulent reattachment of this form to an unintended document.

Description of Attached Document

Title or Type of Document: _____ Document Date: _____

Number of Pages: _____ Signer(s) Other Than Named Above: _____



DEPARTMENT OF PLANNING

APPLICATION / PETITION FORM

Application/Petition For: Amendment of Master Sign Plan
 Project Address (Location) 7709 N. El Capitan Way LVNV 89143
 Project Name Haddies Proposed Use Commercial
 Assessor's Parcel #(s) 1251762016 Ward # 6
 General Plan: existing _____ proposed _____ Zoning: existing T-C proposed T-C
 Commercial Square Footage _____ Floor Area Ratio _____
 Gross Acres 1.3 Acres Lots/Units _____ Density _____
 Additional Information _____

PROPERTY OWNER HANCOCK PROPERTY LLC Contact _____
 Address 4221 WILSHIRE BLVD #390 Phone: _____ Fax: _____
 City LA State CA Zip 90010
 E-mail Address _____

APPLICANT DF Durango, LLC Contact Zane Hadfield
 Address 7709 N. El Capitan Way Phone: (702) 371-4309 Fax: (702) 454-1399
 City Las Vegas State NV Zip 89143
 E-mail Address zane@hadfieldbuild.com

REPRESENTATIVE HIGH IMPACT SIGN Contact MARK WHITEHOUSE
 Address 820 S WILLOW PKWY #100 Phone: (702) 336-3336 Fax: (702) 644-0678
 City HENDERSON State NV Zip 89014
 E-mail Address mwhitehouse@highimpactsign.com

I certify that I am the applicant and that the information submitted with this application is true and accurate to the best of my knowledge and belief. I understand that the City is not responsible for inaccuracies in information presented, and that inaccuracies, false information or incomplete application may cause the application to be rejected. I further certify that I am the owner or purchaser (or option holder) of the property involved in this application, or the lessee or agent fully authorized by the owner to make this submission, as indicated by the owner's signature below.

Property Owner Signature** _____

* An authorized agent may sign in lieu of the property owner for Final Maps, Tentative Maps, and Parcel Maps.

Print Name Matthew West

Subscribed and sworn before me

This _____ day of _____, 20 _____.

** Owner's signature and consent to this application is conditioned on Applicant's compliance with ECCR's re. this requested waiver and change to the matters signage plan.
 Notary Public in and for said County and State

FOR DEPARTMENT USE ONLY

Case # **WVR-74211**

Meeting Date: _____

Total Fee: _____

Date Received: *

Received By: _____

* The application will not be deemed complete until the submitted materials have been reviewed by the Department of Planning for consistency with applicable sections of the Zoning Ordinance.
PRJ 73842
07/26/18

CALIFORNIA JURAT WITH AFFIANT STATEMENT

GOVERNMENT CODE § 8202

- ☒ See Attached Document (Notary to cross out lines 1-6 below)
☐ See Statement Below (Lines 1-6 to be completed only by document signer[s], not Notary)


Signature of Document Signer No. 1_____
Signature of Document Signer No. 2 (if any)

A notary public or other officer completing this certificate verifies only the identity of the individual who signed the document to which this certificate is attached, and not the truthfulness, accuracy, or validity of that document.

State of California

County of Los Angeles

Subscribed and sworn to (or affirmed) before me

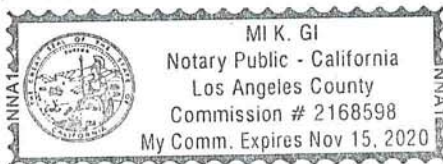on this 5 day of June, 2018
by _____ Date _____ Month _____ Year _____(1) Matthew Kest(and (2) _____),
Name(s) of Signer(s)proved to me on the basis of satisfactory evidence
to be the person(s) who appeared before me.

Signature _____

Signature of Notary Public

Seal
Place Notary Seal Above

OPTIONAL

Though this section is optional, completing this information can deter alteration of the document or fraudulent reattachment of this form to an unintended document.

Description of Attached Document

Title or Type of Document: Application/Petition Form Document Date: 6/05/18
Number of Pages: 1 Signer(s) Other Than Named Above: _____

WVR-74211

FIELD SURVEY COMPLETED
VERIFIED 6/11/18 KL

COMPANY NAME:
HADDIES
"C MART"
7737 N. EL CAPITAN WAY
LAS VEGAS, NV 89143

CLIENT APPROVAL:

APPROVAL DATE:

SALESMAN:
MARK WHITEHOUSE
SALESMAN EMAIL:
MYWHITEHOUSE@HIGHIMPACTSIGN.COM
DESIGNER:
DERRICK
FONTS:

INITIAL PROOF DATE:
05/17/18 DN
MOST RECENT REVISION DATE AND INITIAL:
R6 07/13/18 KL

DESCRIPTION OF CHANGE:
ADD NEW RED PAINT CALL-OUT

PREVIOUS REVISION DATES:
R1 05/07/18 DN R5 06/26/18 KL
R2 05/29/18 DN
R3 05/29/18 DN
R4 06/11/18 KL



LAS VEGAS, NV
702.736.7446 775.727.3800
PAHRUMP, NV
702.644.0678 775.727.3830
SALES@HIGHIMPACTSIGN.COM


LICENSE NUMBERS:

STATE LIC# 47418A

MJ# 1002123944

CVL# C11-12945-C-153860

COPYRIGHT © 2018 HIGH IMPACT SIGNS & DECOR, LLC
ALL RIGHTS RESERVED. NO PART OF THIS DOCUMENT MAY BE REPRODUCED OR TRANSMITTED IN ANY FORM OR BY ANY MEANS, ELECTRONIC OR MECHANICAL, WITHOUT PERMISSION IN WRITING FROM HIGH IMPACT SIGNS & DECOR, LLC.
THIS DOCUMENT IS THE PROPERTY OF HIGH IMPACT SIGNS & DECOR, LLC. IT IS TO BE USED ONLY FOR THE PROJECT AND SITE SPECIFICALLY IDENTIFIED HEREIN. IT IS NOT TO BE USED FOR ANY OTHER PROJECT OR SITE WITHOUT THE WRITTEN PERMISSION OF HIGH IMPACT SIGNS & DECOR, LLC.
ACCURACY OF THIS DOCUMENT IS BASED ON THE INFORMATION PROVIDED BY THE CLIENT. HIGH IMPACT SIGNS & DECOR, LLC DOES NOT WARRANT THE ACCURACY OF THE INFORMATION PROVIDED BY THE CLIENT.

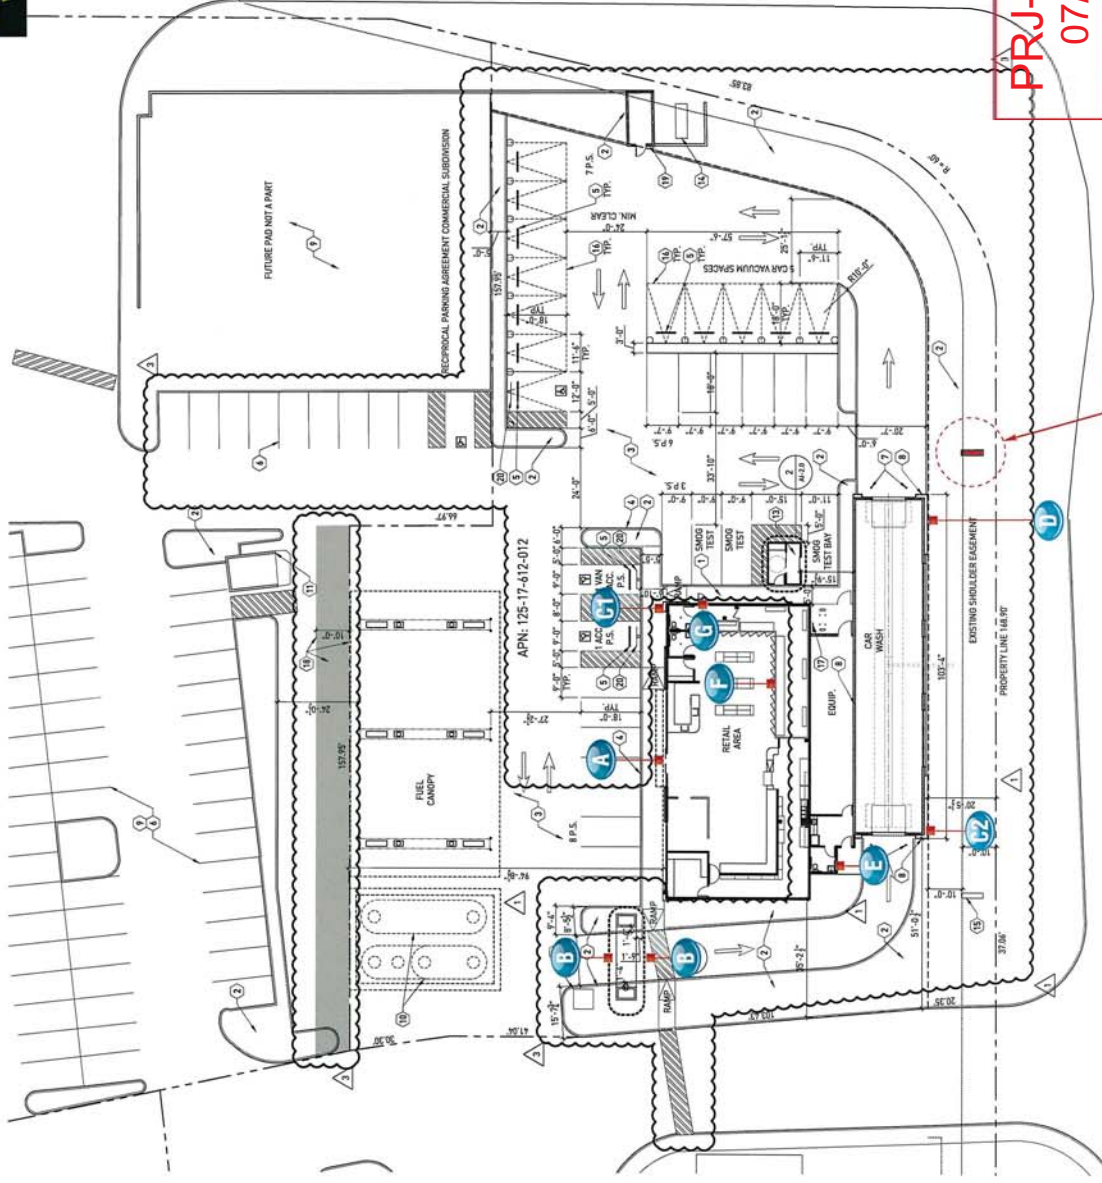

N. DURANGO DR.

TEMPORARY EXISTING MONUMENT SIGN TO BE REPLACED
PROPOSED W/ C.L.V. SHELL STANDARD MONUMENT
TO REPLACE EXISTING


SITE PLAN N.T.S.

FILE LOCATION AND NAME:
ART FILES\G-L\HADDIES-C MART\ PROPOSAL ART\7737 N EL CAPITAN\HADDIES C-MART_ EXTERIOR & INTERIOR SIGNAGE_1100_R6

W/O #6549

1

WVR-74211 and MSP-74070

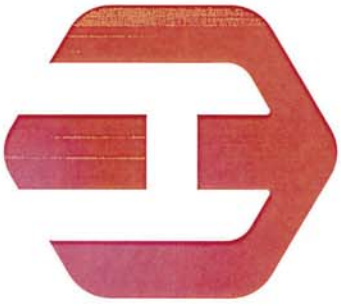

HADDDIES

CONVENIENCE STORE & CAR WASH

7737 N. EL CAPITAN WAY | LAS VEGAS, NV 89143

PROPOSED EXTERIOR & INTERIOR SIGNAGE PACKAGE

W/O #6549

PRJ-73842

07/26/18



702.736.7446
FAX 702.736.1833
820 Wigwam Pkwy, Suite #100
Henderson, NV 89014


WVR-74211 and MSP-74070

FIELD SURVEY COMPLETED
VERIFIED 6/11/18 KL



PROPOSED: REFACE EXISTING D/F MONUMENT SIGN
SCALE: 1/2" = 1'-0"

TEMPORARY FACES FOR EXISTING MONUMENT SIGN.
WHITE LEXAN WITH 1st SURFACE VINYL GRAPHICS
AND ZIP TRACK FOR GAS PRICE.

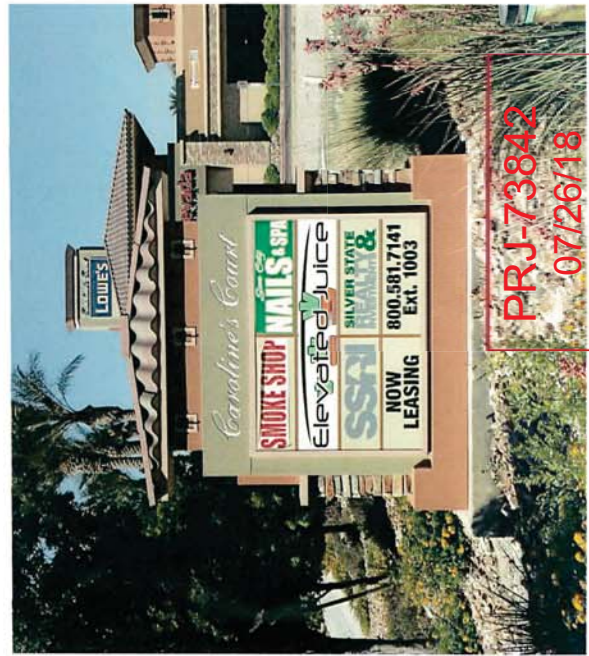

EXISTING ELEVATION D/F MONUMENT SIGN
SCALE: N.T.S.

COMPANY NAME:
H HADDIES
"C MART"
7737 N. EL CAPITAN WAY
LAS VEGAS, NV 89143

CLIENT APPROVAL:

APPROVAL DATE:

SALESMAN:
MARK WHITEHOUSE

SALESMAN EMAIL:
MWHITEHOUSE@HIGHIMPACTSIGN.COM

DESIGNER:
DERRICK

FOITS:

INITIAL PROOF DATE:
05/17/18 DN

MOST RECENT REVISION DATE AND INITIAL:
R6 07/13/18 KL

DESCRIPTION OF CHANGE:
ADD NEW RED PAINT CALL-OUT

PREVIOUS REVISION DATES:
R1 05/23/18 DN R5 06/29/18 JS
R2 05/29/18 DN
R3 05/29/18 DN
R4 06/17/18 KL

HIGH IMPACT SIGNS
LAS VEGAS, NV
702.736.7446 775.727.3800
FAX 702.644.0678 FAX 775.727.3830
SALES@HIGHIMPACTSIGN.COM

LAS VEGAS, NV
702.736.7446 775.727.3800
FAX 702.644.0678 FAX 775.727.3830
SALES@HIGHIMPACTSIGN.COM


LICENSE NUMBERS:
STATE LIC# 47418A
MJ# 1002123944
CVL# C11-12945-C-153860

© COPYRIGHT © 2017 HIGH IMPACT SIGN & DESIGN, LLC
ALL RIGHTS RESERVED. NO PART OF THIS DOCUMENT OR ITS CONTENTS MAY BE REPRODUCED OR TRANSMITTED IN ANY FORM OR BY ANY MEANS, ELECTRONIC OR MECHANICAL, WITHOUT PERMISSION IN WRITING FROM HIGH IMPACT SIGN & DESIGN, LLC.
CUSTOMER MUST PLACE US FIRST PREVENT ELECTRICAL SURGES
ALL ELECTRICAL WIRING MUST BE DONE BY A LICENSED ELECTRICIAN
WARRANTY INSTALLATION TO MEET ALL CODES

WVR-74211 and MSP-74070

2.1.10 MONUMENT SIGNS

PROPOSED WAVIER w/ C.L.V. SHELL STANDARD MONUMENT TO REPLACE EXISTING

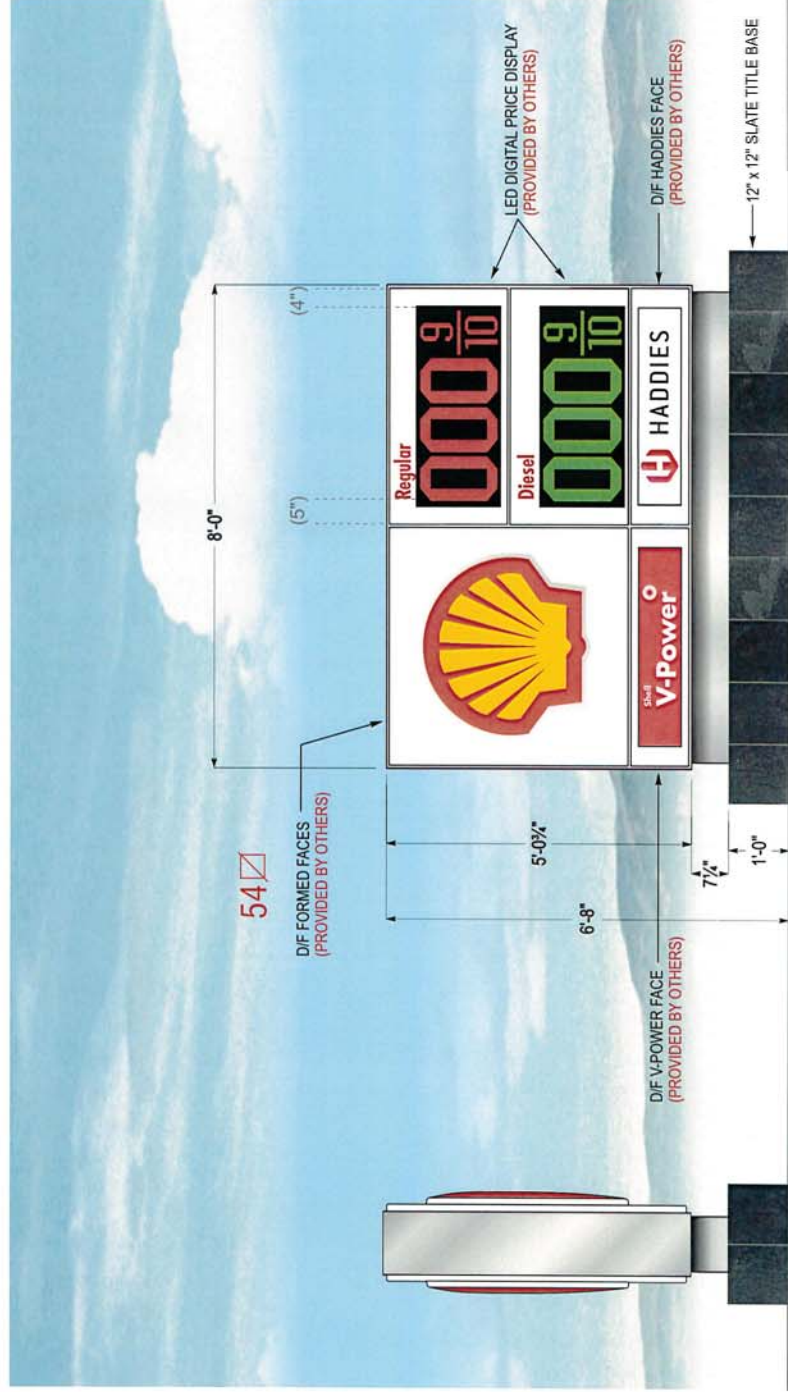

HT PROPOSED: STANDARD SHELL D/F MONUMENT SIGN (1) REQ'D.
SCALE: 1/2" = 1'-0"

PRJ-73842
07/26/18

COMPANY NAME:

HADDIES
"C MART"

7737 N. EL CAPITAN WAY
LAS VEGAS, NV 89143

CLIENT APPROVAL:

APPROVAL DATE:

SALESMAN:

MARK WHITEHOUSE

SALESMAN EMAIL:

MWHITEHOUSE@HIGHIMPACTSIGN.COM

DESIGNER:

DERRICK

FOOTS:

INITIAL PROOF DATE:

05/17/18 DN

MOST RECENT REVISION DATE AND INITIAL:

R6 07/13/18 KL

DESCRIPTION OF CHANGE:

ADD NEW RED PAINT CALL-OUT

PREVIOUS REVISION DATES:

R1 05/07/18 DN R5 06/25/18 MS

R2 05/29/18 DN

R3 05/29/18 DN

R4 06/07/18 KL



LAS VEGAS, NV
702.736.7446 775.727.3800
FAX 702.644.0678 FAX 775.727.3830
SALES@HIGHIMPACTSIGN.COM

LICENSE NUMBERS:

STATE LIC# 47418A

MJ# 1002123944

CVL# C11-12945-C-153860

CONTRACT # 2017 HIGH IMPACT SIGN DESIGN, LLC





FILE LOCATION AND NAME:

ART FILES\G-L\HADDIES-C MART\ PROPOSAL ART\7737 N EL CAPITAN\HADDIES C-MART_EXTERIOR & INTERIOR SIGNAGE_1100_R6

W/O #6549

10

WVR-74211 and MSP-74070

HADDIES CONVENIENT MART SIGN TABLE

<u>SIGN ID</u>	<u>SIGN TYPE</u>	<u>LOCATION</u>	<u>Elevations</u>	<u>HT.</u>	<u>HT. ALLOWED</u>	<u>WIDTH</u>	<u>SIGN AREA</u>	<u>SIGN AREA ALLOWED</u>	<u>QTY</u>	<u>QTY ALLOWED</u>
B	INCIDENTAL	CAR WASH DRIVE WAY	NORTH / SOUTH	2'4"	5'	15'2"	27'	5'	1	1
H	MONUMENT	DURANGO	NA	6'8"	10'	8'	54'	75'	1	1

Notes:

PRJ-73842
07/26/18

WVR-74211 and MSP-74070