



DEPARTMENT OF PLANNING

STATEMENT OF FINANCIAL INTEREST

Case Number: **SUP-74789** APN: 163-03-602-007

Name of Property Owner: NANCY FALLON

Name of Applicant: NANCY FALLON

Name of Representative: NANCY FALLON

To the best of your knowledge, does the Mayor or any member of the City Council or Planning Commission have any financial interest in this or any other property with the property owner, applicant, the property owner or applicant's general or limited partners, or an officer of their corporation or limited liability company?

☐ Yes

☒ No

If yes, please indicate the member of the City Council or Planning Commission who is involved and list the name(s) of the person or persons with whom the City Official holds an interest. Also list the Assessor's Parcel Number if the property in which the interest is held is different from the case parcel.

City Official: _____

Partner(s): _____

APN: _____

Signature of Property Owner: _____

Print Name: NANCY FALLON

Subscribed and sworn before me

This 13th day of Sept., 2018

Evangelina L. Diaz
Notary Public in and for said County and State





DEPARTMENT OF PLANNING

APPLICATION / PETITION FORM

Application/Petition For: Special Use Permit
Project Address (Location) 1501 Montessori Street
Project Name Montessori Rentals Proposed Use Short-term Rental
Assessor's Parcel #(s) 163-03-602-007 Ward # _____
General Plan: existing _____ proposed _____ Zoning: existing _____ proposed _____
Commercial Square Footage _____ Floor Area Ratio _____
Gross Acres _____ Lots/Units _____ Density _____
Additional Information _____

PROPERTY OWNER Fallon Nancy Trust Contact Nancy Fallon
Address 69 Antique Garden Street Phone: 7022654481 Fax: 7022484095
City Las Vegas State NV Zip 89138
E-mail Address Montessorirentals@gmail.com

APPLICANT Nancy Fallon Contact Nancy Fallon
Address 1501 Montessori Street Phone: 7022654481 Fax: 7022484095
City Las Vegas State NV Zip 89117
E-mail Address Montessorirentals@gmail.com

REPRESENTATIVE Nancy Fallon Contact Nancy Fallon
Address 69 Antique Garden Street Phone: 7022654481 Fax: 7022484095
City Las Vegas State NV Zip 89138
E-mail Address Montessorirentals@gmail.com

I certify that I am the applicant and that the information submitted with this application is true and accurate to the best of my knowledge and belief. I understand that the City is not responsible for inaccuracies in information presented, and that inaccuracies, false information or incomplete application may cause the application to be rejected. I further certify that I am the owner or purchaser (or option holder) of the property involved in this application, or the lessee or agent fully authorized by the owner to make this submission, as indicated by the owner's signature below.

Property Owner Signature* [Signature]

* An authorized agent may sign in lieu of the property owner for Final Maps, Tentative Maps, and Parcel Maps.

Print Name Nancy Fallon

Subscribed and sworn before me

This 13th day of September, 20 18.

Evangelina R-D

FOR DEPARTMENT USE ONLY

Case # **SUP-74789**

Meeting Date:

Total Fee:

Date Received:*

Received By:

Notary Public in and for said County and State





DEPARTMENT OF PLANNING

APPLICATION / PETITION FORM

Application/Petition For: SPECIAL USE PERMIT
 Project Address (Location) 1501 MONTESSOURI ST. LAS VEGAS NV 89117
 Project Name MONTESSOURI RENTALS Proposed Use SPECIAL USE PERMIT
 Assessor's Parcel #(s) (1769572) 163-03-602-007 Ward # 1 FOR SHORT-
 General Plan: existing _____ proposed NO CHANGE zoning: existing _____ proposed NO CHANGE term RENTAL
 Commercial Square Footage 3106 sq ft Floor Area Ratio _____
 Gross Acres .56 Lots/Units _____ Density _____
 Additional Information _____

PROPERTY OWNER NANCY FALLON TRUST Contact 702-265-4481
 Address 69 ANTIQUE GARDEN ST. Phone: 702-265-4481 Fax: 0
 City LAS VEGAS State NV Zip 89138
 E-mail Address montessorirentals@gmail.com

APPLICANT NANCY FALLON Contact 702-265-4481
 Address 69 ANTIQUE GARDEN ST. Phone: 702-265-4481 Fax: 0
 City LAS VEGAS State NV Zip 89138
 E-mail Address DR FALLON@HOTMAIL.COM

REPRESENTATIVE _____ Contact _____
 Address _____ Phone: _____ Fax: _____
 City _____ State _____ Zip _____
 E-mail Address _____

I certify that I am the applicant and that the information submitted with this application is true and accurate to the best of my knowledge and belief. I understand that the City is not responsible for inaccuracies in information presented, and that inaccuracies, false information or incomplete application may cause the application to be rejected. I further certify that I am the owner or purchaser (or option holder) of the property involved in this application, or the lessee or agent fully authorized by the owner to make this submission, as indicated by the owner's signature below.

Property Owner Signature* [Signature]

* An authorized agent may sign in lieu of the property owner for Final Maps, Tentative Maps, and Parcel Maps.

Print Name NANCY FALLON

Subscribed and sworn before me

This 13th day of September, 20 18.

Evangelina L. Diaz

Notary Public in and for said County and State



Revised 10/27/08

FOR DEPARTMENT USE ONLY

Case # **SUP-74789**

Meeting Date:


Total Fee:

Date Received:*

Received By:

*The application will not be deemed complete until the submitted application has been reviewed by the Department of Planning for consistency with applicable sections of the Zoning Ordinance.

f:\depot\Application Packet\Application Form.pdf

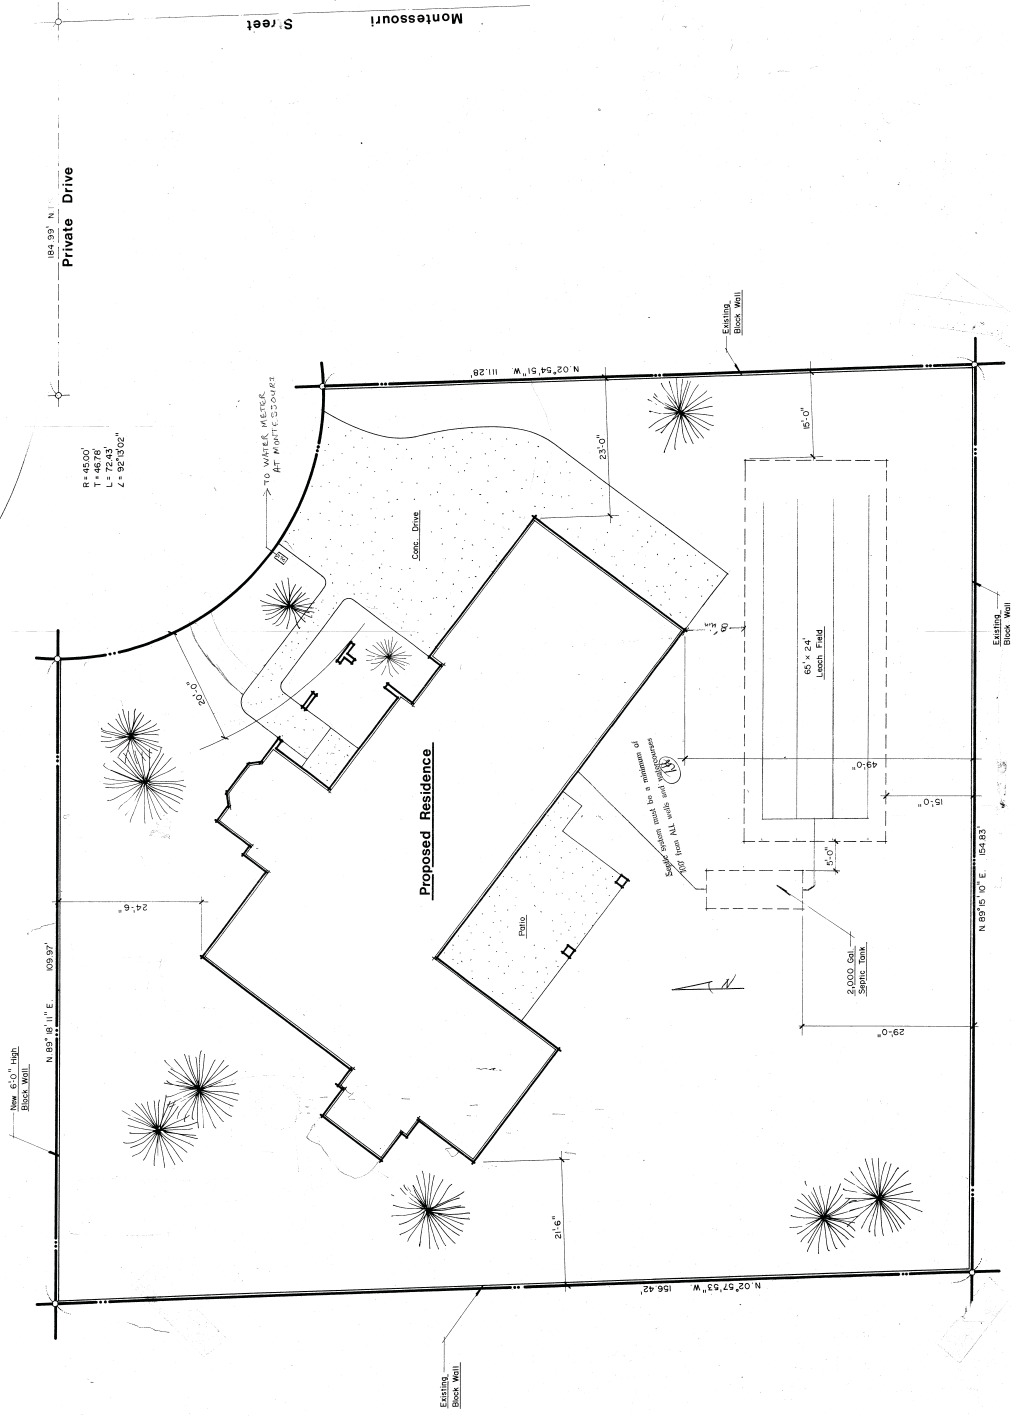

Site Plan

Scale: 1" = 10'-0"



THE STREET ADDRESS SHALL BE POSTED ON THE BUILDING IN SUCH A POSITION TO BE PLAINLY VISIBLE FROM THE STREET FRONTING THE PROPERTY.

ISSUED **REQUIRE PLUMBING AND A/C**
DRAWING BEFORE PERMITS ARE


PLANS APPROVED - CONSTRUCTION
DOES NOT INCLUDE ELECTRICAL, PLUMBING, OR CONDITIONS OF
OFF-SITE IMPROVEMENTS.
RATES AND CHARGES WITHOUT APPROVAL
APPROVAL OF PLAN IS NOT A PRETEXT TO VIOLATE ANY ORDINANCE
Pd 4-5-77

1501 MONTESSORI ST.

Water service is available to this property or an application has been made to extend water service to this property.

Indefinite **PRJ-7475**
 UNB Sworn of monies
 \$ Neil Ray St back 2011/1718

SUP-74789

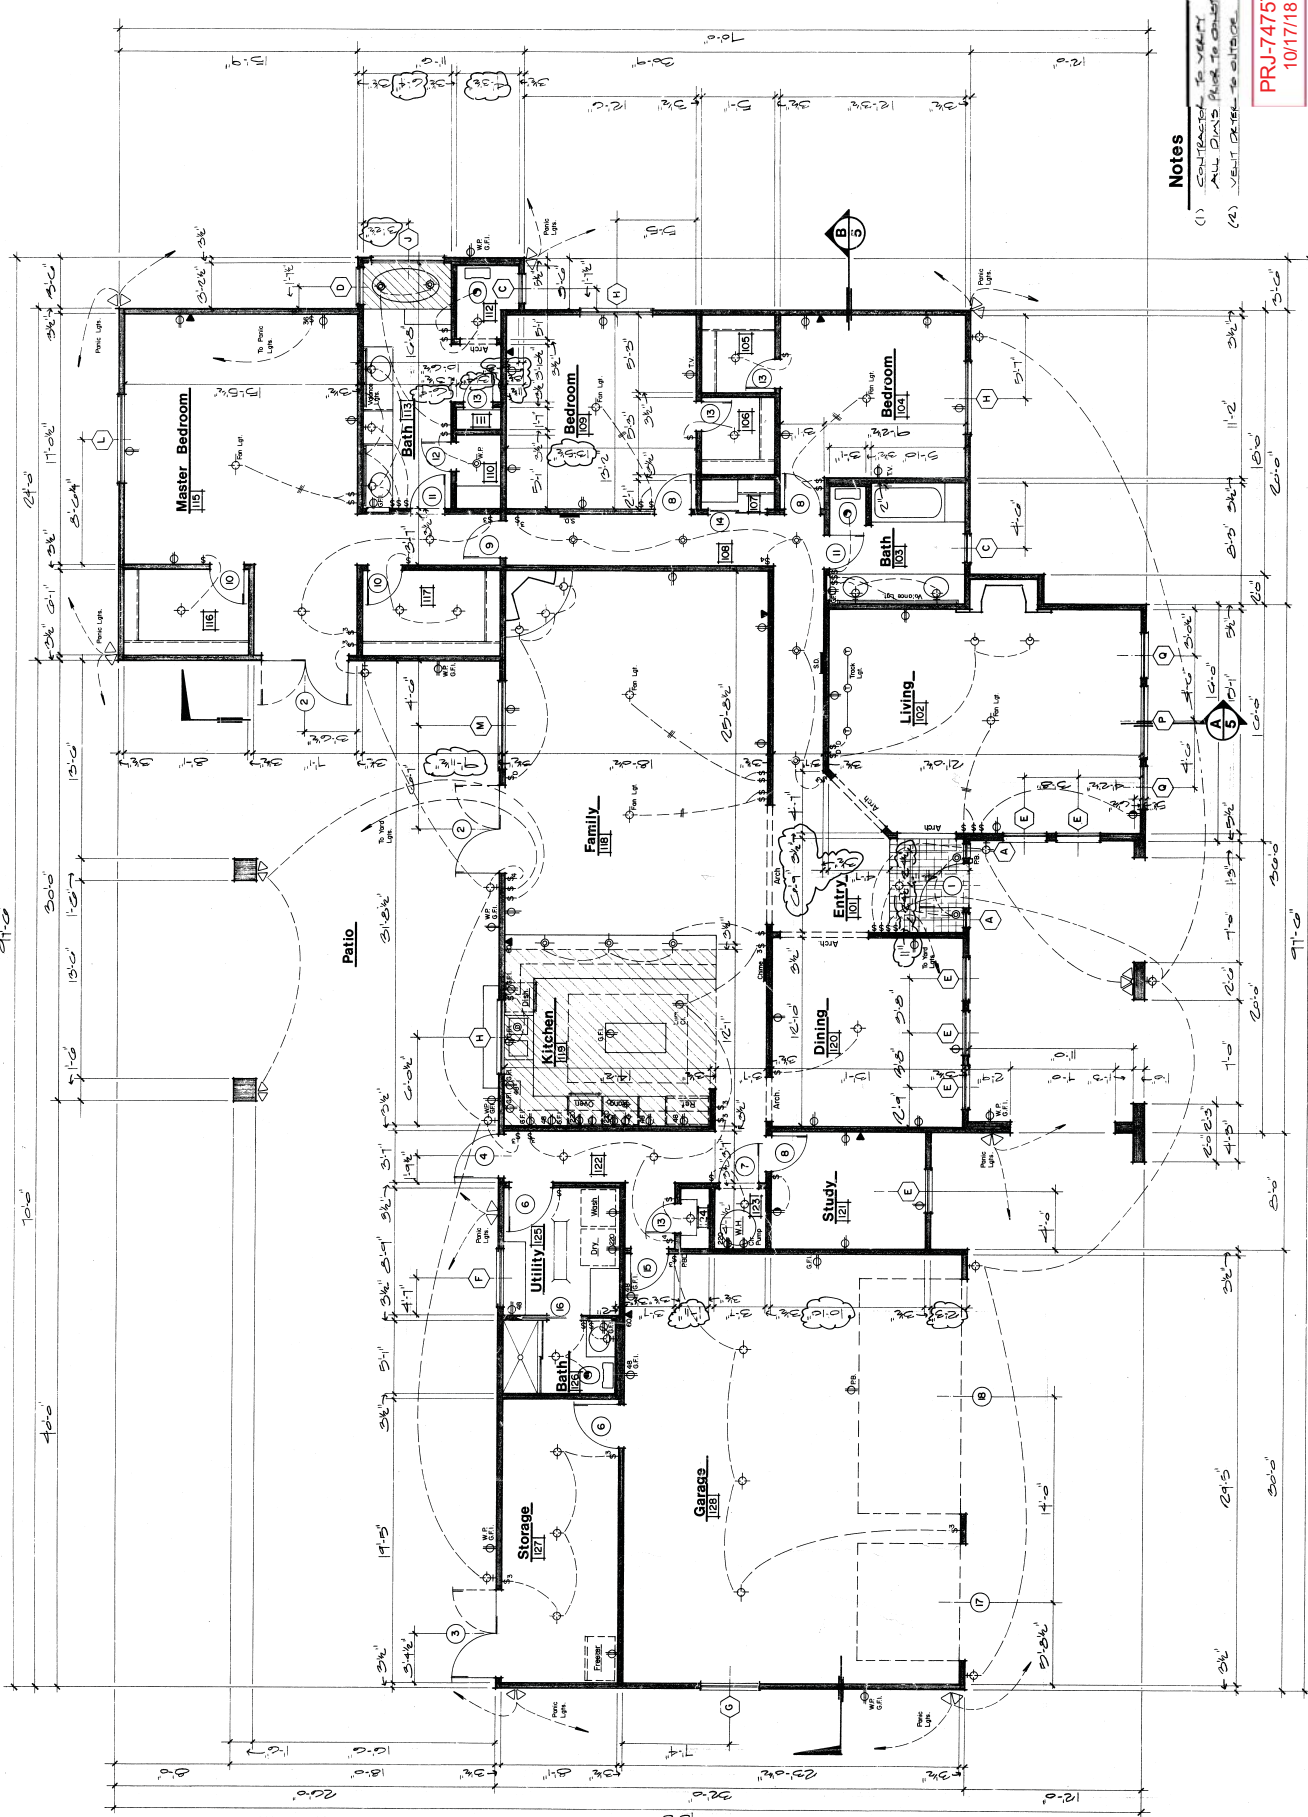

Floor Plan

SUP-74789

PRJ-74757
10/17/18

- Notes**
- (1) CONTRACTOR TO VERIFY ALL DIMS PRIOR TO CONSTRUCTION.

Job No. 86007
Date
Sheet Title
A New Residence

Owner
Larry & Mitzi Hicks