


PROPOSED FOOTPRINT COMPARISON

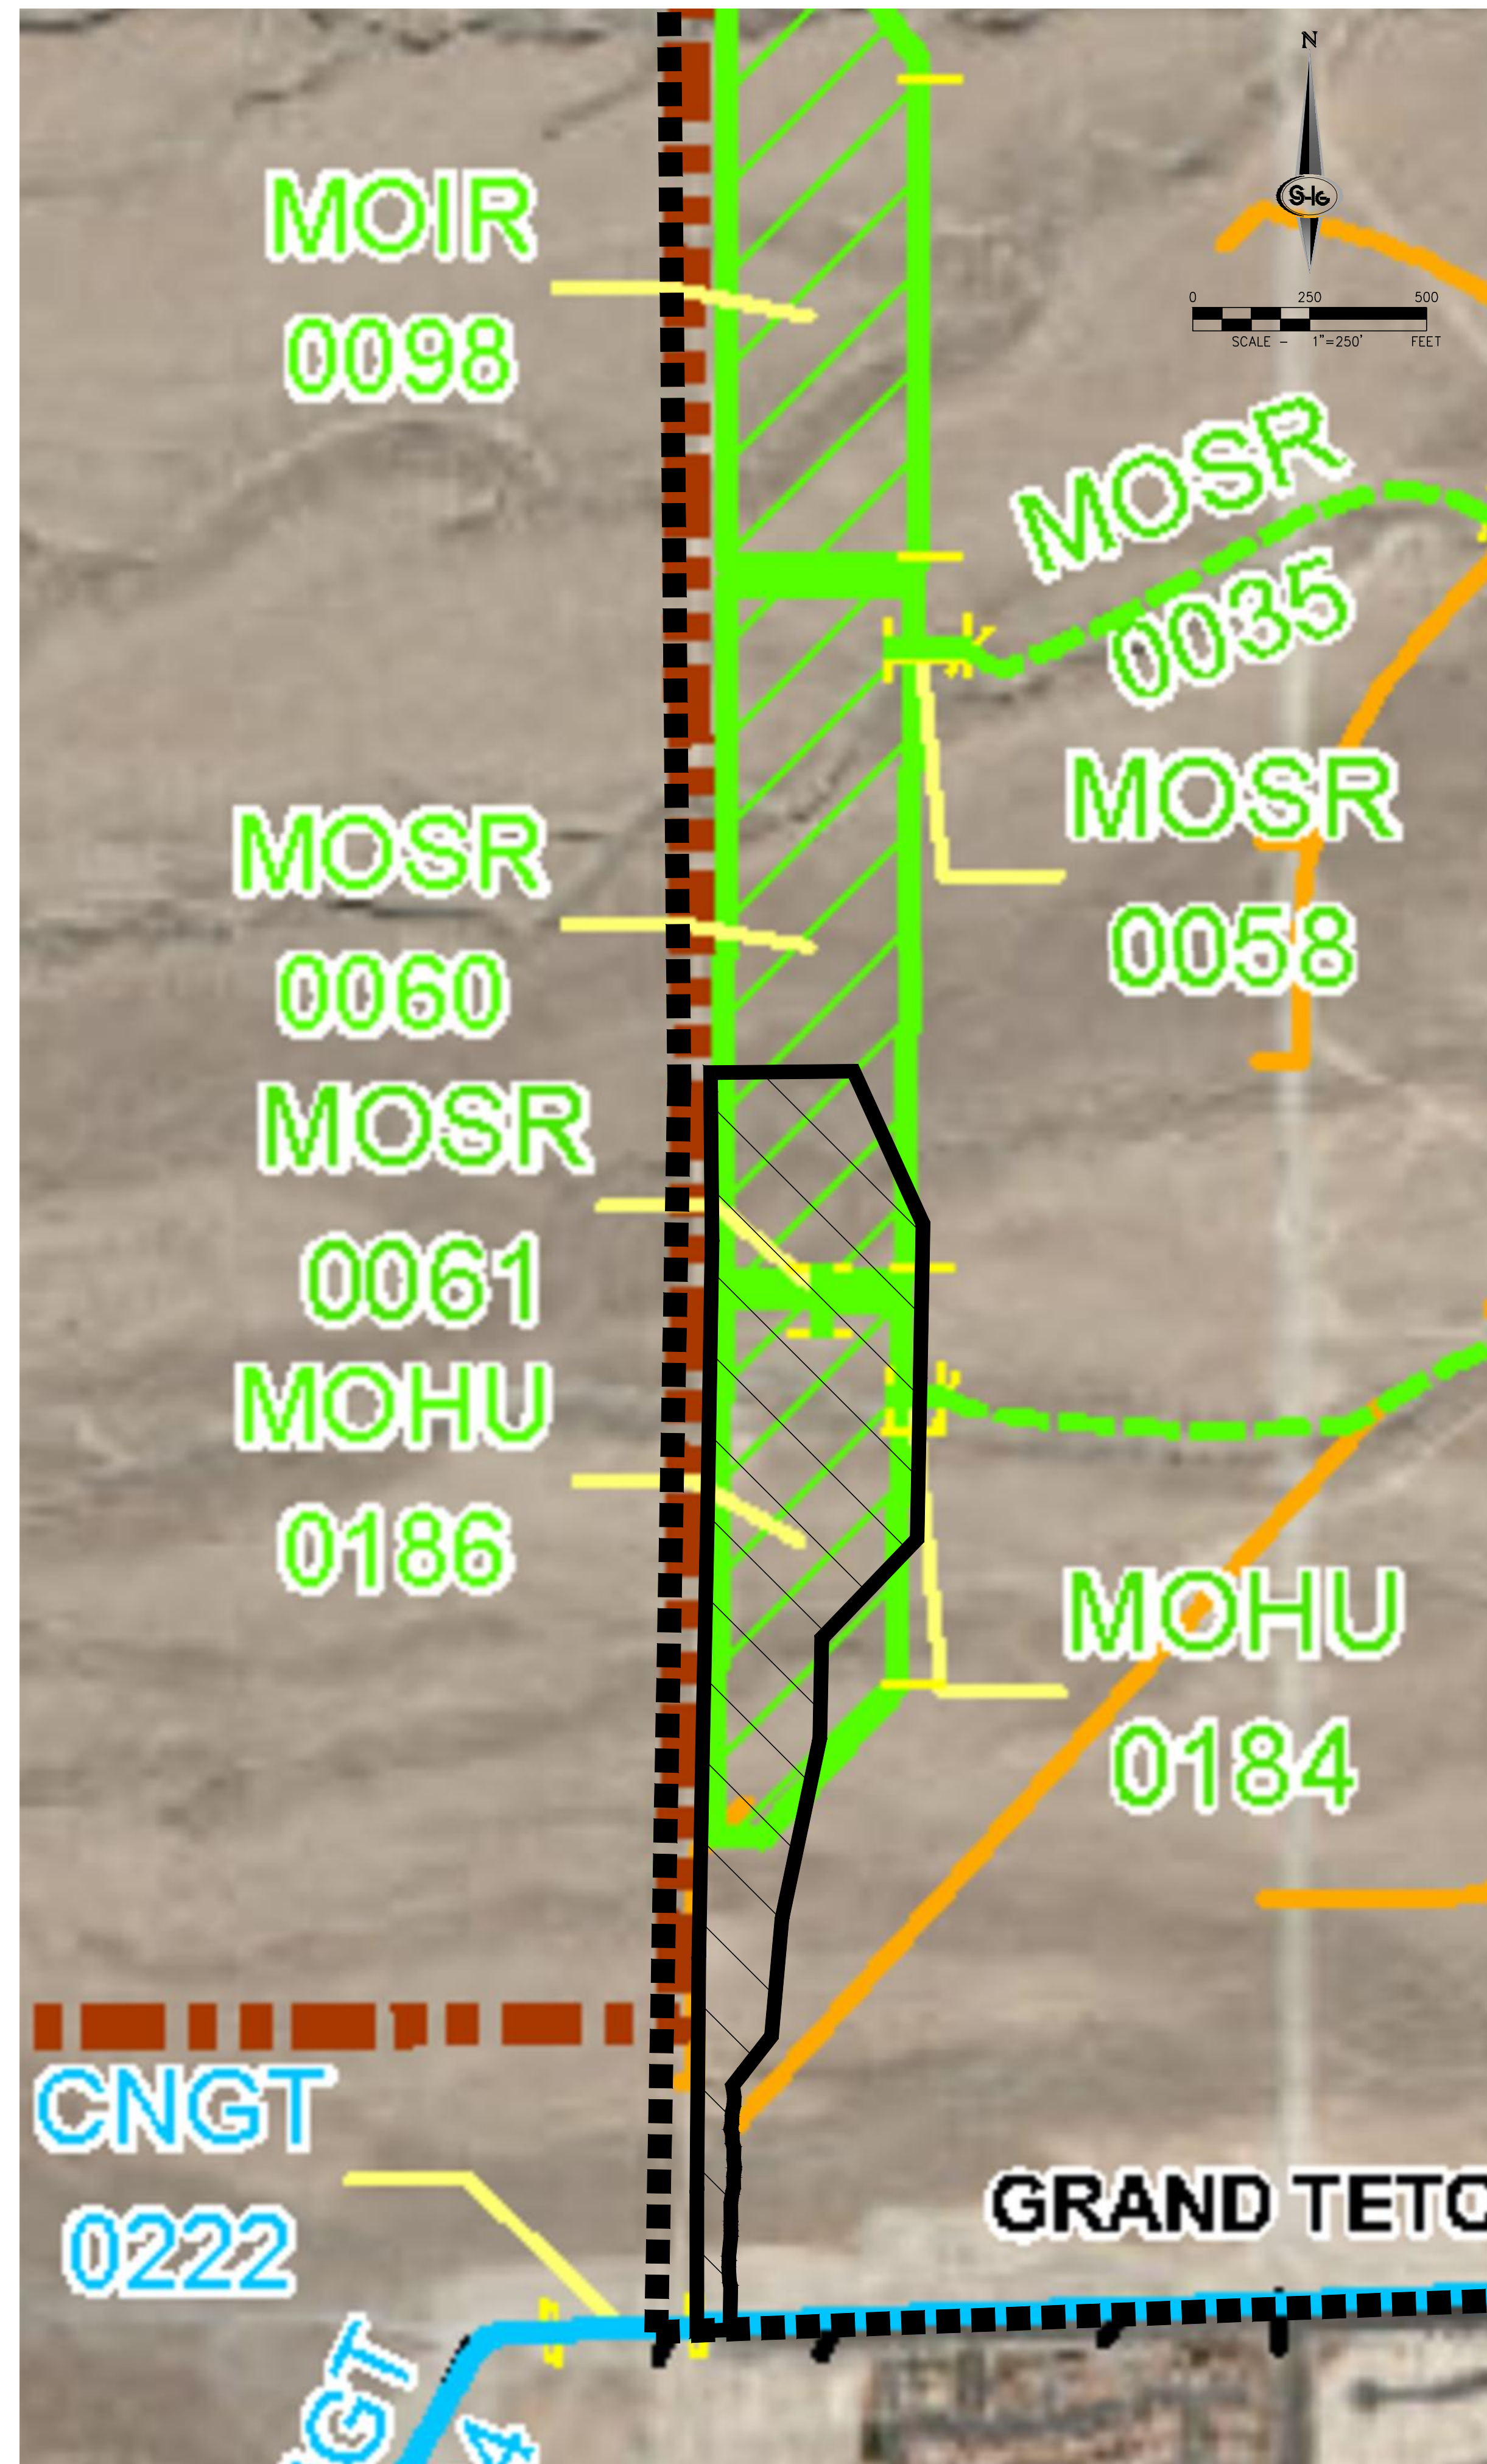

REGIONAL FLOOD CONTROL DISTRICT

2013
LAS VEGAS VALLEY
FLOOD CONTROL
MASTER PLAN UPDATE

FIGURE F- 12

FLOOD CONTROL FACILITIES

LEGEND

- Ultimate Development Boundary
- Existing Facilities
- Category A Proposed Facilities
- Category B Proposed Facilities
- Local Existing Facilities
- Local Proposed Facilities
- Stormdrain
- Lined Channel
- Unlined Channel
- Levee/Dike
- Natural Wash/Floodway
- ID-Mile Separator

Remove & Replace/Parallel Facilities

Category A	Category B
Channel	Channel
Stormdrain	Stormdrain

LEGEND	
	OLD PROPOSED BASIN BOUNDARY
	NEW PROPOSED BASIN BOUNDARY
	OVERLAPPING AREA

S-I-G
SLATER
HANIFAN
GROUP
CONSULTING ENGINEERS & PLANNERS
5740 S. ARVILLE STREET #216, LAS VEGAS, NV 89118
PHONE (702) 284-5300
FAX (702) 284-5399

[illegible]

NINETY-FIVE MANAGEMENT, LLC.

SKYE CANYON - DETENTION BASIN 1

CCRFCD 2013 MPU FACILITIES MAP

DATE:	SEPT 2014
DRAFTER:	WTM
DESIGNER:	WTM
CHECKED:	SMJ
PROJECT NO.	
OLY1401.004	

EXHIBIT C
SHEET 1 OF 1