



2013 MPU FACILITIES MAP

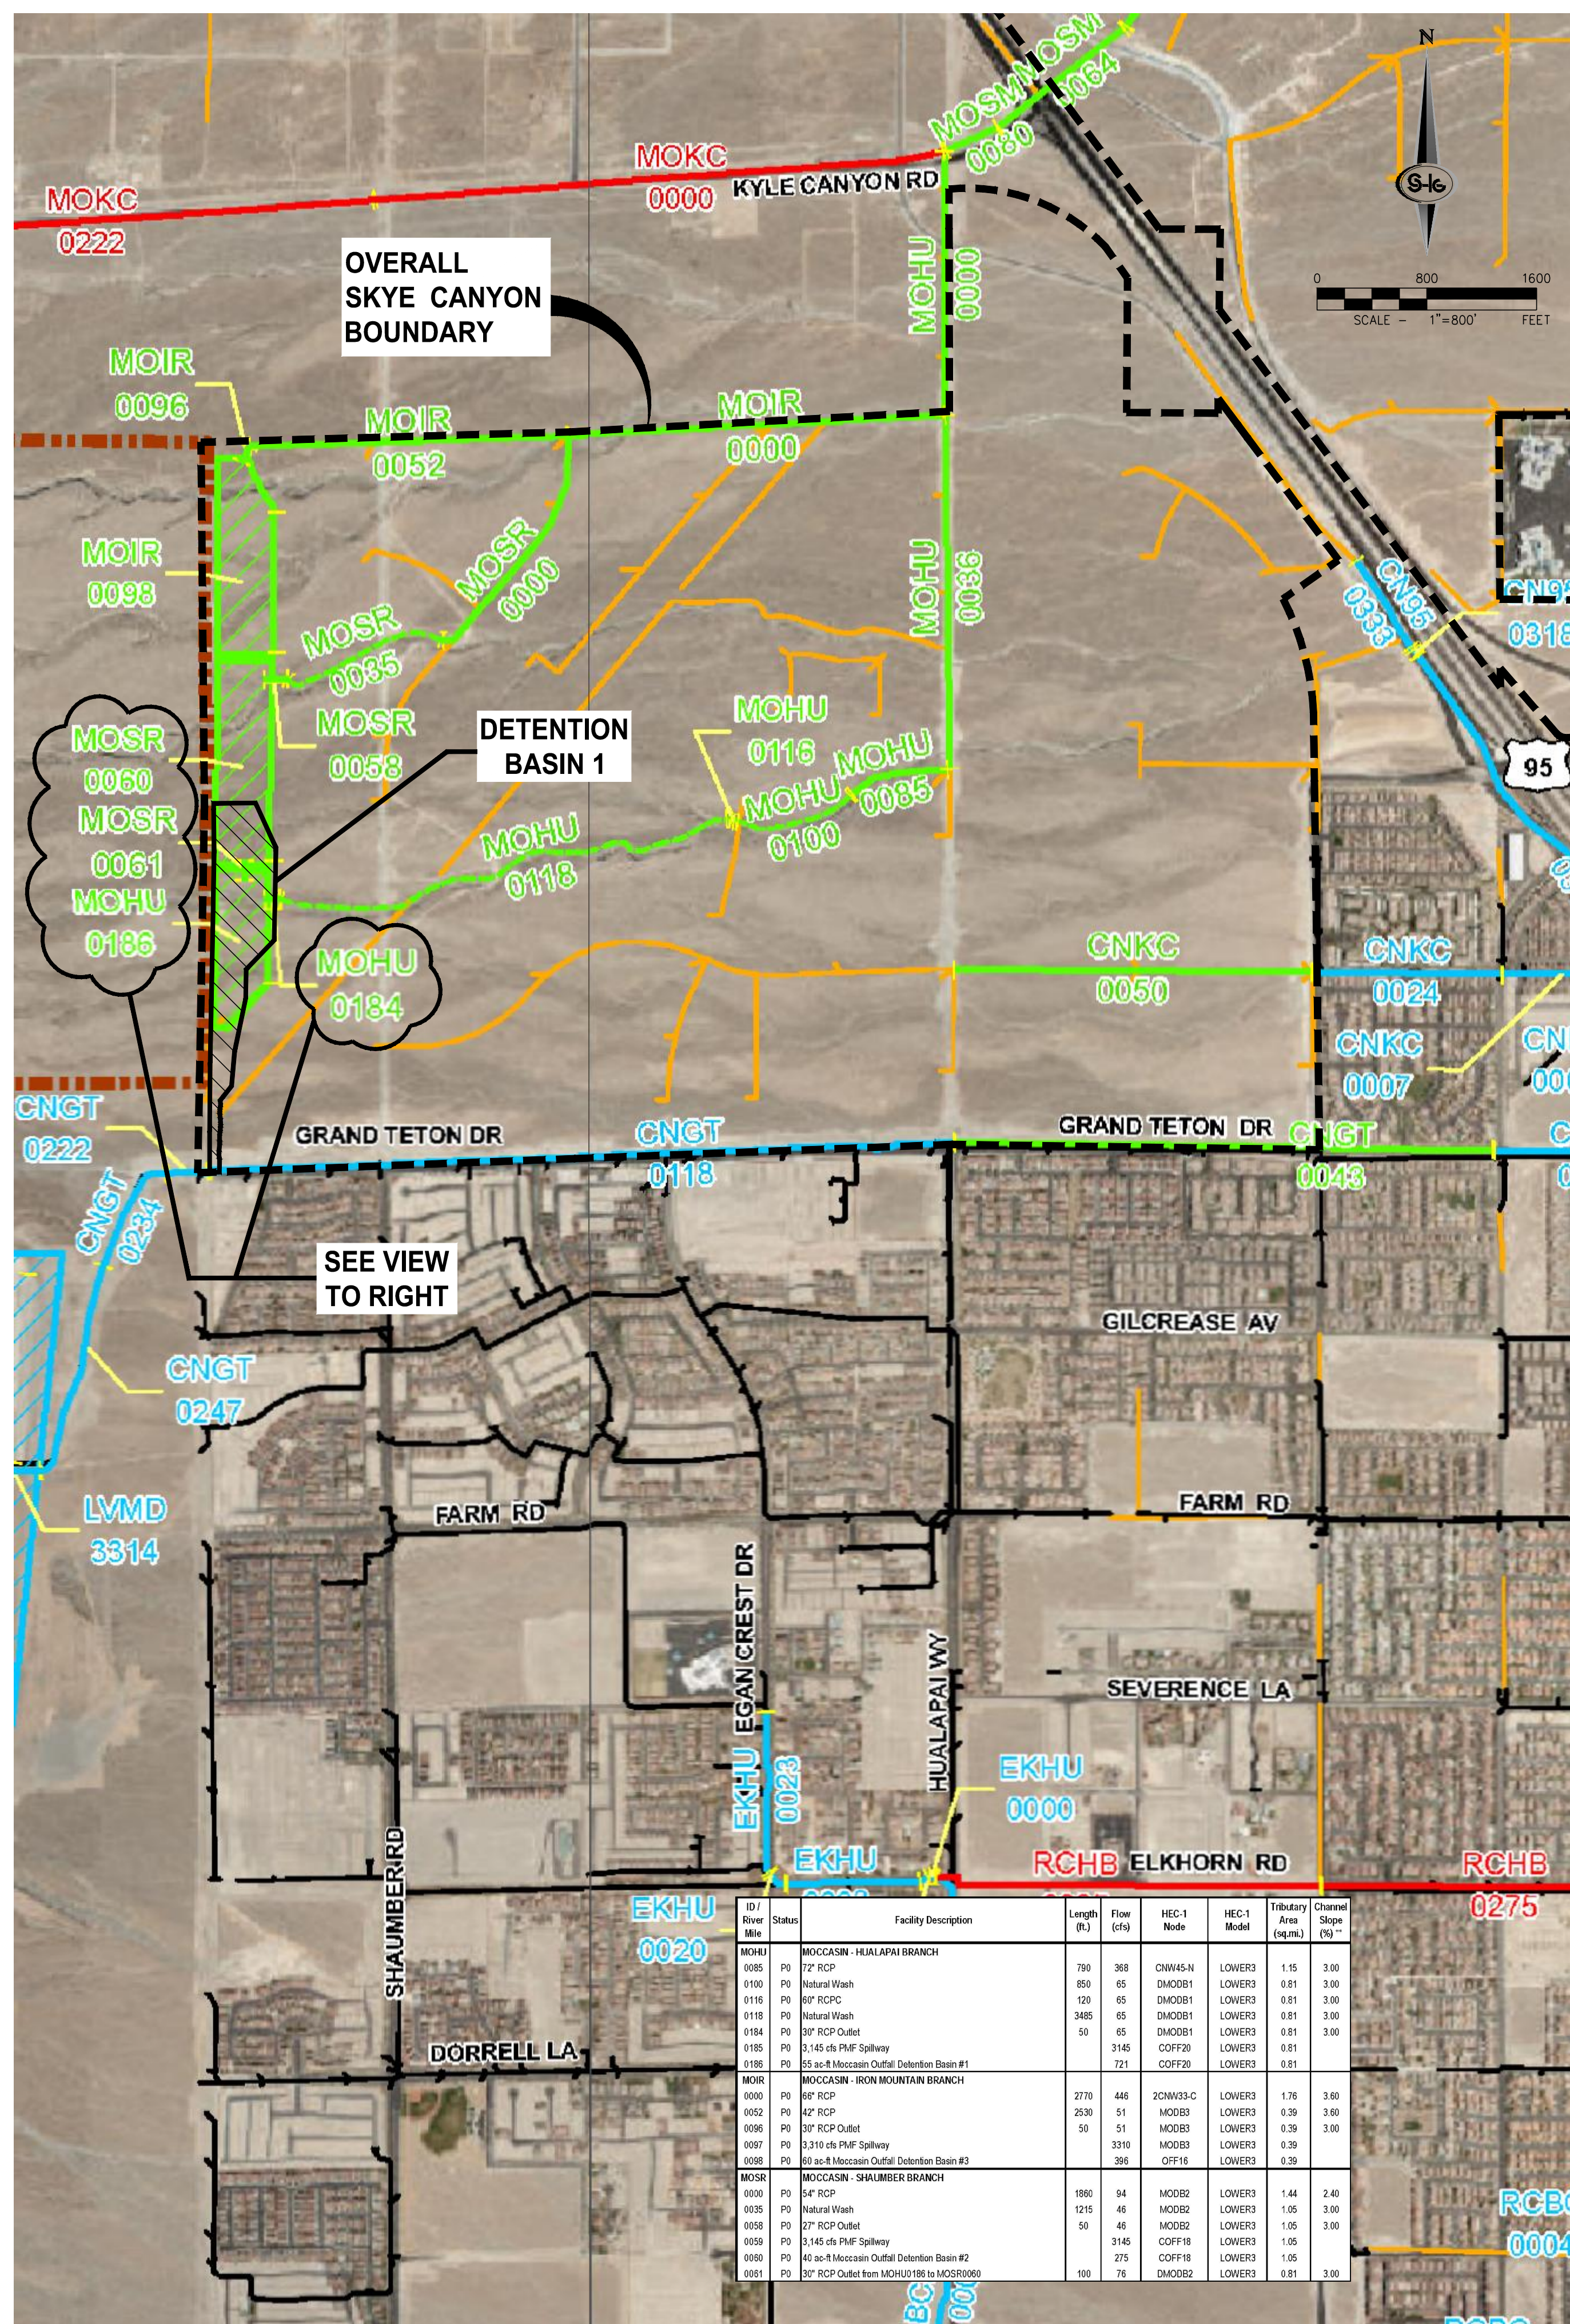

PROPOSED FOOTPRINT COMPARISON

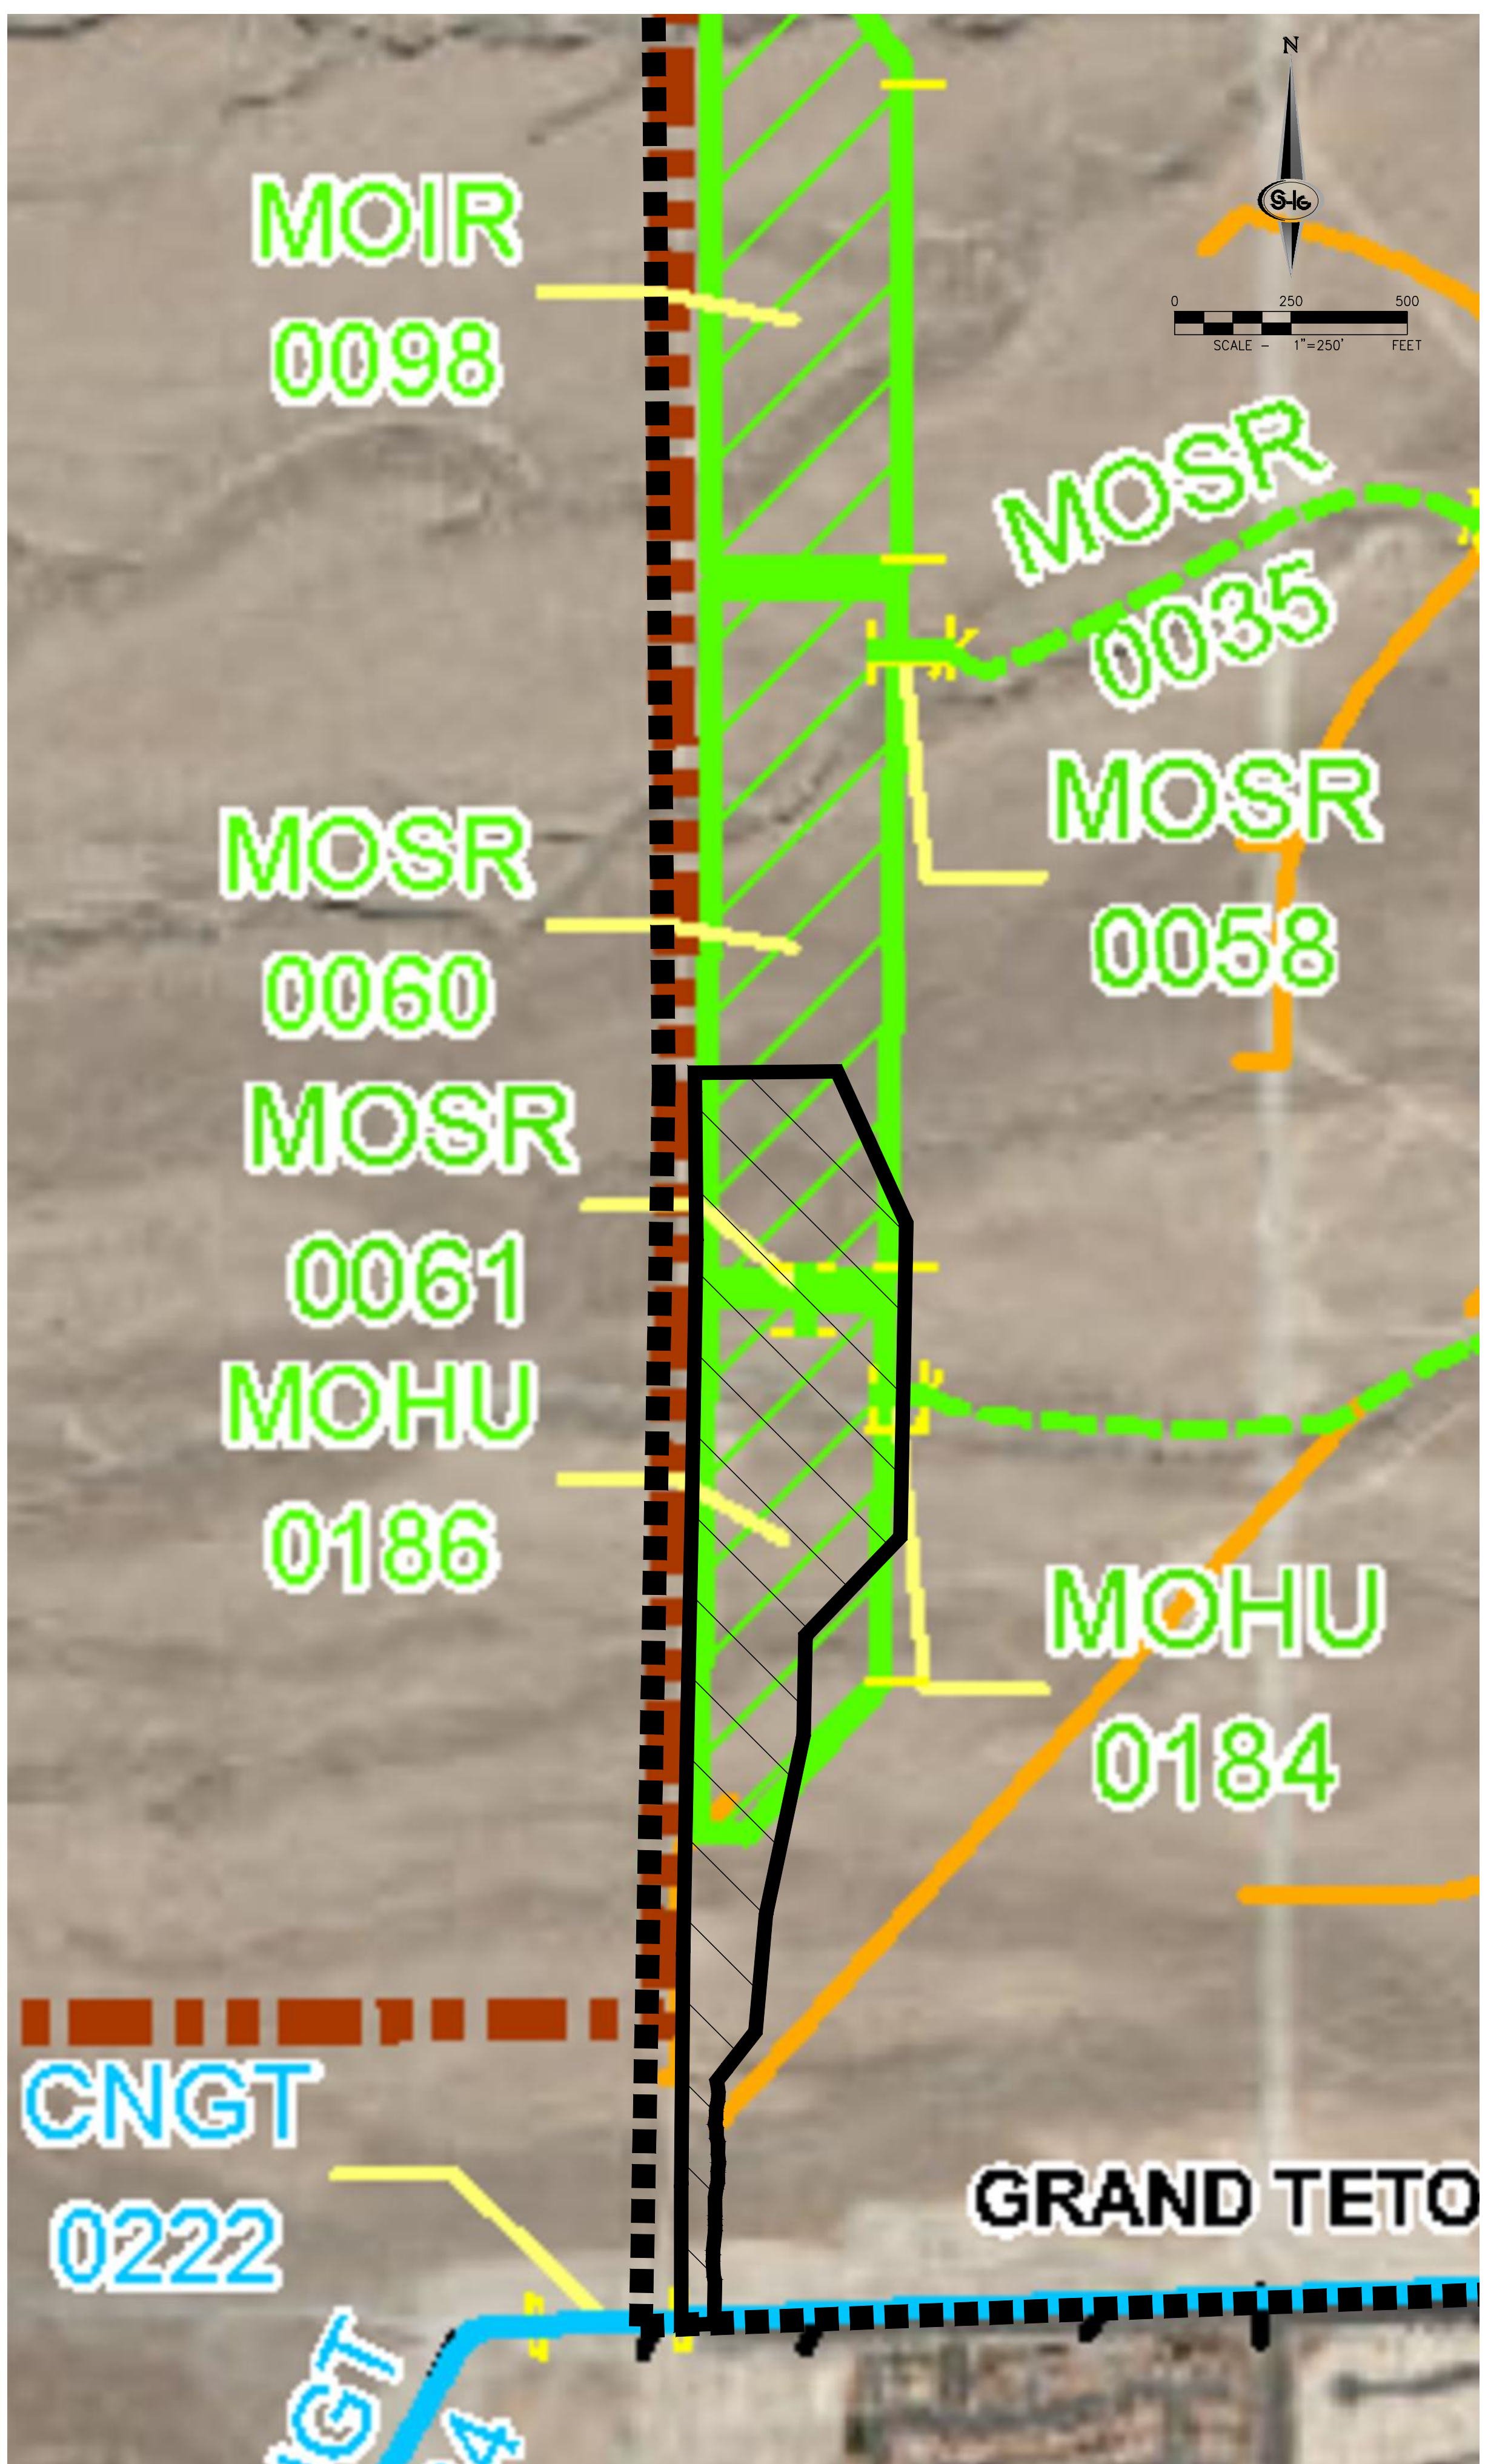

REGIONAL FLOOD CONTROL DISTRICT

2013 LAS VEGAS VALLEY FLOOD CONTROL MASTER PLAN UPDATE

FIGURE F- 12 FLOOD CONTROL FACILITIES

LEGEND

- Ultimate Development Boundary
- Existing Facilities
- Category A Proposed Facilities
- Category B Proposed Facilities
- Local Existing Facilities
- Local Proposed Facilities

Stormdrain

Lined Channel

Unlined Channel

Levee/Dike

Natural Wash/Floodway

ID-Mile Separator

Remove & Replace/Parallel Facilities

Category A

Category B

Channel

Stormdrain

Channel

Stormdrain

LEGEND

- OLD PROPOSED BASIN BOUNDARY
- NEW PROPOSED BASIN BOUNDARY
- OVERLAPPING AREA

SLATER HANIFAN GROUP

CONSULTING ENGINEERS & PLANNERS

5740 S. ARVILLE STREET #216, LAS VEGAS, NV 89118

PHONE (702) 284-5300

FAX (702) 284-5399

DATE: SEPT 2014

DRAFTER: WTM

DESIGNER: WTM

CHECKED: SMJ

PROJECT NO. OLY1401.004

EXHIBIT C

SHEET 1 OF 1