




2013
KYLE CANYON AMENDMENT TO
LAS VEGAS VALLEY
FLOOD CONTROL
MASTER PLAN UPDATE

LEGEND

- Facility Revised by Amendment
- Ultimate Development Boundary
- Existing Facilities
- Category A Proposed Facilities
- Category B Proposed Facilities
- Local Existing Facilities
- Local Proposed Facilities
- Detention Basin
- Culvert or Bridge Crossing
- Stormdrain
- Lined Channel
- Unlined Channel
- Levee/Dike
- Natural Wash/Floodway
- ID-Mile Separator

Remove & Replace/Parallel Facilities

- | Category A | Category B |
|------------|------------|
| Channel | Channel |
| Stormdrain | Stormdrain |
| Crossing | Crossing |

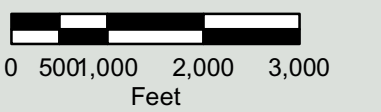

Scale: 1 inch = 2,000 feet

US95						I-15		
1	2	3						
4	5	6						
	7	8	9	10		1215		
11	12	13	14	15	16	17		
18	19	20	21	22	23			
24	25	26	27	28				
29	30	31	32	33	34			
35	36	37	38	39	40			
41	42	43	44	45	46			
47	48	49	50	51	52			
53	54	55	56					
57	58	59						

