




2013
KYLE CANYON AMENDMENT TO
LAS VEGAS VALLEY
FLOOD CONTROL
MASTER PLAN UPDATE

LEGEND

- Facility Revised by Amendment
- Ultimate Development Boundary
- Existing Facilities
- Category A Proposed Facilities
- Category B Proposed Facilities
- Local Existing Facilities
- Local Proposed Facilities
- Detention Basin
- Culvert or Bridge Crossing
- Stormdrain
- Lined Channel
- Unlined Channel
- Levee/Dike
- Natural Wash/Floodway
- ID-Mile Separator

- Remove & Replace/Parallel Facilities
- | Category A | Category B |
|------------|------------|
| Channel | Channel |
| Stormdrain | Stormdrain |
| Crossing | Crossing |

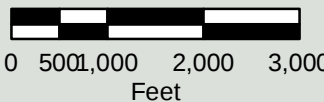

Scale: 1 inch = 2,000 feet

US95	1	2	3			
	4	5	6			
	7	8	9	10		
	11	12	13	14	15	16
	17	18	19	20	21	22
	23	24	25	26	27	28
	29	30	31	32	33	34
	35	36	37	38	39	40
	41	42	43	44	45	46
	47	48	49	50	51	52
	53	54	55	56		
	57	58	59			

