


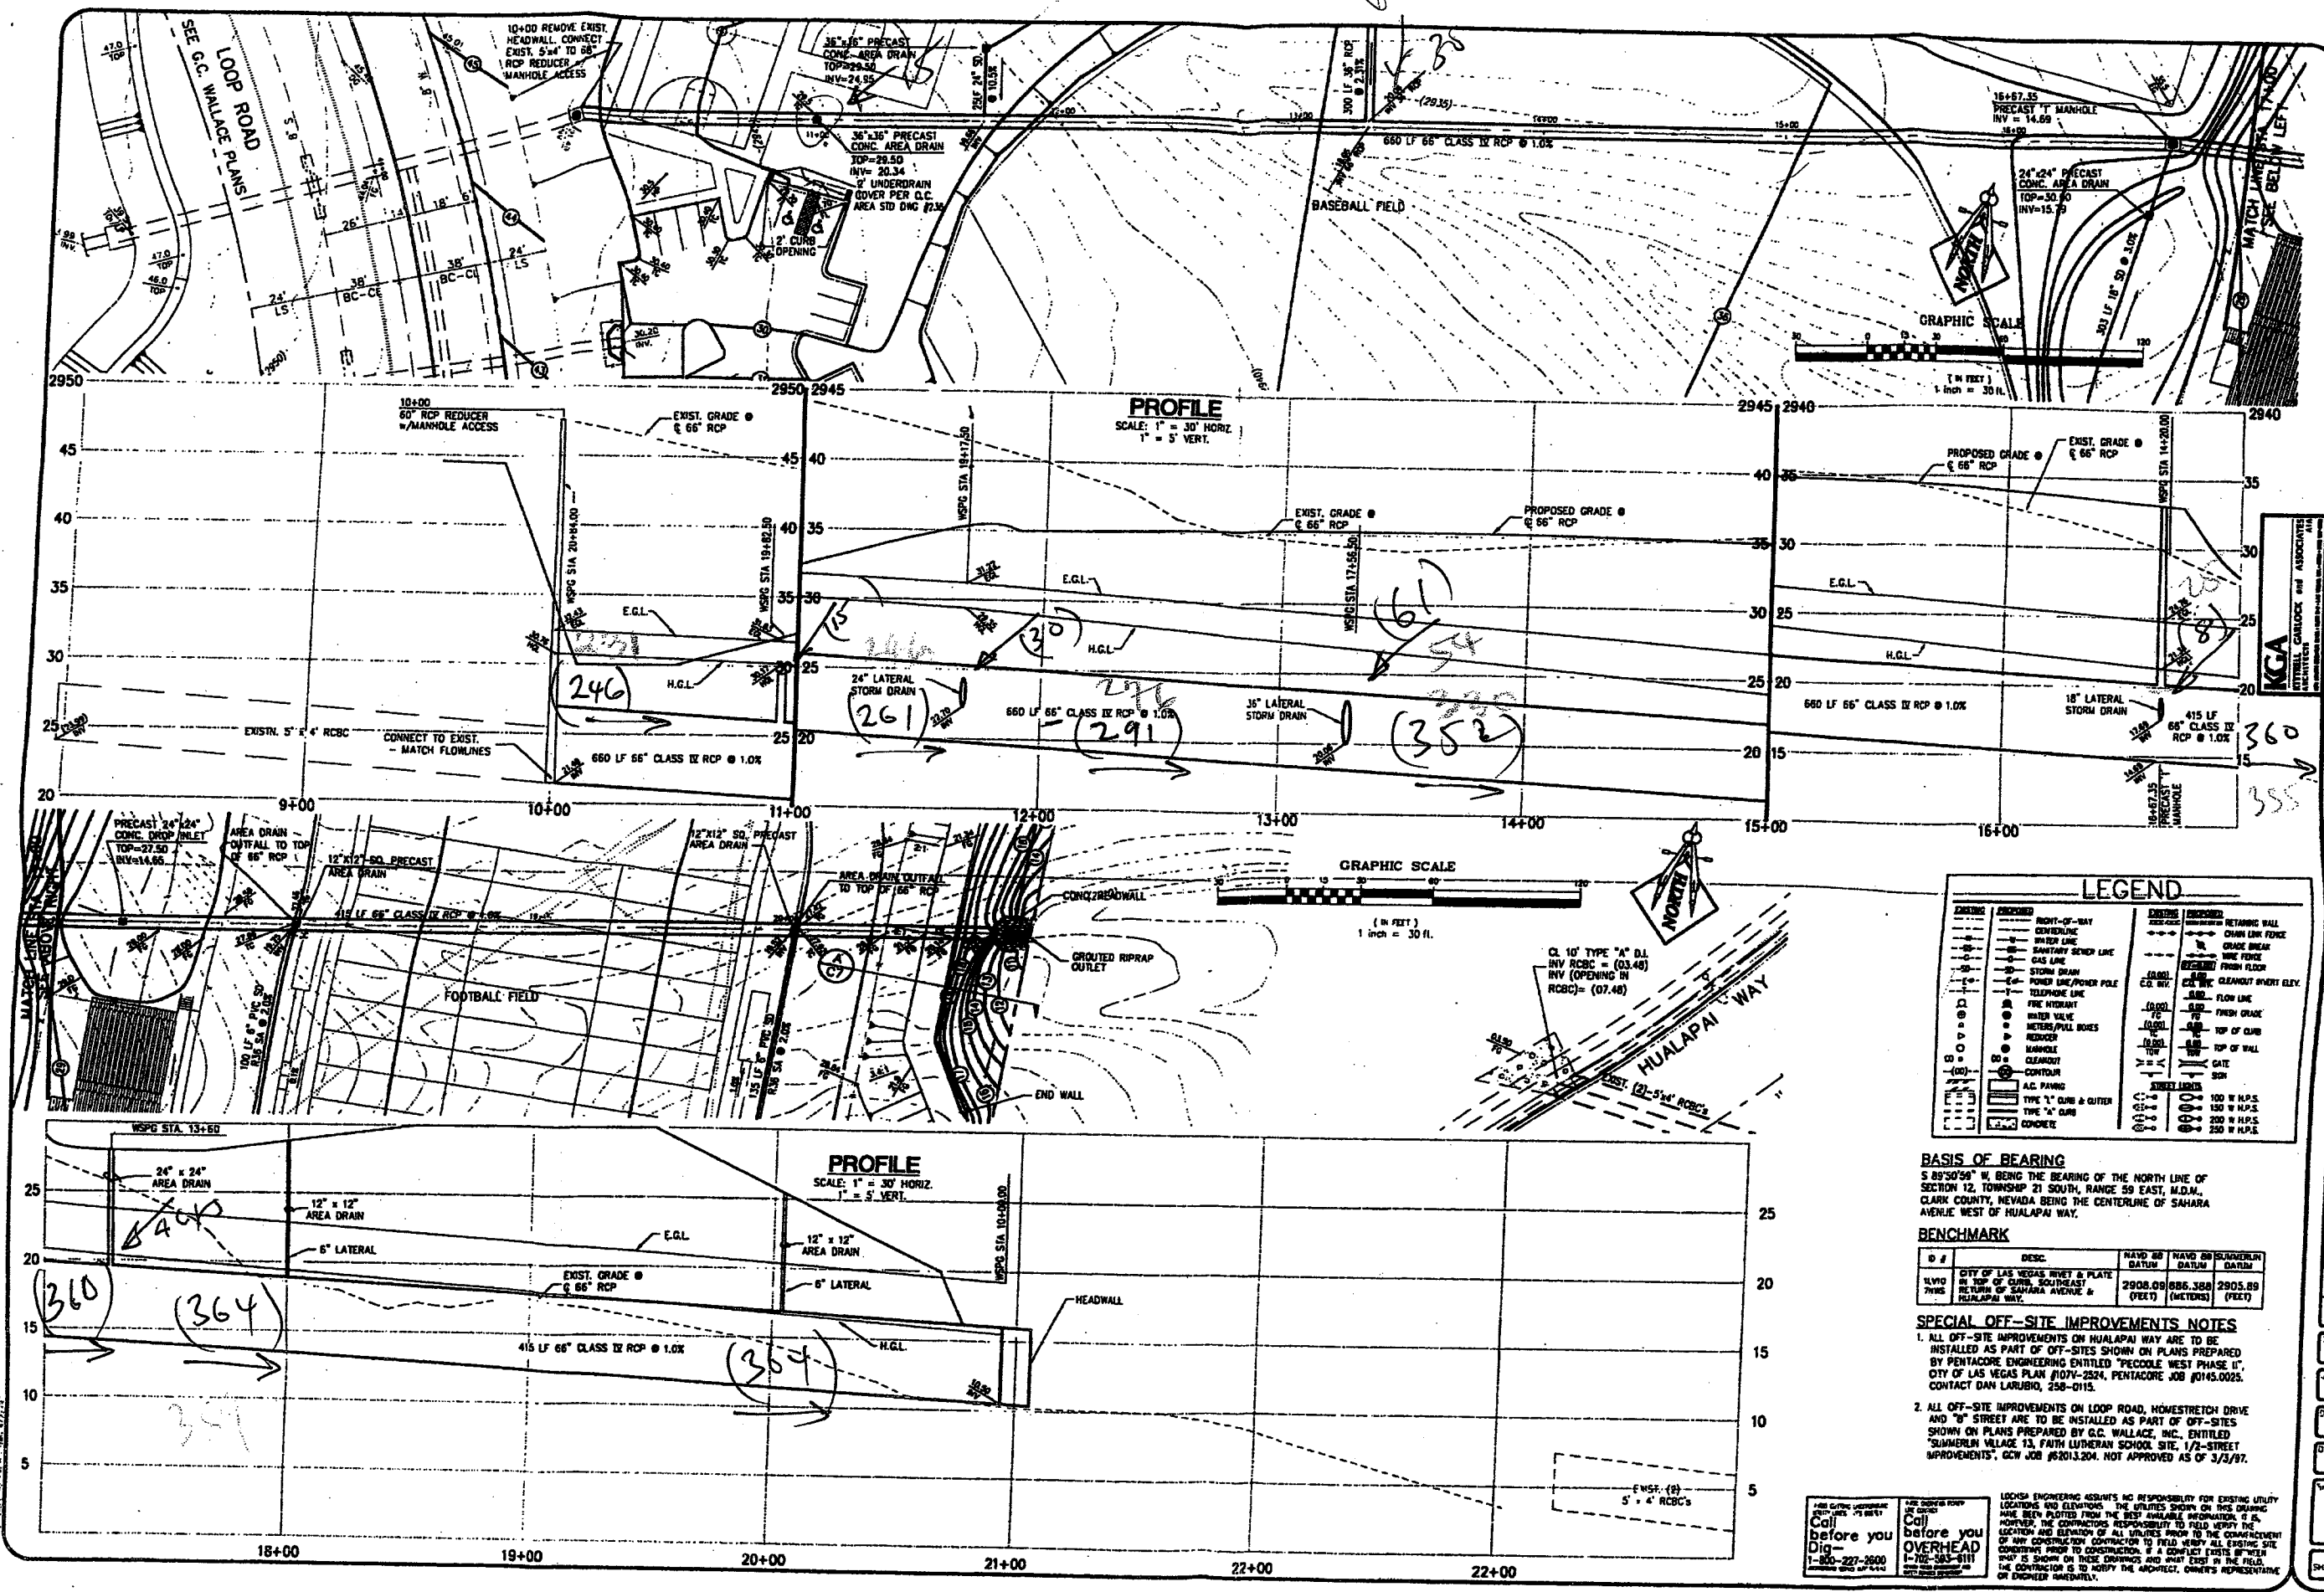

LEGEND			
SYMBOL	DESCRIPTION	SYMBOL	DESCRIPTION
(Line with cross-ticks)	RIGHT-OF-WAY	(Line with cross-ticks)	RETAINING WALL
(Line with cross-ticks)	WATER LINE	(Line with cross-ticks)	CHAIN LINK FENCE
(Line with cross-ticks)	SANITARY SEWER LINE	(Line with cross-ticks)	CRACK BREAK
(Line with cross-ticks)	GAS LINE	(Line with cross-ticks)	WIRE FENCE
(Line with cross-ticks)	STORM DRAIN	(Line with cross-ticks)	FRONT FLOOR
(Line with cross-ticks)	POWER LINE/POLE	(Line with cross-ticks)	BACKLASH CLEANOUT SHORT ELEV.
(Line with cross-ticks)	TELEPHONE LINE	(Line with cross-ticks)	FRONT GRADE
(Line with cross-ticks)	FIRE HYDRANT	(Line with cross-ticks)	FRONT GRADE
(Line with cross-ticks)	WATER VALVE	(Line with cross-ticks)	TOP OF WALL
(Line with cross-ticks)	METERS/PULL BOXES	(Line with cross-ticks)	DATE
(Line with cross-ticks)	REDUCER	(Line with cross-ticks)	SH
(Line with cross-ticks)	MANHOLE	(Line with cross-ticks)	100 W.H.P.S.
(Line with cross-ticks)	CLEANOUT	(Line with cross-ticks)	150 W.H.P.S.
(Line with cross-ticks)	CONDUIT	(Line with cross-ticks)	200 W.H.P.S.
(Line with cross-ticks)	A.C. PAVING	(Line with cross-ticks)	250 W.H.P.S.
(Line with cross-ticks)	TYPE "A" CURB & GUTTER	(Line with cross-ticks)	
(Line with cross-ticks)	TYPE "A" CURB	(Line with cross-ticks)	
(Line with cross-ticks)	CONCRETE	(Line with cross-ticks)	

BASIS OF BEARING
S 89°50'59" W, BEING THE BEARING OF THE NORTH LINE OF SECTION 12, TOWNSHIP 21 SOUTH, RANGE 59 EAST, M.D.M., CLARK COUNTY, NEVADA BEING THE CENTERLINE OF SAHARA AVENUE WEST OF HUALAPAI WAY.

BENCHMARK			
NO.	DESC.	NAVD 83 DATUM	NAVD 83 BENCHMARK DATUM
1110	CITY OF LAS VEGAS RIVER & PLATE	2908.09 (FEET)	2905.89 (FEET)
1111	RETURN OF SAHARA AVENUE & HUALAPAI WAY		

SPECIAL OFF-SITE IMPROVEMENTS NOTES
1. ALL OFF-SITE IMPROVEMENTS ON HUALAPAI WAY ARE TO BE INSTALLED AS PART OF OFF-SITES SHOWN ON PLANS PREPARED BY PENTACORE ENGINEERING ENTITLED "PECCOLE WEST PHASE II", CITY OF LAS VEGAS PLAN #107V-2524, PENTACORE JOB #0145.0025, CONTACT DAN LARUBIO, 258-0115.
2. ALL OFF-SITE IMPROVEMENTS ON LOOP ROAD, HOMESTRETCH DRIVE AND "B" STREET ARE TO BE INSTALLED AS PART OF OFF-SITES SHOWN ON PLANS PREPARED BY G.C. WALLACE, INC. ENTITLED "SUMMERLAD VILLAGE 13, FAITH LUTHERAN SCHOOL SITE, 1/2-STREET IMPROVEMENTS", GCW JOB #62013.204, NOT APPROVED AS OF 3/3/97.

LOCKSA ENGINEERING ASSUMES NO RESPONSIBILITY FOR EXISTING UTILITY LOCATIONS AND ELEVATIONS. THE UTILITIES SHOWN ON THIS DRAWING HAVE BEEN PLOTTED FROM THE BEST AVAILABLE INFORMATION. IT IS HOWEVER, THE CONTRACTOR'S RESPONSIBILITY TO FIELD VERIFY THE LOCATION AND ELEVATION OF ALL UTILITIES PRIOR TO THE COMMENCEMENT OF ANY CONSTRUCTION. IF A CONFLICT EXISTS BETWEEN THE INFORMATION SHOWN ON THESE DRAWINGS AND WHAT EXIST IN THE FIELD, THE CONTRACTOR IS TO NOTIFY THE ARCHITECT, OWNER'S REPRESENTATIVE OR ENGINEER IMMEDIATELY.

LOCKSA ENGINEERING
3001 S. Valley View Blvd.
Las Vegas, Nevada 89102
Phone (702) 385-8372
Fax (702) 385-8377

**FAITH LUTHERAN
JUNIOR / SENIOR
HIGH SCHOOL**

**STORM DRAIN
PLAN & PROFILE**

DATE	MARCH 24, 1997
JOB NO.	1182
DESIGN BY	MARK L. HEDGE
DRAWN BY	M.G.G.
CHECKED BY	
SCALE	C14
SHEET	14 OF 15