


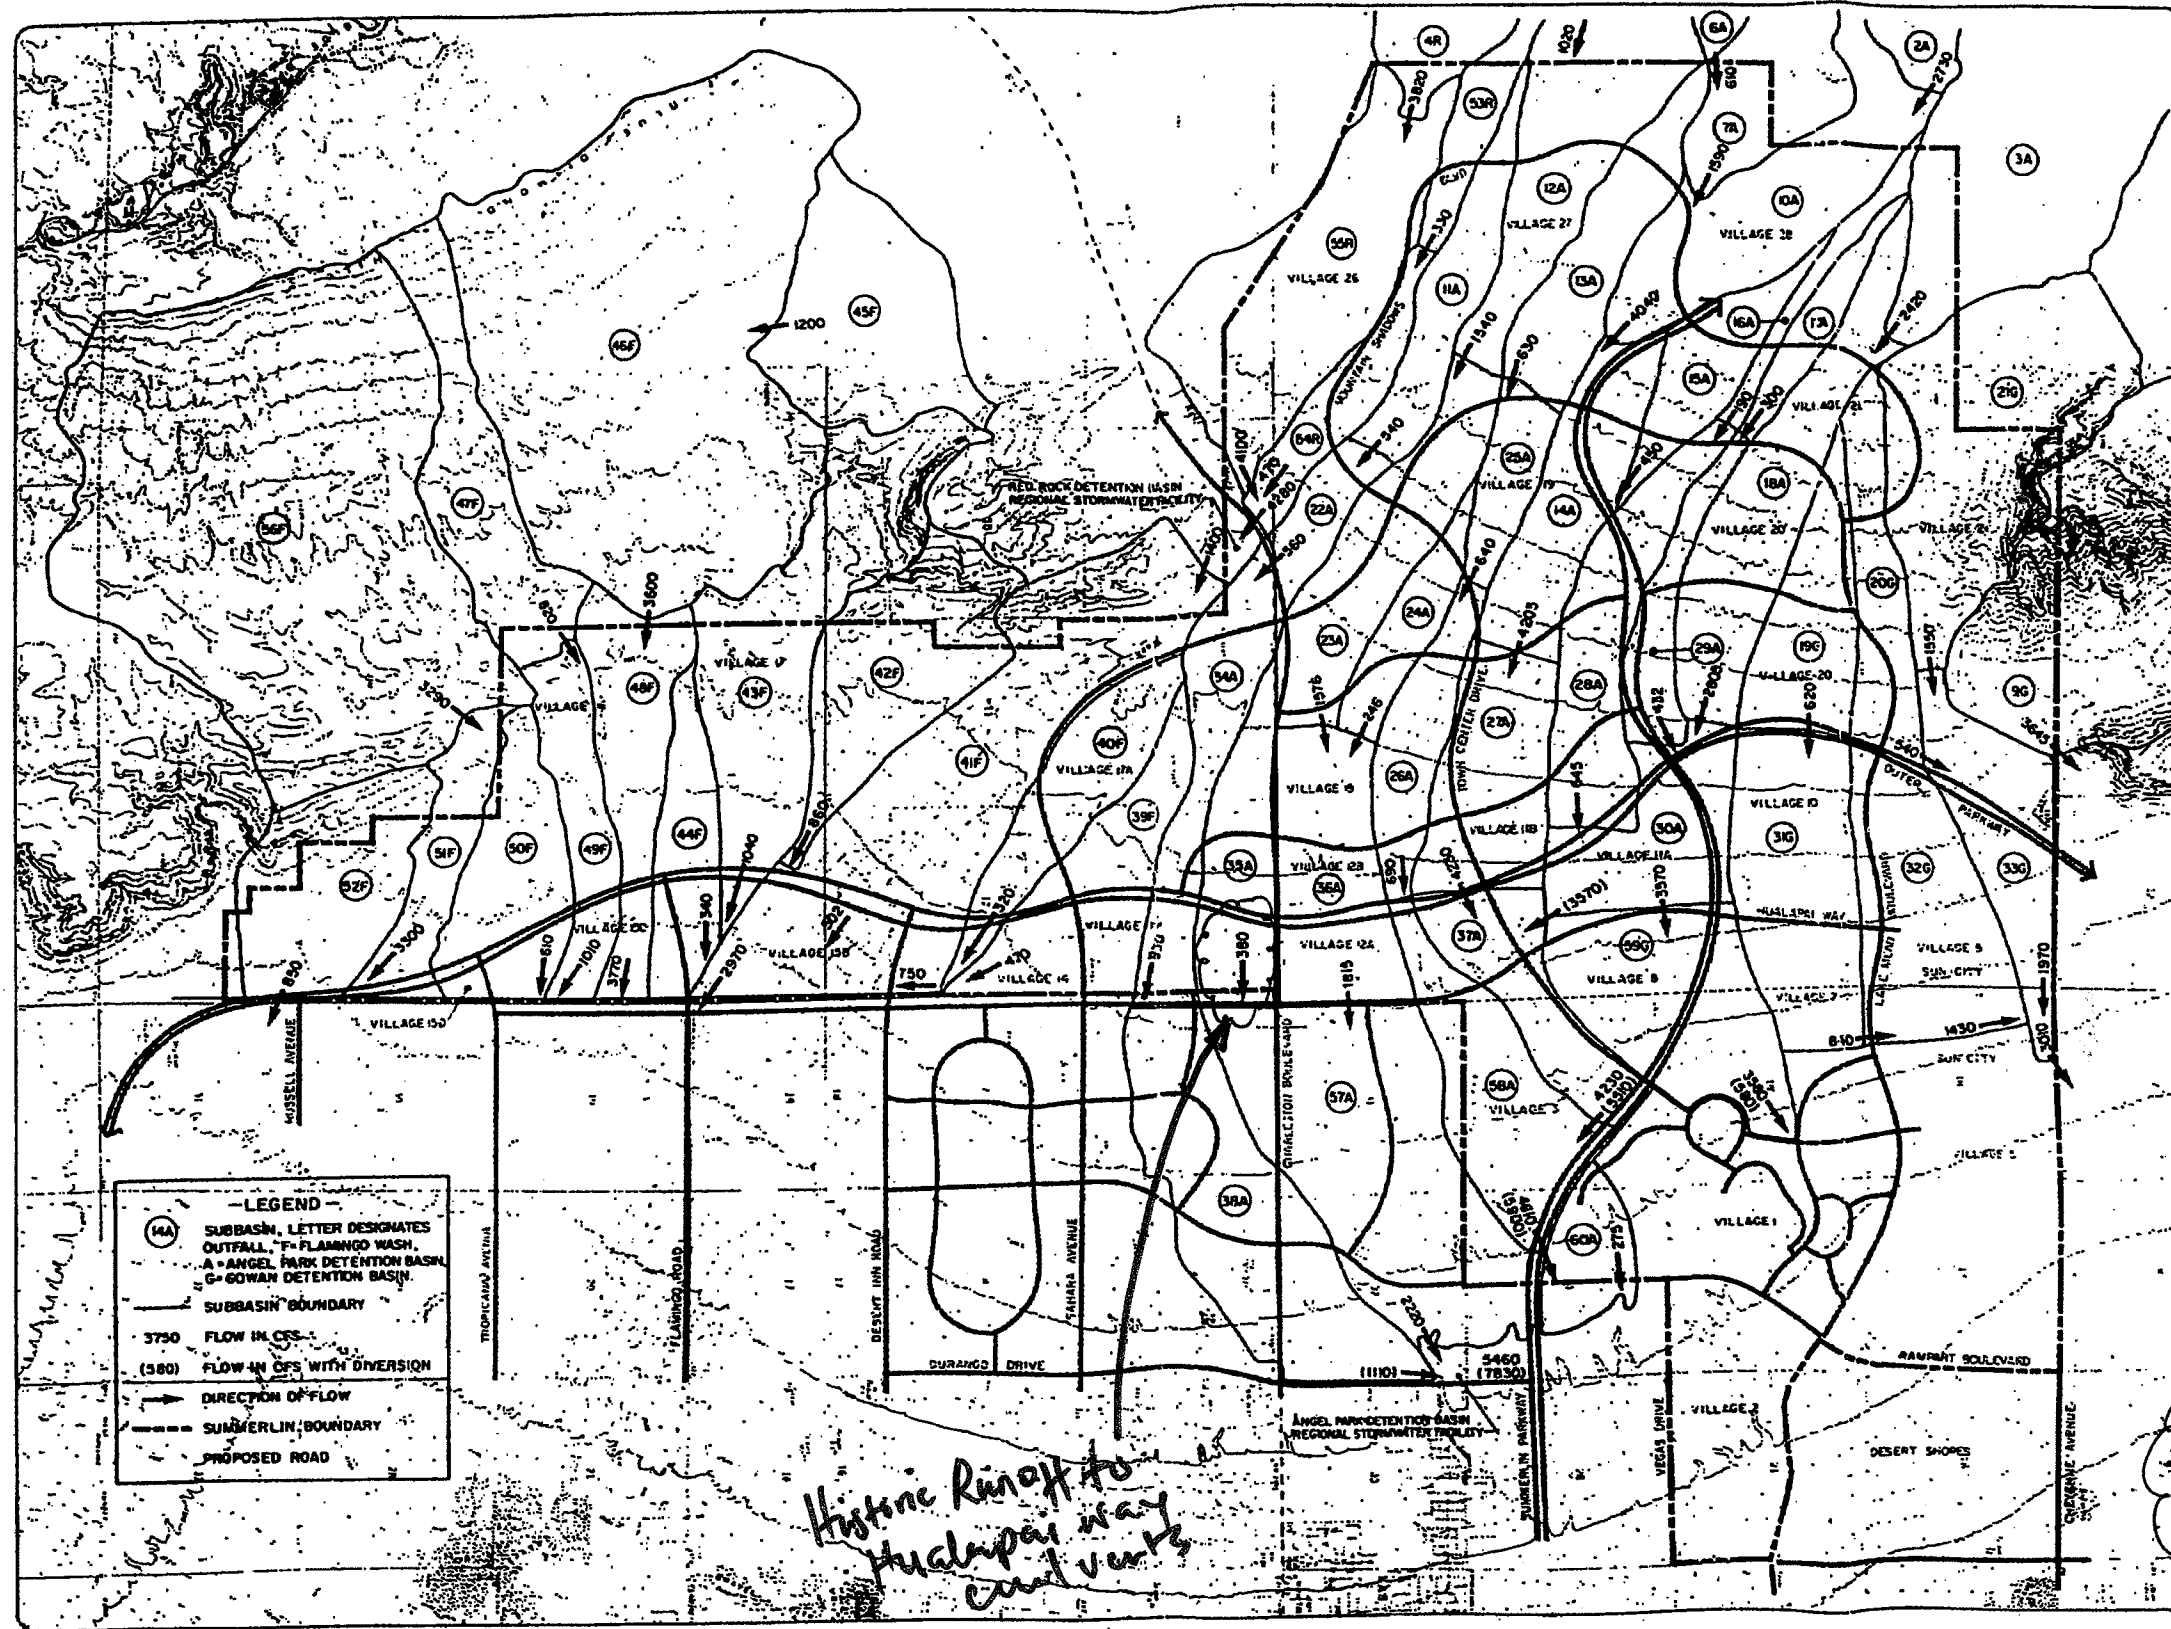

LEGEND


- (14A) SUBBASIN, LETTER DESIGNATES OUTFALL, F-FLAMINGO WASH, A-ANGEL PARK DETENTION BASIN, G-GOWAN DETENTION BASIN.
- SUBBASIN BOUNDARY
- 3750 FLOW IN CFS
- (380) FLOW IN CFS WITH DIVERSION
- DIRECTION OF FLOW
- SUMMERLIN BOUNDARY
- PROPOSED ROAD

SUMMERLIN

Stormwater Management Plan

HYDROLOGY WITH LAND USE MASTER PLAN

FIGURE 12

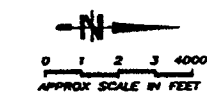

Boyle Engineering Corporation
 1785 E SHAWAN AVE SUITE 300
 LAS VEGAS, NEVADA 89104
 (702) 731-5511