


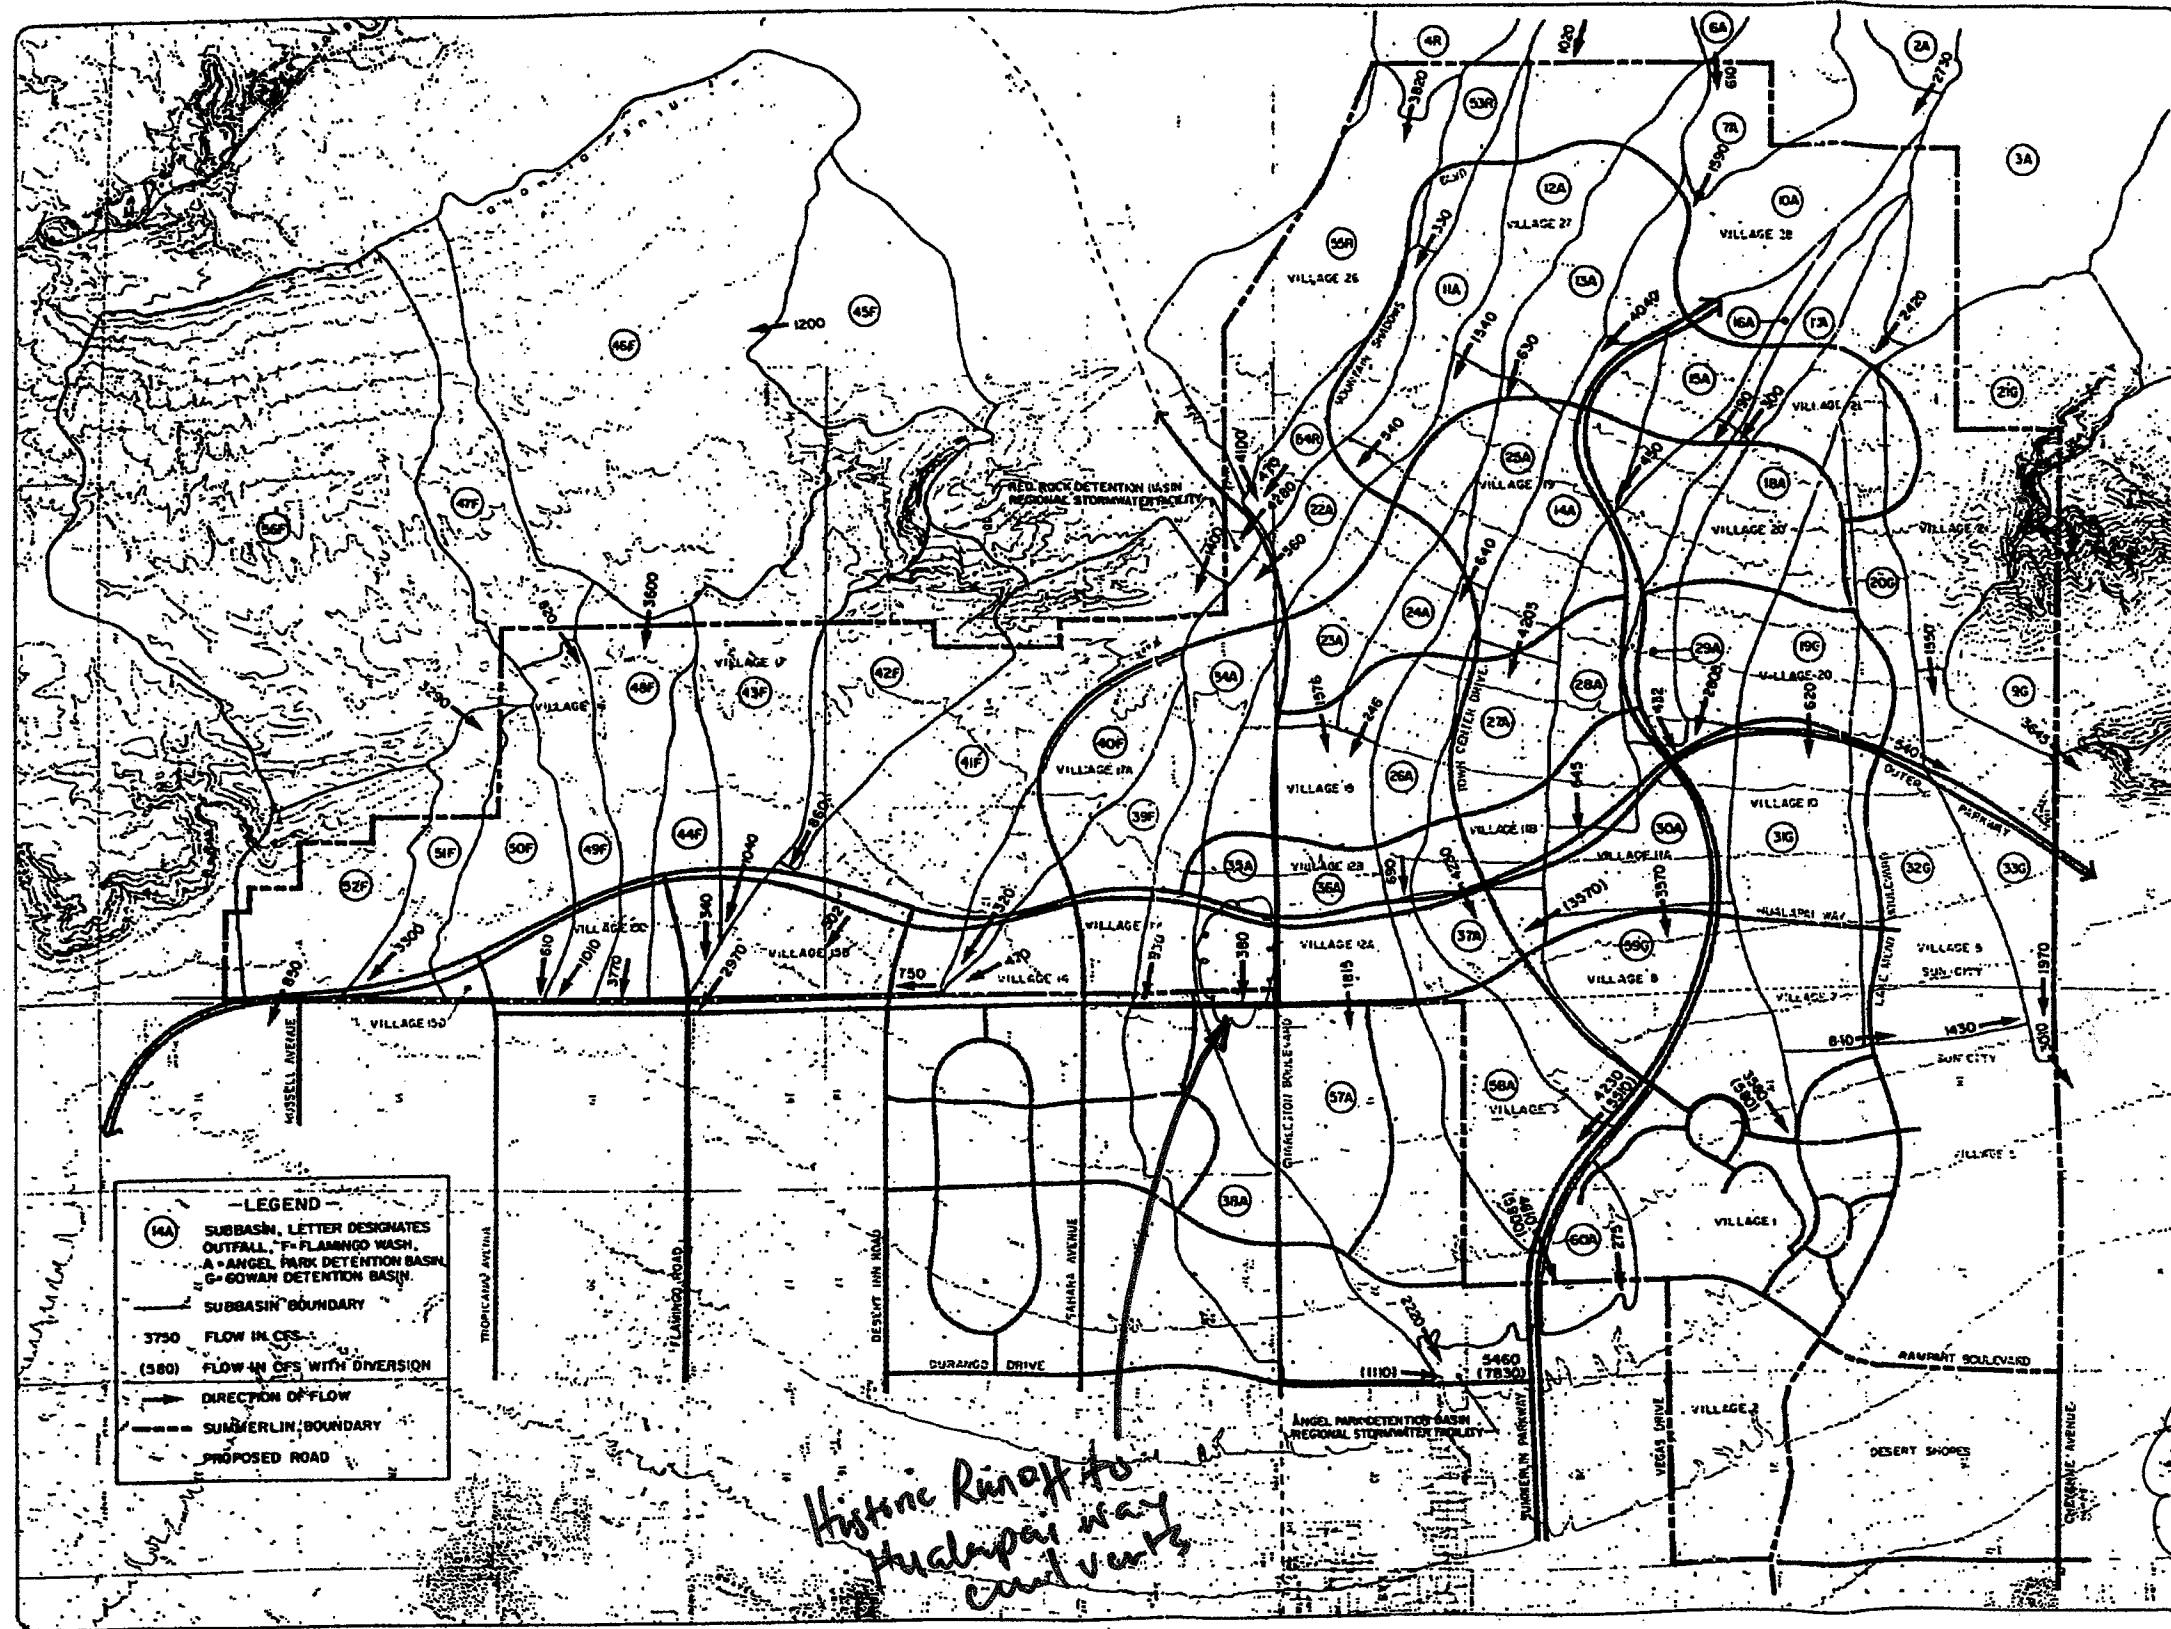

SUMMERLIN

Stormwater Management Plan

HYDROLOGY WITH LAND USE MASTER PLAN

FIGURE 12

0 1 2 3 4000
APPROX SCALE IN FEET

Boyle Engineering Corporation
1785 E SHAWAN AVE SUITE 300
LAS VEGAS, NEVADA 89104
(702) 731-5511

FIGURE
5