

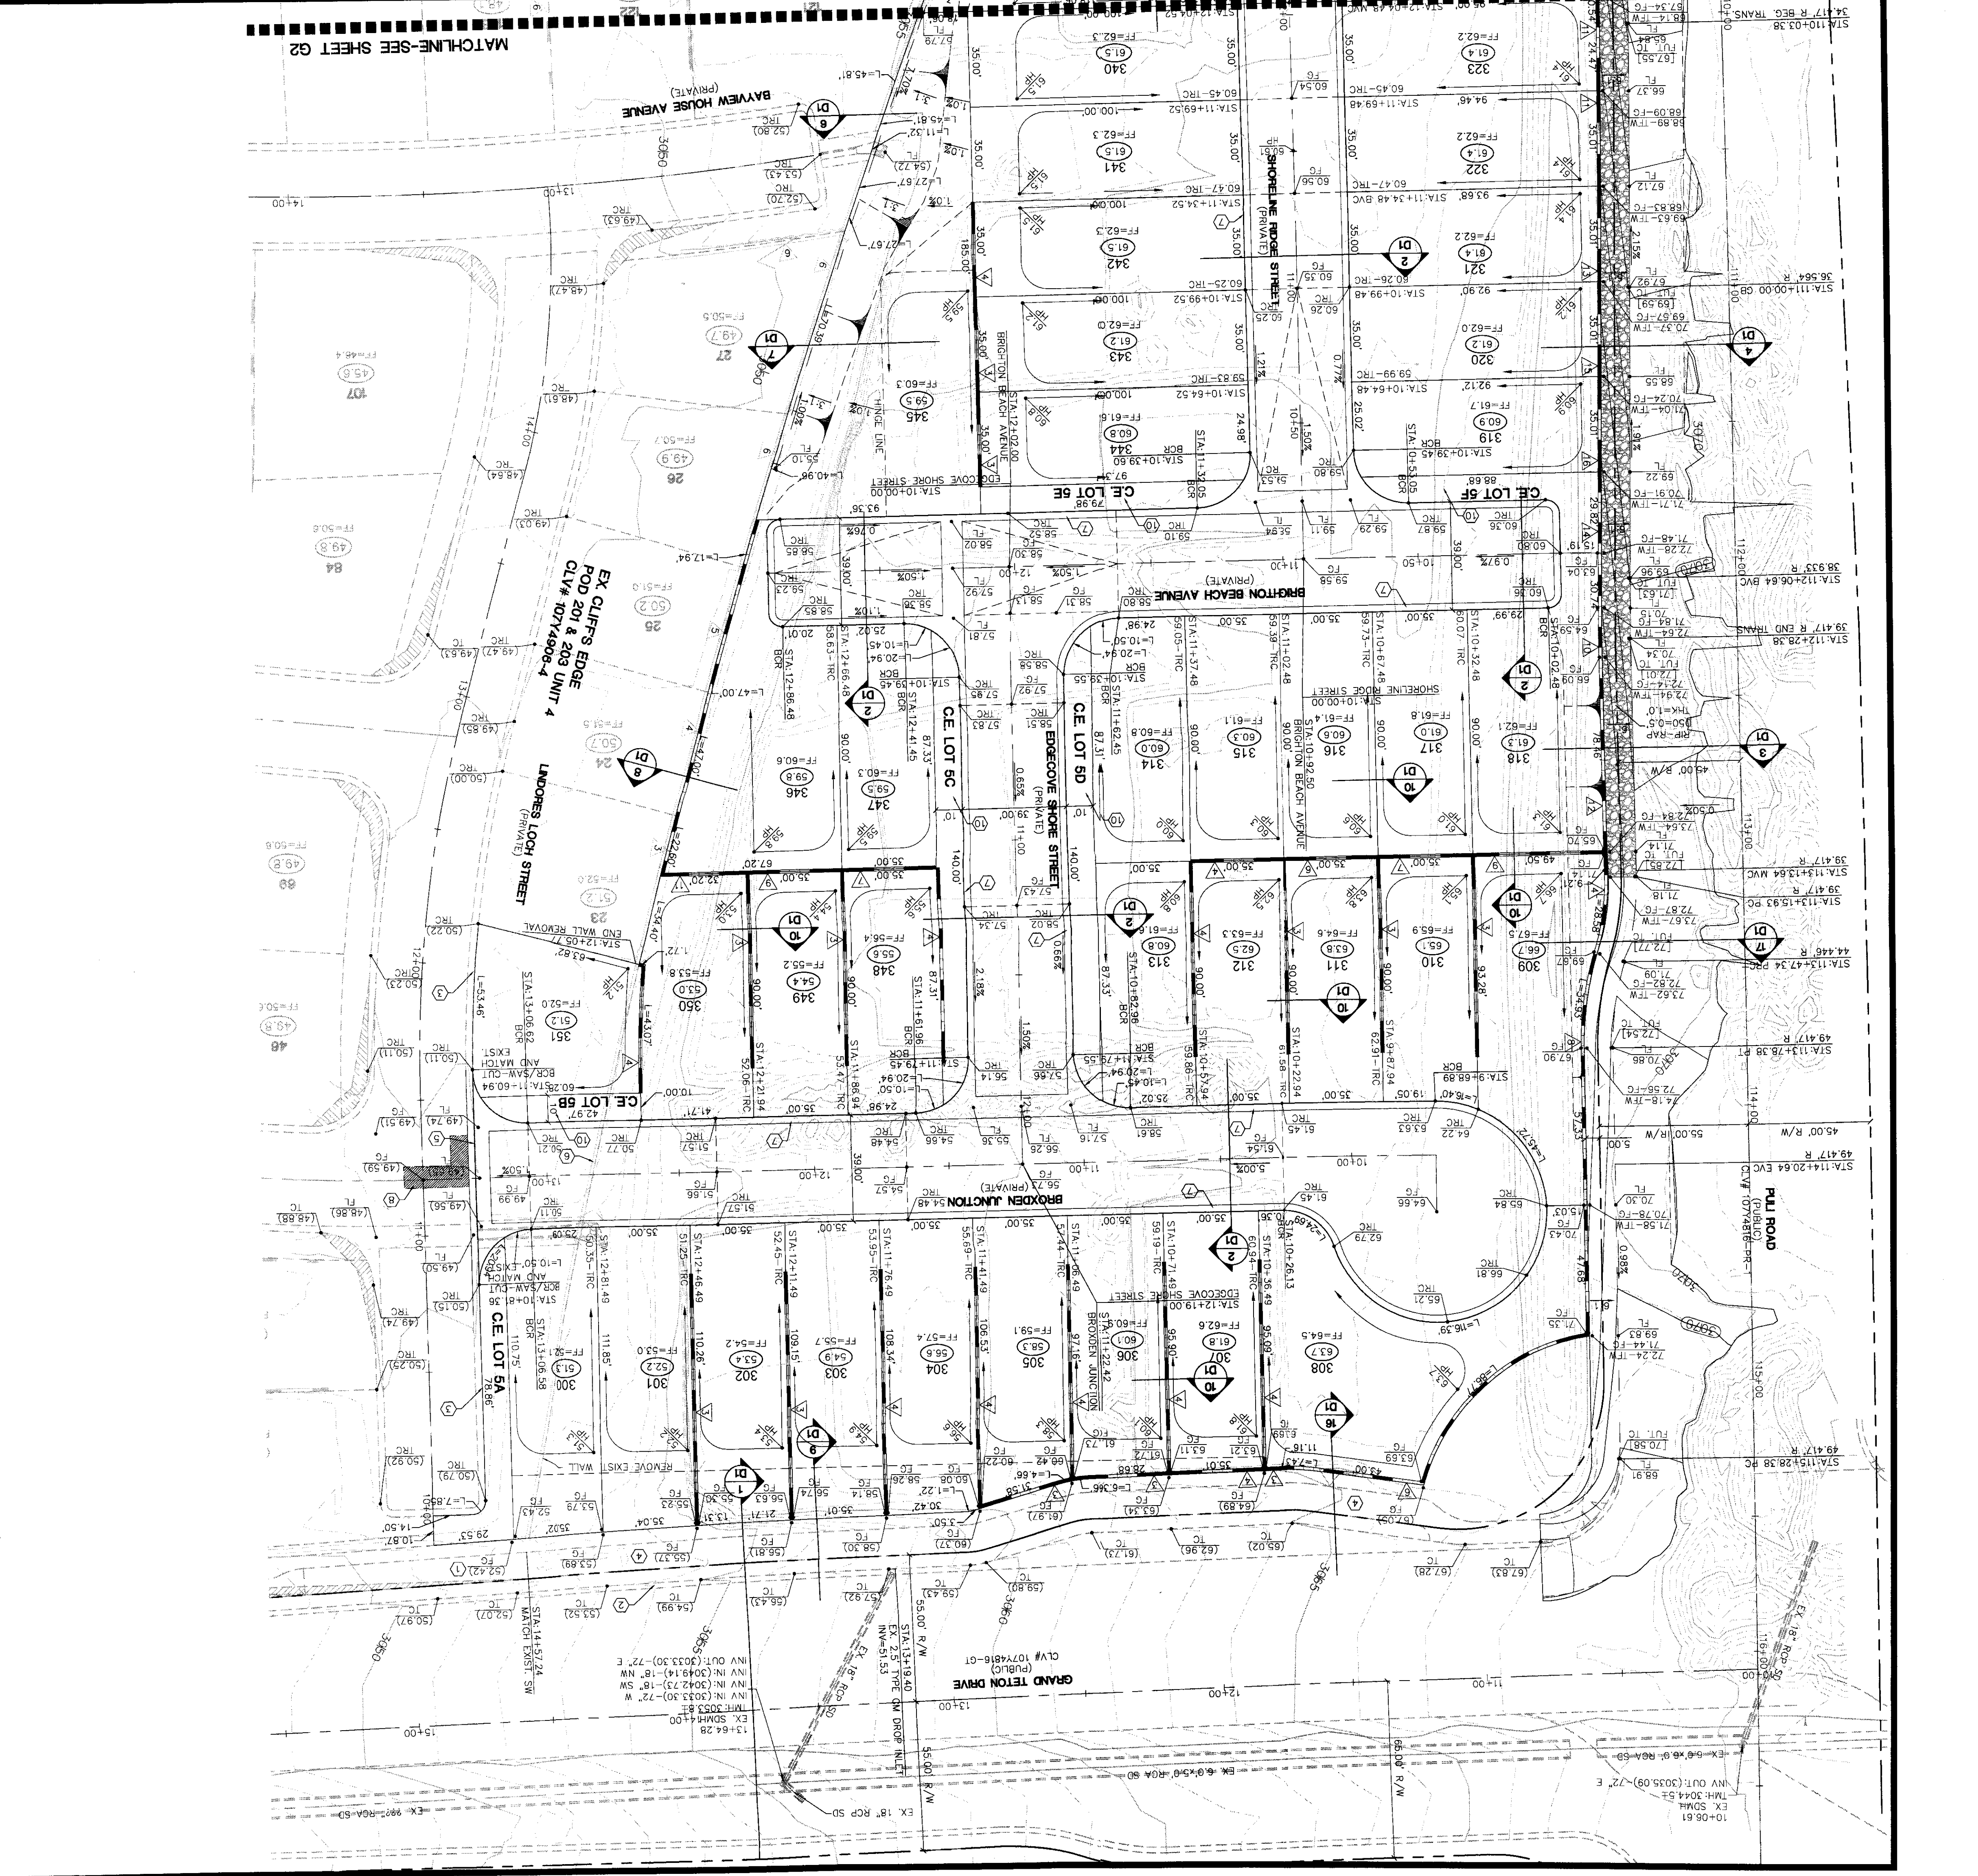
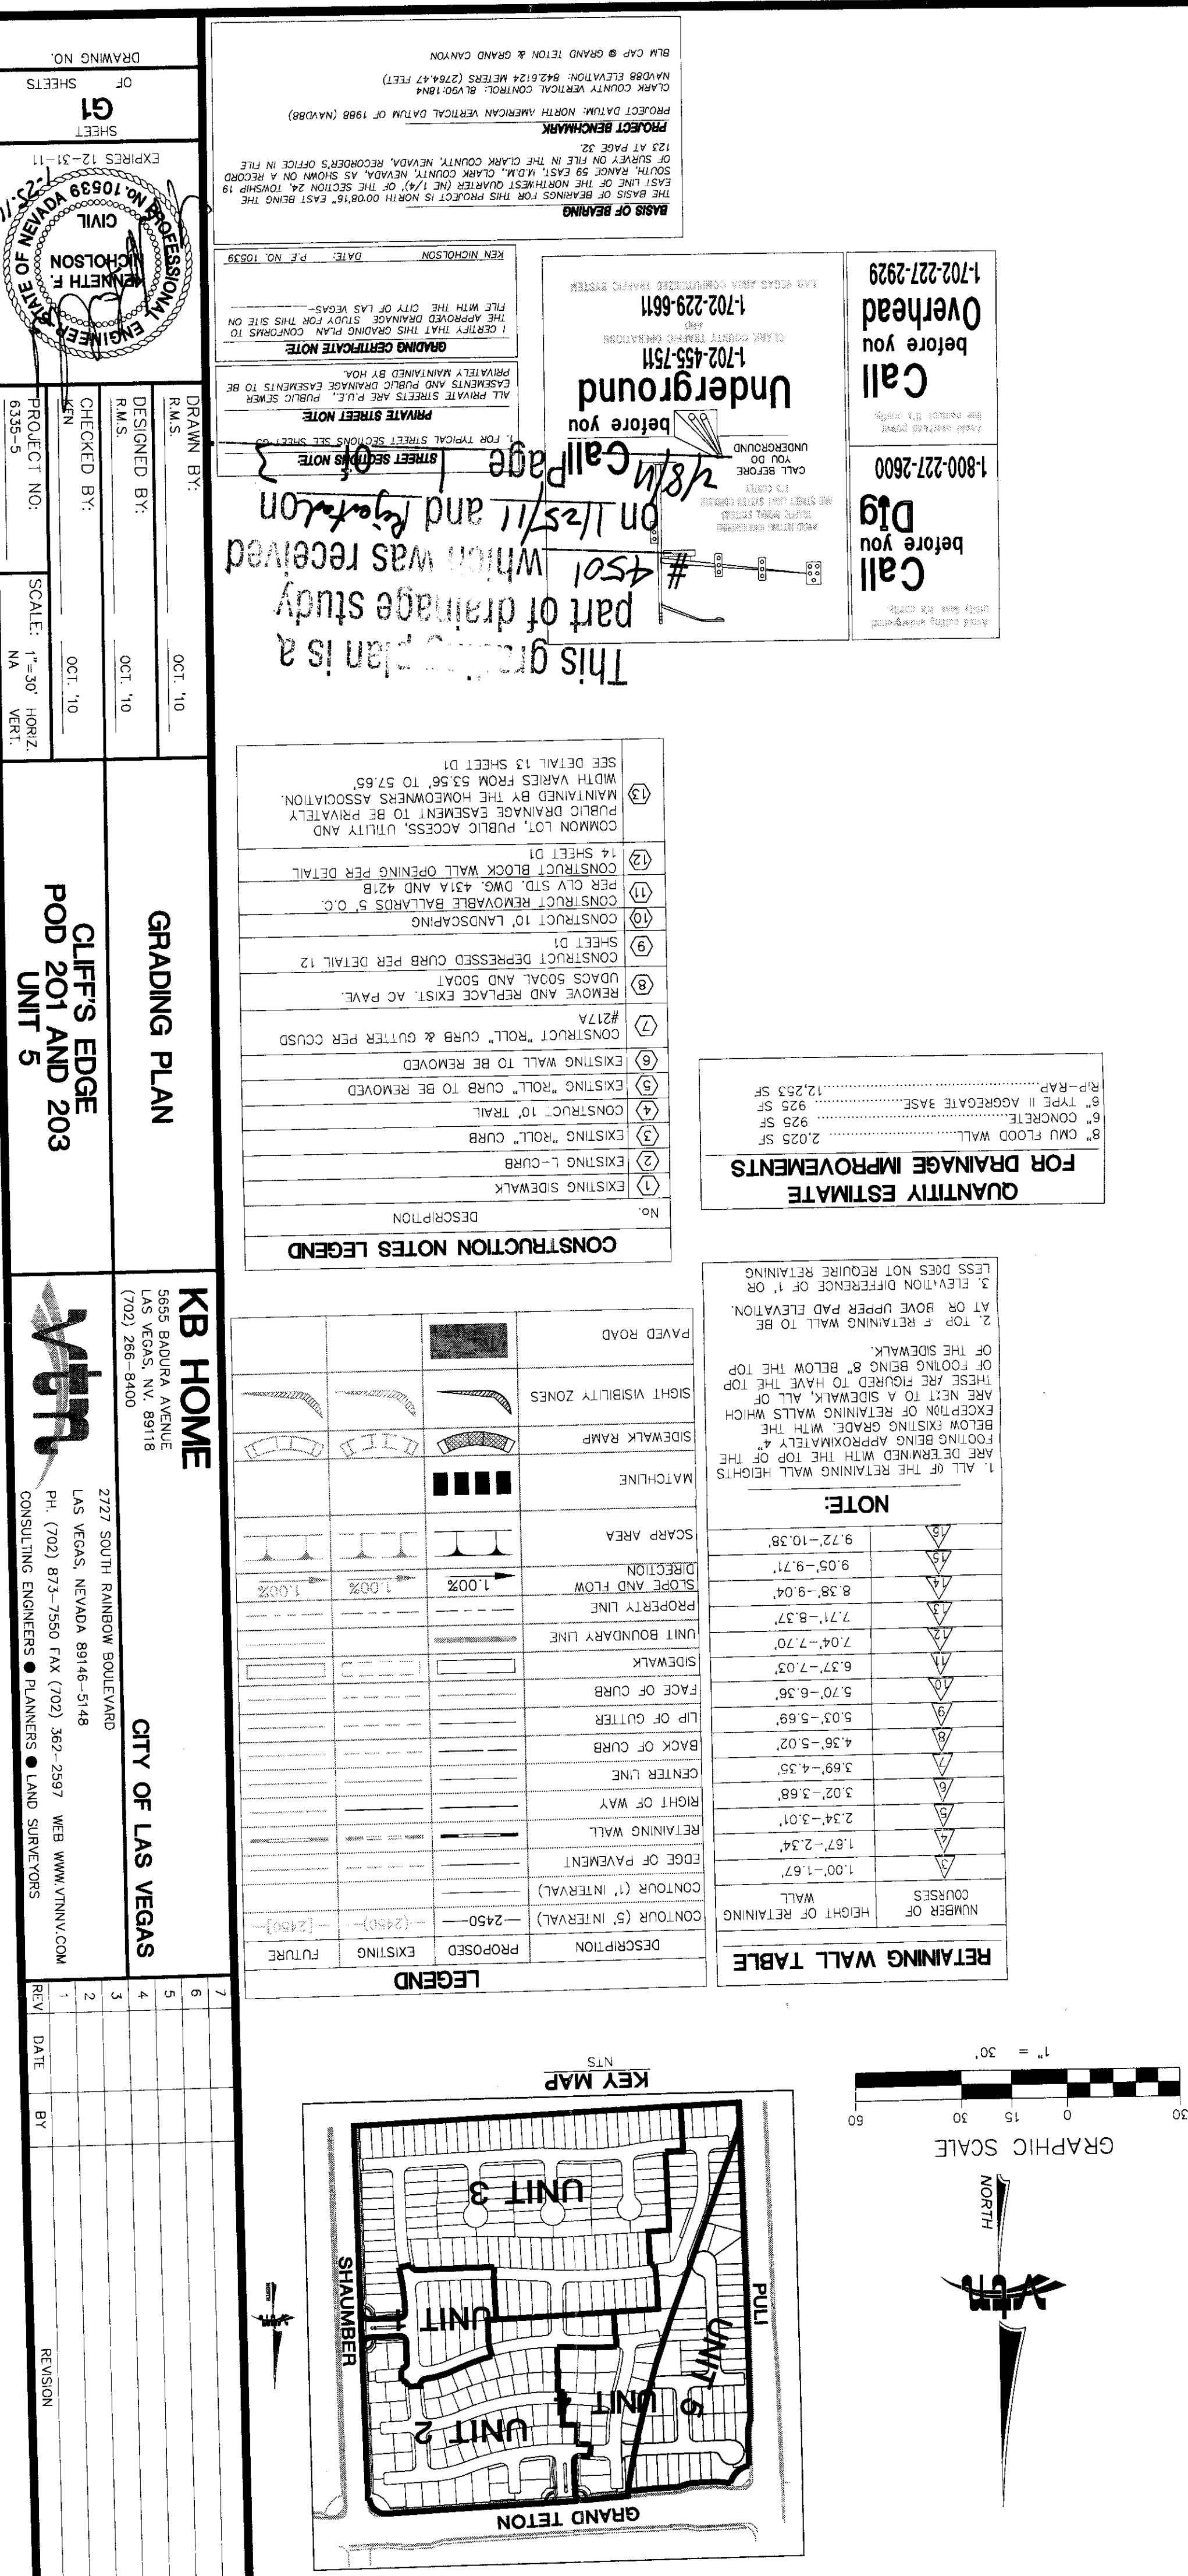
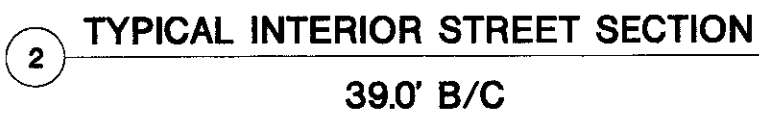


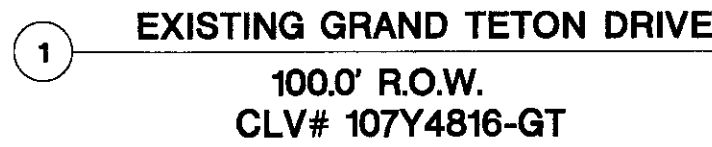

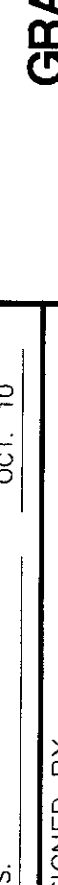

IT This grading plan is a
part of drainage study
4501 which was received
on 4/25/11 and Rejected on
4/28/11
LAND GRADING
COMMUNITY WALL Page 3 of 3

		SHEET D1 OF SHEETS		DRAWING NO.	
DESIGNED BY:	R.M.S.	OCT. '10			
CHECKED BY:	K.F. WOROLSON	OCT. '10			
PROJECT NO:	0635-5	SCALE: 1"=30'			
		HORIZ. NA			
		VERT. NA			
CLIFF'S EDGE POD 201 AND 203 UNIT 5			GRADING DETAILS		
KB HOME 5655 BADURA AVENUE LAS VEGAS, NV. 89118 (702) 268-8400			CITY OF LAS VEGAS 2727 SOUTH RAINBOW BOULEVARD LAS VEGAS, NEVADA 89146-5148 PH. (702) 873-7550 FAX (702) 362-2397 WEB WWW.VTNV.COM CONSULTING ENGINEERS • PLANNERS • LAND SURVEYORS		
REV	DATE	BY	REVISION		
1					
2					
3					
4					
5					
6					
7					