


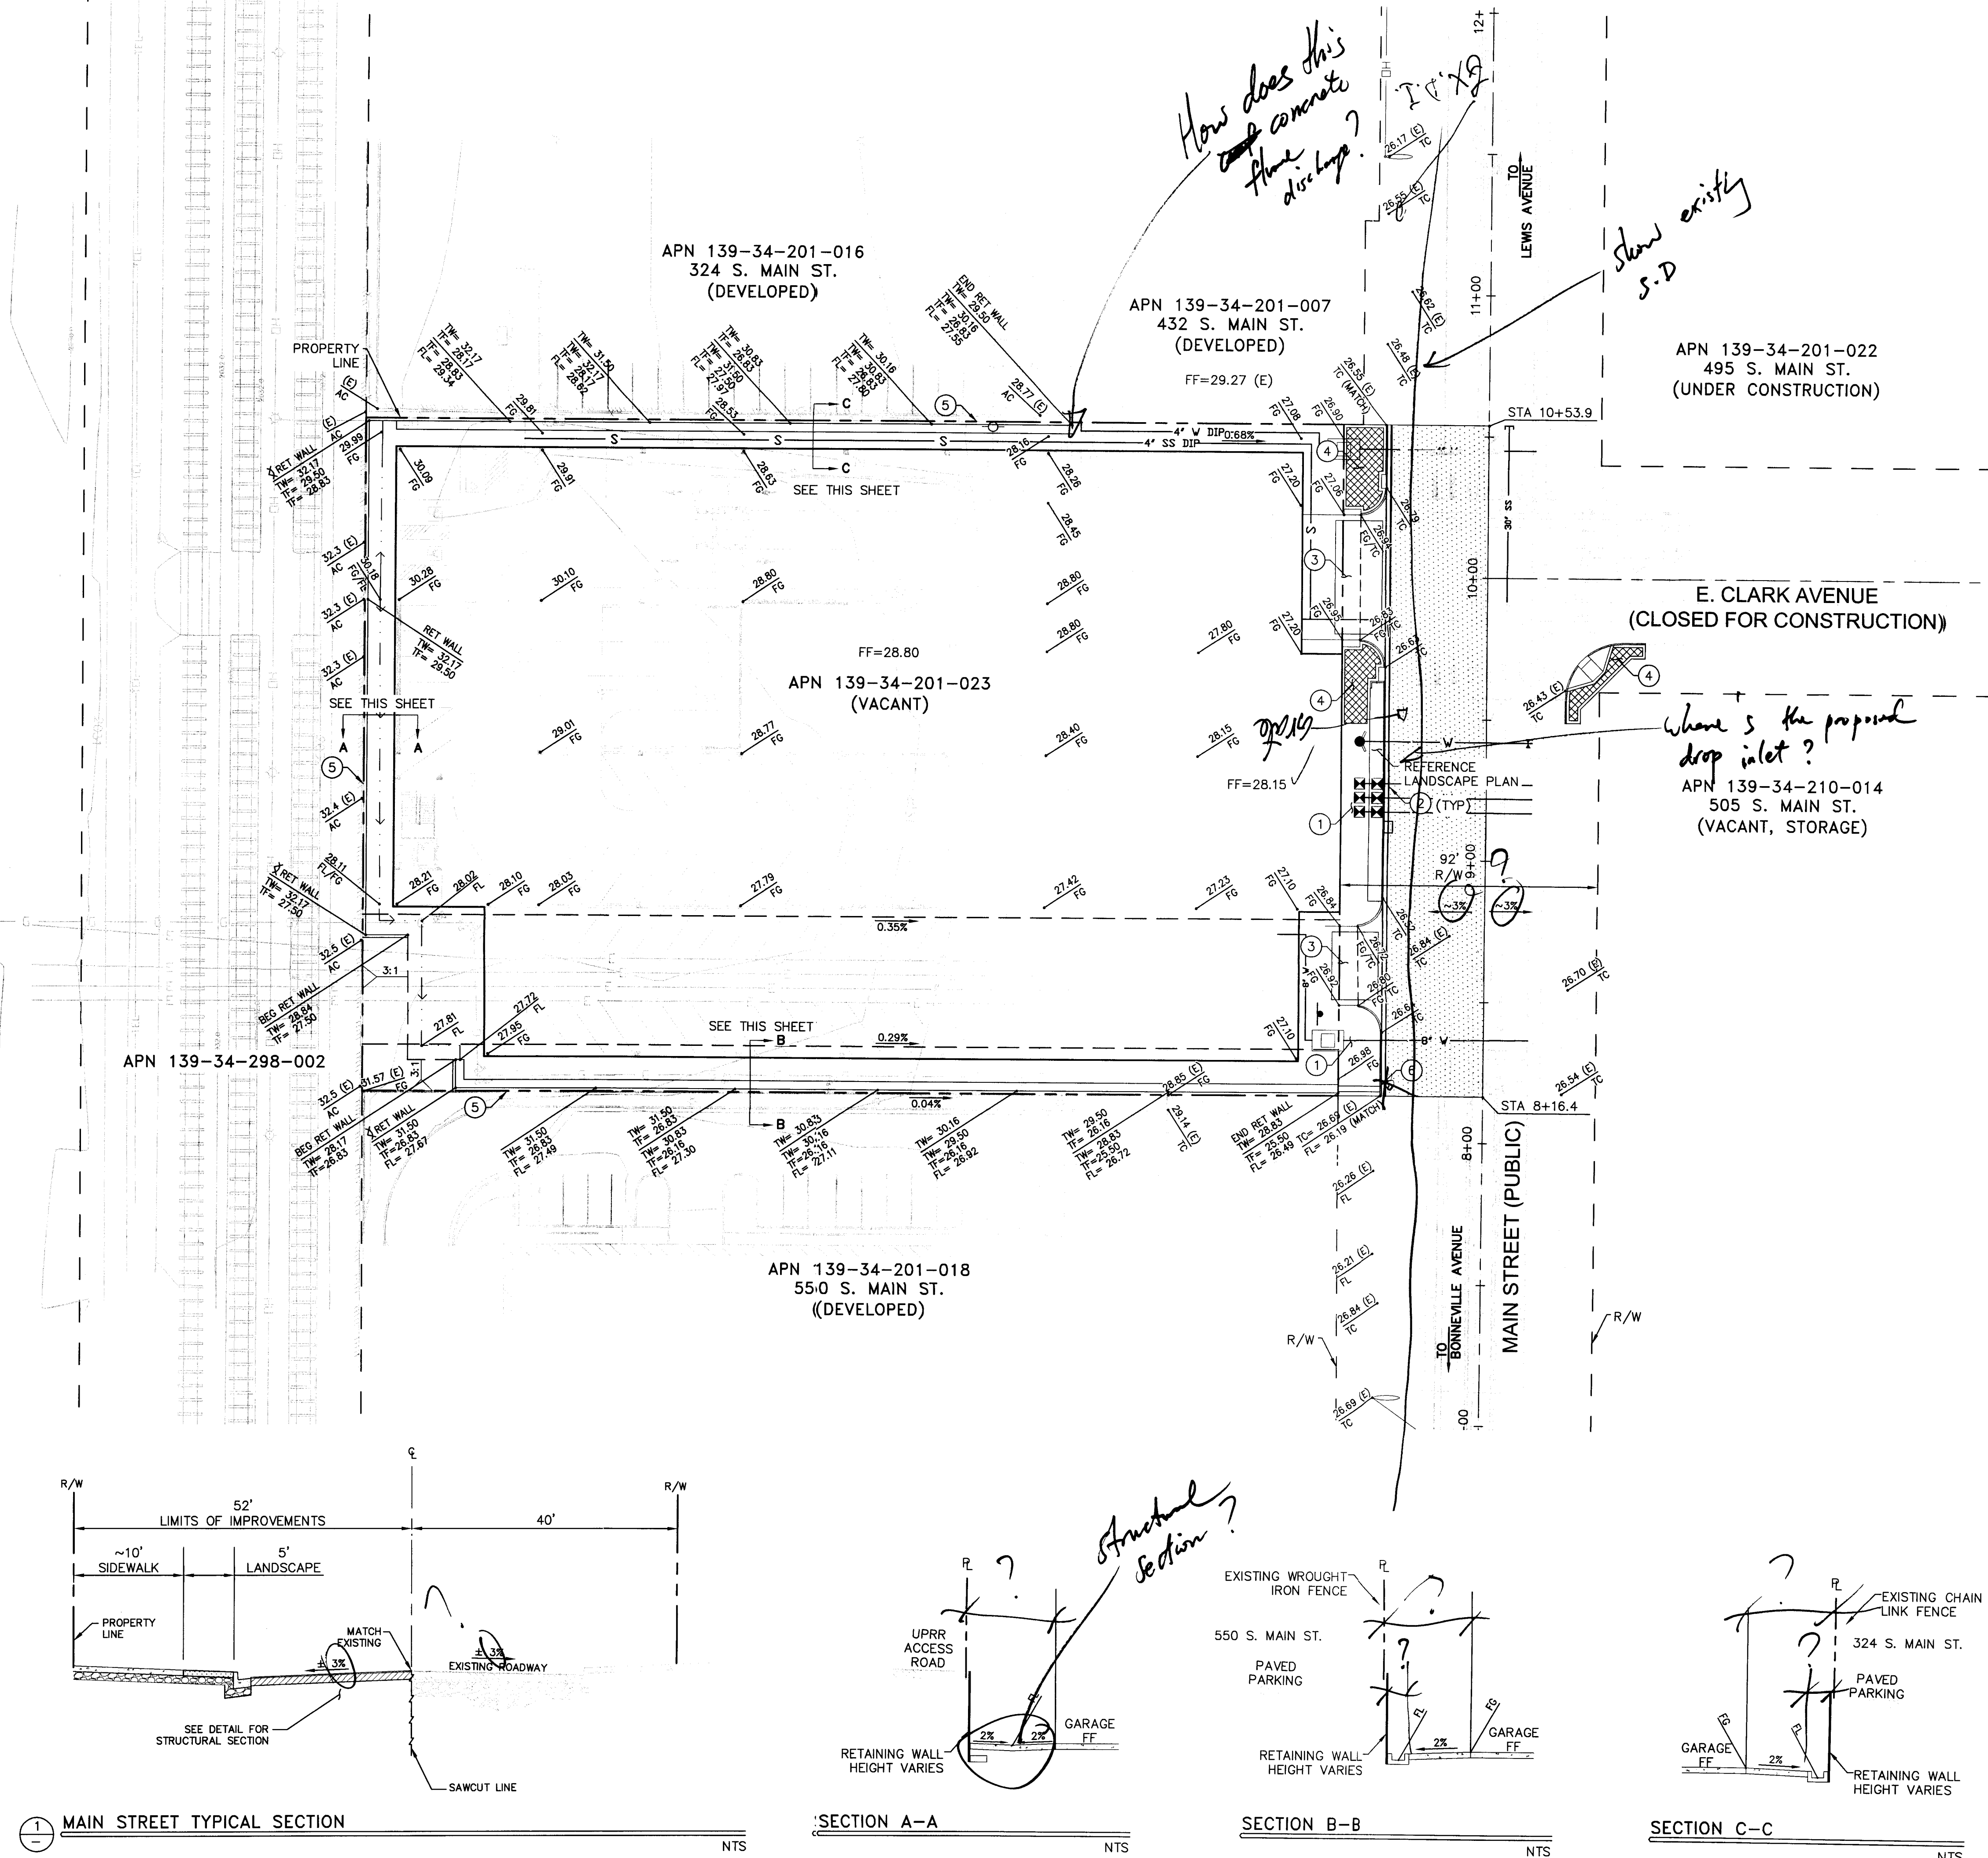

CONSTRUCTION NOTES

1. CONSTRUCT CONCRETE SIDEWALK PER CCAUSD DWG. NO. 234 AND LAS VEGAS DOWNTOWN CENTENNIAL STANDARDS. MATCH NEW SIDEWALK TO THE NEAREST EXISTING EXPANSION JOINT.
2. CONSTRUCT "L" TYPE CURB AND GUTTER PER CCAUSD DWG. NO. 216.
3. INSTALL DRIVEWAY PER LAS VEGAS DOWNTOWN CENTENNIAL STANDARDS.
4. INSTALL SIDEWALK RAMPS PER DOWNTOWN CENTENNIAL STANDARDS, WITH DETECTABLE WARNING STRIPS.
5. INSTALL MASONRY RETAINING WALL PER SOUTHERN NEVADA BUILDING OFFICIALS REGIONAL STANDARD DRAWING NO. B-100-2.
6. INSTALL SIDEWALK DRAIN PER CCAUSD DWG. NO. 236.

CONSTRUCT NEW PAVEMENT SECTION PER DETAIL ON SHEET C9.0.

BASIS OF BEARING

NORTH 27°55'28" EAST BEING THE BEARING OF THE NDOT CENTERLINE OF MAIN STREET BETWEEN BONNEVILLE AND LEWIS. SITUATE IN THE SOUTHWEST QUARTER (SW 1/4) OF SECTION 34, TOWNSHIP 20 SOUTH, RANGE 61 EAST, M.D.M., CITY OF LAS VEGAS, CLARK COUNTY, NEVADA AS SHOWN BY MAP THEREOF ON FILE IN THE CLARK COUNTY RECORDER'S OFFICE IN FILE 97, PAGE 72 OF PARCEL MAPS.

BENCHMARK

CITY OF LAS VEGAS BENCHMARK No. BLV01 34W4

A RIVET AND PLATE IN THE BASE OF A STREET LIGHT AT THE NORTHEAST CORNER OF MAIN AND BONNEVILLE.

ELEVATION = 617.801 METERS (NAVD'88)
ELEVATION = 2026.90 US SURVEY FEET (NAVD'88)



REVISIONS

NO.	DESCRIPTION

CONSULTANT

Owner:
CITY OF LAS VEGAS
DEPARTMENT OF PUBLIC WORKS
CAPITAL PROJECT MANAGEMENT
400 EAST STEWART AVENUE
LAS VEGAS, NEVADA 89101

City:
THE WHITING TURNER CONTRACTING COMPANY
6720 VIA ALBERTA PARKWAY, SUITE 300
LAS VEGAS, NEVADA 89119
PHONE: 702.650.0700 FAX: 702.650.2650
Consultant/ Discipline:


PROJECT MANAGEMENT /
STRUCTURAL ENGINEER /
LANDSCAPE ARCHITECT /
WALTER P. MOORE
7251 AMICO STREET, SUITE 210
LAS VEGAS, NEVADA 89119
PHONE: 702.844.4715 FAX: 702.844.4790

ARCHITECT
CARPENTERS GILLERS DEL GATTO ARCHITECTS
1919 S. JONES, SUITE C
LAS VEGAS, NEVADA 89146
PHONE: 702.251.8896 FAX: 702.251.8876

CIVIL ENGINEERS
KINLEY HORN AND ASSOCIATES
2060 EAST FLAMINGO ROAD, SUITE 210
LAS VEGAS, NEVADA 89119
PHONE: 702.734.5666 FAX: 702.735.4849

MEP CONSULTANTS
MSA ENGINEERING CONSULTANTS
3716 WINDMILL LANE SUITE 100
LAS VEGAS, NEVADA 89122
PHONE: 702.896.1199 FAX: 702.896.1133

500 SOUTH MAIN STREET PARKING GARAGE GRADING PLAN

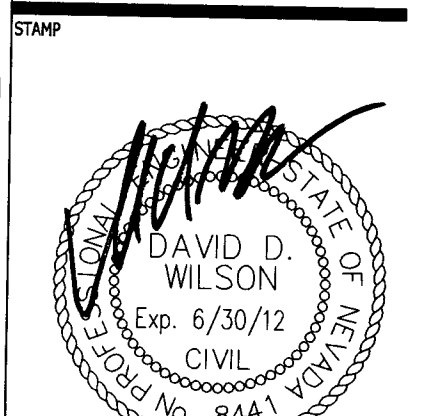


3 Feb 11
For Drainage Study
OWNER: CITY OF LAS VEGAS
DEPARTMENT OF PUBLIC WORKS

400 EAST STEWART AVENUE
LAS VEGAS, NEVADA 89101
PHONE: (702) 229-5535
FAX: (702) 394-4846
TDD: (702) 394-9108

DRAWN	MAG
FILE	092708GD.DWG
DATE	2/3/2011
SCALE	AS SHOWN
BID NO.	09.15341.19
CLV DWG NO.	09.15341.19-TF
SHEET NO.	

C3.0


This grading plan is a
part of drainage study
4510 which was received
on 2/3/11 and Rejected on
2/17/11. Page 1 of 2

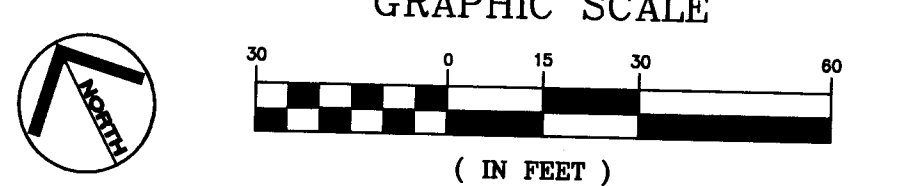

811
know what's below
Call before you dig
1-702-227-2329

SAFETY ALERT
Call
Before You
Overhead
1-702-432-5300

Call
before you
Underground
1-702-432-5300

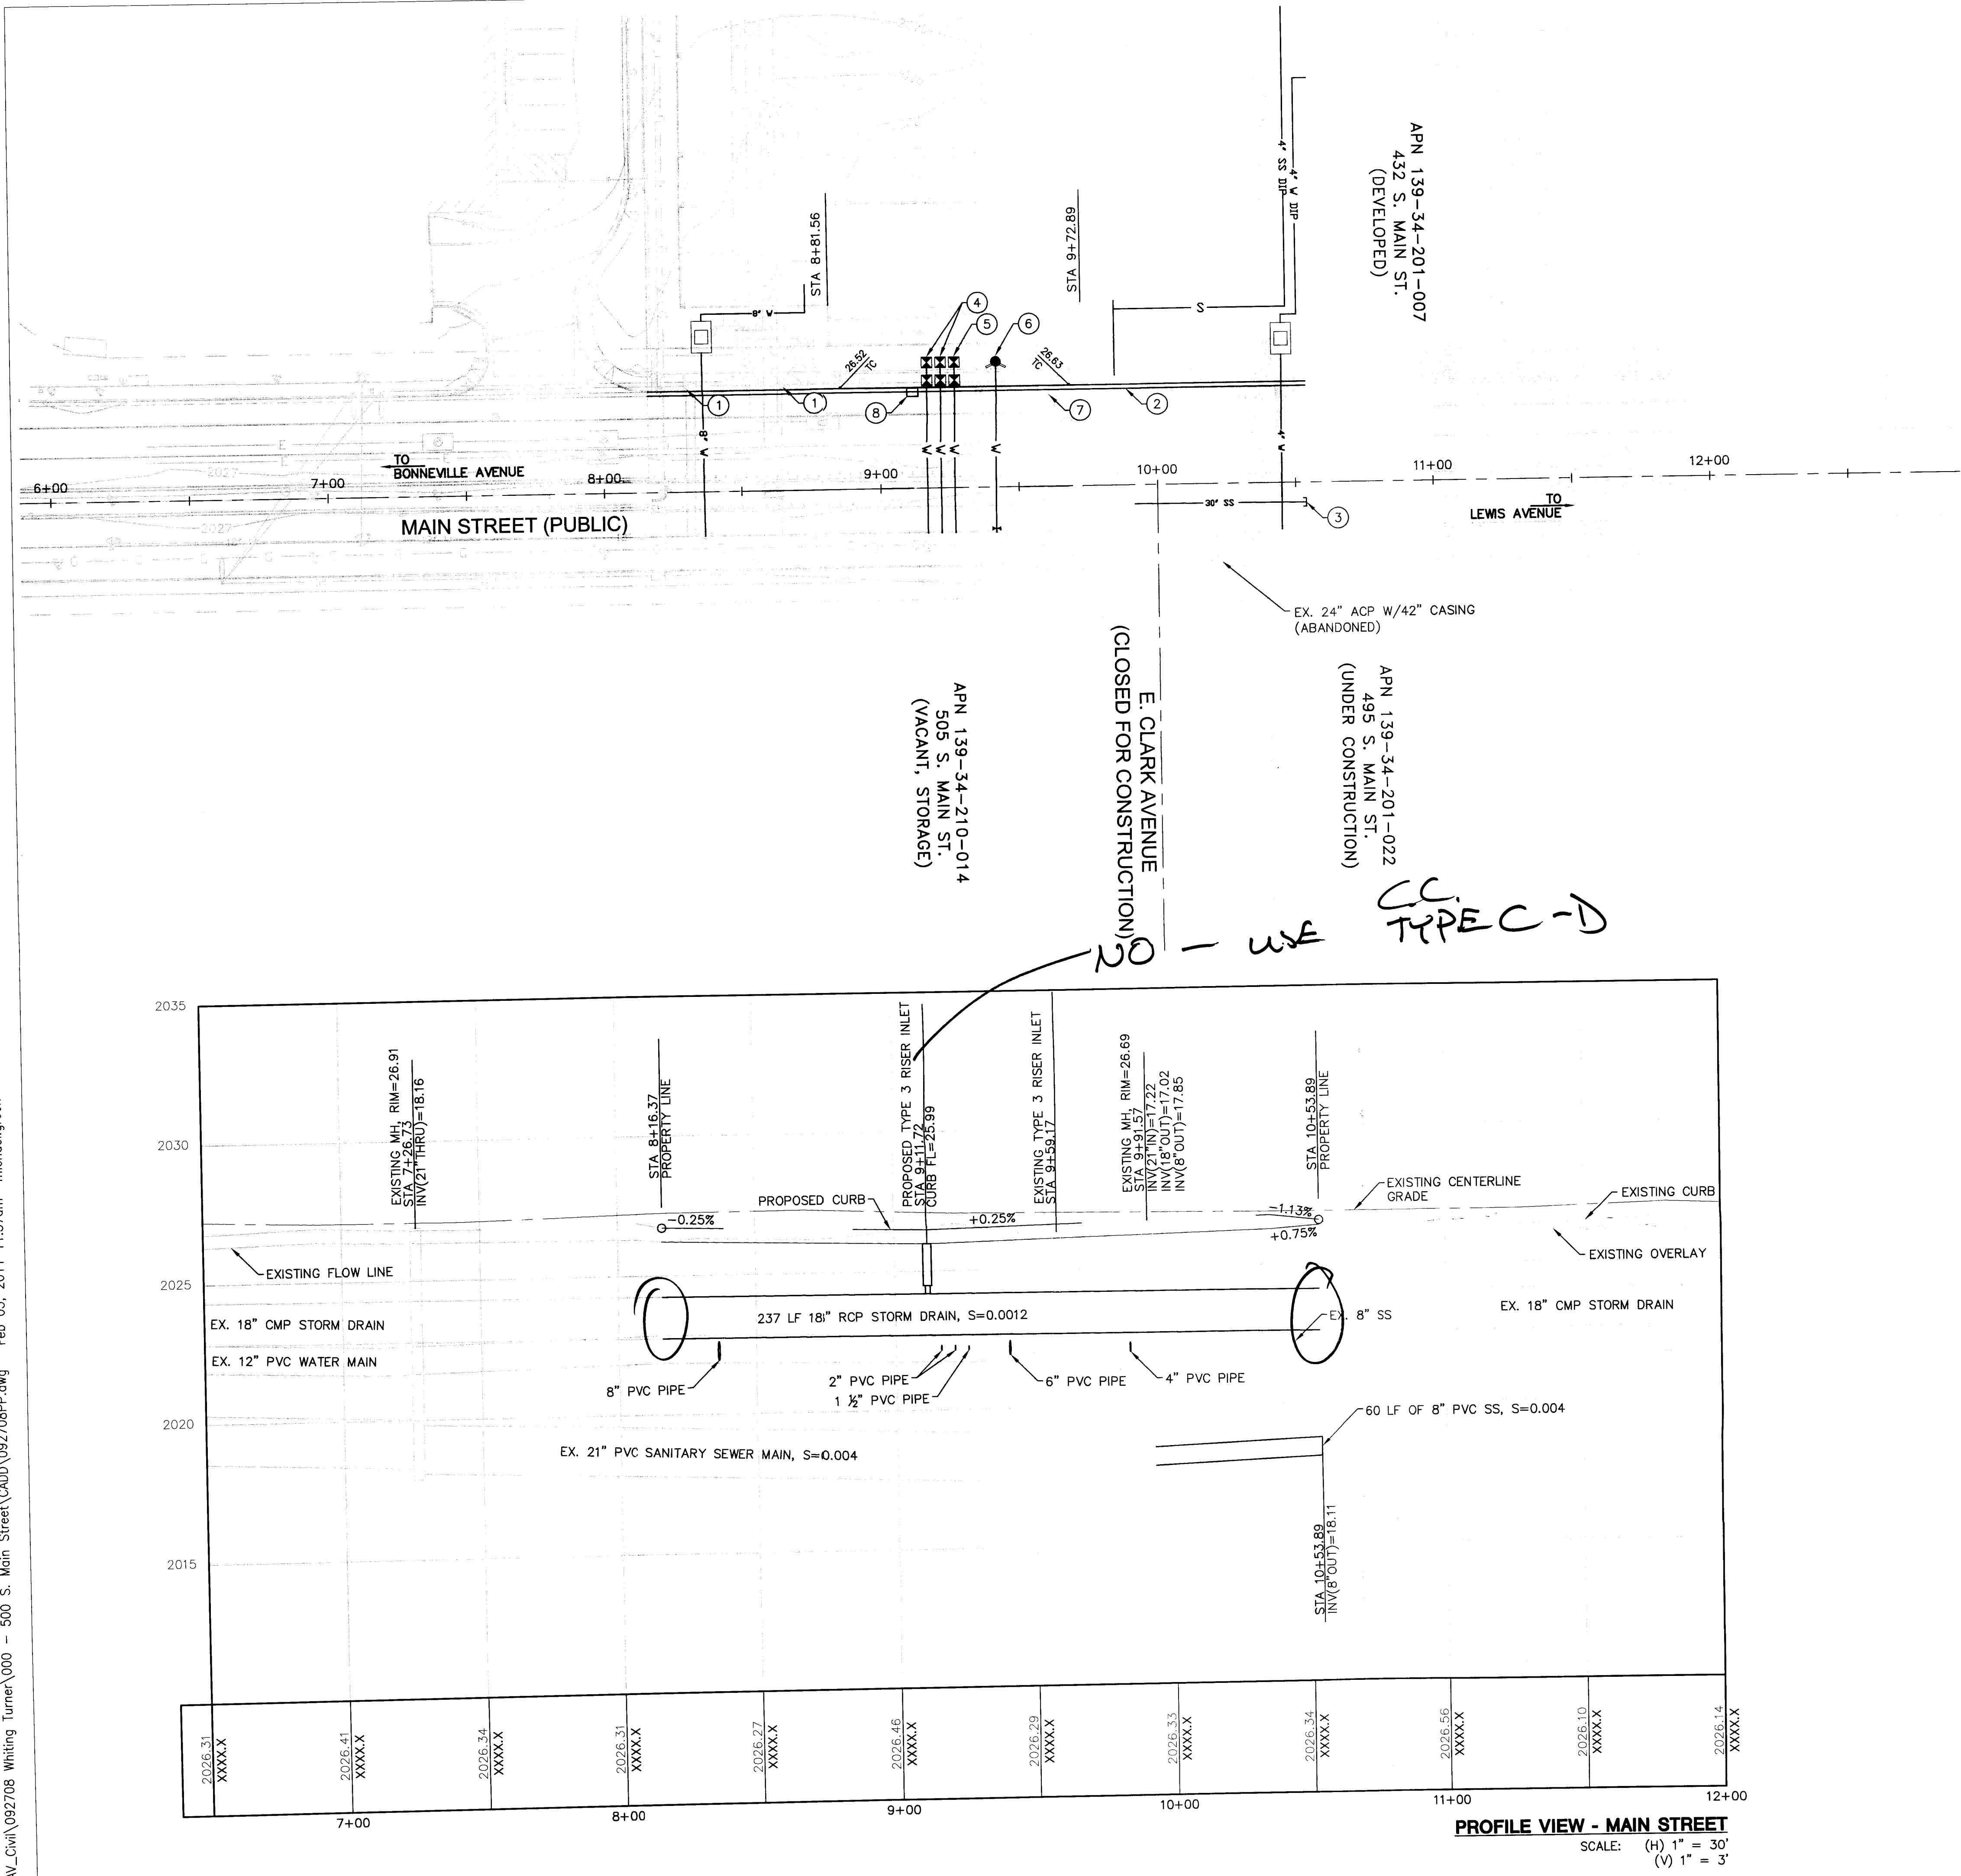

UTILITY NOTES

1. REMOVE EXISTING WATER METERS.
2. REMOVE EXISTING 18" CMP STORM DRAIN AND REPLACE WITH 18" CLASS III RCP.
3. INSTALL 8" PVC SEWER MAIN STUB-OUT W/ SEALED CAP AND THRUST BLOCK PER DCSWCS SECTION 2.2.5.
4. INSTALL 2" WATER METER W/ 2" BACKFLOW PREVENTION ASSEMBLY. REFERENCE UDACS PLATES 3 & 8.
5. INSTALL 1 1/2" WATER METER W 1 1/2" BACKFLOW PREVENTION ASSEMBLY. REFERENCE UDACS PLATES 3 & 8.
6. INSTALL FIRE HYDRANT W/GATE VALVE. REFERENCE UDACS PLATES 39 & 40.
7. REMOVE EXISTING TYPE 3 PIPE RISER INLET.
8. INSTALL TYPE 3 PIPE RISER INLET PER NDOT STANDARD PLAN NO. R-4.1.1.

NOTES:

1. CONTRACTOR TO POTHOLE AND VERIFY UTILITY ELEVATIONS AT CONNECTION POINTS, VERIFY CONSTRUCTABILITY AND CONSULT ENGINEER.



REVISIONS

CONSULTANT

Owner: CITY OF LAS VEGAS
DEPARTMENT OF PUBLIC WORKS
CAPITAL PROJECT MANAGEMENT
400 EAST STEWART AVENUE
LAS VEGAS, NEVADA 89101

Consultants/Divisions:


PROJECT MANAGEMENT /
PARKING CONSULTANT:
STRUCTURAL ENGINEER /
WALTER P. MOORE
7251 AMICO STREET, SUITE 210
LAS VEGAS, NEVADA 89119
PHONE 702.844.4710 FAX 702.844.4790

ARCHITECT:
CARPENTER SELLERS DEL GATTO ARCHITECTS
1919 S. JONES, SUITE C
LAS VEGAS, NEVADA 89146
PHONE 702.251.8896 FAX 702.251.8876

CIVIL ENGINEERS:
KIMLEY-HORN AND ASSOCIATES
2000 EAST FLAMINGO ROAD, SUITE 210
LAS VEGAS, NEVADA 89119
PHONE 702.734.5066 FAX 702.735.4949

MEP CONSULTANTS:
MSA ENGINEERING CONSULTANTS
370 E. WINDMILL LANE, SUITE 100
LAS VEGAS, NEVADA 89123
PHONE 702.896.1199 FAX 702.896.1133

DEPARTMENT OF PUBLIC WORKS
500 SOUTH MAIN STREET
PARKING GARAGE
MAIN STREET PLAN

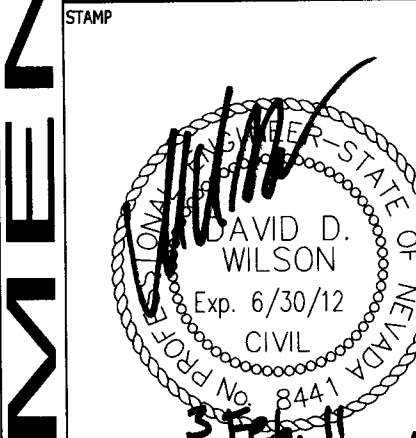

OWNER: CITY OF LAS VEGAS
DEPARTMENT OF PUBLIC WORKS

400 EAST STEWART AVENUE
LAS VEGAS, NEVADA 89101
PHONE: (702) 229-6535
FAX: (702) 384-4846
TDD: (702) 386-9108

DRAWN: MAG
FILE: 092708PP.DWG
DATE: 2/3/2011
SCALE: AS SHOWN
BID NO: 09.15341.19
CLV DWG NO: 09.15341.19-TF

SHEET NO: C5.0

This grading is part of drainage study #4518 which was received on 2/3/11 and rejected on 2/17/11. Page 2 of 2

GRAPHIC SCALE
0 10 20 30 40
(IN FEET)



811 SAFETY ALERT
Call Before You Dig
Before You Overhead
1-800-432-5300
1-702-227-2929

