

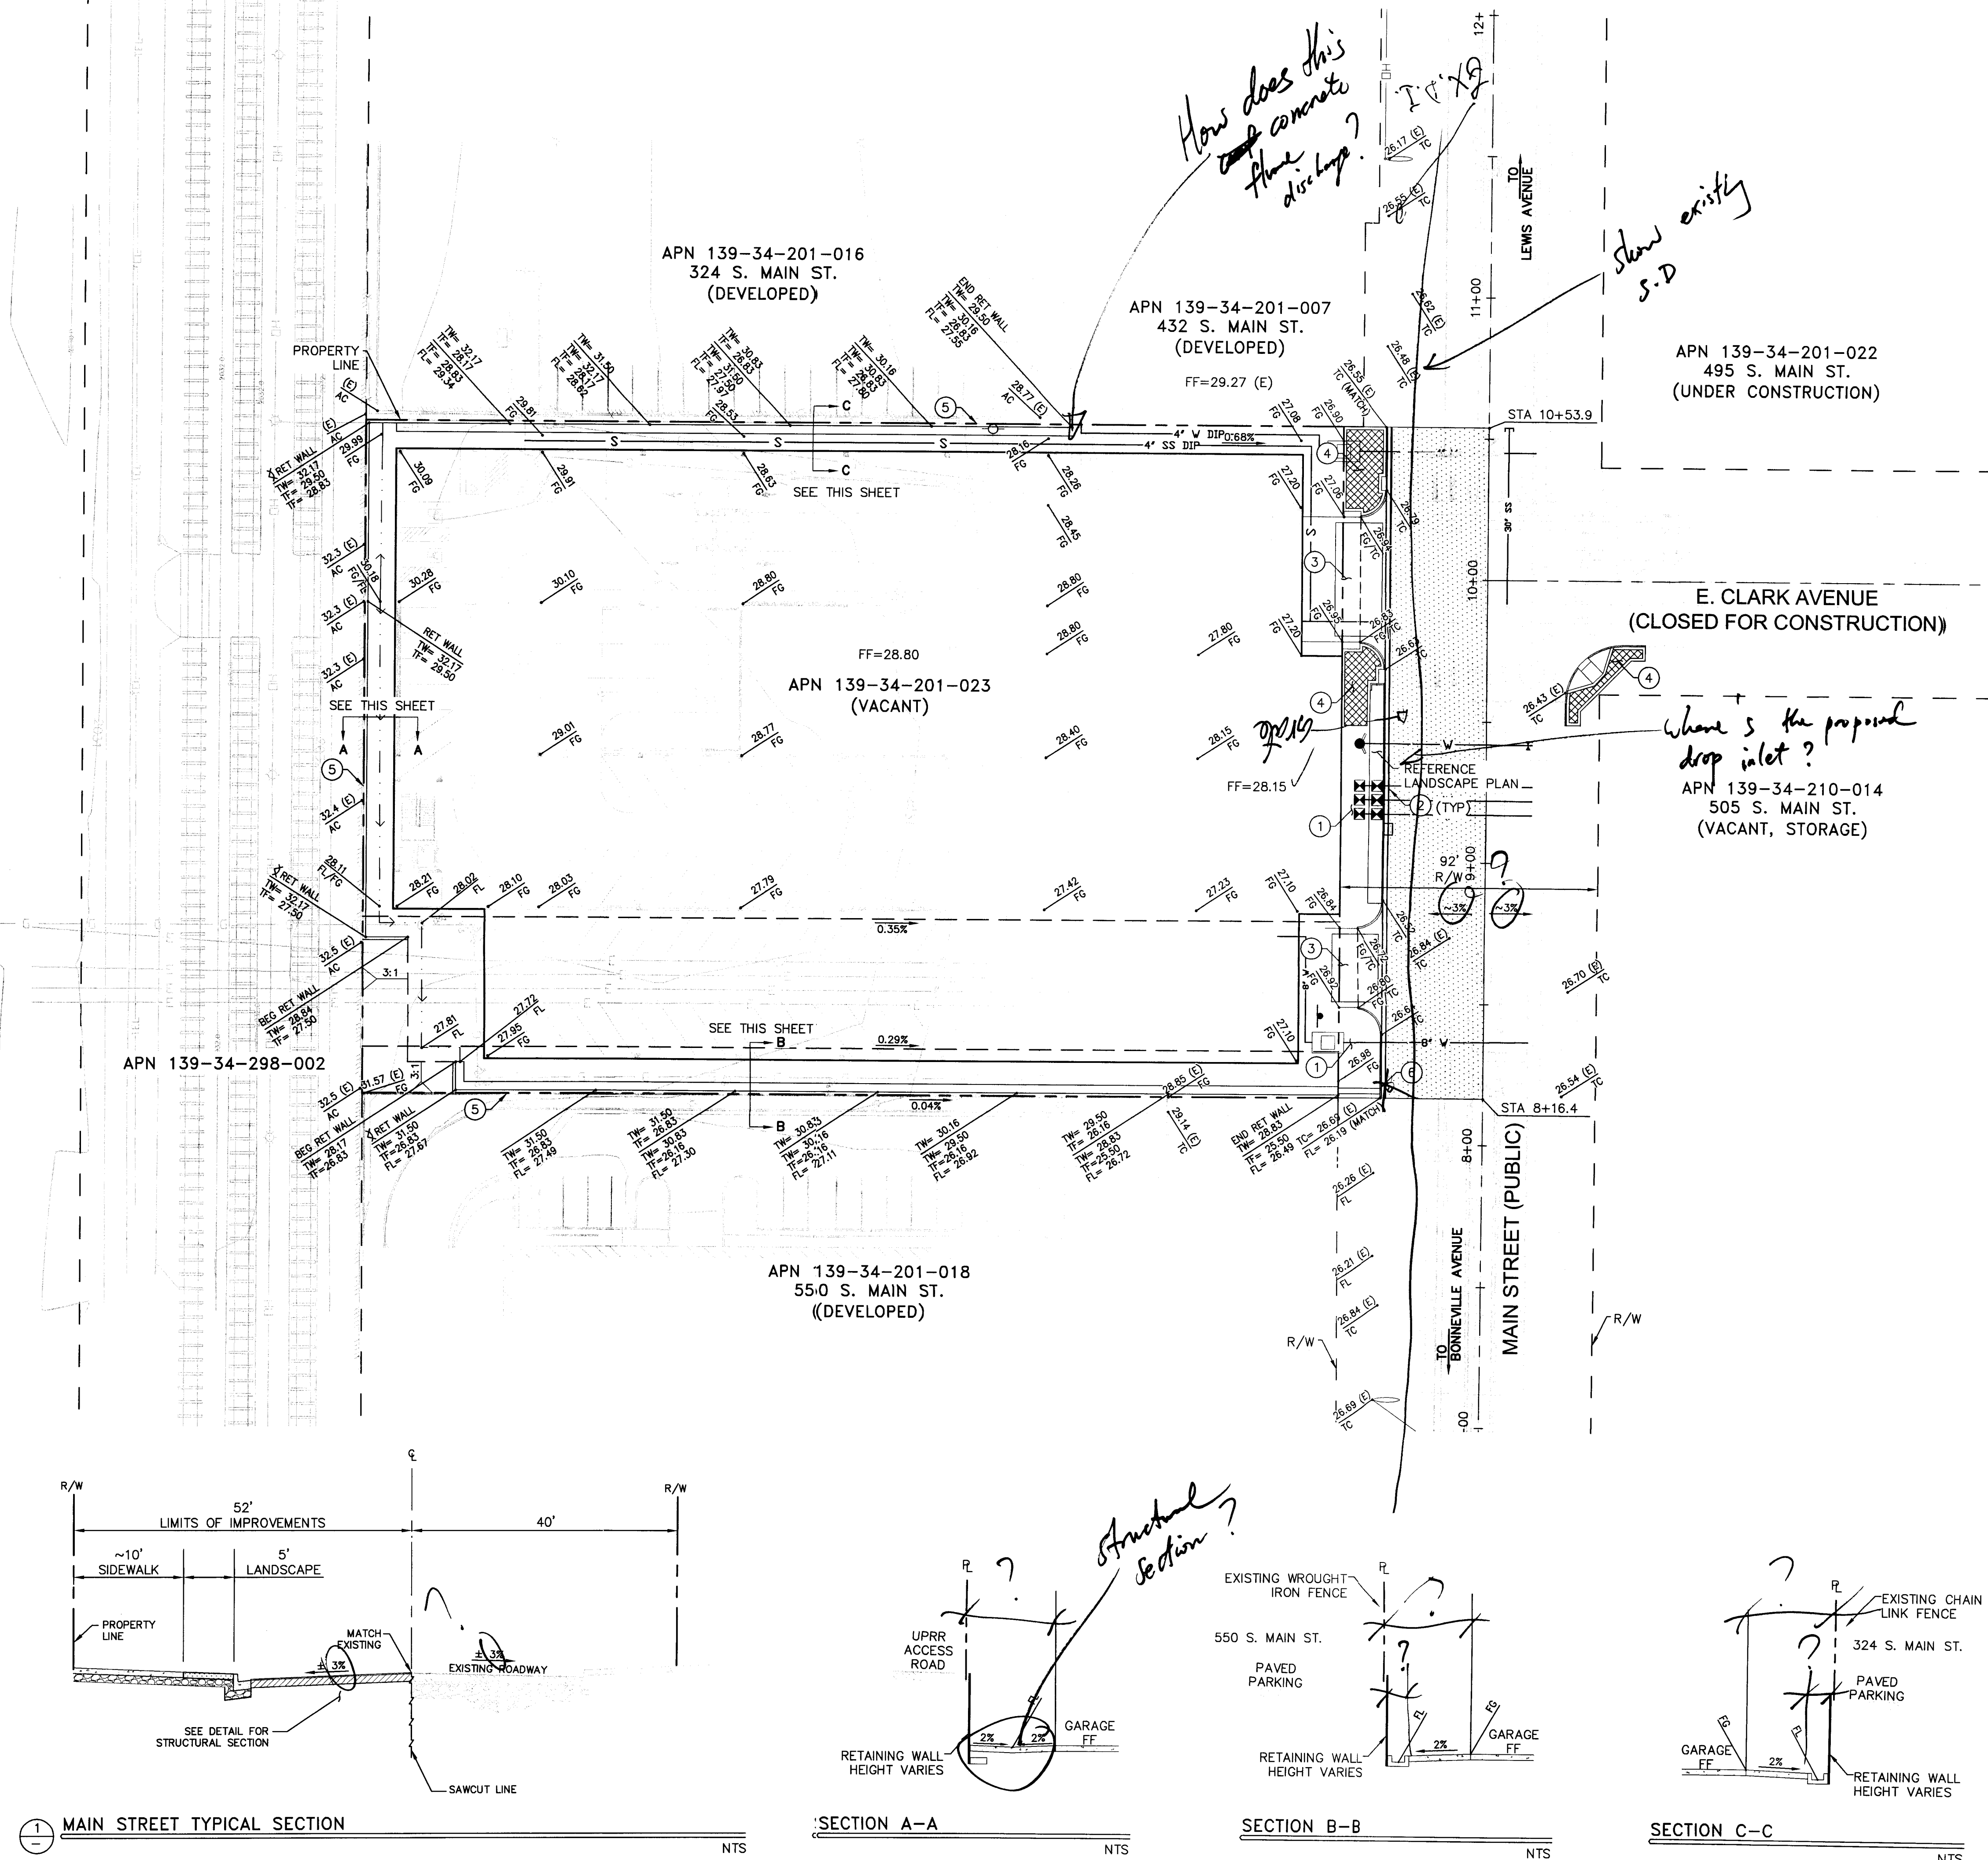


K:\LAV_Civil\092708\Whiting Turner\000 - 500 S. Main Street\Drainage\CADD\092708GD_Drainage.dwg Feb 03, 2011 11:46am michael.green

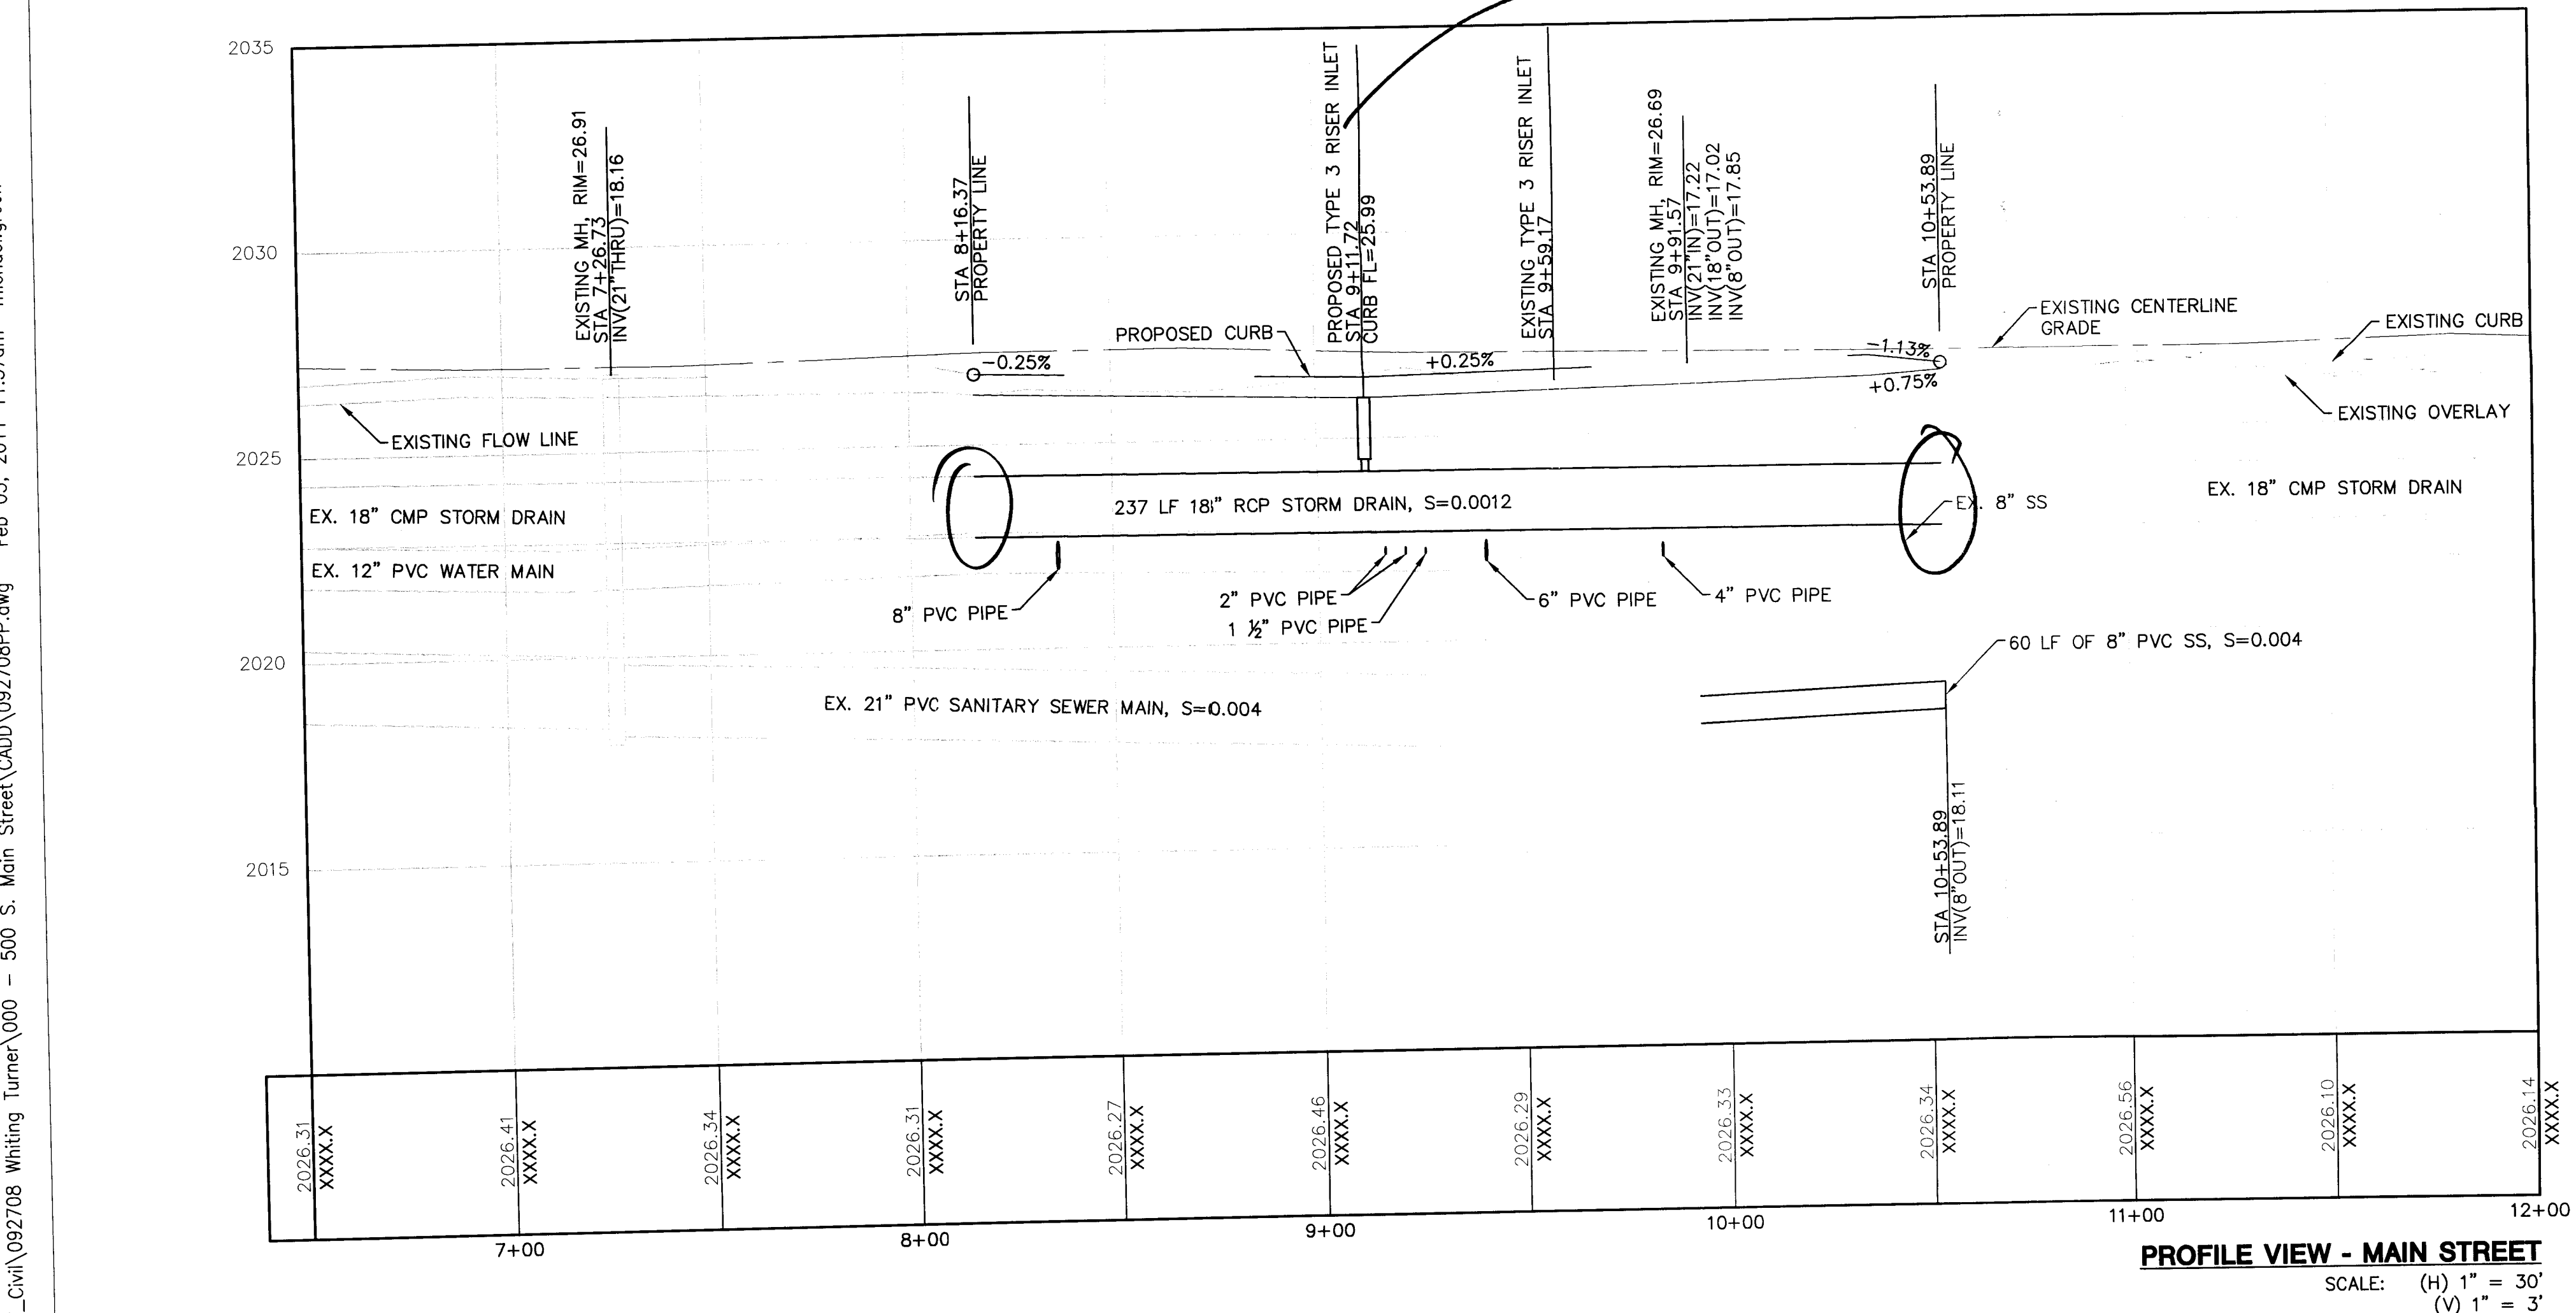

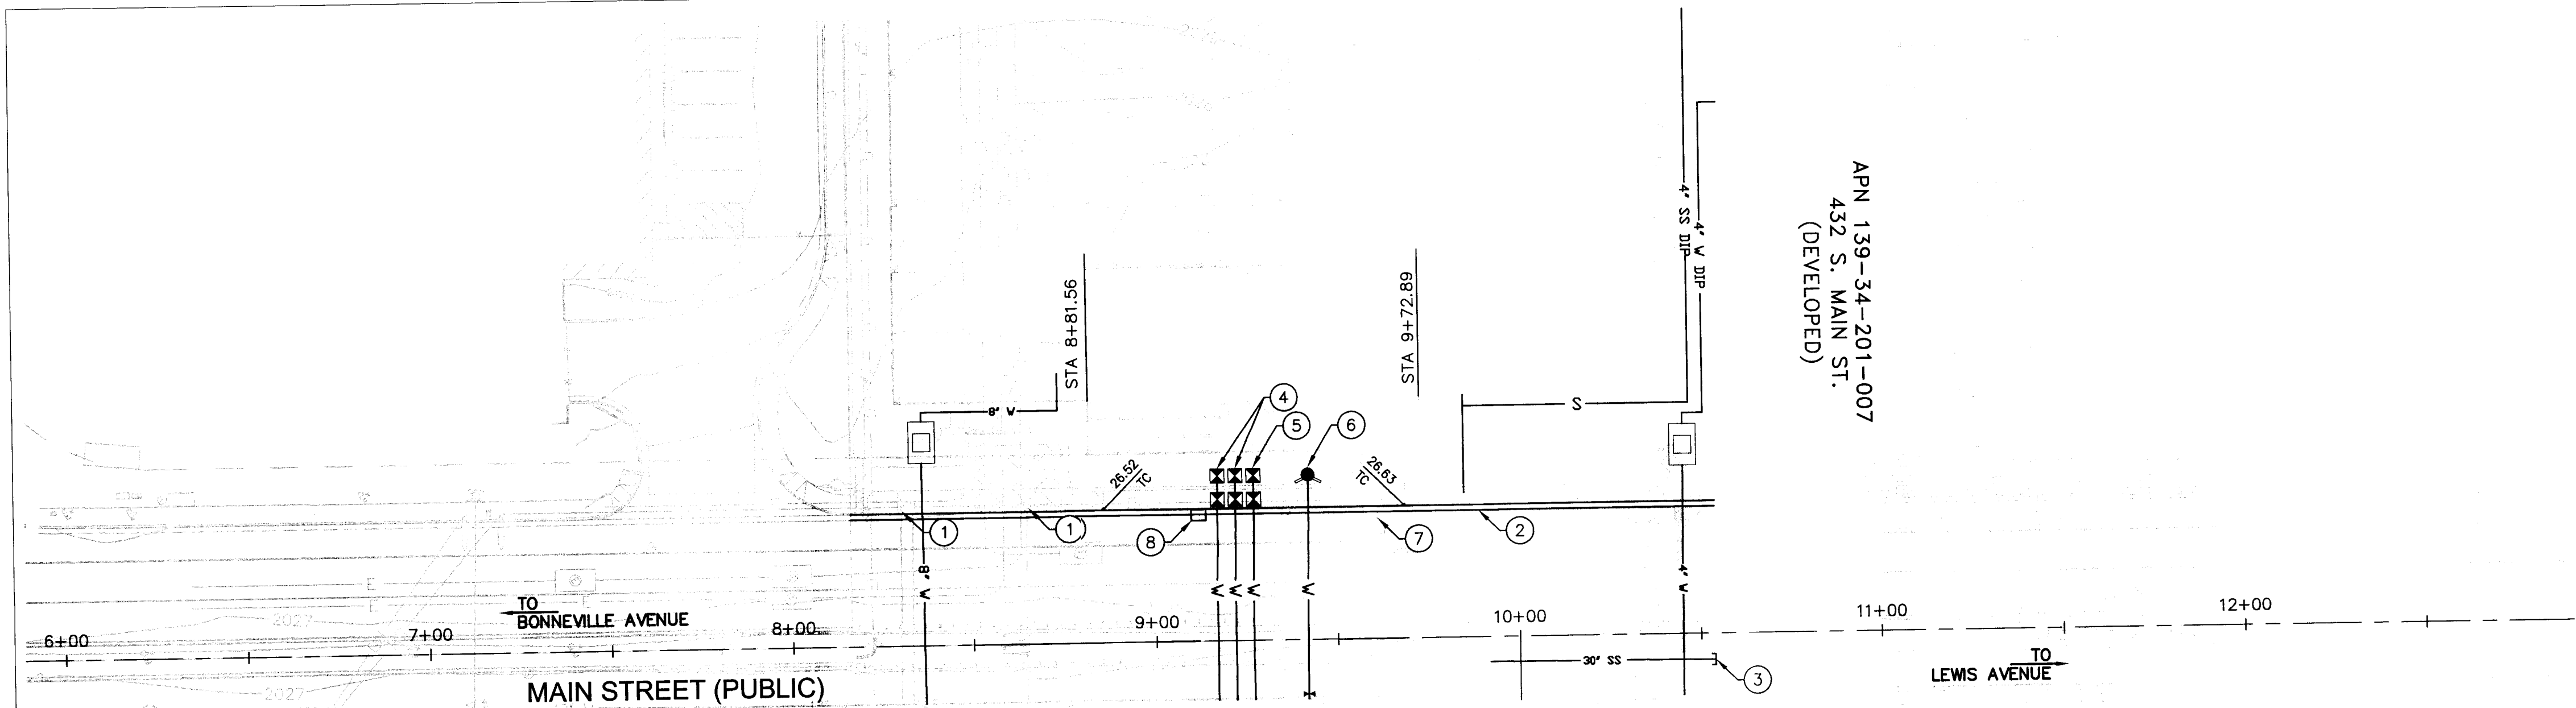

UTILITY NOTES

1. REMOVE EXISTING WATER METERS.
2. REMOVE EXISTING 18" CMP STORM DRAIN AND REPLACE WITH 18" CLASS III RCP.
3. INSTALL 8" PVC SEWER MAIN STUB-OUT W/ SEALED CAP AND THRUST BLOCK PER DCSWCS SECTION 2.2.5.
4. INSTALL 2" WATER METER W/ 2" BACKFLOW PREVENTION ASSEMBLY. REFERENCE UDACS PLATES 3 & 8.
5. INSTALL 1 1/2" WATER METER W 1 1/2" BACKFLOW PREVENTION ASSEMBLY. REFERENCE UDACS PLATES 3 & 8.
6. INSTALL FIRE HYDRANT W/GATE VALVE. REFERENCE UDACS PLATES 39 & 40.
7. REMOVE EXISTING TYPE 3 PIPE RISER INLET.
8. INSTALL TYPE 3 PIPE RISER INLET PER NDOT STANDARD PLAN NO. R-4.1.1.

NOTES:

1. CONTRACTOR TO POTHOLE AND VERIFY UTILITY ELEVATIONS AT CONNECTION POINTS, VERIFY CONSTRUCTABILITY AND CONSULT ENGINEER.

This grading is part of drainage study #4518 which was received on 2/3/11 and rejected on 2/17/11. Page 2 of 2


GRAPHIC SCALE
0 10 20 30 40
(IN FEET)

811 SAFETY ALERT
Call Before You Dig
Before You Overhead
1-702-432-5300



REVISIONS
CONSULTANT
OWNER: CITY OF LAS VEGAS
DEPARTMENT OF PUBLIC WORKS
CAPITAL PROJECT MANAGEMENT
400 EAST STEWART AVENUE
LAS VEGAS, NEVADA 89101
CONSULTANTS / DIVISIONS
PROJECT MANAGEMENT / PARKING CONSULTANT
STRUCTURAL ENGINEER / WALTER P. MOORE
7251 AMIGO STREET, SUITE 210
LAS VEGAS, NEVADA 89119
PHONE 702.844.4710 FAX 702.844.4790
ARCHITECT / CARPENTER SELLERS DEL GATTO ARCHITECTS
1919 S. JONES, SUITE C
LAS VEGAS, NEVADA 89146
PHONE 702.251.8896 FAX 702.251.8876
CIVIL ENGINEERS / KIMLEY-HORN AND ASSOCIATES
2000 EAST FLAMINGO ROAD, SUITE 210
LAS VEGAS, NEVADA 89119
PHONE 702.734.5066 FAX 702.735.4949
MEP CONSULTANTS / MSA ENGINEERING CONSULTANTS
370 E. WINDMILL LANE, SUITE 100
LAS VEGAS, NEVADA 89123
PHONE 702.896.1199 FAX 702.896.1133

DEPARTMENT OF PUBLIC WORKS
500 SOUTH MAIN STREET
PARKING GARAGE
MAIN STREET PLAN

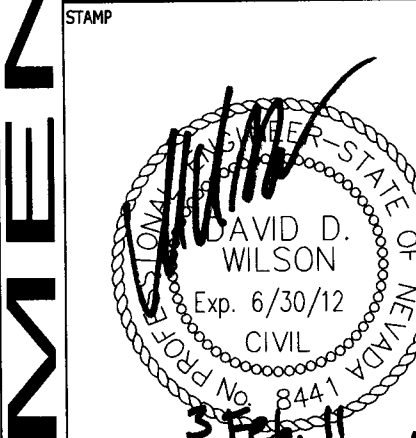

OWNER: CITY OF LAS VEGAS
DEPARTMENT OF PUBLIC WORKS

400 EAST STEWART AVENUE
LAS VEGAS, NEVADA 89101
PHONE: (702) 229-6535
FAX: (702) 384-4846
TDD: (702) 386-9108

DRAWN: MAG
FILE: 092708PP.DWG
DATE: 2/3/2011
SCALE: AS SHOWN
BID NO: 09.15341.19
CLV DWG NO: 09.15341.19-TF

C5.0