



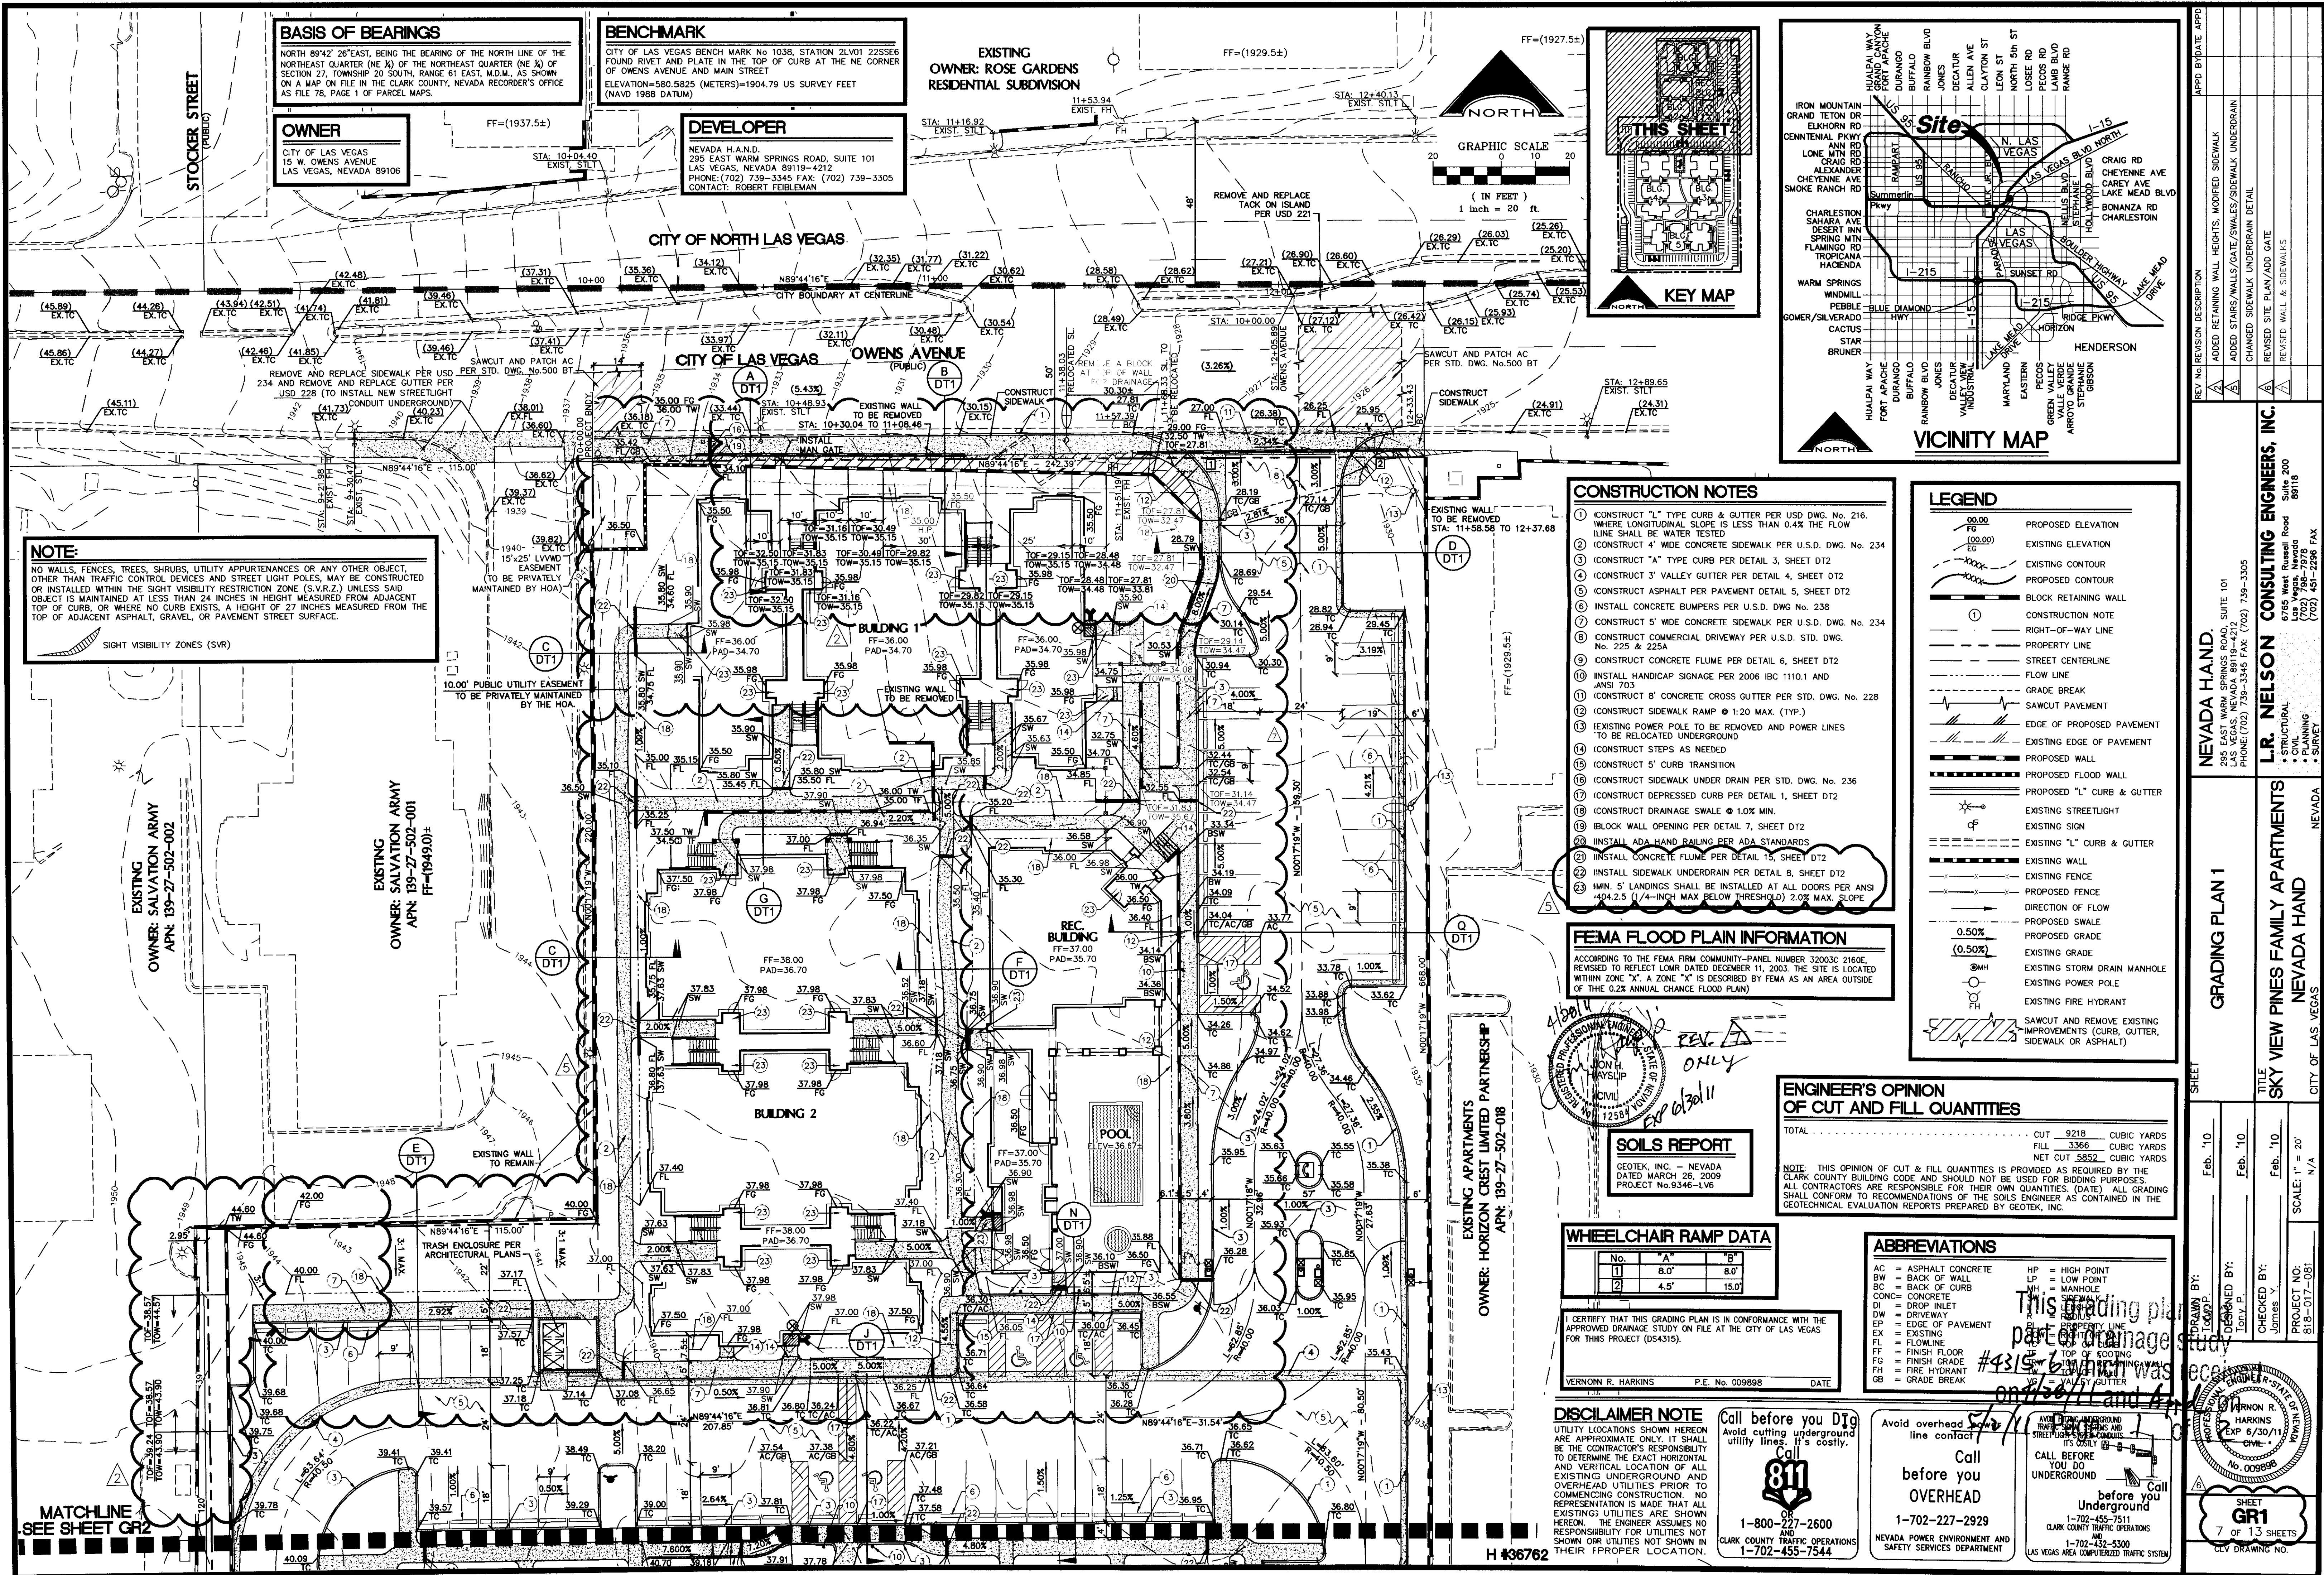

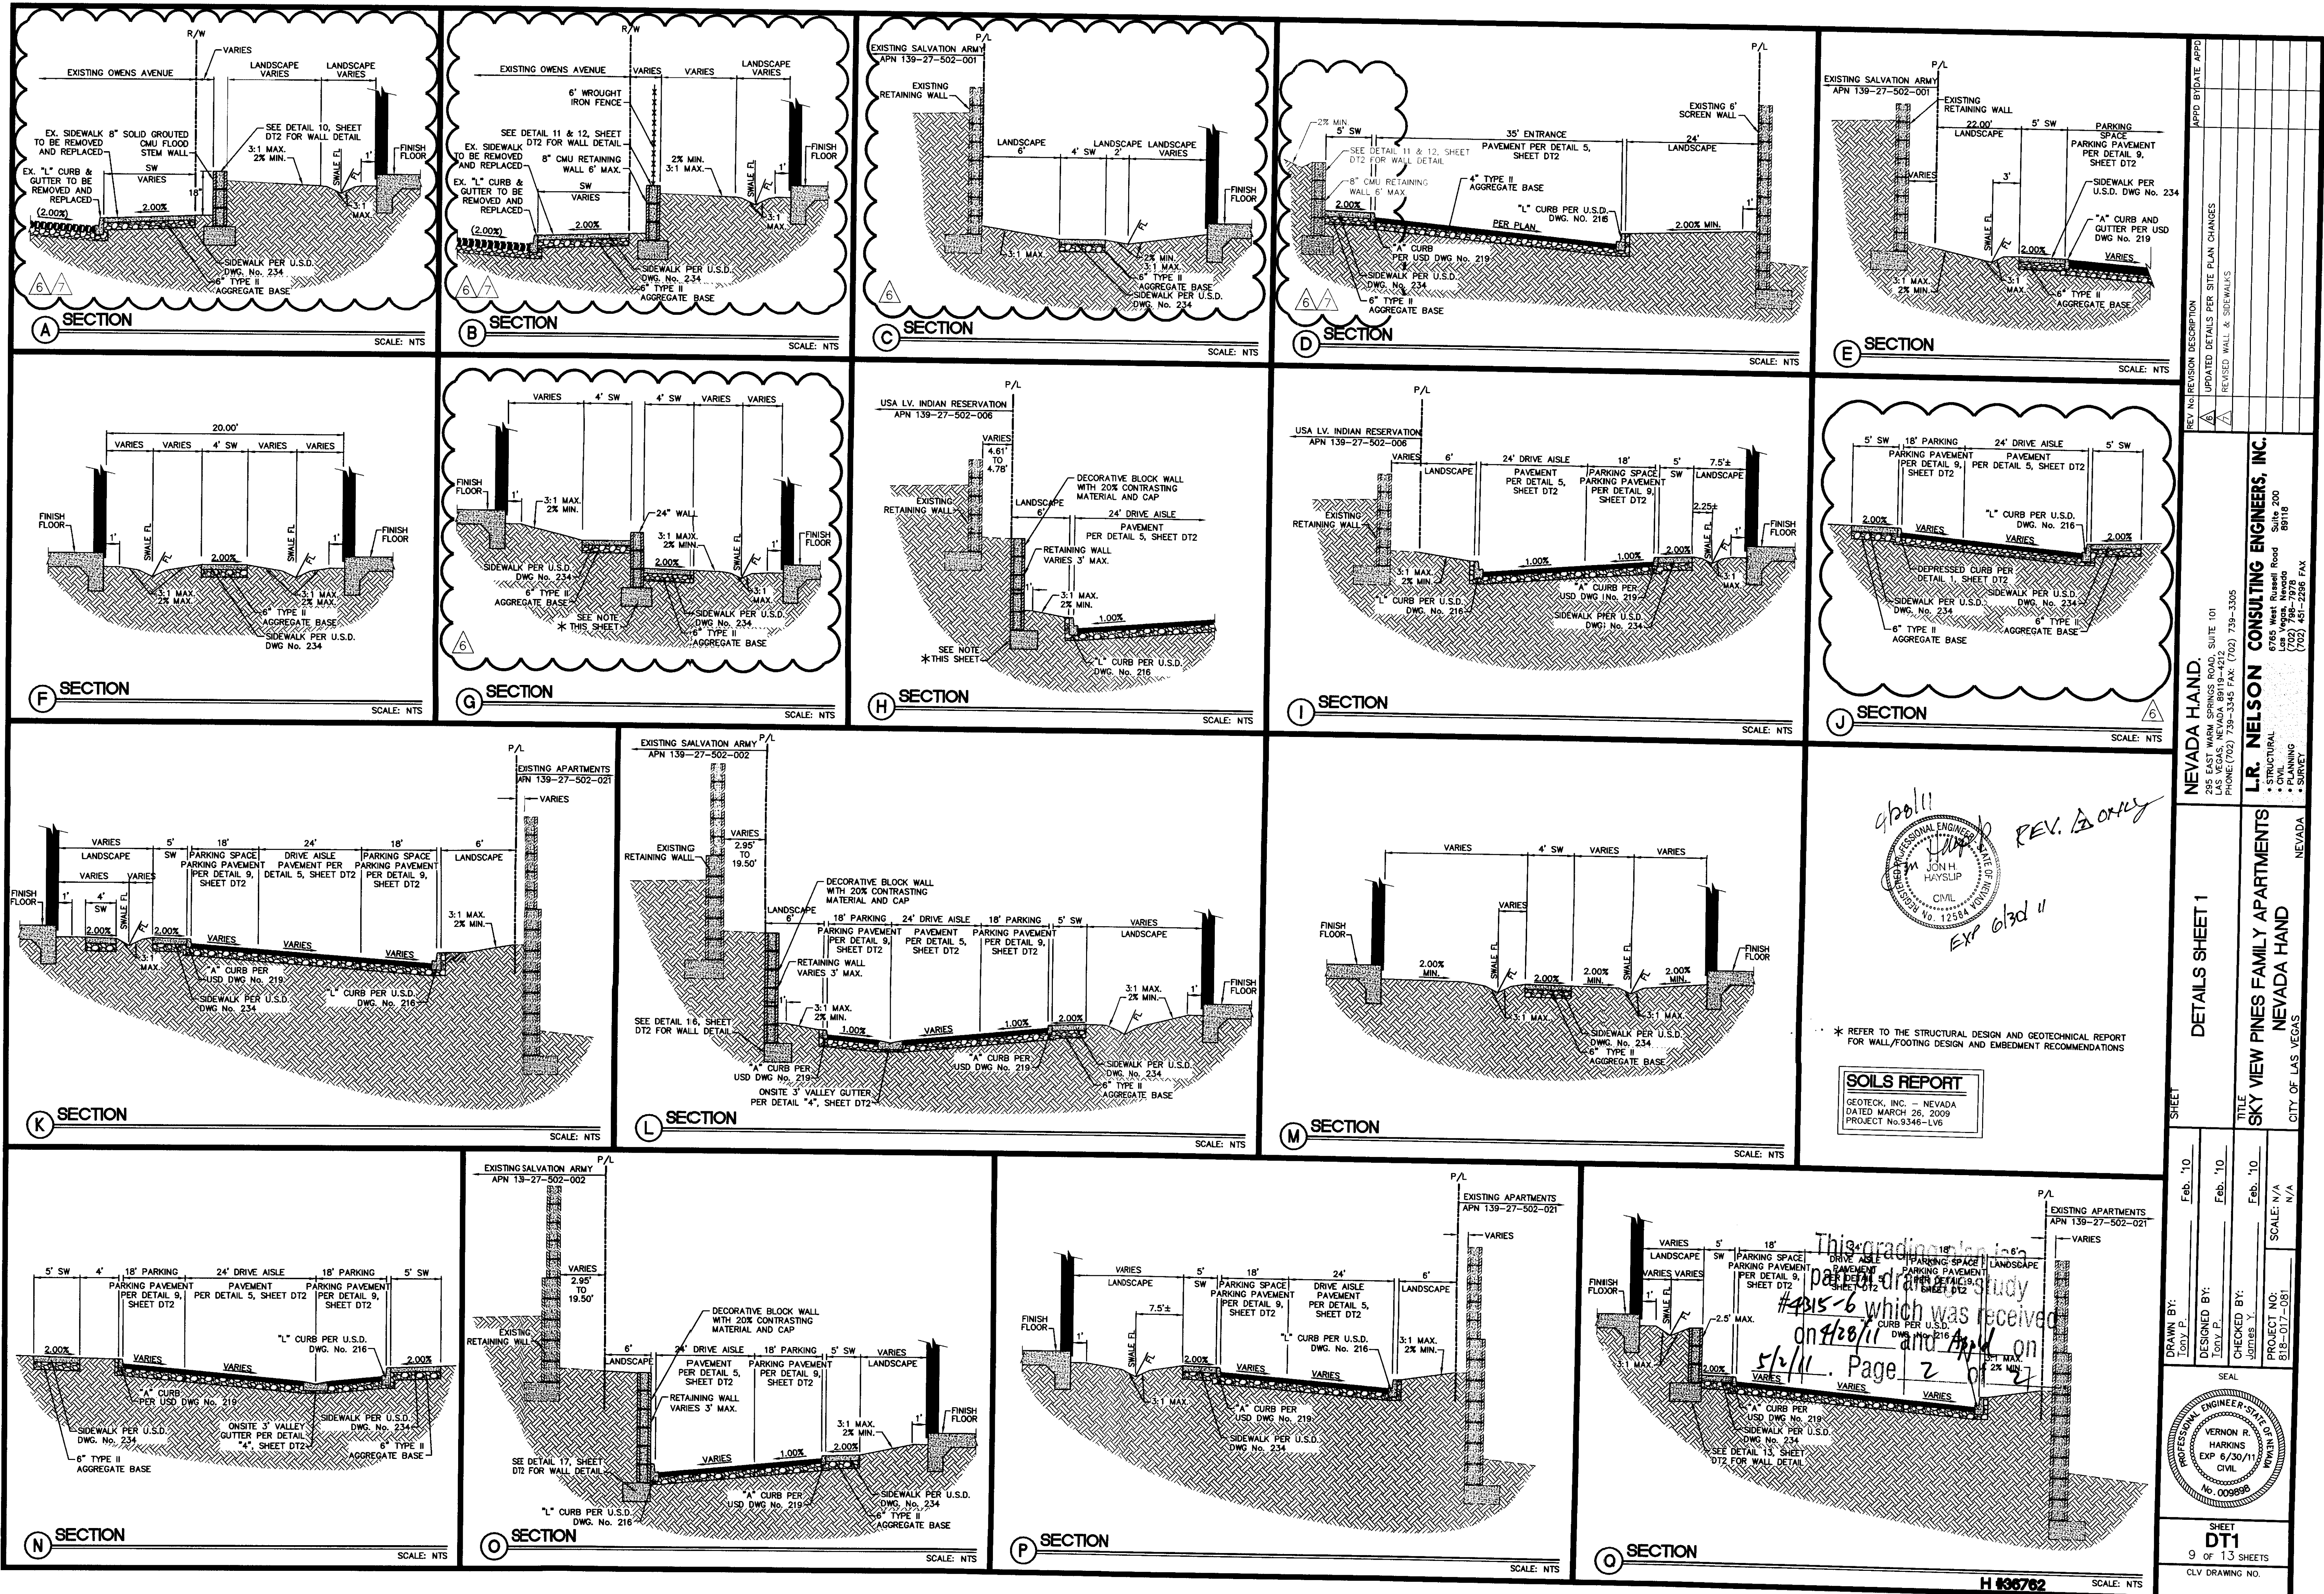

NORTH 89°42' 26"EAST, BEING THE BEARING OF THE NORTH LINE OF THE NORTHEAST QUARTER (NE ¼) OF THE NORTHEAST QUARTER (NE ¼) OF SECTION 27, TOWNSHIP 20 SOUTH, RANGE 61 EAST, M.D.M., AS SHOWN ON A MAP ON FILE IN THE CLARK COUNTY, NEVADA RECORDER'S OFFICE AS FILE 78, PAGE 1 OF PARCEL MAPS.

CITY OF LAS VEGAS
15 W. OWENS AVENUE
LAS VEGAS, NEVADA 89106

CITY OF LAS VEGAS BENCH MARK No 1038, STATION 2LV01 22S5E6
FOUND RIVET AND PLATE IN THE TOP OF CURB AT THE NE CORNER
OF OWENS AVENUE AND MAIN STREET
ELEVATION=580.5825 (METERS)=1904.79 US SURVEY FEET
(NAVD 1988 DATUM)

NEVADA H.A.N.D.
295 EAST WARM SPRINGS ROAD, SUITE 101
LAS VEGAS, NEVADA 89119-4212
PHONE: (702) 739-3345 FAX: (702) 739-3305
CONTACT: ROBERT FEIBLEMAN

EXISTING
OWNER: ROSE GARDENS
RESIDENTIAL SUBDIVISION

$$FF=(1929.5 \pm$$
 $FF = (1927.5 \pm$


GRAPHIC SCALE

20 0 10 2

(IN FEET)

1 inch = 20 ft.

NORTH

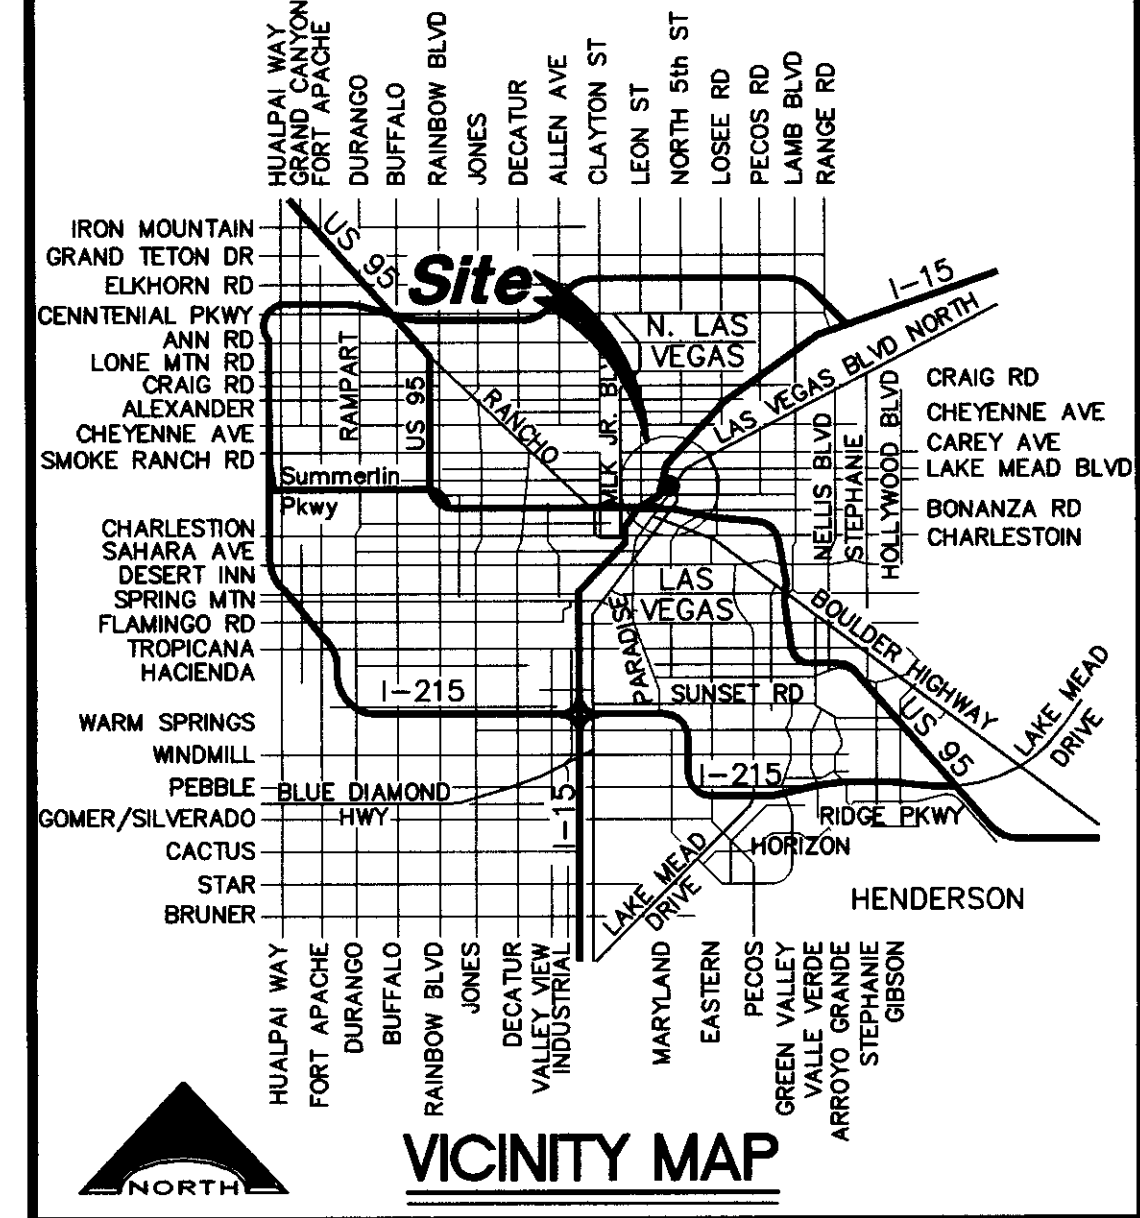

NOTE:

NO WALLS, FENCES, TREES, SHRUBS, UTILITY APPURTENANCES OR ANY OTHER OBJECT, OTHER THAN TRAFFIC CONTROL DEVICES AND STREET LIGHT POLES, MAY BE CONSTRUCTED OR INSTALLED WITHIN THE SIGHT VISIBILITY RESTRICTION ZONE (S.V.R.Z.) UNLESS SAID OBJECT IS MAINTAINED AT LESS THAN 24 INCHES IN HEIGHT MEASURED FROM ADJACENT TOP OF CURB, OR WHERE NO CURB EXISTS, A HEIGHT OF 27 INCHES MEASURED FROM THE TOP OF ADJACENT ASPHALT, GRAVEL, OR PAVEMENT STREET SURFACE.

SIGHT VISIBILITY ZONES (SVR)

EXISTING
OWNER: SALVATION ARMY

EXISTING
OWNER: SALVATION ARMY
APN: 139-27-502-001

CONSTRUCTION NOTES

- 1) CONSTRUCT "I" TYPE CURB & GUTTER PER USD DWG. No. 216.
WHERE LONGITUDINAL SLOPE IS LESS THAN 0.4% THE FLOW
LINE SHALL BE WATER TESTED
- 2) CONSTRUCT 4" WIDE CONCRETE SIDEWALK PER U.S.D. DWG. No. 234A
- 3) CONSTRUCT "A" TYPE CURB PER DETAIL 3, SHEET DT2
- 4) CONSTRUCT 3" VALLEY GUTTER PER DETAIL 4, SHEET DT2
- 5) CONSTRUCT ASPHALT PER PAVEMENT DETAIL 5, SHEET DT2
- 6) INSTALL CONCRETE BUMPERS PER U.S.D. DWG. No. 238
- 7) CONSTRUCT 5" WIDE CONCRETE SIDEWALK PER U.S.D. DWG. No. 234A
- 8) CONSTRUCT COMMERCIAL DRIVEWAY PER U.S.D. STD. DWG.
No. 225 & 225A
- 9) CONSTRUCT CONCRETE FLUME PER DETAIL 6, SHEET DT2
- 10) INSTALL HANDICAP SIGNAGE PER 2006 IBC 1101.1 AND
ANSI 703
- 11) CONSTRUCT 8" CONCRETE CROSS GUTTER PER STD. DWG. No. 228
- 12) CONSTRUCT SIDEWALK RAMP @ 1:20 MAX. (TYP.)
- 13) EXISTING POWER POLE TO BE REMOVED AND POWER LINES
TO BE RELOCATED UNDERGROUND
- 14) CONSTRUCT STEPS AS NEEDED
- 15) CONSTRUCT 5" CURB TRANSITION
- 16) CONSTRUCT SIDEWALK UNDER DRAIN PER STD. DWG. No. 236
- 17) CONSTRUCT DEPRESSIONED CURB PER DETAIL 1, SHEET DT2
- 18) CONSTRUCT DRAINAGE SWALE @ 1.0% MIN.
- 19) BLOCK WALL OPENING PER DETAIL 7, SHEET DT2
- 20) INSTALL ADA HAND RAILING PER ADA STANDARDS
- 21) INSTALL CONCRETE FLUME PER DETAIL 15, SHEET DT2
- 22) INSTALL SIDEWALK UNDERDRAIN PER DETAIL 8, SHEET DT2
- 23) MIN. 5" LANDINGS SHALL BE INSTALLED AT ALL DOORS PER ANSI
A4.2.2.5 (1/4-INCH MAX BELOW THRESHOLD) 2.0% MAX. SLOPE

FEMIA FLOOD PLAIN INFORMATION

ACCORDING TO THE FEMA FIRM COMMUNITY--PANEL NUMBER 32003C 2160E, REVISED TO REFLECT LOMR DATED DECEMBER 11, 2003. THE SITE IS LOCATED WITHIN Z/ONE "X". A ZONE "X" IS DESCRIBED BY FEMA AS AN AREA OUTSIDE OF THE 10.2% ANNUAL CHANCE FLOOD PLAIN)

LEGEND

- | | |
|--|---|
| | PROPOSED ELEVATION |
| | EXISTING ELEVATION |
| | EXISTING CONTOUR |
| | PROPOSED CONTOUR |
| | BLOCK RETAINING WALL |
| | CONSTRUCTION NOTE |
| | RIGHT-OF-WAY LINE |
| | PROPERTY LINE |
| | STREET CENTERLINE |
| | FLOW LINE |
| | GRADE BREAK |
| | SAWCUT PAVEMENT |
| | EDGE OF PROPOSED PAVEMENT |
| | EXISTING EDGE OF PAVEMENT |
| | PROPOSED WALL |
| | PROPOSED FLOOD WALL |
| | PROPOSED "L" CURB & GUTTER |
| | EXISTING STREETLIGHT |
| | EXISTING SIGN |
| | EXISTING "L" CURB & GUTTER |
| | EXISTING WALL |
| | EXISTING FENCE |
| | PROPOSED FENCE |
| | DIRECTION OF FLOW |
| | PROPOSED SWALE |
| | PROPOSED GRADE |
| | EXISTING GRADE |
| | EXISTING STORM DRAIN MANHOLE |
| | EXISTING POWER POLE |
| | EXISTING FIRE HYDRANT |
| | SAWCUT AND REMOVE EXISTING IMPROVEMENTS (CURB, GUTTER, STREETLIGHT, SIGN, ETC.) |

ENGINEER'S OPINION OF CUT AND FILL QUANTITIES

TOTAL	CUT	<u>9218</u>	CUBIC YARDS
	FILL	<u>3366</u>	CUBIC YARDS
	NET CUT	<u>5852</u>	CUBIC YARDS

NOTE: THIS OPINION OF CUT & FILL QUANTITIES IS PROVIDED AS REQUIRED BY THE CLARK COUNTY BUILDING CODE AND SHOULD NOT BE USED FOR BIDDING PURPOSES. ALL CONTRACTORS ARE RESPONSIBLE FOR THEIR OWN QUANTITIES. (DATE) ALL GRADING SHALL CONFORM TO RECOMMENDATIONS OF THE SOILS ENGINEER AS CONTAINED IN THE GEOTECHNICAL EVALUATION REPORTS PREPARED BY GEOTEK, INC.

SOILS REPORT

GEOTEK, INC. - NEVADA
DATED MARCH 26, 2009
PROJECT No.9346-LV6

WHEELCHAIR RAMP DATA

No.	"A"	"B"
1	8.0'	8.0'
2	4.5'	15.0'

I CERTIFY THAT THIS GRADING PLAN IS IN CONFORMANCE WITH THE APPROVED DRAINAGE STUDY ON FILE AT THE CITY OF LAS VEGAS FOR THIS PROJECT (DS4315).

VERNON R. HARKINS P.E. No. 009898 4/21/11

ABBREVIATIONS

AC	= ASPHALT CONCRETE	HP	= HIGH POINT
BW	= BACK OF WALL	LP	= LOW POINT
BC	= BACK OF CURB	MA	= MANHOLE
CONC	= CONCRETE	SW	= SIDEWALK
DI	= DROP INLET	L	= LENGTH
DW	= DRIVEWAY	R	= RADIUS
EP	= EDGE OF PAVEMENT	PL	= PROPERTY LINE
EX	= EXISTING	ROW	= RIGHT OF WAY
FL	= FLOWLINE	TC	= TOP OF CURB
FF	= FINISH FLOOR	TF	= TOP OF FOOTING
FG	= FINISH GRADE	TRW	= TOP OF RETAINING WALL
FH	= FIRE HYDRANT	TW	= TOP OF WALL
GB	= GRADE BREAK	VG	= VALLEY GUTTER

DISCLAIMER NOTE

UTILITY LOCATIONS SHOWN HEREON ARE APPROXIMATE ONLY. IT SHALL BE THE CONTRACTOR'S RESPONSIBILITY TO DETERMINE THE EXACT HORIZONTAL AND VERTICAL LOCATION OF ALL EXISTING UNDERGROUND AND OVERHEAD UTILITIES PRIOR TO COMMENCING CONSTRUCTION. NO REPRESENTATION IS MADE THAT ALL EXISTING UTILITIES ARE SHOWN HEREON. THE ENGINEER ASSUMES NO RESPONSIBILITY FOR UTILITIES NOT SHOWN OR UTILITIES NOT SHOWN IN THEIR PROPER LOCATION.

Call before you Dig
Avoid cutting underground
utility lines. It's costly.

Call
811

OR
1-800-227-2600
AND
CLARK COUNTY TRAFFIC OPERATIONS
1-702-455-7544

Call before you dig
435-6666
1-702-435-5111

NEVADA POWER ENVIRONMENT AND SAFETY SERVICES DEPARTMENT

Call before you dig
1-702-435-5111
1-702-432-5300
LAS VEGAS AREA COMPUTERIZED TRACKING SYSTEM

NEVADA H.A.N.D.
295 EAST WARM SPRINGS ROAD, SUITE 101
LAS VEGAS, NEVADA 89119-4212
PHONE: (702) 739-3345 FAX: (702) 739-3305

L.R. NELSON CONSULTING ENGINEERS, INC.

GRADING PLAN 1

TITLE
SKY VIEW PINES FAMILY APARTMENTS
NEVADA HAND
 CITY OF LAS VEGAS

NEVADA

DESIGNED BY: Tony P.	Feb. '10
CHECKED BY: James Y.	Feb. '10
PROJECT NO: 818-017-081	
SCALE: 1" = 20' N/A	

PROFESSIONAL ENGINEER - STATE OF NEVADA
VERNON R. HARKINS
EXP 6/30/11
CIVIL
No. 009898
4/11

6

SHEET
GR1
7 OF 13 SHEETS
CLV DRAWING NO.

BASIS OF BEARINGS
NORTH 89°42' 26"E, BEING THE BEARING OF THE NORTH LINE OF THE NORTHWEST QUARTER (NE 1/4) OF THE NORTHEAST QUARTER (NE 1/4) OF SECTION 27, TOWNSHIP 20 SOUTH, RANGE 61 EAST, M.D.M., SHOWN ON A MAP ON FILE IN THE CLARK COUNTY, NEVADA RECORDER'S OFFICE AS FILED 78, PAGE 1 OF PARCEL MAPS.

OWNER
CITY OF LAS VEGAS
15 W. OWENS AVENUE
LAS VEGAS, NEVADA 89106




BENCHMARK
CITY OF LAS VEGAS BENCH MARK NO. 1038, STATION 2LV01 22556 FOUND RIVET AND PLATE IN THE TOP OF CURB AT THE NE CORNER OF OWENS AVENUE AND MAIN STREET
ELEVATION=580.5825 (METERS)=1904.79 US SURVEY FEET (NAVD. 1988 DATUM)

DEVELOPER
NEVADA H.A.N.D.
295 EAST WARM SPRINGS ROAD, SUITE 101
LAS VEGAS, NEVADA 89119-4212
PHONE: (702) 739-3345 FAX: (702) 739-3305
CONTACT: ROBERT FEIBLEMAN

EXISTING
OWNER: ROSE GARDENS
RESIDENTIAL SUBDIVISION

FF=(1929.5±)

FF=(1927.5±)

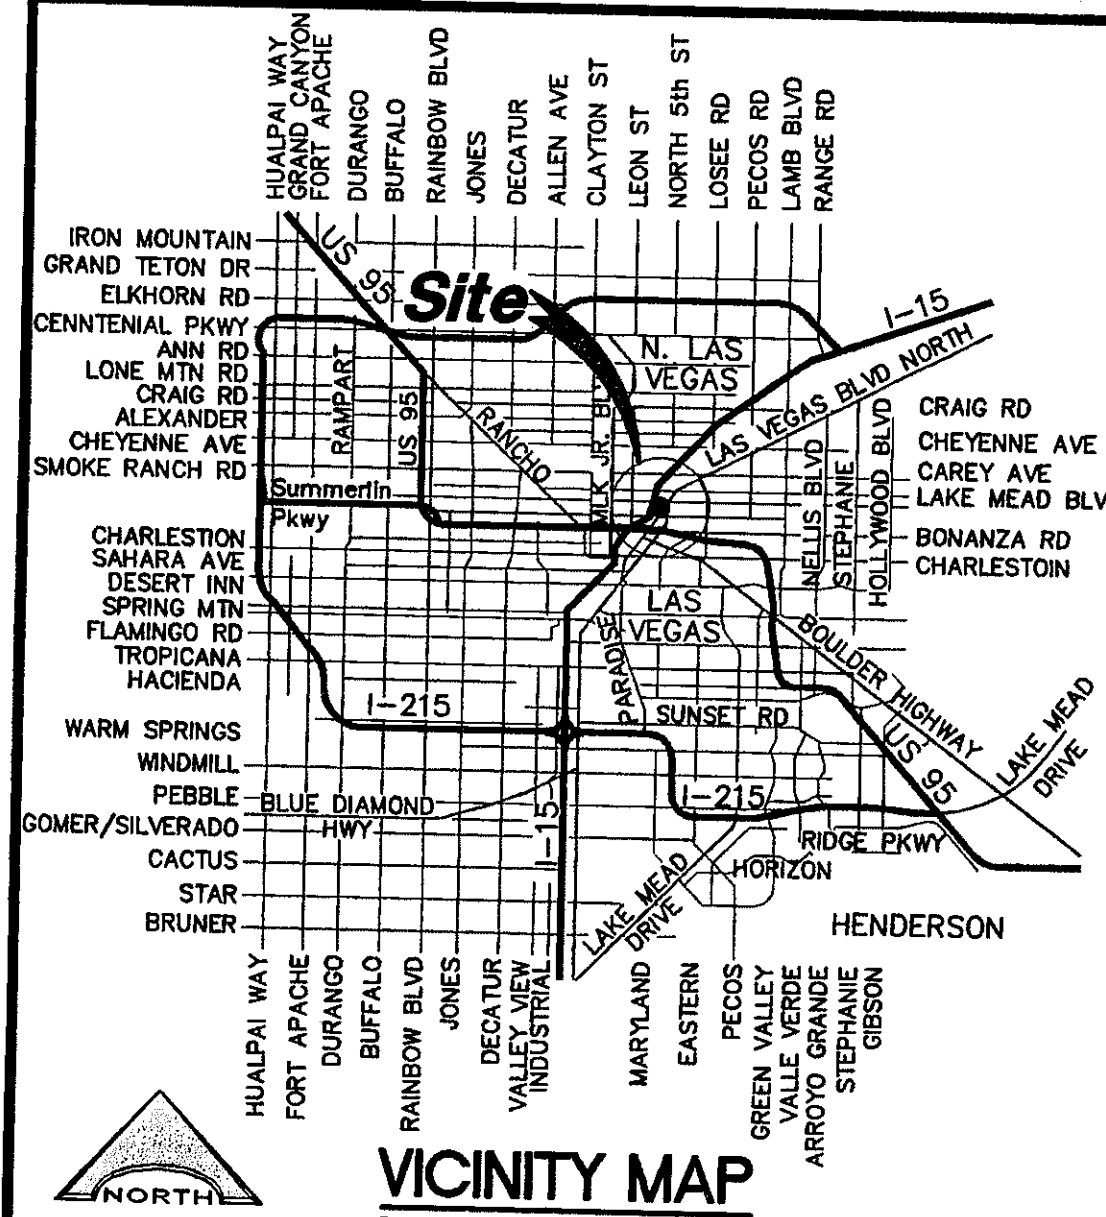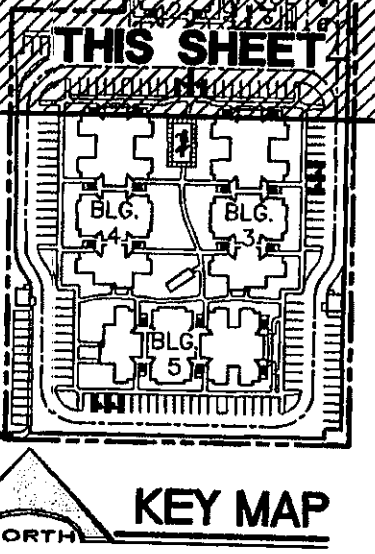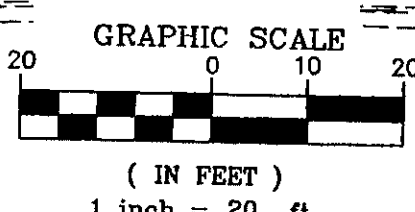

NOTE
NO WALLS, FENCES, TREES, SHRUBS, UTILITY APPURTENANCES OR ANY OTHER OBJECT, OTHER THAN TRAFFIC CONTROL DEVICES AND STREET LIGHT POLES, MAY BE CONSTRUCTED OR INSTALLED WITHIN THE SIGHT VISIBILITY RESTRICTION ZONE (S.V.R.Z.) UNLESS SAID OBJECT IS MAINTAINED AT A HEIGHT OF 27 INCHES IN HEIGHT MEASURED FROM ADJACENT TOP OF CURB, OR WHERE NO CURB EXISTS, A HEIGHT OF 27 INCHES MEASURED FROM THE TOP OF ADJACENT ASPHALT, GRAVEL, OR PAVEMENT STREET SURFACE.

CONSTRUCTION NOTES

1. CONSTRUCT "L" TYPE CURB & GUTTER PER USD DWG. NO. 216. WHERE LONGITUDINAL SLOPE IS LESS THAN 0.4% THE FLOW LINE SHALL BE WATER TESTED.
2. CONSTRUCT "A" WIDE CONCRETE SIDEWALK PER U.S.D. DWG. NO. 234.
3. CONSTRUCT "A" TYPE CURB PER DETAIL 3, SHEET DT2.
4. CONSTRUCT "3" VALLEY GUTTER PER DETAIL 4, SHEET DT2.
5. CONSTRUCT ASPHALT PER PAVEMENT DETAIL 5, SHEET DT2.
6. INSTALL CONCRETE BUMPERS PER U.S.D. DWG. NO. 238.
7. CONSTRUCT 5' WIDE CONCRETE SIDEWALK PER U.S.D. DWG. NO. 234.
8. CONSTRUCT COMMERCIAL DRIVEWAY PER U.S.D. STD. DWG. NO. 225 & 225A.
9. CONSTRUCT CONCRETE FLUME PER DETAIL 6, SHEET DT2.
10. INSTALL HANDICAP SIGNAGE PER 2006 IBC 1101.1 AND ANSI 703.
11. CONSTRUCT 8" CONCRETE CROSS GUTTER PER STD. DWG. NO. 228.
12. CONSTRUCT SIDEWALK RAMP @ 1:20 MAX. (TYP.)
13. EXISTING POWER POLE TO BE REMOVED AND POWER LINES TO BE RELOCATED UNDERGROUND.
14. CONSTRUCT STEPS AS NEEDED.
15. CONSTRUCT 5' CURB TRANSITION.
16. CONSTRUCT SIDEWALK UNDER DRAIN PER STD. DWG. NO. 236.
17. CONSTRUCT DEPRESSURE CURB PER DETAIL 1, SHEET DT2.
18. CONSTRUCT DRAINAGE SWALE @ 1.0% MIN.
19. BLOCK WALL OPENING PER DETAIL 7, SHEET DT2.
20. INSTALL ADA HAND RAILING PER ADA STANDARDS.
21. INSTALL CONCRETE FLUME PER DETAIL 15, SHEET DT2.
22. INSTALL SIDEWALK UNDERDRAIN PER DETAIL 8, SHEET DT2.
23. MIN. 5' LANDINGS SHALL BE INSTALLED AT ALL DOORS PER ANSI 404.2.5 (1/4-INCH MAX BELOW THRESHOLD) 2.0% MAX. SLOPE.

FEMA FLOOD PLAIN INFORMATION

ACCORDING TO THE FEMA FIRM COMMUNITY-PANEL NUMBER 32003C 2160E, REVISION 1, DATED DECEMBER 11, 2003, THE SITE IS LOCATED WITHIN ZONE "X", A ZONE "X" IS DESCRIBED BY FEMA AS AN AREA OUTSIDE OF THE 0.2% ANNUAL CHANCE FLOOD PLAIN.

LEGEND

- PROPOSED ELEVATION
- EXISTING ELEVATION
- PROPOSED CONTOUR
- EXISTING CONTOUR
- BLOCK RETAINING WALL
- CONSTRUCTION NOTE
- RIGHT-OF-WAY LINE
- PROPERTY LINE
- STREET CENTERLINE
- FLOW LINE
- GRADE BREAK
- SAW-CUT PAVEMENT
- EDGE OF PROPOSED PAVEMENT
- EXISTING EDGE OF PAVEMENT
- PROPOSED WALL
- PROPOSED FLOOD WALL
- PROPOSED "L" CURB & GUTTER
- EXISTING STREETLIGHT
- EXISTING SIGN
- EXISTING "L" CURB & GUTTER
- EXISTING WALL
- EXISTING FENCE
- PROPOSED FENCE
- DIRECTION OF FLOW
- PROPOSED SWALE
- PROPOSED GRADE
- EXISTING STORM
- EXISTING STORM DRAIN MANHOLE
- EXISTING POWER POLE
- EXISTING FIRE HYDRANT
- SAW-CUT AND REMOVE EXISTING IMPROVEMENTS (CURB, GUTTER, SIDEWALK OR ASPHALT)

ENGINEER'S OPINION OF CUT AND FILL QUANTITIES

TOTAL CUT 9218 CUBIC YARDS
TOTAL FILL 3366 CUBIC YARDS
NET CUT 5852 CUBIC YARDS

NOTE: THIS OPINION OF CUT & FILL QUANTITIES IS PROVIDED AS REQUIRED BY THE CLARK COUNTY BUILDING CODE AND SHOULD NOT BE USED FOR BIDDING PURPOSES. ALL CONTRACTORS ARE RESPONSIBLE FOR THEIR OWN QUANTITIES (DATE) ALL GRADING SHALL CONFORM TO RECOMMENDATIONS OF THE SOILS ENGINEER AS CONTAINED IN THE GEOTECHNICAL EVALUATION REPORTS PREPARED BY GEOTEK, INC.

SOILS REPORT

GEOTEK, INC. - NEVADA
DATED MARCH 26, 2009
PROJECT NO. 9346-LVS

WHEELCHAIR RAMP DATA

No.	"A"	"B"
1	8.0'	8.0'
2	4.5'	15.0'

CERTIFY THAT THIS GRADING PLAN IS IN CONFORMANCE WITH THE APPROVED DRAINAGE STUDY ON FILE AT THE CITY OF LAS VEGAS FOR THIS PROJECT (DS4315).

DISCLAIMER NOTE

UTILITY LOCATIONS SHOWN HEREON ARE APPROXIMATE ONLY. IT SHALL BE THE CONTRACTOR'S RESPONSIBILITY TO DETERMINE THE EXACT HORIZONTAL AND VERTICAL LOCATION OF ALL EXISTING UNDERGROUND AND OVERHEAD UTILITIES PRIOR TO COMMENCING CONSTRUCTION. NO REPRESENTATION IS MADE THAT ALL EXISTING UTILITIES ARE SHOWN HEREON. THE ENGINEER ASSUMES NO RESPONSIBILITY FOR UTILITIES NOT SHOWN OR UTILITIES NOT IN THEIR PROPER LOCATION.

Call before you Dig
Avoid cutting underground utility lines. It's costly.

Call before you Overhead
Avoid overhead power line contact.

Call before you Undergo
Avoid hitting underground traffic signal systems and street light bases. It's costly.

ABBREVIATIONS

- AC = ASPHALT CONCRETE
- BW = BACK OF WALL
- BC = BACK OF CURB
- CONC = CONCRETE
- DI = DROP INLET
- DW = DRIVEWAY
- EX = EXISTING
- FL = FLOWLINE
- FF = FINISH FLOOR
- FG = FINISH GRADE
- FH = FIRE HYDRANT
- GB = GRADE BREAK
- HP = HIGH POINT
- LP = LOW POINT
- MH = MANHOLE
- SW = SIDEWALK
- LENTH = LENGTH
- PL = RADIUS
- PL = PROPERTY LINE
- ROW = RIGHT OF WAY
- TC = TOP OF CURB
- TF = TOP OF FOOTING
- TW = TOP OF RETAINING WALL
- VG = VALLEY GUTTER

NEVADA HAND.
295 EAST WARM SPRINGS ROAD, SUITE 101
LAS VEGAS, NEVADA 89119-4212
PHONE: (702) 739-3345 FAX: (702) 739-3305

GRADING PLAN 1

SKY VIEW PINES FAMILY APARTMENTS

NEVADA HAND

CITY OF LAS VEGAS

PROJECT NO. 818-017-081

SCALE: 1" = 20'

DATE: Feb. '10

DESIGNED BY: Tony P.

CHECKED BY: James Y.



























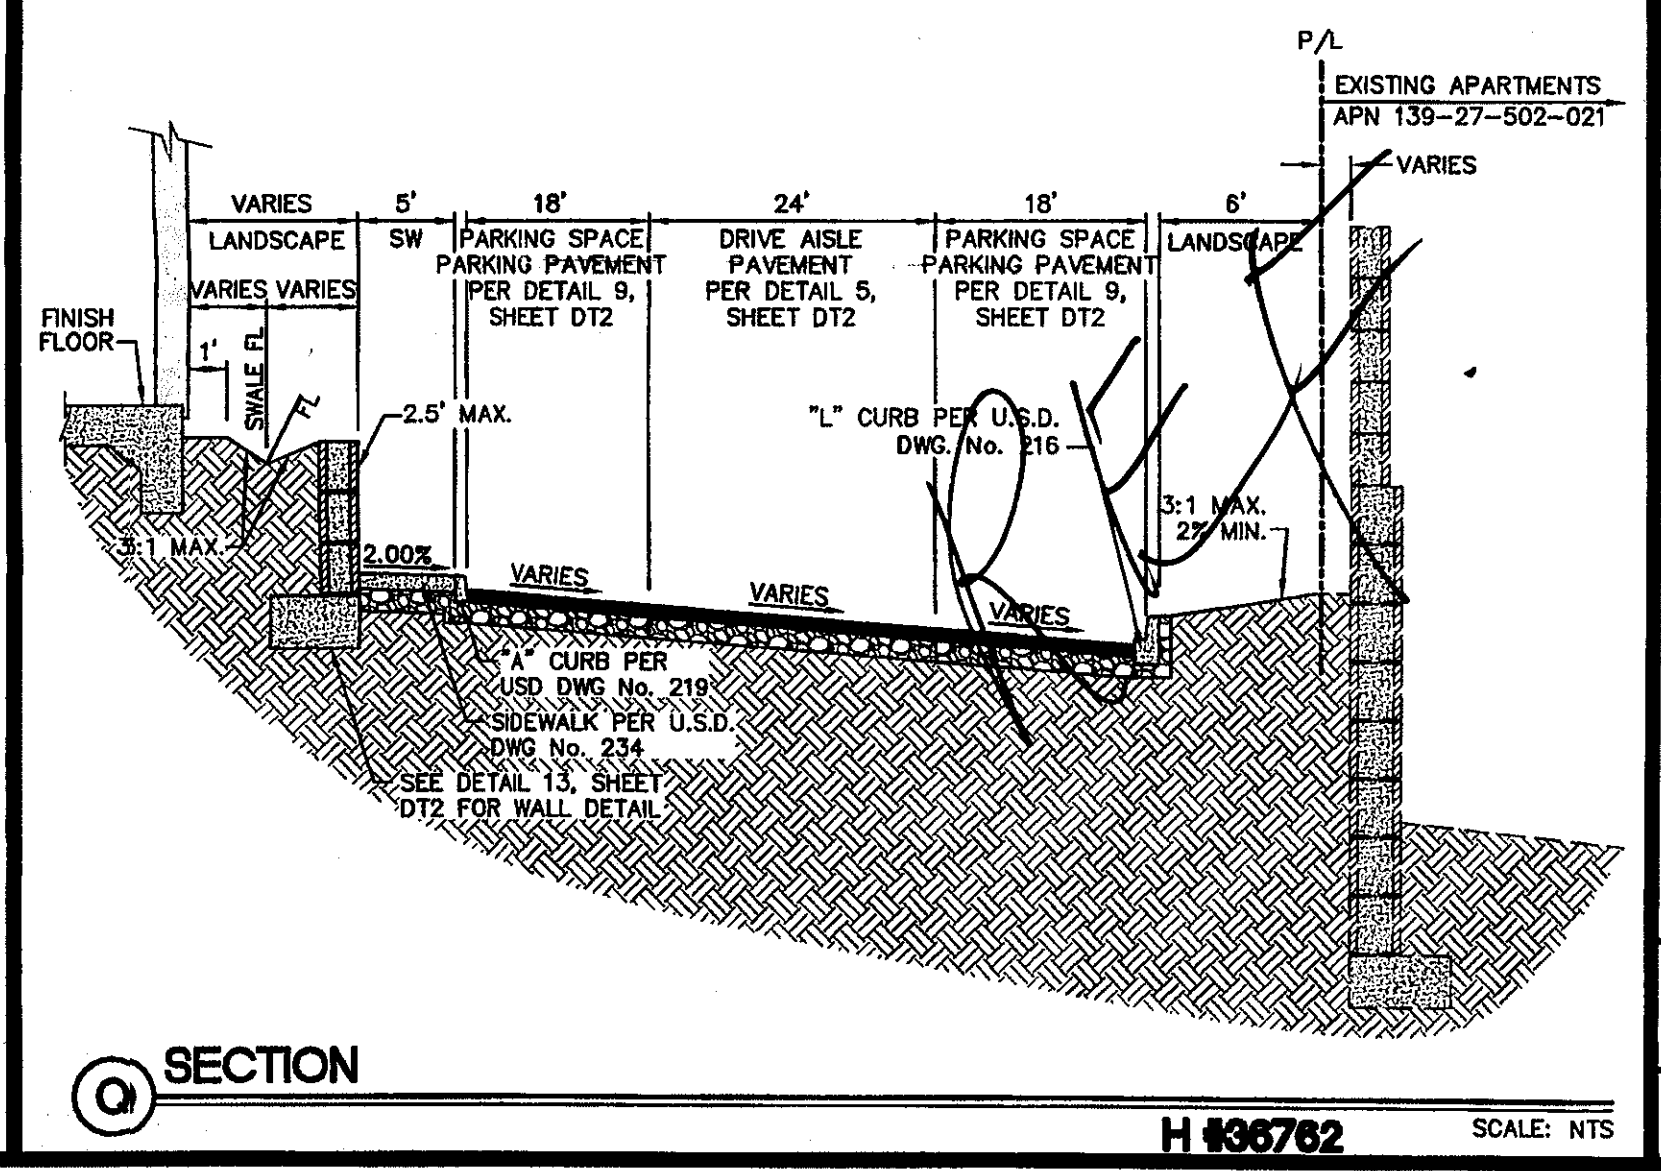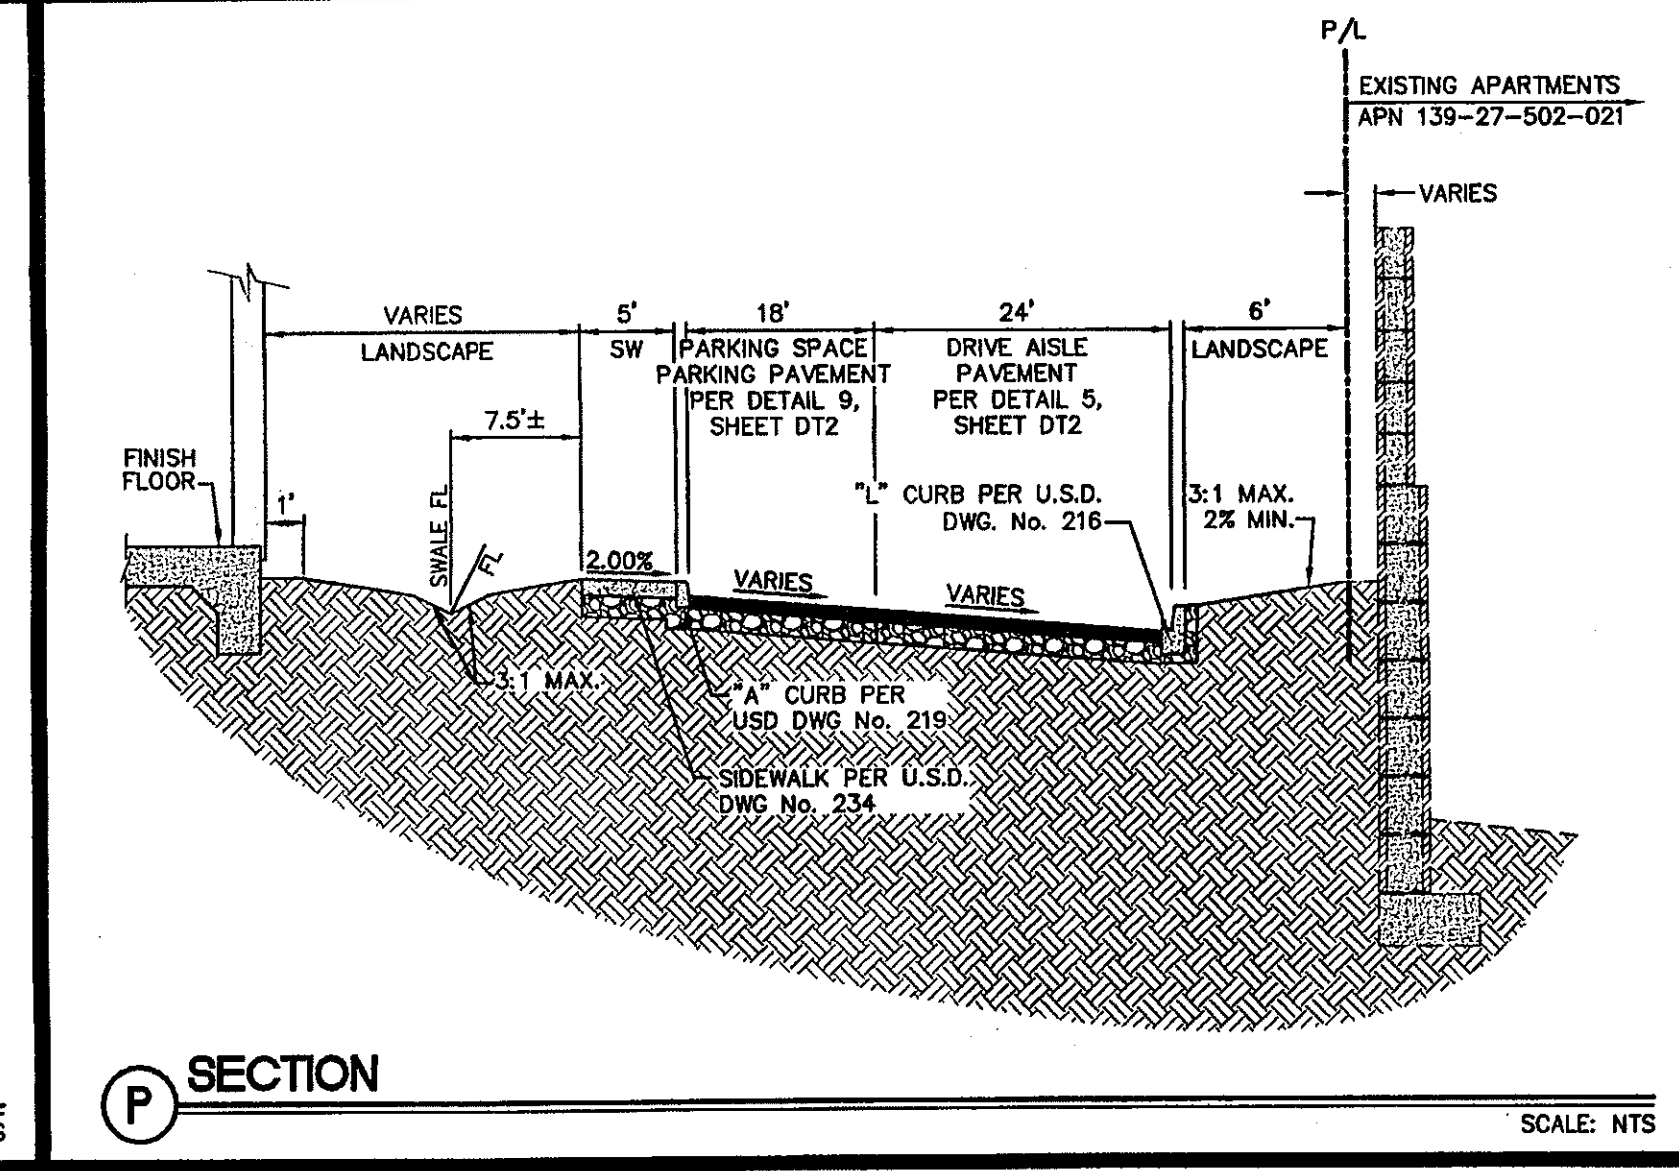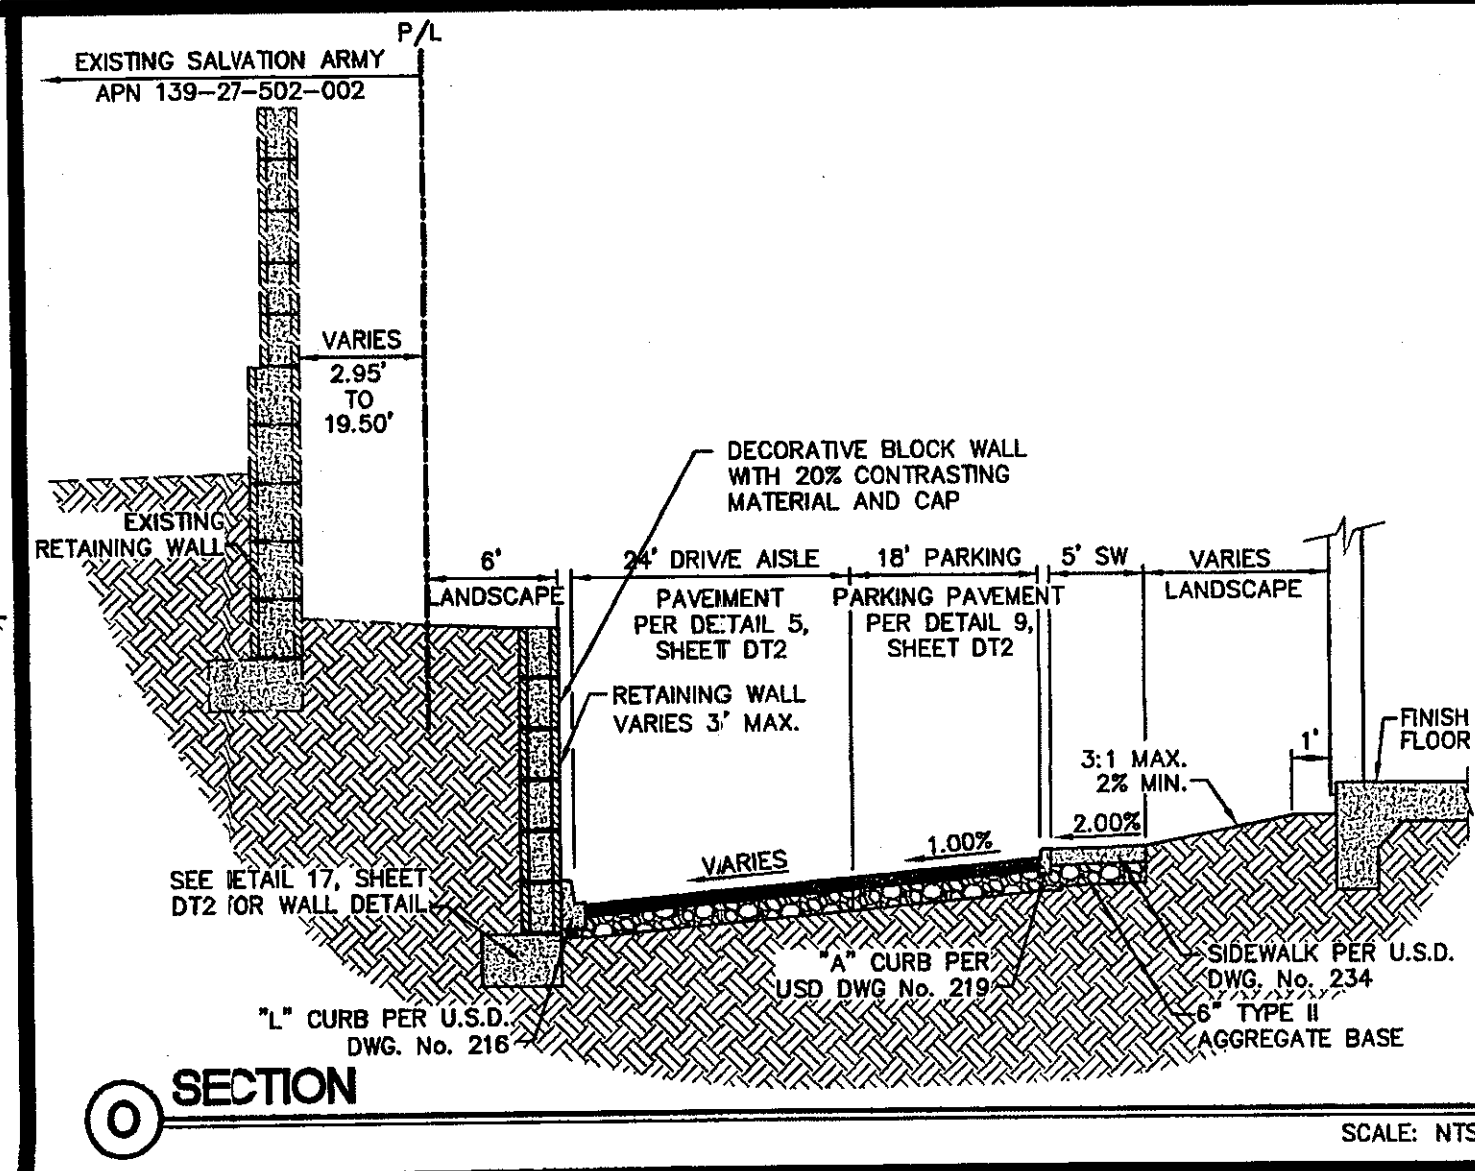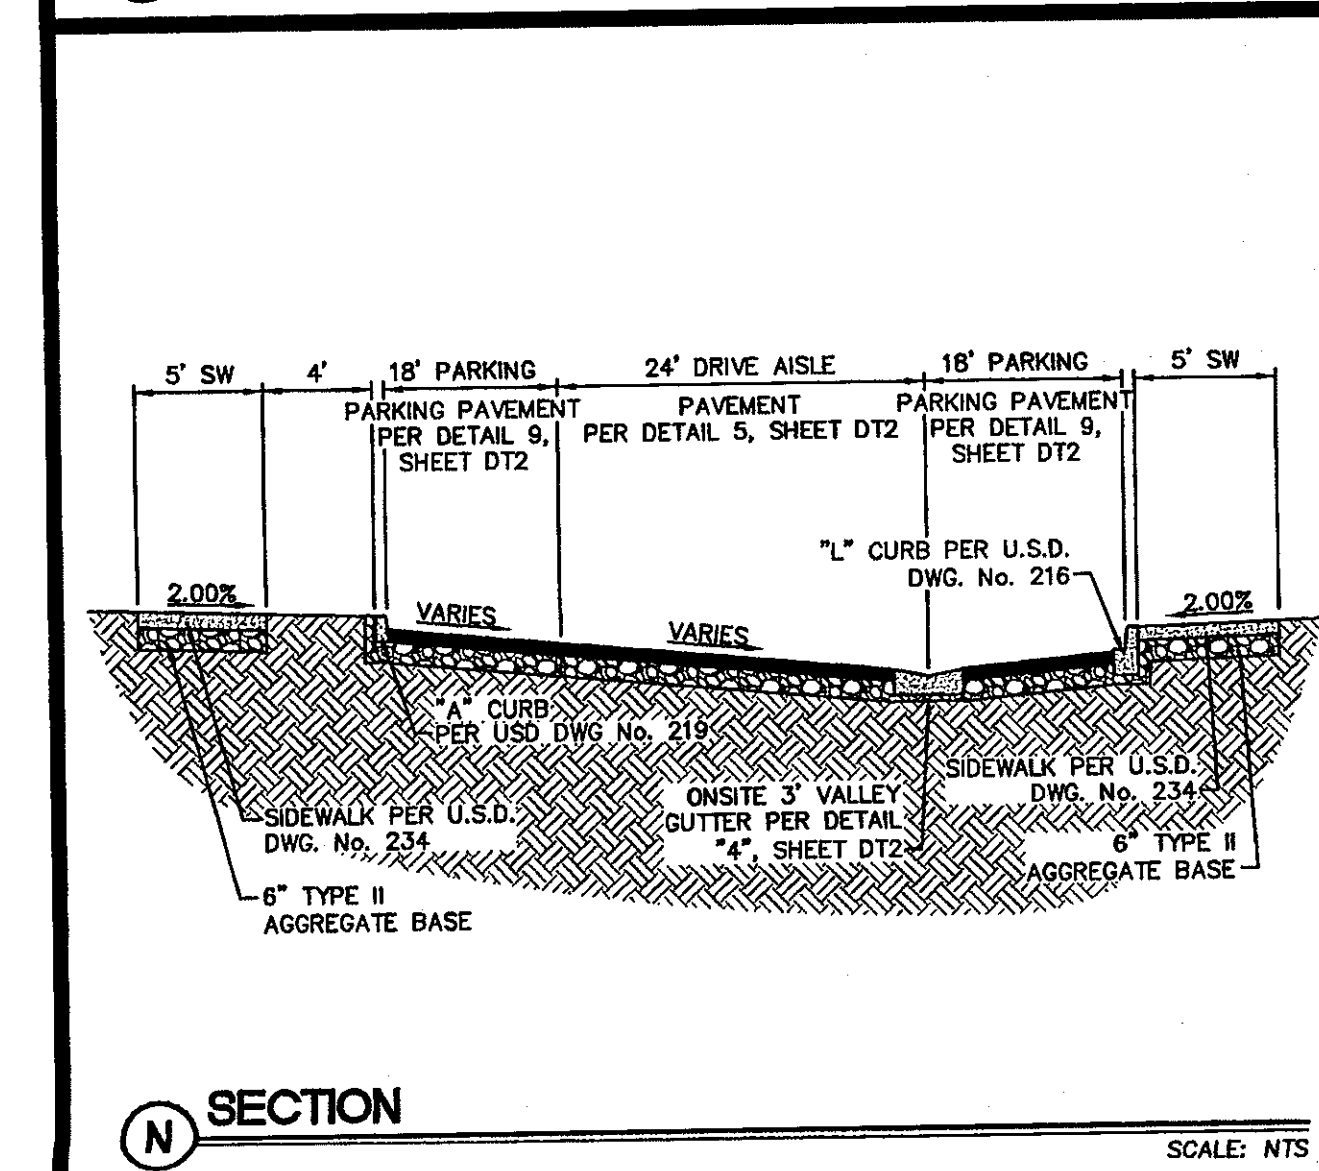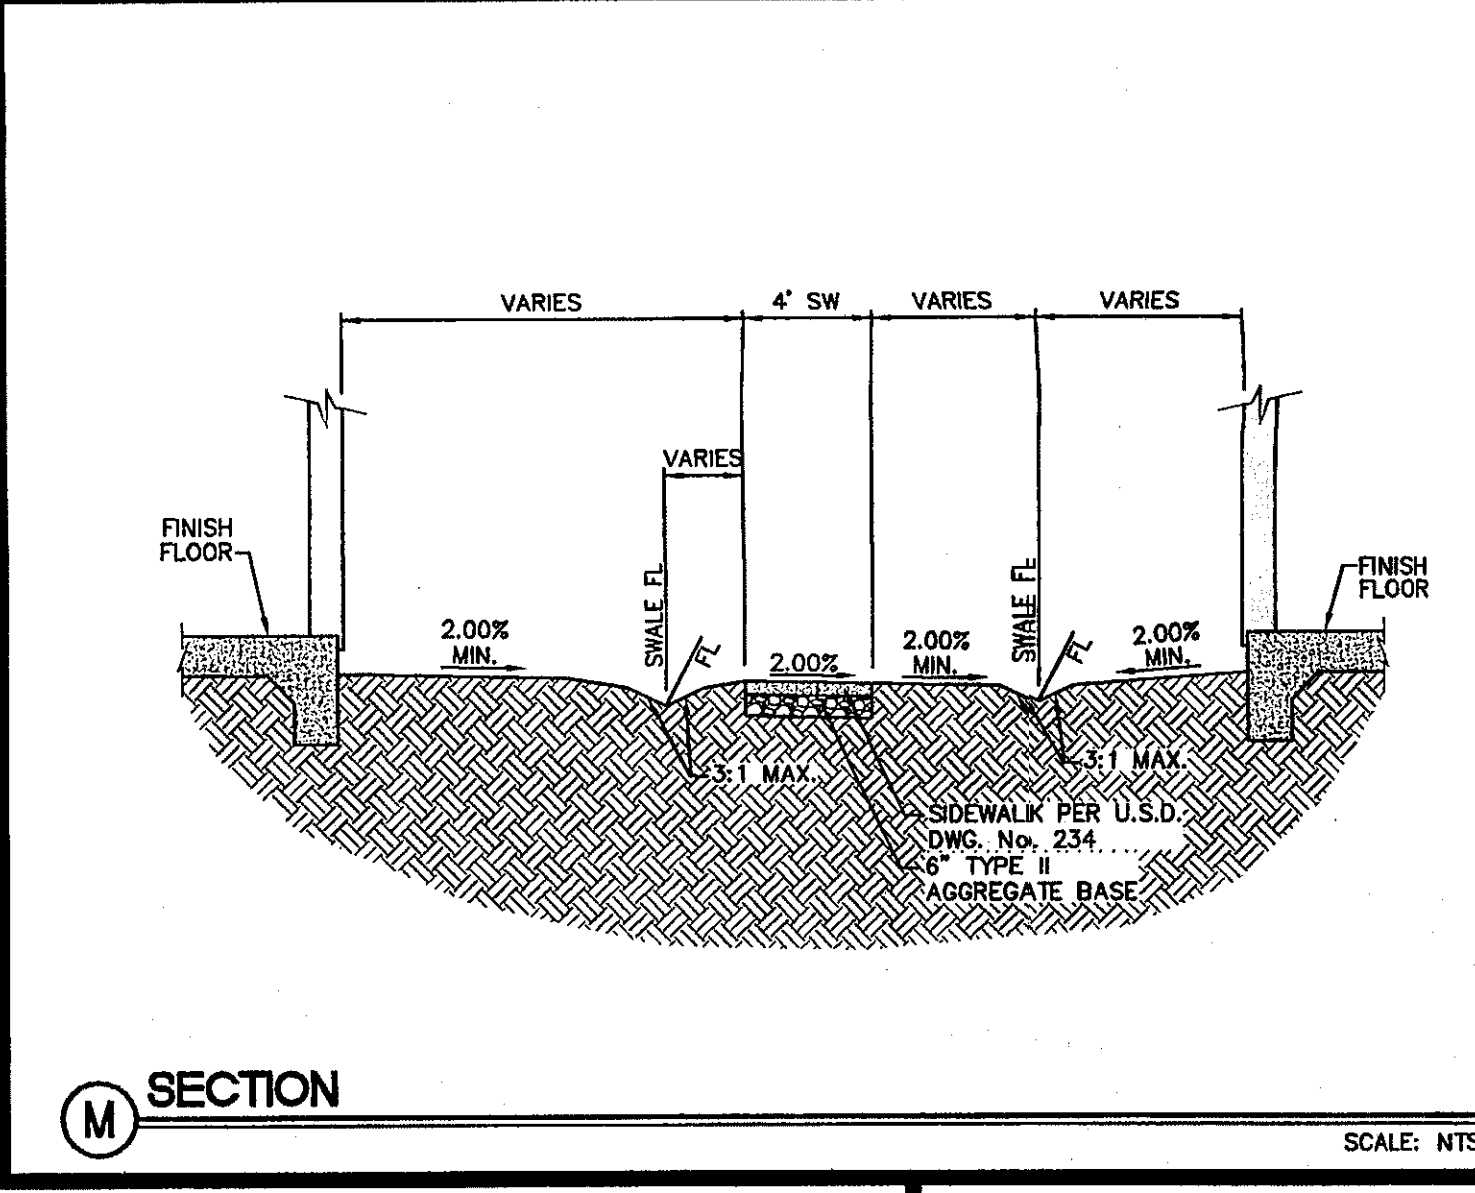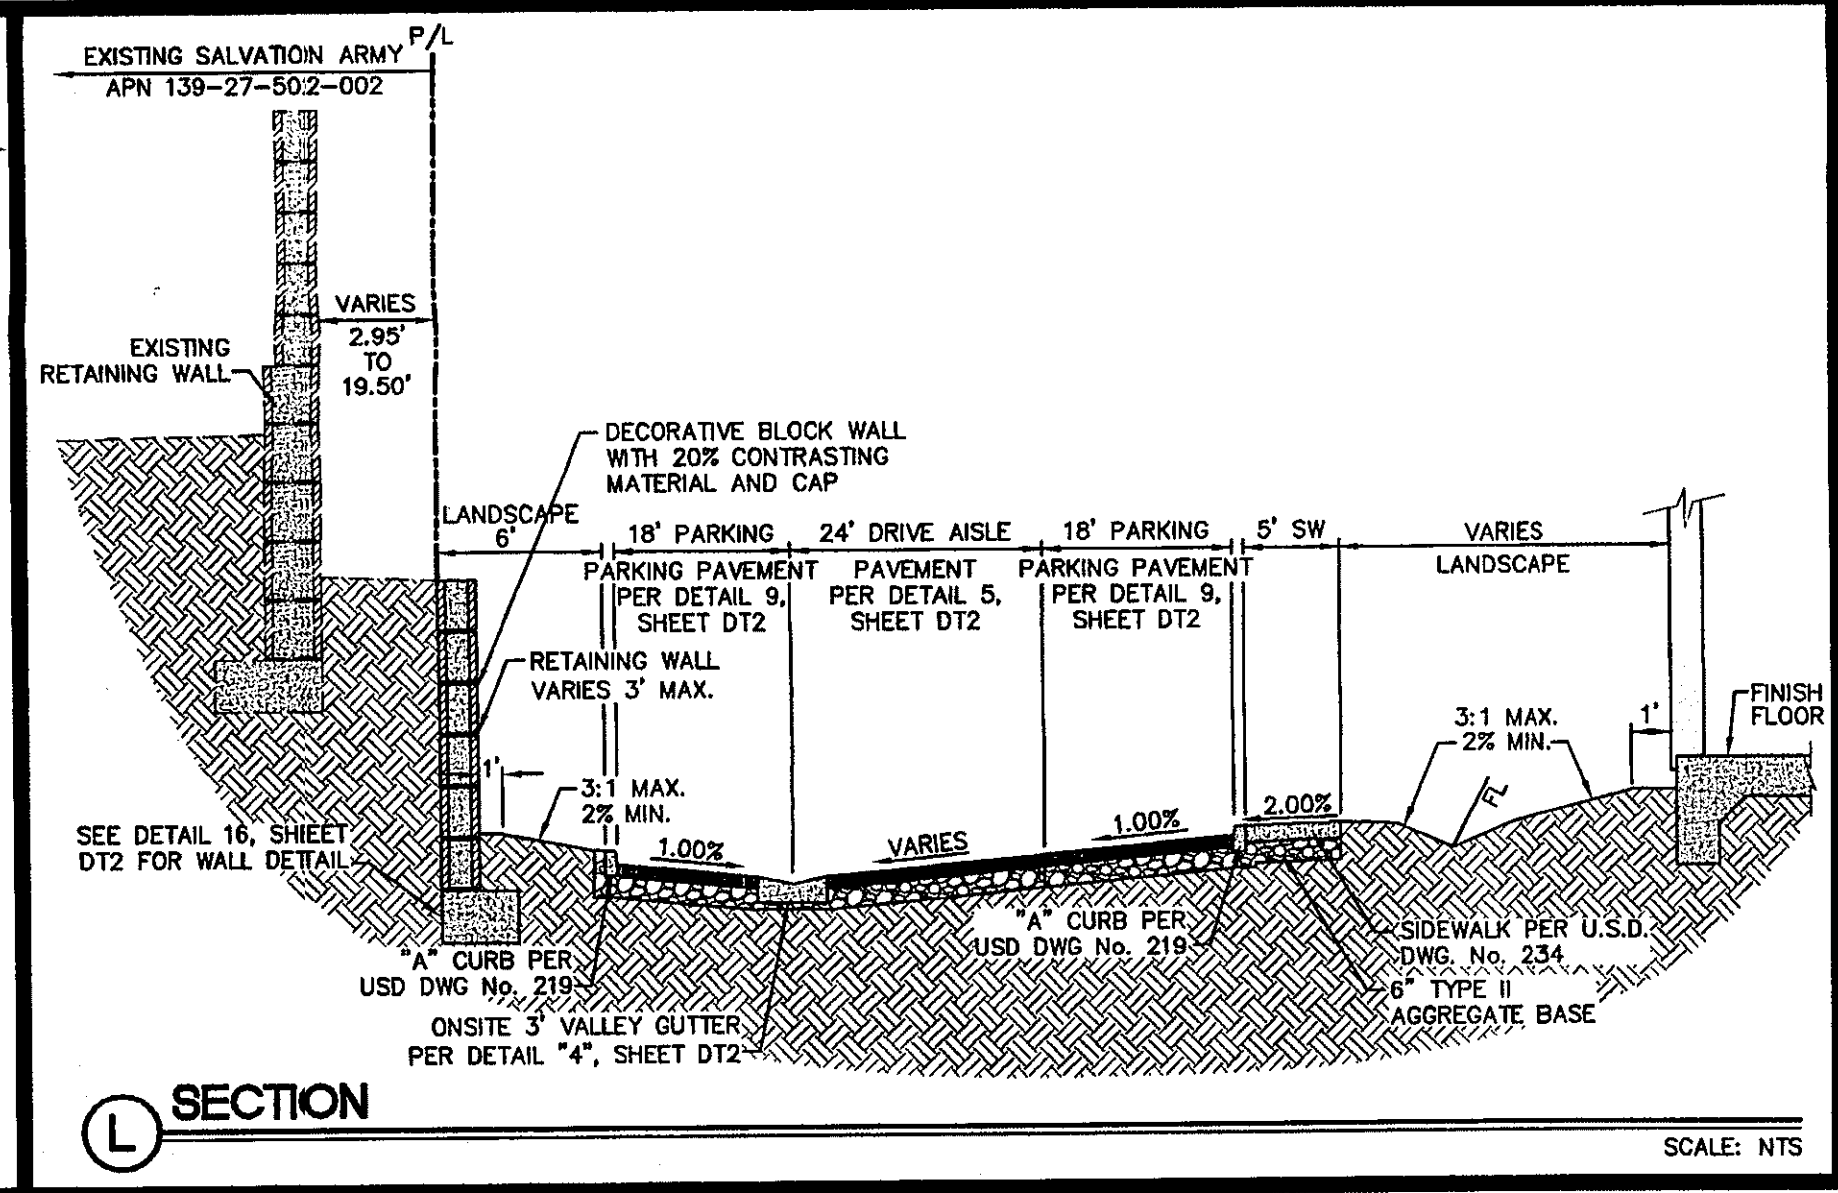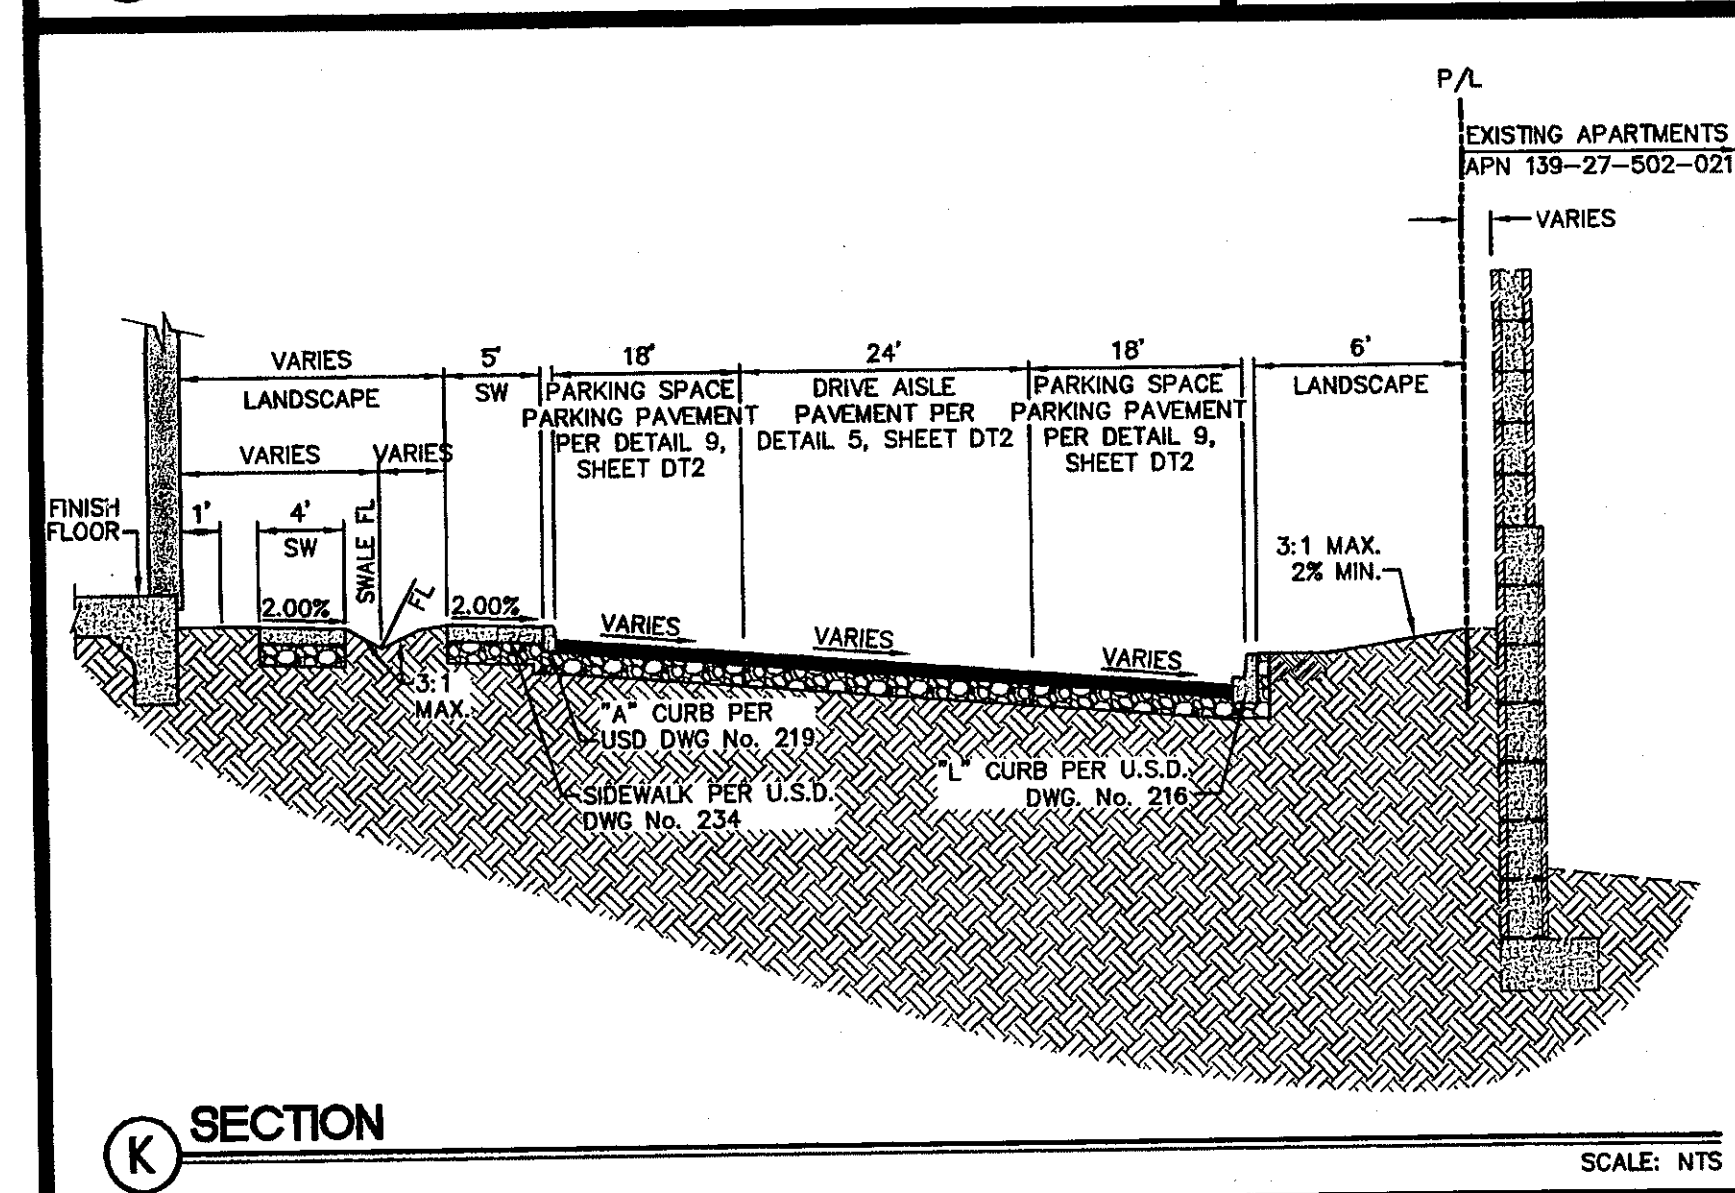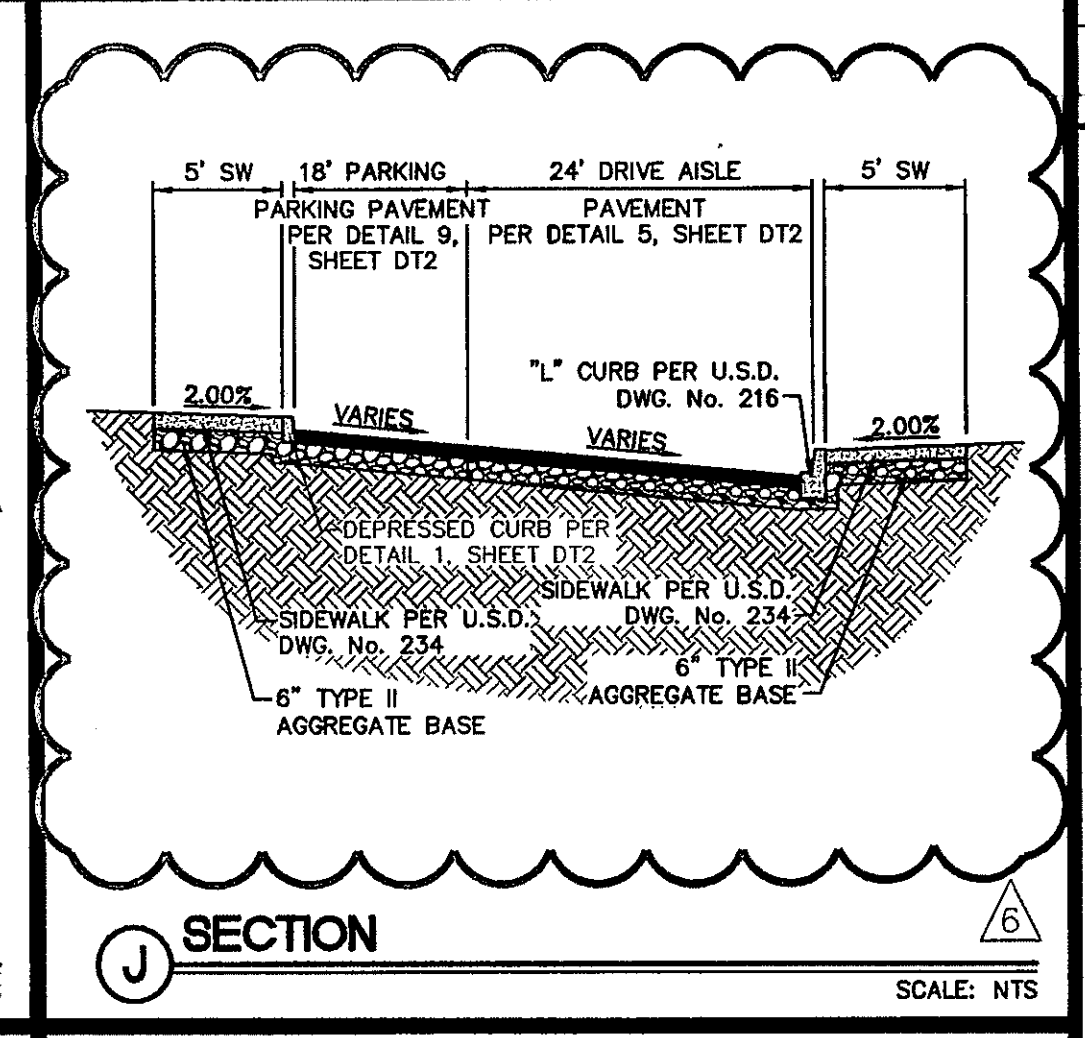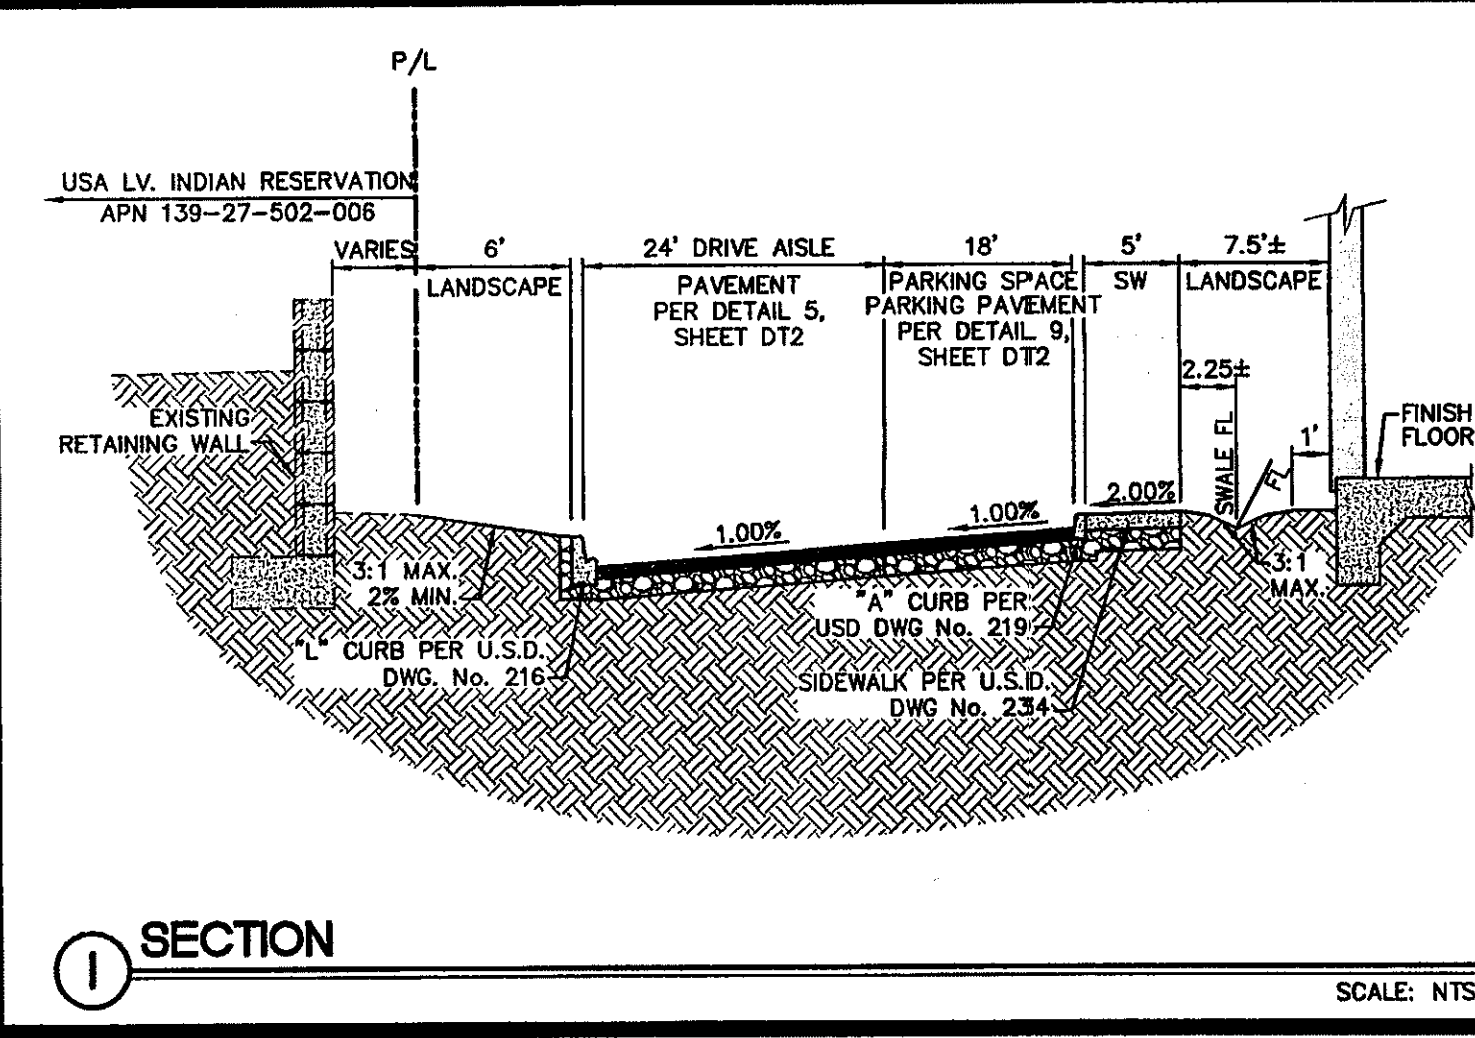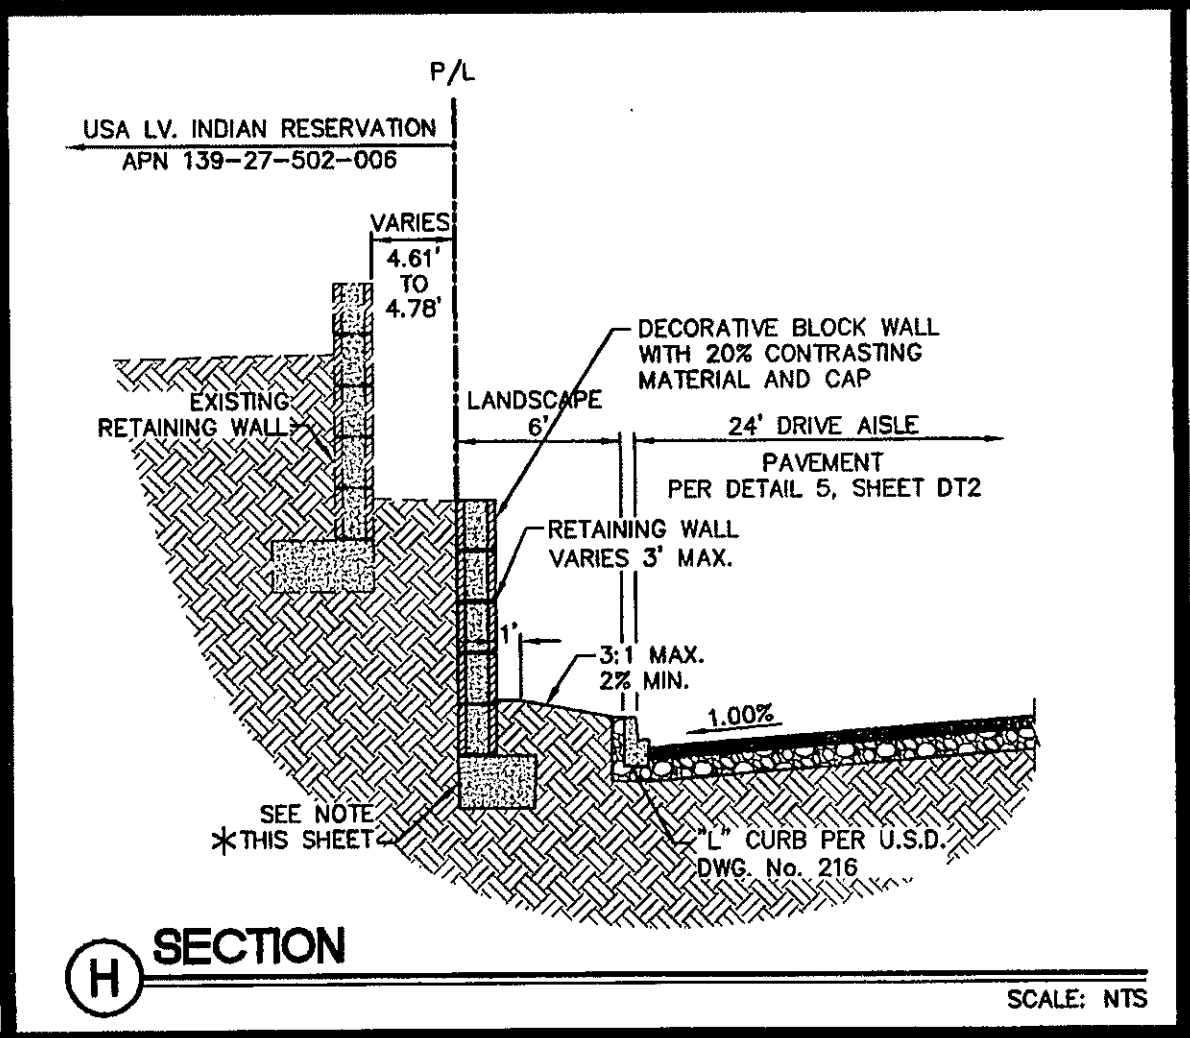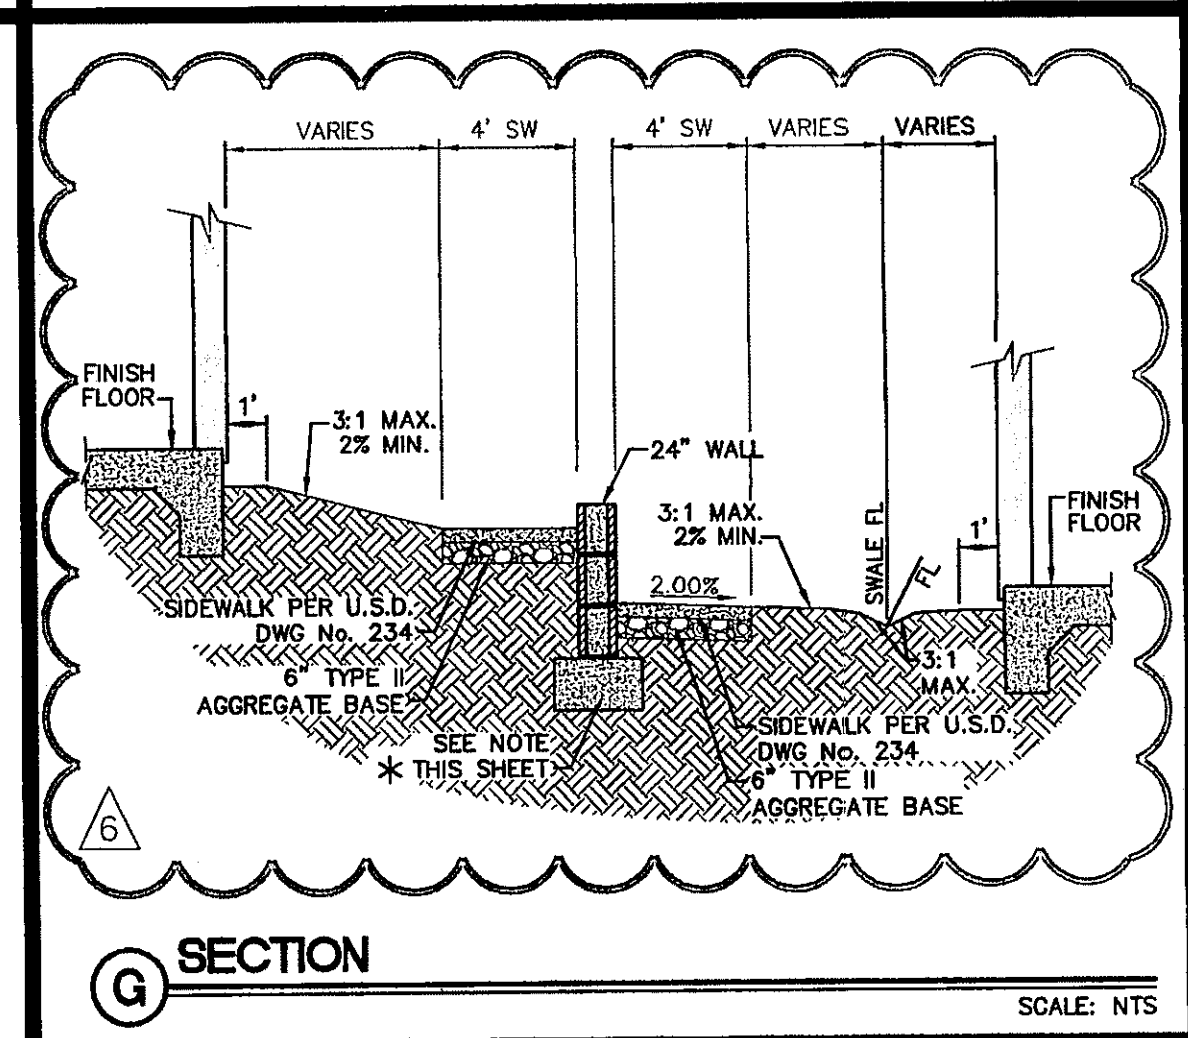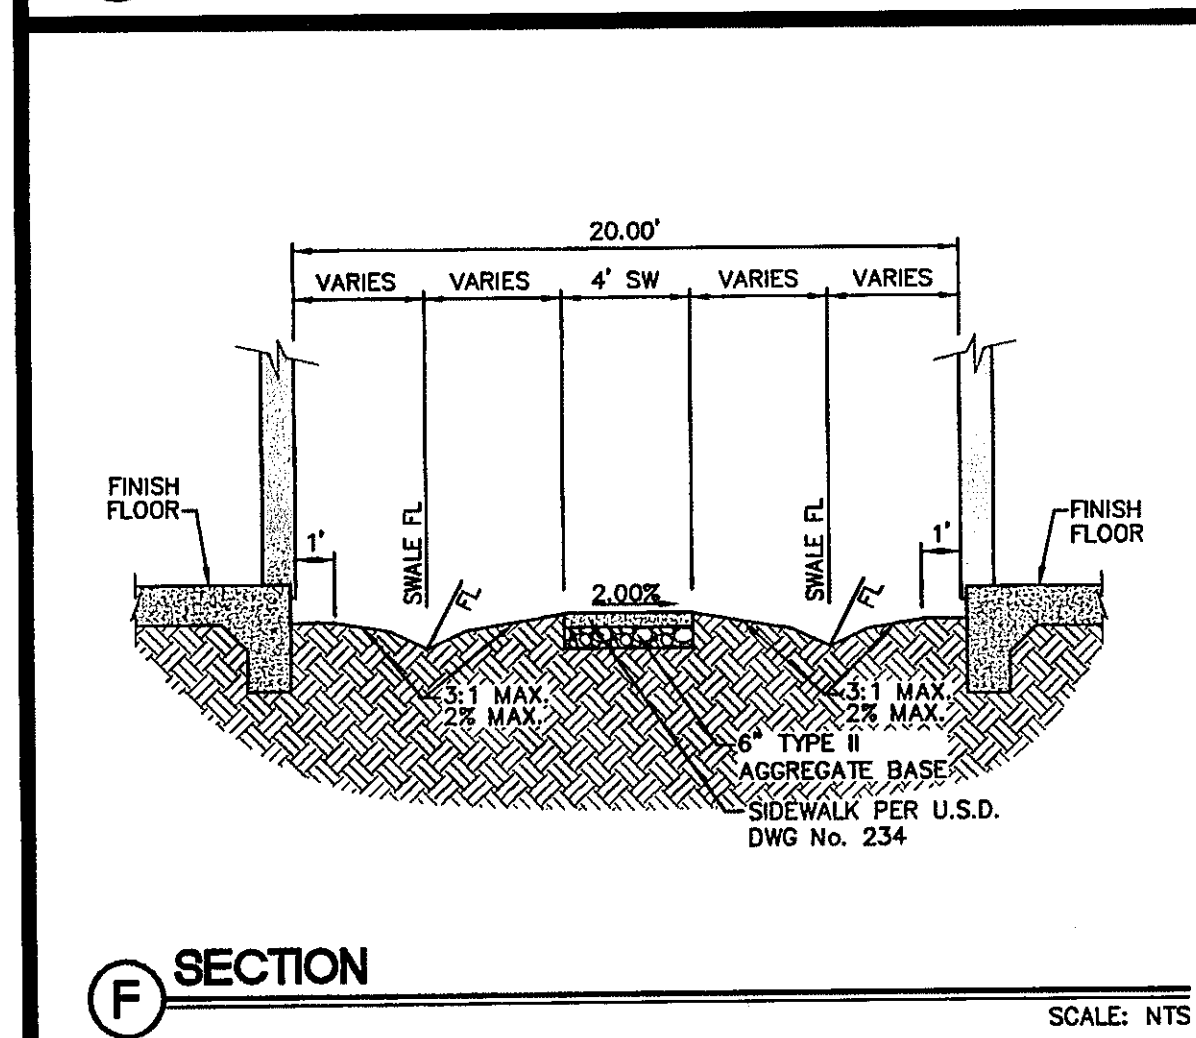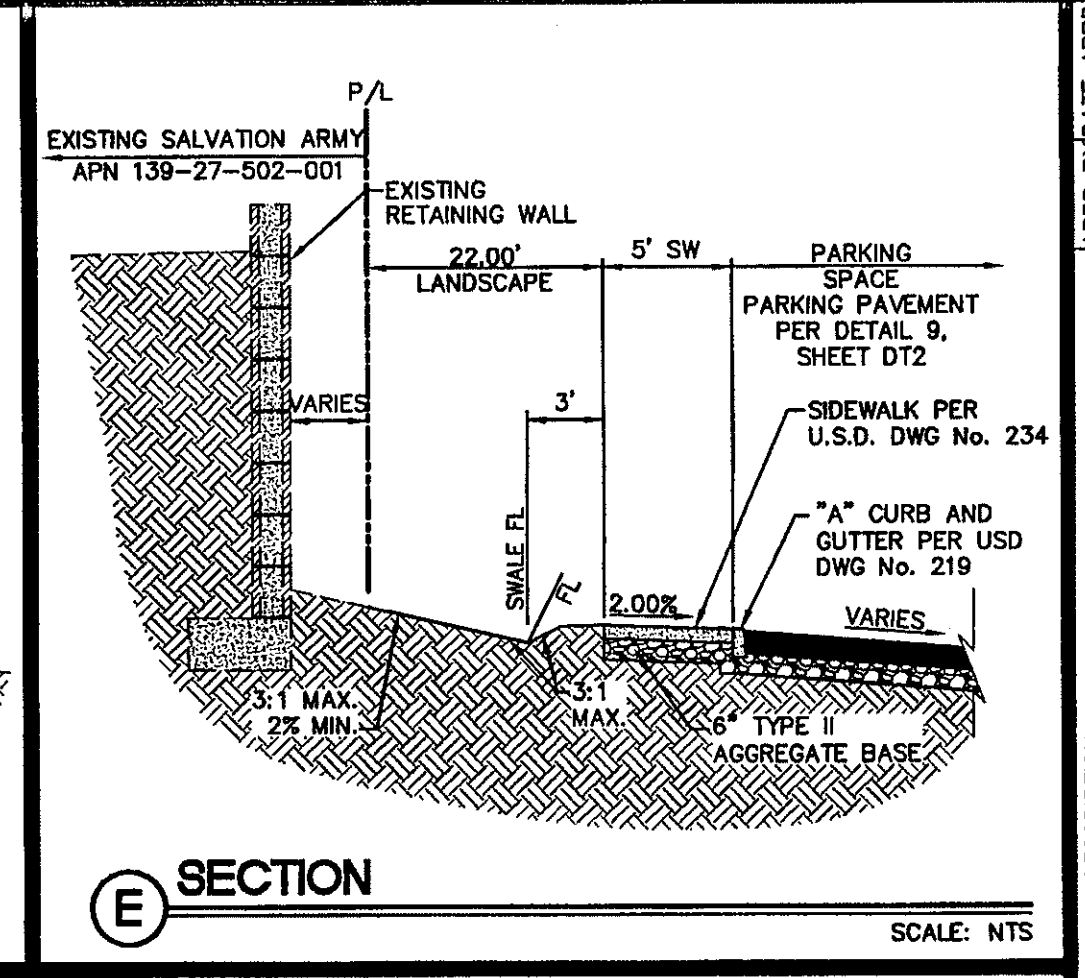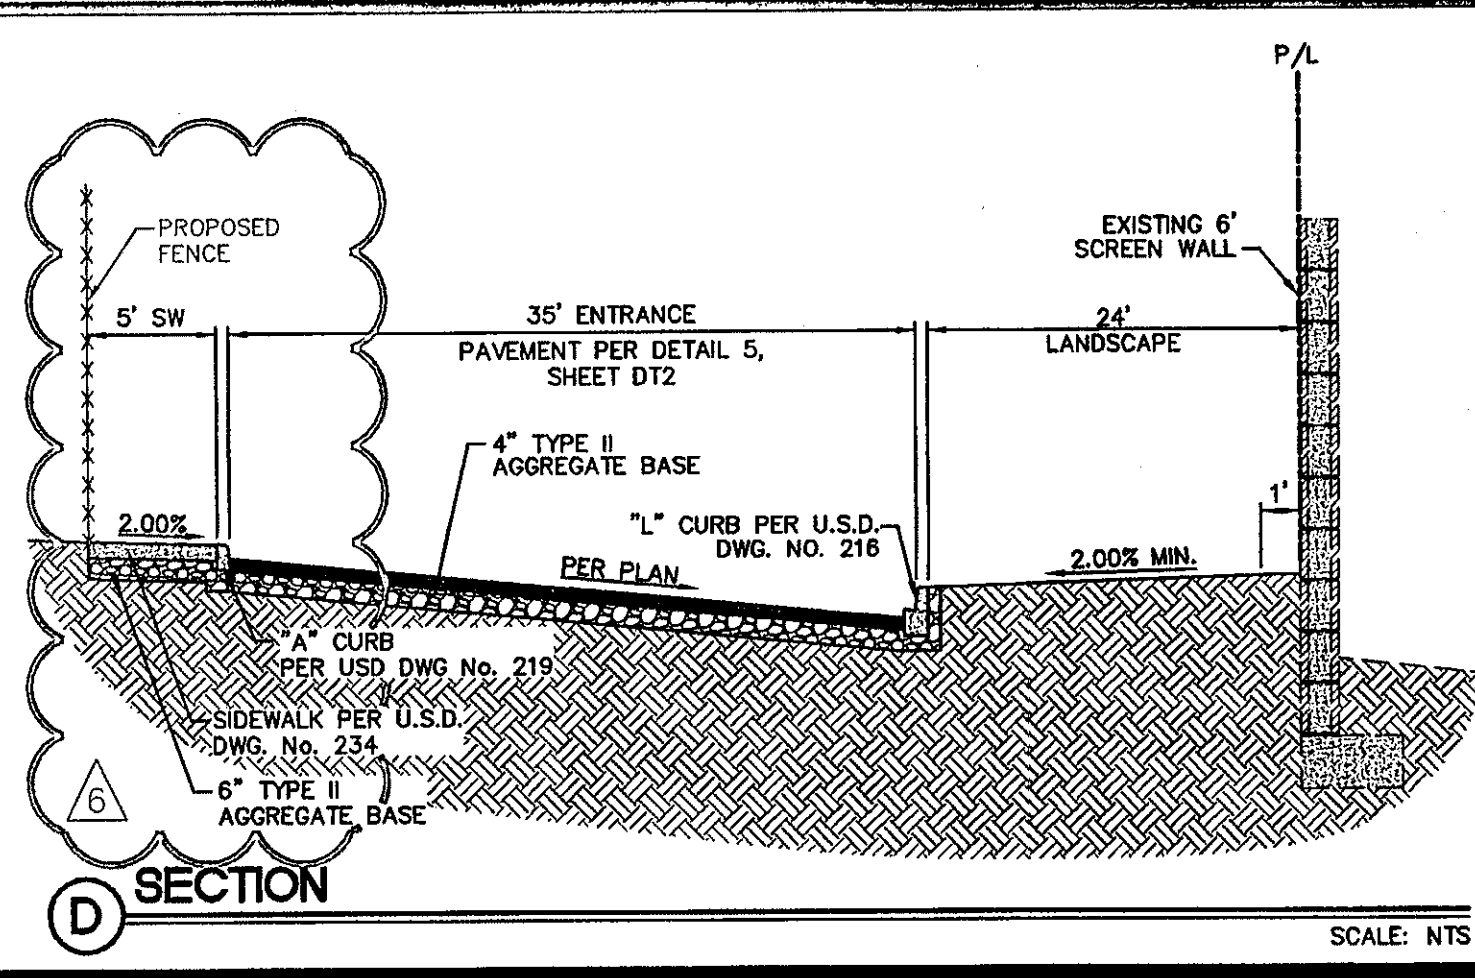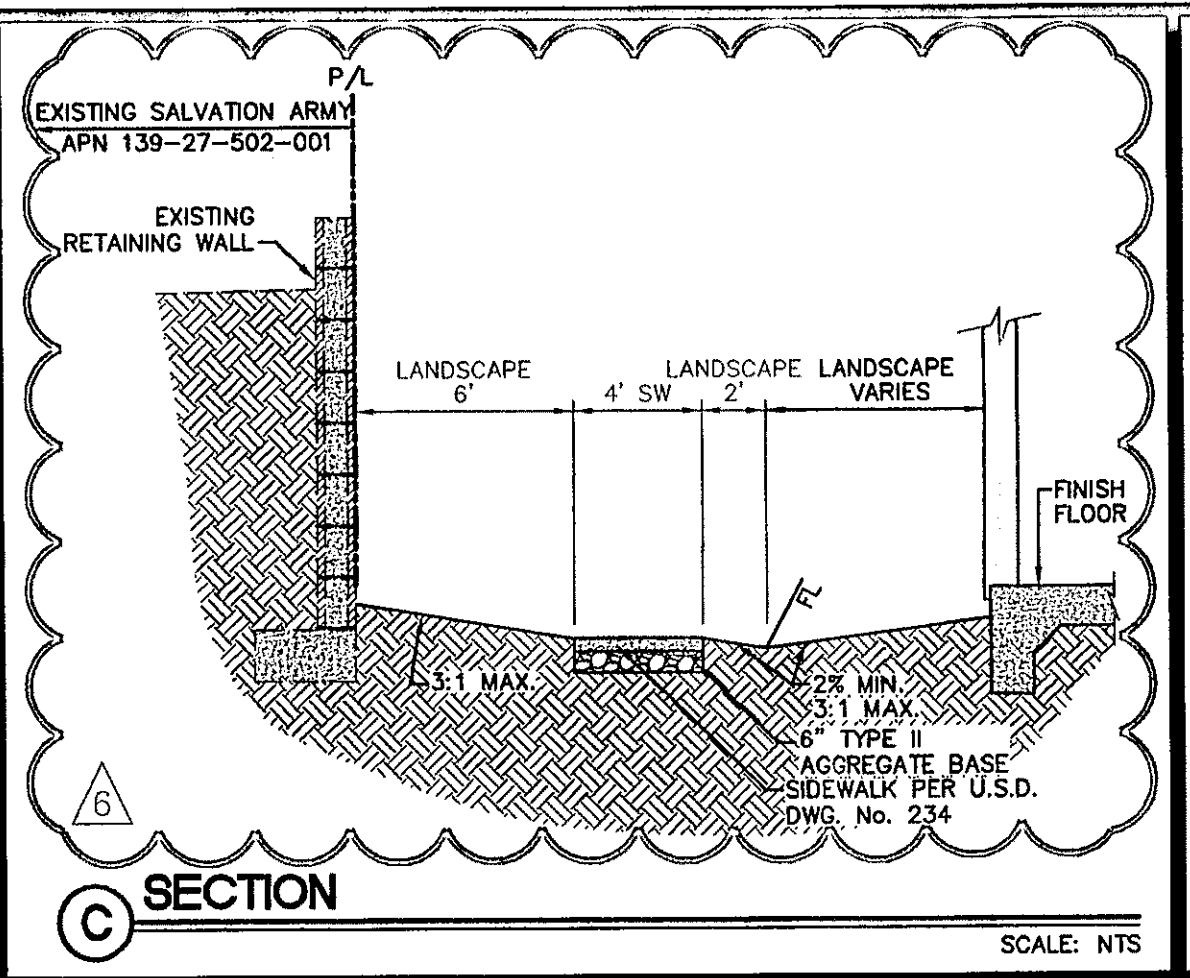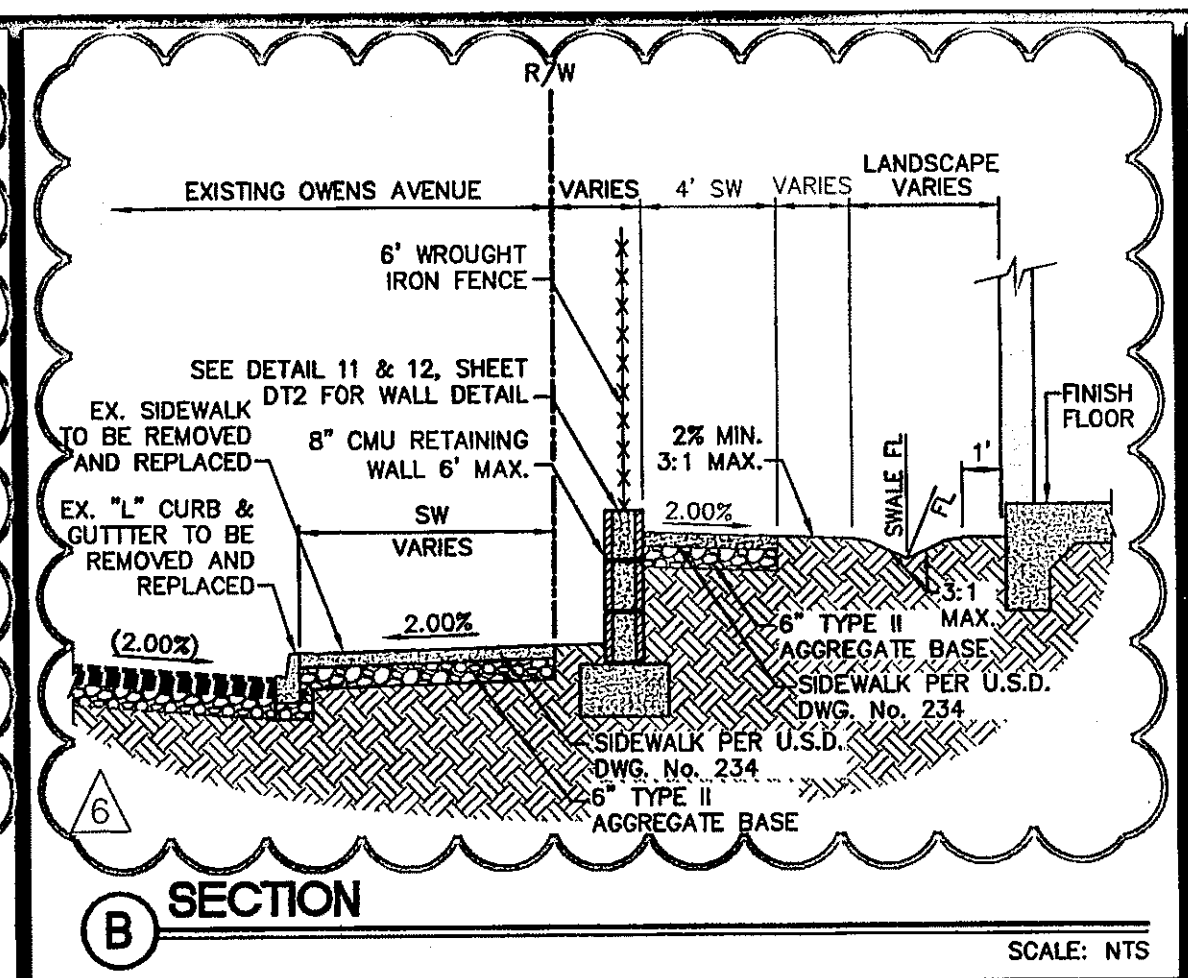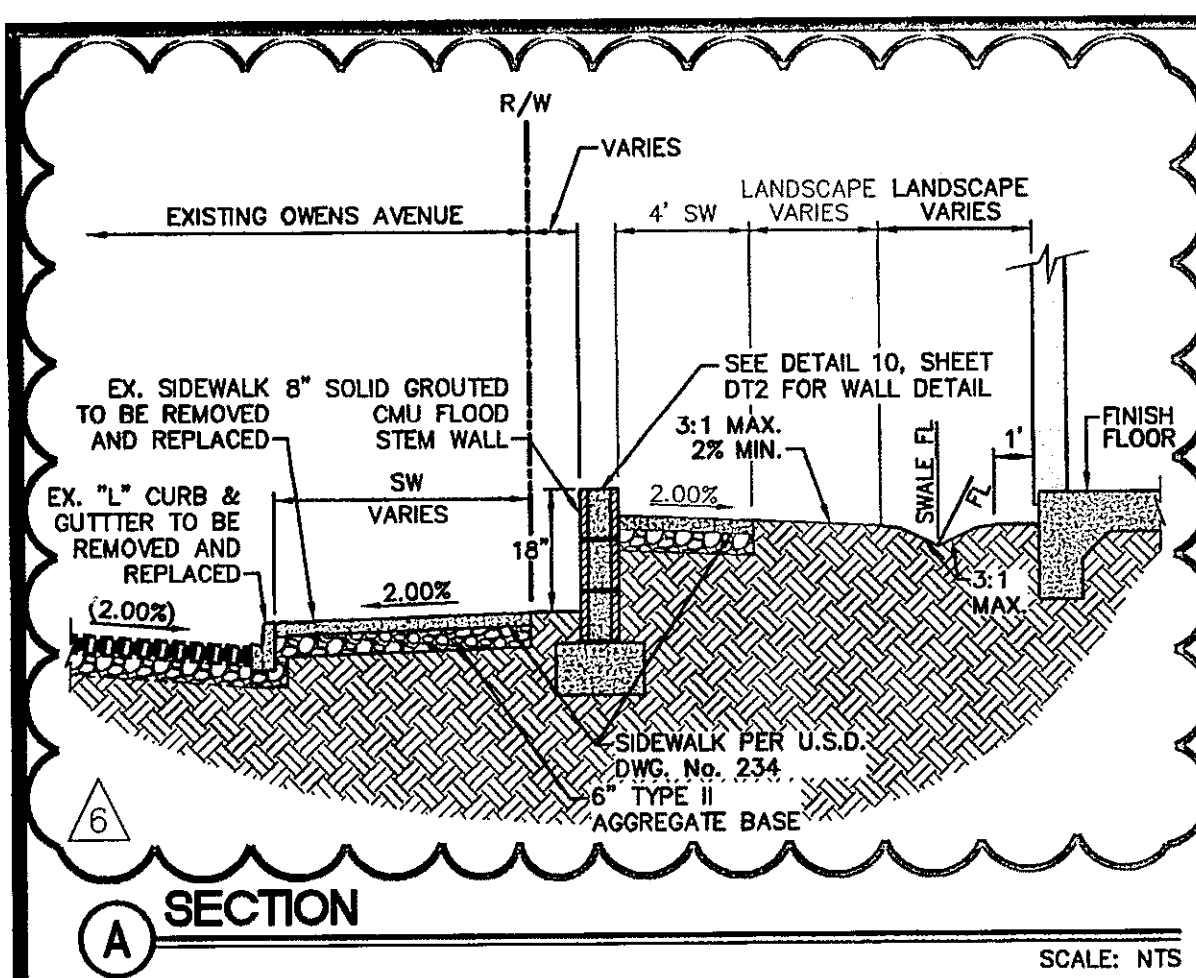

NEVADA HAND.
295 EAST WARM SPRINGS ROAD, SUITE 101
LAS VEGAS, NEVADA 89119-4312
PHONE (702) 739-3345 FAX (702) 739-3305

L.R. NELSON CONSULTING ENGINEERS, INC.
6765 West Russell Road Suite 200
Las Vegas, NV 89118
PHONE (702) 798-7978 FAX (702) 451-2286

SKY VIEW PINES FAMILY APARTMENTS
NEVADA HAND
CITY OF LAS VEGAS

DETAILS SHEET 1

SOILS REPORT
GEOTECH, INC. - NEVADA
DATED MARCH 26, 2009
PROJECT No. 9346-LV6

REVISIONS

NO.	DATE	DESCRIPTION
1	03/26/09	ISSUED FOR PERMITS

PROFESSIONAL ENGINEER - STATE OF NEVADA
JAMES A. YANCEY
EXP. 6-30-12
CIVIL
No. 18109

SHEET
DT1
9 OF 13 SHEETS
CLV DRAWING NO.