

DS #: 3656

APN: 125-17-702-002

PROJECT: Village of Centennial Springs - Update #12 Brownstones

SUBMITTAL: 18th

SCANNED BY/DATE:

CHECKED BY/DATE:





CITY OF LAS VEGAS			DATE:
INTER-OFFICE MEMORANDUM			July 9, 2014 <i>AMS</i>
TO: Land Development Services Department of Public Works			FROM: Albert Sung, P.E. Flood Control Project Engineer Department of Public Works
SUBJECT: Technical Drainage Study for: Village of Centennial Springs – Update #12 Brownstones			COPIES TO: Preator Consulting
Cross Streets:	SWC of Tule Springs & El Capitan (Farm)		CVL Nevada
File Number:	F:\#Depot\DSMEMOS\DS3656T.doc		Bart Anderson, P.E., DevCo
Parcel Number:	125-17-702-002		
Zoning Action:	N/A		
FEMA Flood Zone	YES	NO X	
Proposed Storm Drain	YES X	NO	

HISTORY	DATE RECEIVED	DATE REVIEWED	COMMENTS	REVIEW FEES	FEES PAID Trn. No.
1 st Submittal	9/23/2004	10/06/2004	Not Approved	\$400.00	9950: \$400
2 nd Submittal	11/24/2004	12/8/2004	Not Approved	\$400.00	12699: \$400
3 rd Submittal	12/21/2004	1/4/2005	Conditional Approval	\$400.00	13952: \$400
4 th Submittal	3/29/2005 & 5/2/2005	5/3/2005	Approved	\$400.00	18998: \$400
Revision	5/5/2005	5/6/2005	Approved	N/C	N/C
5 th Submittal	6/1/2005	6/2/2005	Approved	\$400.00	22960: \$400
6 th Submittal	8/15/2005	8/19/2005	Approved	\$100.00	27750: \$100
7 th Submittal	9/16/2005	9/29/2005	Not Approved	\$400.00	29833: \$400
8 th Submittal	10/24/2005	10/24/2005	Approved	N/C	N/C
Revision	11/9/2005	11/9/2005	Approved	N/C	N/C
9 th Submittal	11/10/2005	11/21/2005	Approved	\$100.00	33246: \$100
10 th Submittal	2/10/2006 & 3/1/2006	3/6/2006	Approved	\$400.00	38542: \$400
11 th Submittal	3/9/2006	3/23/2006	Approved	\$400.00	40223: \$400
12 th Submittal	6/28/2006	7/19/2006	Approved	\$400.00	Paid: \$400
13 th Submittal	9/28/2006, 12/6/2006 & 12/22/2006	1/3/2007	Approved	\$400.00	54968: \$400
14 th Submittal	12/6/2006 & 12/22/2006	1/3/2007	Approved	\$100.00	58987: \$100
15 th Submittal	3/30/2007	4/13/2007	Approved	\$100.00	66108: \$100
16 th Submittal	3/4/2009	3/13/2009	Approved	\$100.00	116422: \$100
17 th Submittal	12/19/2011	12/21/2011	Approved	\$400.00	269273: \$400
18 th Submittal	7/9/2014	7/9/2014	See Comments Below	\$400.00	362879: \$400
TOTAL FEES (LDDRS):				\$5,300.00	----

REMARKS:

18th Submittal: Update #12 to Re-Vitalize the construction plans of Brownstones

17th Submittal: Revise F.F. Elevation of Lot 69 in Unit 4

16th Submittal: Update #10 to revise architectural elevations of houses in Unit 1 to Unit 5 and Re-Validate the drainage study

15th Submittal: Update #9 for Minor Parking-Lot Layout Revision in the Mixed-Use Portion of the Village of Centennial Springs

14th Submittal: Update #8 to revise Glider Ridge Street to a cross-fall section

13th Submittal: Update #7 to replace a 48" pipe at Bellfry & Tule Springs with a 38"x60" Elliptical

12th Submittal: Update to adjust the finish floor elevations for Buildings 10 & 14 to 16

11th Submittal: Update to Raise the F.F. and to Adjust the lot lines of Lots 126-131. Also to relocate SDMH #2, DI #3 and DI #4 approximately 15' to the east

10th Submittal: Update to revise F.F. / street grading in Unit 4, Unit 5 and the Brownstones

9th Submittal: Update to revise offsite channel geometry along the west property line

7th & 8th Submittals: Update #3 and Supplement to change the Finish Floor Elevation of Buildings 1 & 2 and Additional Building in Park Only

6th Submittal: Update #2 to revise the size of storm drain in Tule Springs Road

5th Submittal: Update #1 to adjust the finish floor elevations from Lot 126 through Lot 131

The Drainage Study for the subject project has been reviewed and:

X	is approved subject to conformance to all City standards and the following conditions:
	must be resubmitted or supplemented including the following:
	is conditionally approved subject to Clark County Regional Flood Control District concurrence.
	is conditionally approved subject to Nevada Department of Transportation (NDOT) concurrence

NOTE: Any future changes to the proposed design (or design assumptions) as outlined in the approved drainage study and attached preliminary grading plan which affect drainage must be addressed in a Drainage Study Amendment and accepted by the City of Las Vegas Flood Control Section. Additionally, conditional acceptance of a drainage study is valid for a period of one (1) year. If the proposed construction has not been completed in that time period, the City of Las Vegas reserves the right to require additional conditions and/or submission and acceptance of a complete drainage study update prior to further construction of a project.

NOTE: Please be advised that all land surface area disturbances over 1 acre or any area adjacent to a water way must submit to the Nevada Division of Environmental Protection a "Notice of Intent" to discharge that certifies a stormwater pollution prevention plan has been developed and is maintained on site; for inclusion in the Stormwater General Permit No. NVR100000. A phased construction unit in a contiguous subdivision is considered under construction until all stripped or disturbed surface areas have been covered by paving, building construction or planting. For more information, including forms and applications see <http://ndep.nv.gov/bwpc/storm01.htm> or call (775) 687-9429.

END OF REMARKS
B&H/PBJ/ays

T/R/S: T19S/R60E/17
AREA G-17

 *** FAX TX REPORT ***

TRANSMISSION OK

JOB NO. 4096
 DESTINATION ADDRESS 7025644082
 PSWD/SUBADDRESS
 DESTINATION ID
 ST. TIME 07/09 17:19
 USAGE T 01' 36
 PGS. 2
 RESULT OK

CITY OF LAS VEGAS INTER-OFFICE MEMORANDUM

DATE:

July 9, 2014

TO:

Land Development Services
 Department of Public Works

FROM:

Albert Sung, P.E.
 Flood Control Project Engineer
 Department of Public Works

SUBJECT:

Technical Drainage Study for:
 Village of Centennial Springs – Update #12 Brownstones

COPIES TO:

Preator Consulting

Cross Streets:

SWC of Tule Springs & El Capitan (Farm)

CVL Nevada

File Number:

F:\#Depot\DSMEMOS\DS3656T.doc

Bart Anderson, P.E., DevCo

Parcel Number:

125-17-702-002

Zoning Action:

N/A

FEMA Flood Zone

YES

NO

X

Proposed Storm Drain

YES

X

NO

HISTORY	DATE RECEIVED	DATE REVIEWED	COMMENTS	REVIEW FEES	FEES PAID Trn. No.
1 st Submittal	9/23/2004	10/06/2004	Not Approved	\$400.00	9950: \$400
2 nd Submittal	11/24/2004	12/8/2004	Not Approved	\$400.00	12699: \$400
3 rd Submittal	12/21/2004	1/4/2005	Conditional Approval	\$400.00	13952: \$400
4 th Submittal	3/29/2005 & 5/2/2005	5/3/2005	Approved	\$400.00	18998: \$400
Revision	5/5/2005	5/6/2005	Approved	N/C	N/C
5 th Submittal	6/1/2005	6/2/2005	Approved	\$400.00	22960: \$400
6 th Submittal	8/15/2005	8/19/2005	Approved	\$100.00	27750: \$100
7 th Submittal	9/16/2005	9/29/2005	Not Approved	\$400.00	29833: \$400
8 th Submittal	10/24/2005	10/24/2005	Approved	N/C	N/C
Revision	11/9/2005	11/9/2005	Approved	N/C	N/C
9 th Submittal	11/10/2005	11/21/2005	Approved	\$100.00	33246: \$100
10 th Submittal	2/10/2006 & 3/1/2006	3/6/2006	Approved	\$400.00	38542: \$400
11 th Submittal	3/9/2006	3/23/2006	Approved	\$400.00	40223: \$400
12 th Submittal	6/28/2006	7/19/2006	Approved	\$400.00	Paid: \$400
13 th Submittal	9/28/2006, 12/6/2006 & 12/22/2006	1/3/2007	Approved	\$400.00	54968: \$400
14 th Submittal	12/6/2006 & 12/22/2006	1/3/2007	Approved	\$100.00	58987: \$100
15 th Submittal	3/30/2007	4/13/2007	Approved	\$100.00	66108: \$100
16 th Submittal	3/4/2009	3/13/2009	Approved	\$100.00	116422: \$100
17 th Submittal	12/19/2011	12/21/2011	Approved	\$400.00	269273: \$400



1012 Silver Retreat Ct
Henderson, NV 89002
Tel: (702) 606-7613
Fax: (702) 564-4082

Reid: 7/9/14
DS 3656-12
6-17
\$400-

June 25, 2014

Albert Sung
Flood Control
City of Las Vegas Dept of Public Works
Development Services Center
333 N. Rancho Drive, 7th Floor
Las Vegas, NV 89106

**RE: VILLAGE OF CENTENNIAL SPRINGS BROWNSTONES
DRAIANGE STUDY UPDATE LETTER
CLV HANSEN PROJECT: 53714**

Dear Mr. Sung;

We have reviewed the original approved drawings, the updated drawings, historical aerial photographs, and the original drainage study as prepared by the Keith Companies for this project. We have found no discrepancies in the information, and take no objections to the findings of the Keith Companies study. It is noted that the current plans for the project are being prepared by CVL Nevada.


The area around the development has experienced very little change in the intervening years. The site is protected by the US95 and Durango corridors. The contributing watershed appears to have had no noticeable development or changes in permeable surfaces.

It is our engineering opinion that the flows depicted in the original technical drainage study as well as the findings and recommendations, remain valid. Also, no changes are required in finished floor elevations, street grades or drainage catchment.

Please feel free to contact me at 606-7613 with any questions you may have concerning this project.

Sincerely,
Preator Consulting, LLC
Lazell H. Preator, PE
Chief Engineer

Attachment (0)

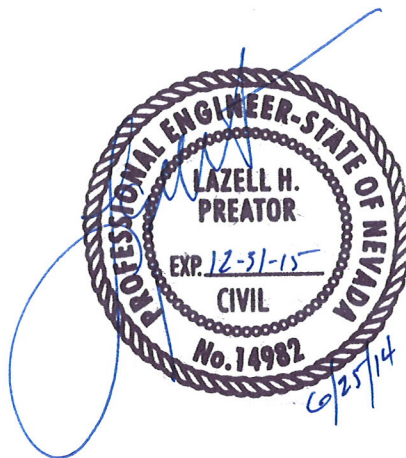

CITY OF LAS VEGAS GRADING NOTES

1. IN THE EVENT THAT ANY UNFORESEEN CONDITIONS NOT COVERED BY THESE NOTES ARE ENCOUNTERED DURING GRADING OPERATIONS, THE OWNER/ENGINEER SHALL BE IMMEDIATELY NOTIFIED FOR DIRECTION.
2. IT SHALL BE THE RESPONSIBILITY OF THE CONTRACTOR TO PERFORM ALL NECESSARY CUTS AND FILLS WITHIN THE LIMITS OF THIS PROJECT AND THE RELATED OFF-SITE WORK, SO AS TO GENERATE THE DESIRED SUBGRADE, FINISH GRADES AND SLOPES SHOWN.
3. CONTRACTOR SHALL TAKE FULL RESPONSIBILITY FOR ALL EXCAVATION. ADEQUATE SHORING SHALL BE DESIGNED AND PROVIDED BY THE CONTRACTOR TO PREVENT UNDERMINING OF ANY ADJACENT FEATURES OR FACILITIES AND/OR CAVING OF THE EXCAVATION.
4. THE CONTRACTOR IS WARNED THAT AN EARTHWORK BALANCE WAS NOT NECESSARILY THE INTENT OF THIS PROJECT. ANY ADDITIONAL MATERIAL REQUIRED OR LEFTOVER MATERIAL FOLLOWING EARTHWORK OPERATIONS BECOMES THE RESPONSIBILITY OF THE CONTRACTOR.
5. THE GRADING CONTRACTOR IS RESPONSIBLE TO COORDINATE WITH THE OWNER TO PROVIDE FOR THE REQUIREMENTS OF THE PROJECT STORM WATER POLLUTION PREVENTION PLAN (SWPPP) AND ASSOCIATED PERMIT.
6. CONTRACTOR SHALL GRADE TO THE LINES AND ELEVATIONS SHOWN ON THE PLANS WITHIN THE FOLLOWING HORIZONTAL AND VERTICAL TOLERANCES AND DEGREES OF COMPACTION, IN THE AREAS INDICATED:

	HORIZONTAL	VERTICAL	COMPACTION
A. PAVEMENT AREA SUBGRADE	0.1"	+0.0' TO -0.1'	SEE SOILS REPORT
B. ENGINEERED FILL	0.5"	+0.1' TO -0.1'	SEE SOILS REPORT
- COMPACTION TESTING WILL BE PERFORMED BY THE OWNER OR HIS REPRESENTATIVE. COMPACTION SHALL COMPLY WITH THE REQUIREMENTS OF THE ENGINEER.
7. ALL CUT AND FILL SLOPES SHALL BE PROTECTED UNTIL EFFECTIVE EROSION CONTROL HAS BEEN ESTABLISHED.
8. THE USE OF POTABLE WATER WITHOUT A SPECIAL PERMIT FOR BUILDING OR CONSTRUCTION PURPOSES INCLUDING CONSOLIDATION OF BACKFILL OR DUST CONTROL IS PROHIBITED. THE CONTRACTOR SHALL OBTAIN ALL NECESSARY PERMITS FOR CONSTRUCTION WATER.
9. THE CONTRACTOR SHALL MAINTAIN THE STREETS, SIDEWALKS AND ALL OTHER PUBLIC RIGHT-OF-WAY IN A CLEAN, SAFE AND USABLE CONDITION. ALL SPILLS OF SOIL, ROCK OR CONSTRUCTION DEBRIS SHALL BE PROMPTLY REMOVED FROM THE PUBLICLY OWNED PROPERTY DURING CONSTRUCTION AND UPON COMPLETION OF THE PROJECT. ALL ADJACENT PROPERTY, PRIVATE OR PUBLIC SHALL BE MAINTAINED IN A CLEAN, SAFE AND USABLE CONDITION.
10. IN THE EVENT THAT ANY TEMPORARY CONSTRUCTION ITEM IS REQUIRED THAT IS NOT SHOWN ON THESE DRAWINGS, SUCH ITEM SHALL BE PROVIDED, AS DIRECTED BY THE CITY ENGINEER, AT NO EXPENSE TO THE CITY OF LAS VEGAS. TEMPORARY CONSTRUCTION INCLUDES DITCHES, BERM, ROAD SIGNS AND BARRICADES, ETC.

REVISED 4/15/10

CITY OF LAS VEGAS SEWER NOTES

1. ALL CONSTRUCTION AND MATERIALS SHALL BE IN ACCORDANCE WITH THE LATEST EDITION OF THE DESIGN AND CONSTRUCTION STANDARDS FOR WASTEWATER COLLECTION SYSTEMS AND THE UNIFORM STANDARD SPECIFICATIONS FOR PUBLIC WORKS' CONSTRUCTION OFF-SITE IMPROVEMENTS, CLARK COUNTY AREA, NEVADA, AS AMENDED. IT WILL BE THE RESPONSIBILITY OF THE CONTRACTOR TO BE AWARE OF THE CONTENTS OF THE ABOVE SPECIFICATIONS.
2. IT SHALL BE THE CONTRACTOR'S RESPONSIBILITY TO PERFORM CONSTRUCTION AS PER PLANS. ANY ADDITIONS, DELETIONS, OR CHANGES SHALL FIRST MEET WITH THE APPROVAL OF THE CITY ENGINEER.
3. CHASEL "S" OR "O" IN CURBS WHERE SEWER OR GAS LATERALS PASS UNDER THE CURB.
4. POLYVINY (PVC) SEWER PIPE SHALL MEET ASTM D-3034 SDR 35 SPECIFICATIONS, INSTALLED WITH SAND BEDDING AND BACKFILL OF TYPE II AGGREGATE BASE.
5. ALL MANHOLES PAVED IN STREETS EIGHTY (80') FOOT R/W AND LARGER SHALL HAVE CONCRETE COLLARS. STREETS LESS THAN EIGHTY (80') FOOT R/W WILL REQUIRE REINFORCED IF PAVING DOES NOT CONFORM TO CITY STANDARDS AT THE MANHOLE.
6. TEE SADDLES SHALL BE USED TO CONNECT SEWER LATERALS TO EXISTING MAIN LINES UP TO TWELVE INCH (12") DIAMETER. CONNECTIONS TO FIFTEEN INCH (15") OR LARGER MAINS SHALL REQUIRE SPECIAL PROCEDURES. IN LINE "Y" S SHALL BE USED ON LINES TWELVE INCHES (12") OR ABOVE.
7. WATER MAINS SHALL BE PROTECTED IN ACCORDANCE WITH LVVWD STANDARDS WHENEVER A SEWER MAIN CROSSES OVER A WATER MAIN OR THE SEWER IS LESS THAN EIGHTEEN INCH (18") UNDER A WATER MAIN.
8. ALL CONTRACTORS INSTALLING SEWER MAINS THAT WILL BE UNDER THE JURISDICTION OF THE CITY OF LAS VEGAS MUST BE STATE OF NEVADA CLASS "A" CONTRACTORS.
9. THE CITY OF LAS VEGAS WILL NOT ACCEPT ANY SEWER MAINS WHICH HAVE A VERTICAL DEFLECTION OF MORE THAN ONE TENTH (0.1) OF A FOOT FROM THE APPROVED CONSTRUCTION PLANS AT ANY LOCATION. SEWER MAINS FOUND TO EXCEED THIS TOLERANCE WILL HAVE TO BE REPAIRED OR REMOVED OR REPLACED TO THE SATISFACTION OF THE CITY ENGINEER PRIOR TO ACCEPTANCE BY THE CITY OF LAS VEGAS.
10. INSTALLATION OF CURVED SEWER REQUIRES THE USE OF C-900 PIPE WHICH ALLOWS FOR PIPE DEFLECTION AT THE JOINTS.

REVISED 04/15/10

CITY OF LAS VEGAS STREETLIGHT NOTES

1. ALL STREET LIGHTING INSTALLATIONS SHALL BE IN ACCORDANCE WITH THE STREET LIGHTING PLANS, THE "UNIFORM STANDARD SPECIFICATIONS FOR PUBLIC WORKS CONSTRUCTION OFF-SITE IMPROVEMENTS, CLARK COUNTY AREA, NEVADA," LATEST REVISION, AND THE "UNIFORM STANDARD DRAWINGS FOR PUBLIC WORKS CONSTRUCTION OFF-SITE IMPROVEMENTS, CLARK COUNTY AREA, NEVADA," LATEST REVISION, AND ANY ADOPTED SPECIAL AREA STANDARDS.
2. NO DEVIATION OF STREET LIGHT, PULL BOX, CONDUITS (ETC.) LOCATIONS SHALL BE PERMITTED WITHOUT WRITTEN APPROVAL OF THE TRAFFIC ENGINEER AND THE CITY ENGINEER.
3. ALL EXISTING STREET LIGHTING SHALL REMAIN OPERATIONAL DURING CONSTRUCTION.
4. ALL STREET LIGHTING CONDUITS STUB SHALL HAVE AT LEAST ONE GREEN #8 THW WIRE INSTALLED, AS TRACER WIRE. WHEN "EMPTY" CONDUIT IS COMPLETELY INSTALLED FROM PB TO PB, IT SHALL HAVE MAXIMUM OF 2 #4 AND 1 #8 THW WIRE WITH THE ENDS TAPED OR "SAFE OFF" PRIOR TO FINAL INSPECTION.
5. ANY STRUCTURE SUCH AS BLOCK WALLS, CHAIN LINK FENCES, RETAINING WALLS, ETC., SHALL LEAVE A MINIMUM CLEARANCE IN ACCORDANCE WITH THE USD NO. 320A.
6. AS-BUILT DRAWINGS SHALL BE SUPPLIED TO THE TETO PRIOR TO ANY PRE-FINAL INSPECTION. THE AS-BUILT DRAWING NEEDS TO BE STAMPED AS-BUILT AND SIGNED BY THE PREPARER.
7. SERVICE POINT SHALL BE COORDINATED WITH NV ENERGY COMPANY, AND WHEREVER POSSIBLE, BE LOCATED NEAR THE CENTER OF THE CIRCUIT. SERVICE POINTS SHALL BE SHOWN ON THE PLANS.
8. IT SHALL BE ASSUMED THAT IN THE ABSENCE OF AN EXISTING, WORKABLE CIRCUIT TO ATTACH TO, ALL INSTALLATIONS SHALL REQUIRE A NEW SERVICE FOR OPERATION OF THE CIRCUIT.
9. WHEREVER THERE IS AN OVERHEAD UTILITY THAT MAY CONFLICT WITH THE INSTALLATION OF STREET LIGHTING CIRCUITS AND/OR POLES, THESE CONFLICTS MUST BE RESOLVED BETWEEN THE DEVELOPER AND THE UTILITIES INVOLVED, AT NO EXPENSE TO THE CITY OF LAS VEGAS, BEFORE STREETLIGHT BASES ARE INSTALLED.
10. THE CONTRACTOR SHALL FURNISH COMPLETE SERVICE TO TRANSFORMERS AND CONTROL SYSTEMS IF REQUIRED ON PLANS.
11. THE DEVELOPER/OWNER WILL BE REQUIRED TO SUPPLY POWER TO ALL NEW PUBLIC STREET LIGHTS INSTALLED UNDER THIS DESIGN PRIOR TO BOND RELEASE OR PROJECT COMPLETION. THE DEVELOPER/OWNER WILL BE RESPONSIBLE FOR ALL ITEMS ASSOCIATED WITH THE INSTALLATION, CONSTRUCTION, ENERGIZING, MAINTENANCE AND OPERATIONAL COST OF SAID STREET LIGHTS PRIOR TO PROJECT COMPLETION. REFER TO THE PLAN FOR ANY NEW SERVICE REQUIREMENTS. THE TRANSFER OF OWNERSHIP FROM THE DEVELOPER/OWNER TO THE CITY OF LAS VEGAS FOR ALL NEW PUBLIC STREET LIGHTS AND/OR SERVICE/S INSTALLED UNDER THIS DESIGN WILL BE IN CONJUNCTION WITH THIS PROJECT COMPLETION. COORDINATE ALL MAINTENANCE AND OPERATIONAL TRANSFERS WITH THE CITY OF LAS VEGAS TRAFFIC ENGINEERING DEPARTMENT (TETO) AT (702) 229-6331.

REVISED 04/15/10

QUANTITY TABLE

MARK	DESCRIPTION	PUBLIC	PRIVATE
①	CONSTRUCT "L" TYPE CURB & GUTTER PER CCAUSD #216	640 LF	384 LF
②	CONSTRUCT 8" CROSS-GUTTER PER CCAUSD #228	1621 LF	-
③	CONSTRUCT 4" SIDEWALK PER CCAUSD #234	2570 LF	-
④	CONSTRUCT SIDEWALK RAMP CASE II PER CCAUSD #235	4 EA.	-
⑤	CONSTRUCT SIDEWALK RAMP CASE I (1-SIDE ONLY) PER CCAUSD #235	1 EA.	-
⑥	DEPRESS CURB FOR FUTURE SIDEWALK RAMP PER CCAUSD #235	2 EA.	-
⑦	CONSTRUCT RETAINING WALL PER DETAIL J/DT-1	97 LF	-

CITY OF LAS VEGAS TRAFFIC NOTES

1. ALL CONSTRUCTION SIGNING, BARRICADING, AND TRAFFIC DELINEATION SHALL CONFORM TO THE "MANUAL ON UNIFORM TRAFFIC CONTROL DEVICES", LATEST EDITION.
2. THE STREET SIGN CONTRACTOR SHALL OBTAIN STREET NAMES AND BLOCK NUMBERING FROM THE PLANNING DEPARTMENT PRIOR TO CONSTRUCTION.
3. BEFORE ANY WORK IS STARTED IN THE RIGHT-OF-WAY, THE CONTRACTOR SHALL INSTALL ALL ADVANCED WARNING SIGNS FOR THE CONSTRUCTION ZONE. THE CONTRACTOR SHALL INSTALL TEMPORARY STOP SIGNS AT ALL NEW STREET ENCROACHMENTS INTO EXISTING CITY STREETS WHERE WARRANTED IMMEDIATELY AFTER FIRST GRADING WORK IS ACCOMPLISHED, AND SHALL MAINTAIN SAID SIGNS WHEN PERMANENT SIGNS ARE INSTALLED.
4. WHEN A DESIGNATED "SAFE ROUTE TO SCHOOL" IS ENCLOSED UPON BY A CONSTRUCTION WORK ZONE AND PUBLIC WORKS STAFF IDENTIFIES A NEED FOR STUDENTS TO BE ASSIGNED IN THE SAFE CROSSING THROUGH THAT WORK ZONE, THE CONTRACTOR SHALL BE REQUIRED TO PROVIDE A QUALIFIED "CROSSING GUARD". THE GUARD SHALL BE PRESENT FOR THE FULL DURATION OF TIME THAT CHILDREN ARE LIKELY TO BE PRESENT.
5. IF THE IMPROVEMENTS NECESSITATE THE OBSTRUCTION, TEMPORARY OBSTRUCTION, TEMPORARY REMOVAL OR RELOCATION OF ANY EXISTING TRAFFIC PAVEMENT MARKING, SUCH PAVEMENT MARKING SHALL BE RESTORED OR REPLACED WITH LIKE MATERIALS TO THE SATISFACTION OF THE CITY TRAFFIC ENGINEER.
6. THE CONTRACTOR SHALL BE RESPONSIBLE FOR PROVIDING AND INSTALLING ALL PERMANENT SIGNS SHOWN ON THE PLANS. ALL NEW SIGNS SHALL BE FABRICATED WITH DIAMOND GRADE VP CLASS 6 REFLECTIVE SHEETING OR APPROVED EQUIVALENT. ALL NEW TRAFFIC SIGNS, EXCEPT STREET NAME AND SCHOOL STOP SIGNS, SHALL HAVE 3M SERIES 1160 OR APPROVED EQUIVALENT ANTI-GRAFFITI PROTECTIVE OVERLAY FILM. SCHOOL ZONE SIGNS SHALL HAVE 3M SERIES 1150 ANTI-GRAFFITI PROTECTIVE OVERLAY FILM. STREET NAME SIGNS SHALL CONFORM IN THEIR ENTIRETY TO CURRENT CITY STANDARDS. ALL OTHER SIGNS SHALL BE STANDARD SIZE UNLESS OTHERWISE SPECIFIED ON THE PLANS. ALL SIGN POSTS SHALL BE INSTALLED IN ACCORDANCE WITH THE CURRENT CITY STANDARDS.
7. WHEN A PROPOSED STREET LIGHT STANDARD IS LOCATED WITHIN FIVE (5) FEET OF ANY PROPOSED SIGN SHOWN ON THE PLANS TO BE MOUNTED ON A SIGNPOST, THE SIGN SHALL BE MOUNTED ON THE STREET LIGHT STANDARD AND THE SIGNPOST SHALL BE ELIMINATED.
8. ALL PERMANENT TRAFFIC CONTROL DEVICES CALLED FOR HEREON SHALL BE IN PLACE AND IN FINAL POSITION PRIOR TO ALLOWING ANY PUBLIC TRAFFIC ON THE PORTIONS OF THE ROAD(S) BEING IMPROVED HERE UNDER, REGARDLESS OF THE STATUS OF COMPLETION OF PAVING OR OTHER OFF-SITE IMPROVEMENTS CALLED FOR BY THESE PLANS.
9. STREET SIGNS AND STOP SIGNS SHALL BE INSTALLED PER CITY STANDARD SPECIFICATIONS FOR PLACEMENT OF STREET NAME SIGNS.
10. THE CONTRACTOR SHALL PROVIDE ALL NECESSARY TRAFFIC CONTROL DEVICES AND FLAGGERS TO INSURE THE SAFETY OF THE PUBLIC IN OR AROUND THE WORK AREA. THE CONTRACTOR SHALL HAVE A CERTIFIED ATSSA TRAFFIC CONTROL TECHNICIAN OR MCA WORK ZONE SAFETY SPECIALIST SET UP, MAINTAIN AND/OR REMOVE ALL TRAFFIC CONTROL DEVICES IN THE CITY OF LAS VEGAS RIGHT-OF-WAY.
11. WORK IN PUBLIC STREETS, ONCE BEGUN, SHALL BE EXPEDITED TO COMPLETION SO AS TO PROVIDE MINIMUM INCONVENIENCE TO ADJACENT PROPERTY OWNERS AND TO THE TRAVELING PUBLIC.
12. THE CONTRACTOR SHALL BE RESPONSIBLE FOR NOTIFYING CITIZENS AREA TRANSIT (C.A.T.) IF THE CONSTRUCTION INTERRUPTS OR RELOCATES A BUS STOP OR HAS AN ADVERSE EFFECT ON BUS SERVICE ON THAT STREET TO ARRANGE FOR TEMPORARY RELOCATION OF STOP.
13. GUARDS SHALL BE OBTAINED BY CONTACTING THE METROPOLITAN POLICE DEPARTMENT SPECIAL EVENTS UNIT (PHONE # 828-3442) WHO WILL PROVIDE OFFICERS PROPERLY TRAINED IN TRAFFIC CONTROL. FEES FOR THE USE OF THESE OFFICERS SHALL BE SET BY METRO AND WILL BE PAID BY THE CONTRACTOR. THE CONTRACTOR IS RESPONSIBLE FOR ALL ARRANGEMENTS WITH METRO.
14. ANY WORK WITHIN 300' OF A SIGNALIZED INTERSECTION WILL BE NIGHT WORK, UNLESS DIRECTED BY THE CITY OF LAS VEGAS TRAFFIC ENGINEER.
15. CONTRACTOR SHALL CONTACT THE TRAFFIC ENGINEERING DIVISION (TRANSPORTATION SECTION) THROUGH THE PROJECTS OFFSITE INSPECTOR PRIOR TO INITIATING PAVING TO RECEIVE DIRECTION FOR ANY PERMANENT OR TEMPORARY MODIFICATIONS TO THE APPROVED DRAWINGS REGARDING FINAL PAVEMENT TRANSITIONS, MARKINGS AND SIGNING THAT ARE REQUIRED TO MATCH ADJACENT ROADWAY SEGMENTS. THE CONTRACTOR SHALL PROVIDE A DRAWING FOR APPROVAL BY THE TRAFFIC ENGINEERING DIVISION DEPICTING ANY ADJUSTMENTS TO THE FINAL PAVEMENT MARKINGS AND SIGNAGE, WHICH MAY INCLUDE OMITTING, ADDING OR MODIFYING PAVEMENT MARKINGS AND TRAFFIC CONTROL SIGNS SUCH THAT ADEQUATE TRANSITIONS AND LANE TRANSITIONS BETWEEN ADJACENT ROADWAY SEGMENTS ARE CONSTRUCTED.

REVISED 4/15/10

LAS VEGAS VALLEY WATER DISTRICT (LVVWD) STANDARD NOTES

LVVWD PROJECT # _____

1. NO WORK SHALL BEGIN UNTIL THE WATER PLANS HAVE BEEN APPROVED FOR CONSTRUCTION BY THE LVVWD FOLLOWING WATER PLAN APPROVAL, NOTICE SHALL BE GIVEN TO THE LVVWD COMMUNICATION SUPPORT CENTER (258-7171) TWO (2) WORKING DAYS PRIOR TO THE START OF CONSTRUCTION FOR FUTURE INSPECTIONS, NOTICE TO BE GIVEN BY 2:00 P.M. PRIOR TO THE REQUESTED LVVWD INSPECTION. WHEN REQUESTING INSPECTIONS, PLEASE REFER TO THE PROJECT # IDENTIFIED ABOVE.
 2. ALL WORK SHALL CONFORM TO LVVWD STANDARD PLATES, DRAWINGS, AND SPECIFICATIONS, AND TO THE 2010 EDITION OF THE UNIFORM DESIGN AND CONSTRUCTION STANDARDS FOR POTABLE WATER SYSTEMS (UDACS), THE LATEST EDITION OF UDACS SHALL SUPERSEDE ANY CONFLICTS CONTAINED IN THE APPROVED DRAWINGS AND/OR SPECIFICATIONS.
 3. ALL WORK, EXCEPT AS MODIFIED BY THESE PLANS OR BY NOTE 2 ABOVE, SHALL BE DONE IN ACCORDANCE WITH THE MOST RECENT DRAFT OR EDITION OF THE UNIFORM SPECIFICATIONS FOR PUBLIC WORKS CONSTRUCTION OFFSITE IMPROVEMENT, CLARK COUNTY AREA.
 4. A SINGLE PIPE MATERIAL SHALL BE USED THROUGHOUT THE PROJECT UNLESS OTHERWISE APPROVED BY THE LVVWD.
 5. ALL SERVICE LATERALS TWO (2) INCHES IN DIAMETER AND SMALLER SHALL BE TYPE K COPPER TUBING WITH LVVWD APPROVED SERVICE SADDLES.
 6. ALL WATER METER BOXES SHALL BE LOCATED OUTSIDE OF DRIVEWAY AREAS.
 7. ALL VALVES SHALL BE LOCATED OUTSIDE OF DRIVEWAYS, VALLEY AND CURB GUTTERS.
 8. ALL WATER AND STORM DRAIN OR SANITARY SEWER CROSSEINGS SHALL CONFORM TO SECTION 2.22 OF THE 2010 EDITION OF THE UDACS.
 9. ALL WATER FACILITIES SHALL BE FILLED, DISINFECTED, PRESSURE TESTED, FLUSHED, FILLED, AND AN ACCEPTABLE WATER SAMPLE OBTAINED, PRIOR TO CONNECTION TO THE LVVWD DISTRIBUTION SYSTEM.
 10. THE CONTRACTOR MUST OBTAIN ALL METERS TWO (2) INCHES AND SMALLER FROM LVVWD CENTRAL STORES. TELEPHONE 258-3152 OR 258-3802, TWO (2) WORKING DAYS PRIOR TO METER PICKUP.
 11. ANY INTERRUPTION OF SERVICE MUST BE PERFORMED IN ACCORDANCE WITH UDACS SECTION 3.14.01, AND APPROVED BY THE LVVWD INSPECTION DIVISION PRIOR TO SHUTDOWN. PROPER WRITTEN NOTIFICATION MUST BE GIVEN TO ALL AFFECTED CUSTOMERS.
 12. ALL WATER FACILITY CONSTRUCTION MATERIALS USED MUST BE LISTED ON THE LVVWD PRE-APPROVED MATERIALS AND MANUFACTURER'S LISTING FOR NEW FACILITIES, LATEST REVISION, OR SPECIFICALLY APPROVED ON THESE PLANS.
 13. TELEPHONE "CALL BEFORE YOU DIG" AT 811 OR 1-800-227-2600.
 14. THE INSTALLATION OF LAS VEGAS VALLEY WATER DISTRICT (LVVWD) MUNICIPAL WATER FACILITIES WITHIN ALL STREETS IS ASSUMED TO BE IN COMPLIANCE WITH THE UNIFORM STANDARDS, INCLUDING THE PLACEMENT OF ASPHALT PAVING STREET SURFACES. ANY REPAIR WORK DONE BY THE LVVWD TO THE MUNICIPAL WATER FACILITIES WILL INCLUDE THE PLACEMENT OF AN APPROPRIATELY SIZED ASPHALT REPAIR PATCH ON THE STREET SURFACE.
- ANY DECORATIVE PAVING SURFACE WITHIN THE STREET IS THE RESPONSIBILITY OF THE OWNER'S ASSOCIATION, OR THE INDIVIDUAL PROPERTY OWNERS IF NO OWNER'S ASSOCIATION IS IN EXISTENCE, OR THE AGENCY HAVING JURISDICTION. DECORATIVE SURFACE MATERIALS PLACED WITHIN THE TEN FOOT EASEMENT ADJUTING A PUBLIC OR PRIVATE STREET, IF DISTURBED BY THE LVVWD DURING THE REPAIR OR OPERATION OF ITS FACILITIES, WILL BE REPLACED BY LVVWD WITH AN APPROPRIATELY SIZED PLAIN FINISH CONCRETE PATCH. THE LVVWD WILL NOT RESTORE, AND WILL NOT BE RESPONSIBLE FOR THE RESTORATION OF ANY DECORATIVE PAVING SURFACE WITHIN THE STREET. THE LVVWD WILL NOT ATTEMPT TO MATCH COLOR OR FINISH OF ANY ADJACENT MATERIALS.

QUANTITY TABLE CONT.






⑧	RECESS CURB CONNECT TO EXISTING SIDEWALK (NO RAMP REQ'D)	1 EA.	-
⑨	CONSTRUCT "A" TYPE PER CCAUSD #219	-	443 LF
⑩	CONSTRUCT SIDEWALK RAMP PER DETAIL H/DT-1	1 EA.	-
⑪	CONSTRUCT 3" VALLEY GUTTER PER DETAIL K/DT-1	-	216 LF
①	INSTALL FIRE HYDRANT ASSEMBLY PER UDACS PLATE NO. 7	3 EA.	-
②	INSTALL 45° BEND (SAME SIZE AS MAIN)	2 EA.	-
③	REMOVE EXISTING BLOWOFF & CONNECT TO EXISTING MAIN PER UDACS PLATE 4A	1 EA.	-
④	INSTALL 1" SERVICE SADDLE & 5/8" METER PER UDACS PLATE 1B	14 EA.	-



CITY OF LAS VEGAS GENERAL NOTES

1. ALL CONSTRUCTION AND MATERIALS SHALL BE IN ACCORDANCE WITH THE LATEST EDITION OF THE DESIGN AND CONSTRUCTION STANDARDS FOR WASTEWATER COLLECTION SYSTEMS AND THE UNIFORM STANDARD SPECIFICATIONS FOR PUBLIC WORKS' CONSTRUCTION OFF-SITE IMPROVEMENTS, CLARK COUNTY AREA, NEVADA, AS AMENDED. IT WILL BE THE RESPONSIBILITY OF THE CONTRACTOR TO BE AWARE OF THE CONTENTS OF THE ABOVE SPECIFICATIONS.
2. THE EXISTENCE AND LOCATION OF ANY OVERHEAD OR UNDERGROUND UTILITIES SHOWN ON THESE PLANS ARE OBTAINED BY A RESEARCH OF THE AS SHOWN ON CLV PLANS LIBRARY ARE APPROPRIATE AND IF ANY LATERALS MAY NOT BE SHOWN ON THE PLANS. THE CONTRACTOR SHALL TAKE ALL NECESSARY PRECAUTIONS TO AVOID DAMAGE TO EXISTING UTILITIES. EXTREME CAUTION WHEN WORKING NEAR OVERHEAD UTILITIES, SIGNS AND EQUIPMENT, AND SHALL BE RESPONSIBLE FOR ALL COSTS ASSOCIATED WITH DAMAGE TO EXISTING UTILITIES.
3. THE CONTRACTOR SHALL TAKE ALL PRECAUTIONARY MEASURES, LINES, STRUCTURES AND STREET IMPROVEMENTS WHICH ARE TO BE SHUT IMPROVEMENTS OR STRUCTURES DAMAGED BY THE CONTRACTOR SHALL BE REPLACED SATISFACTORY TO THE CITY ENGINEER OR OWNING UTILITY CONTRACTOR.
4. ALL CONSTRUCTION SHALL BE AS SHOWN ON THESE PLANS, AND APPROVAL OF THE CITY ENGINEER.
5. TYPE V CEMENT SHALL BE USED IN ALL OFF-SITE CONCRETE UP TO 18" THICK. MIX DESIGNS TO BE APPROVED BY THE CITY, PRIOR TO CONSTRUCTION.
6. PERMITS ARE REQUIRED FOR ANY WORK IN THE PUBLIC RIGHT-OF-WAY. PERMITS AND INSPECTIONS REQUIRED FOR THIS CONSTRUCTION.
7. EXPANSION JOINTS REQUIRED, MAXIMUM EVERY 300' IN EXTERIOR WALLS.
8. AC PAVEMENT TO BE 1/2" ABOVE LP OF ALL GUTTERS AFTER CURB AND GUTTER FLOW TO BE UNACCEPTABLE TO THE CITY REPLACED PER USD 216.
9. SIDEWALK RAMP/S SHALL BE CONSTRUCTED IN EACH QUADRANT LOCATION OF RAMP/S MAY BE ADJUSTED IN THE FIELD BY A CITY ENGINEER.
10. CONTRACTOR SHALL PROVIDE ALL NECESSARY HORIZONTAL AND VERTICAL CURBS AND GUTTERS TO EXISTING SURFACES TO PROVIDE FOR PROPER DRAINAGE TO NEW CONSTRUCTION. THE EXTENT OF TRANSITIONS TO BE MADE SHALL BE AS SHOWN ON THE PLANS.
11. ALL GRADING WORK SHALL CONFORM TO THE SOILS REPORT AS DATED BY THE CITY ENGINEER, AND AS SHOWN ON THE PLANS.
12. EXACT LOCATION OF ALL SAWCUT LINES MAY BE DETERMINED ON PLANS IS NOT CLEARLY SHOWN, OR EXISTING PAVEMENT COORDINATES SHALL BE USED.
13. THE CONTRACTOR SHALL TAKE ALL PRECAUTIONS NECESSARY TO PROTECT ALL MONUMENTS, MONUMENTS DISTURBED SHALL BE REPLACED ACCORDANCE WITH N.R.S. STATUTE NO. 625.380 AND CITY OF LAS VEGAS STANDARD SPECIFICATIONS.
14. UTILITY COMPANY WATER BOXES, MANHOLE LIDS, VALVE COVERS, DRIVEWAYS, DRIVEWAY APRONS, FLOW LINES, AND CROSS GUTTERS BY THE UTILITY COMPANY AND THE CITY ENGINEER.
15. ALL WALLS, NEW OR EXISTING, ARE ONLY SHOWN ON CIVIL PLANS. RELATIONSHIPS, FLOOD CONTROL AND SIGHT DISTANCE AT INTERSECTIONS SHALL BE MAINTAINED BY THE BUILDING DEPARTMENT.
16. ASPHALT MIX DESIGN MUST BE SUBMITTED AND APPROVED BY THE CITY ENGINEER PRIOR TO CONSTRUCTION OF ASPHALT WITHIN CITY RIGHT OF WAY.
17. CONTRACTOR SHALL ADJUST ALL NEW AND EXISTING INLETS, VALVES, CLEAN OUTS, ETC. TO FINISH GRADE AS APPLICABLE. WHETHER THE FINISH GRADE IS SHOWN OR NOT.
18. MATERIALS, HANDLING AND PLACEMENT OF PORTLAND CEMENT CONCRETE SHALL BE IN ACCORDANCE WITH THE CLARK COUNTY AREA PLANS AND DETAILS SHOWN HEREON.
19. WHEN INSTALLING UNDERGROUND FACILITIES THAT REQUIRE UNDERGROUND FACILITIES, THE CONTRACTOR SHALL PROVIDE OFFSITE INSPECTION AND TESTING CERTIFYING THAT ALL EXISTING FACILITIES ARE IN GOOD WORKING CONDITION PRIOR TO THE CONSTRUCTION OF NEW FACILITIES.
20. SANITARY SEWER AND STORM DRAIN FINAL LOCATION MAP(S) SHALL BE PROVIDED TO THE CITY ENGINEER PRIOR TO THE START OF CONSTRUCTION. THE VERTICAL (INVERT) LOCATION OF PUBLIC SEWER MANHOLES, STUBS, AND CONNECTIONS TO THE STORM DRAIN MAIN AND AT THE CONNECTION OF SEWER SERVICE LATERALS TO THE SERVICE MAIN SHALL BE SHOWN ON THE "NEVADA COORDINATE SYSTEM OF 1983" REVISIONS CHAPTER 327, AND TIED TO THE CITY OF LAS VEGAS NETWORK. COORDINATES MUST BE CERTIFIED BY A NEVADA PROFESSIONAL SURVEYOR WITH POSITIONAL CERTAINIES OF +/- 0.1 METER (+/- 0.3 FEET). FILE FOR THE SANITARY SEWER AND STORM DRAIN COORDINATE MAP(S) WITH THE CITY ENGINEER PRIOR TO THE START OF CONSTRUCTION.
21. SANITARY SEWER SERVICE LATERALS REQUIRE THE INSTALLATION OF THE SEWER SERVICE LATERAL TO THE SEWER MAIN AND WHERE THE SEWER SERVICE LATERAL ENTERS THE SEWER MAIN, THE CONNECTION OF THE STORM DRAIN LATERAL TO THE STORM DRAIN LATERAL ENTERS THE PUBLIC RIGHT-OF-WAY OR WHERE THE STUB INLET, THE MARKER BALL SHALL BE 3M 4" MARKER BALL 1404.
22. CCTV VIDEO INSPECTION IS REQUIRED FOR ALL SEWER AND STORM DRAIN LATERALS TO BE PERFORMED PER THE DESIGN AND CONSTRUCTION SYSTEMS LATEST EDITION.
23. A SEPARATE BORING PERMIT IS REQUIRED FOR ALL BORING ACTIVITIES.

REVISED 4/15/10


⑤	INSTA
⑥	INSTA
⑦	INSTA
⑧	INSTA
⑨	INSTA
⑩	INSTA
⑪	INSTA
①	EXIST
②	EXIST
③	INSTA
④	STUB
⑤	REMO
⑥	INSTA
⑦	INSTA
-	WATE

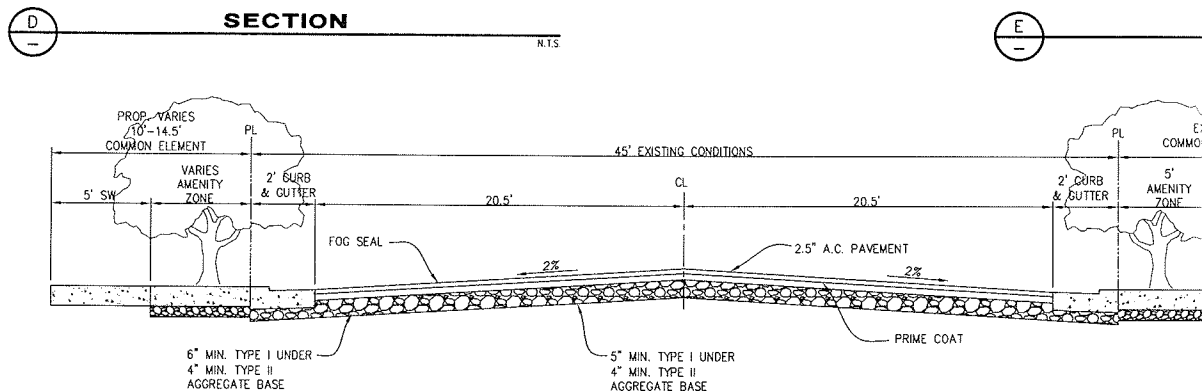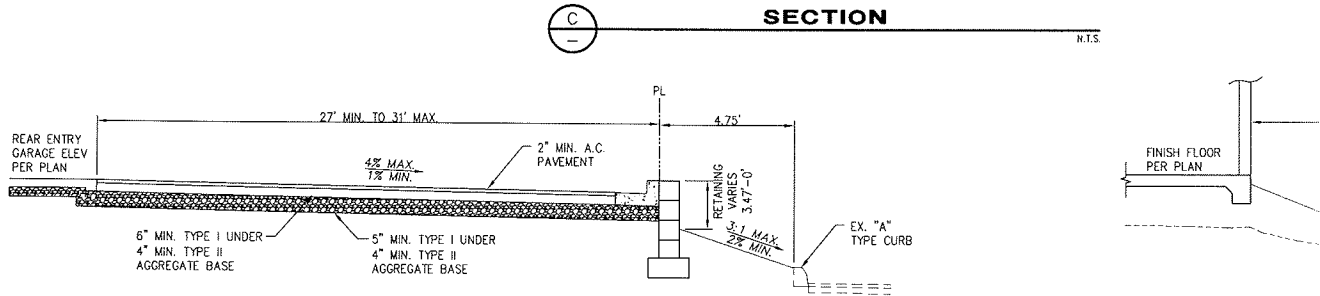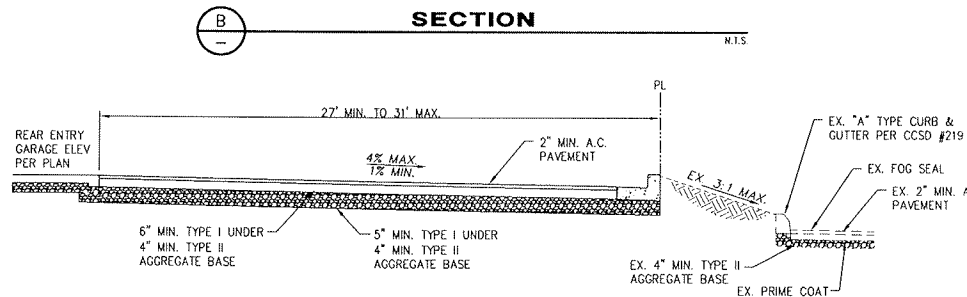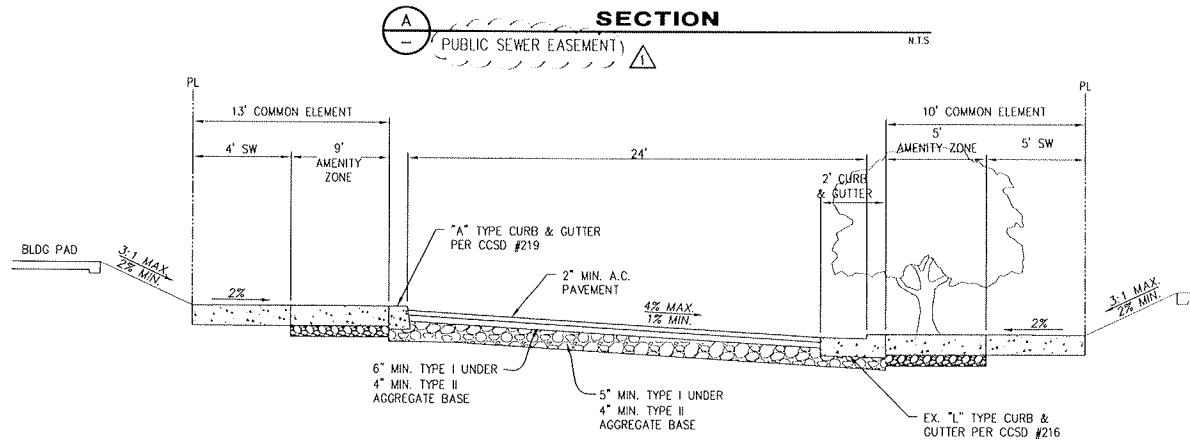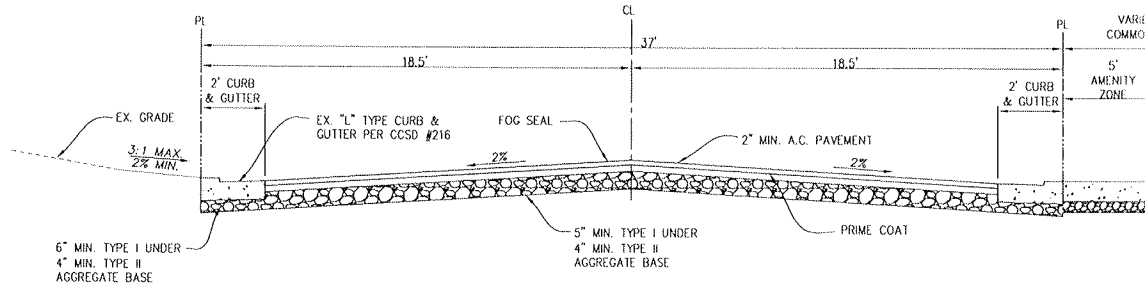

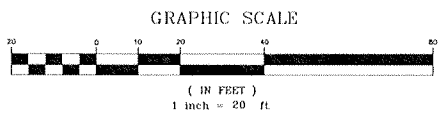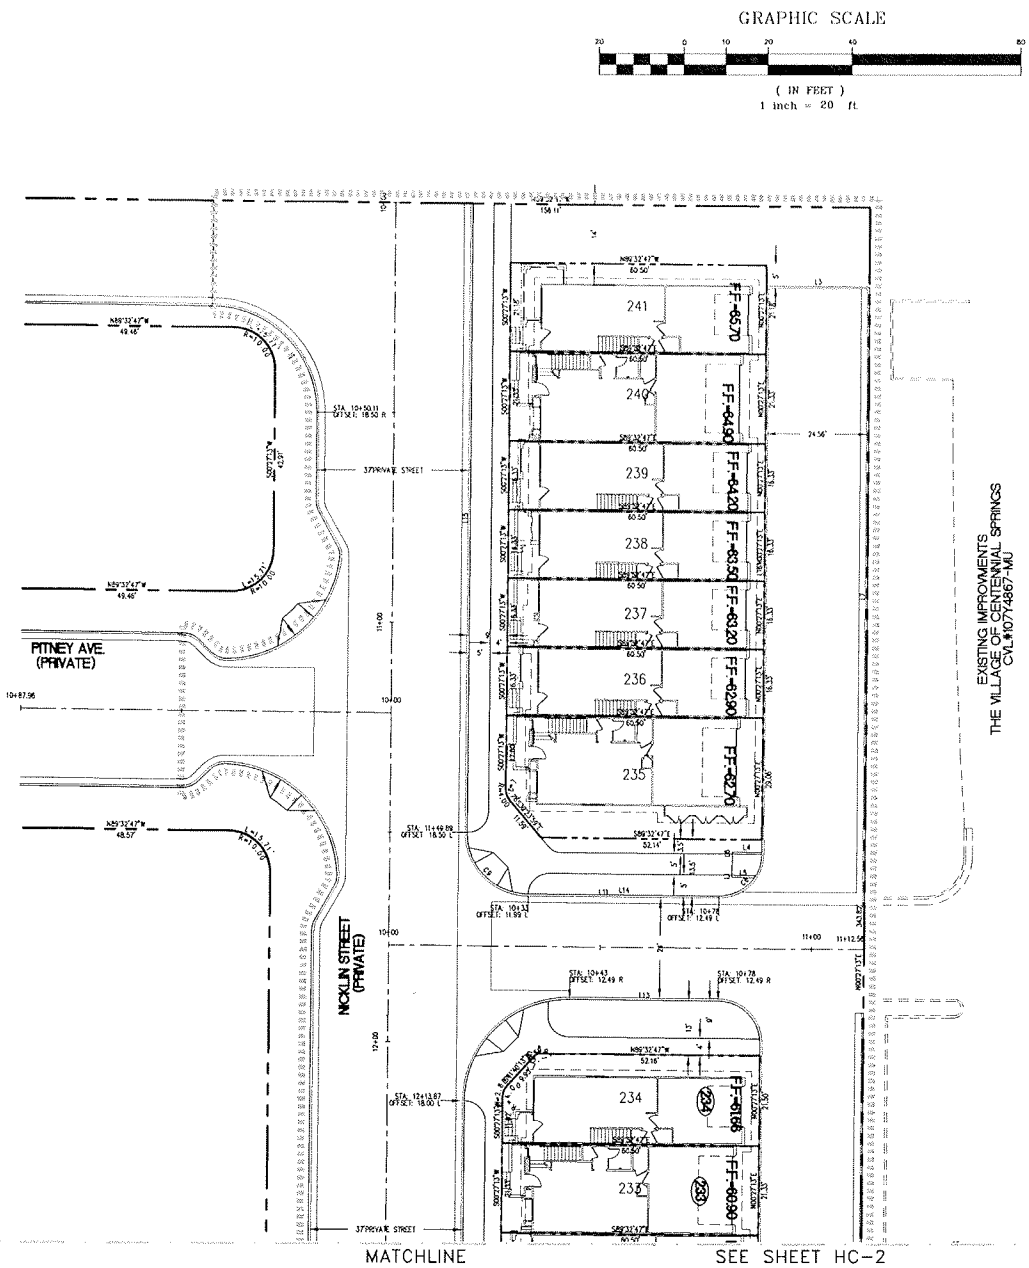

LINE TABLE		
LINE	LENGTH	BEARING
L1	0.50	S00°27'13"W
L2	1.05	S89°32'47"E
L3	24.56	N89°32'47"W
L4	7.00	N89°32'47"W
L5	5.35	N89°32'47"W
L6	0.50	S00°27'13"W
L7	147.39	S00°27'13"W
L8	20.10	S00°27'13"W
L9	86.35	S00°27'13"W
L10	45.00	N89°32'47"W
L11	35.33	N89°32'47"W
L12	114.95	S00°27'13"W
L13	35.00	N89°32'47"W
L14	45.00	N89°32'47"W
L15	149.89	S00°27'13"W
L16	135.39	N00°27'13"E
L17	133.95	N00°27'13"E
L18	147.37	S00°27'13"W

CURVE TABLE		
CURVE	LENGTH	RADIUS
C1	6.28	4.00
C2	35.10	139.08
C3	38.46	24.56
C4	15.71	10.00
C5	15.71	10.00
C6	15.71	10.00
C7	38.46	24.56
C8	22.78	14.56
C9	22.78	14.56

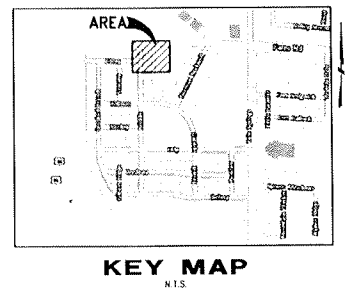

NOTE
NO WALLS, FENCES, TREES, SHRUBS, UTILITY APPURTENANCES OR ANY OTHER OBJECT, OTHER THAN TRAFFIC CONTROL DEVICES AND STREET LIGHT POLES, MAY BE CONSTRUCTED OR INSTALLED WITHIN THE SIGHT VISIBILITY ZONE UNLESS SAID OBJECT IS MAINTAINED AT LESS THAN 24 INCHES IN HEIGHT, MEASURED FROM TOP OF CURB, OR WHERE NO CURB EXISTS, A HEIGHT OF 27 INCHES MEASURED FROM THE TOP OF ADJACENT ASPHALT, GRAVEL OR PAVEMENT STREET SURFACE.

BASIS OF BEARINGS
NORTH 00°13'00" EAST, BEING THE EAST LINE OF THE SOUTHEAST QUARTER (SE1/4) OF SECTION 17, TOWNSHIP 19 SOUTH, RANGE 60 EAST, M.D.M., SAID LINE ALSO BEING THE CENTERLINE OF TULE SPRINGS ROAD AS SHOWN BY PLAT THEREOF ON FILE IN BOOK 81, PAGE 85 IN THE CLARK COUNTY, NEVADA RECORDER'S OFFICE.

BENCHMARK
01V90 16W4 CITY OF LAS VEGAS BENCHMARK, RIVET & PLATE IN TOP OF CURB AT THE NORTHEAST CORNER OF FARM ROAD AND TULE SPRINGS ROAD (FORMERLY DURANGO DRIVE) 774.7072 METERS
2541.69 FEET

NOTE
ALL DIMENSIONS AND RADII ARE TO BACK OF CURB UNLESS OTHERWISE NOTED.

LEGEND	
	PROPERTY LINE
	RIGHT-OF-WAY
	CENTERLINE
	LOTLINE
	EASEMENT
	ADJACENT PROPERTY LINE
	EX. EDGE OF PAVEMENT
	PROP. SIDEWALK
	SIGHT VISIBILITY ZONE
1	LOT NUMBER

NOTE
NDOT PERMIT REQUIRED FOR ALL WORK IN NDOT RIGHT-OF-WAY

SIGNAGE CONSTRUCTION NOTES	
MARK	DESCRIPTION
	INSTALL "R1-1" STOP SIGN

NOTES
ALL PRIVATE STREETS, DRIVE ISLES AND COMMON LOTS ARE P.U.E.'S. PUBLIC SEWER EASEMENTS & PUBLIC DRAINAGE EASEMENT TO BE PRIVATELY MAINTAINED BY THE H.O.A. SEE HORIZONTAL CONTROL SHEET FOR CURVE DATA

Call before you Dig
1-800-227-2600

CALL BEFORE YOU DIG
1-702-227-2929

FAST
Call before you UnderGround.
1-702-432-5300

DESIGNED BY: [blank]
DRAWN BY: CMH
CHECKED BY: LZ
PROJECT DATE: APRIL 2014

REVISION

NO.	DATE	DESCRIPTION
1	6/7/14	BLOC. DEPT. COMMENTS

THE VILLAGE OF CENTENNIAL SPRINGS - BROWNSTONES
CITY OF LAS VEGAS, NEVADA

HORIZONTAL CONTROL

OWNER/DEVELOPER:
SHEK CAPITAL
4455 CLIFF SHADOWS PKWY, STE #220
LAS VEGAS, NV 89129


SEAL
DARREN M. BENCH
REGISTERED PROFESSIONAL ENGINEER
NO. 10574

1915 N. Green Valley Pkwy
Suite 200
Henderson, NV 89074
Tel: (702) 855-3846

NEVADA, INC.
ENGINEERING · PLANNING · LAND SURVEYING

SHEET
HC-1
4 OF 10

AGENCY DWG. NO.

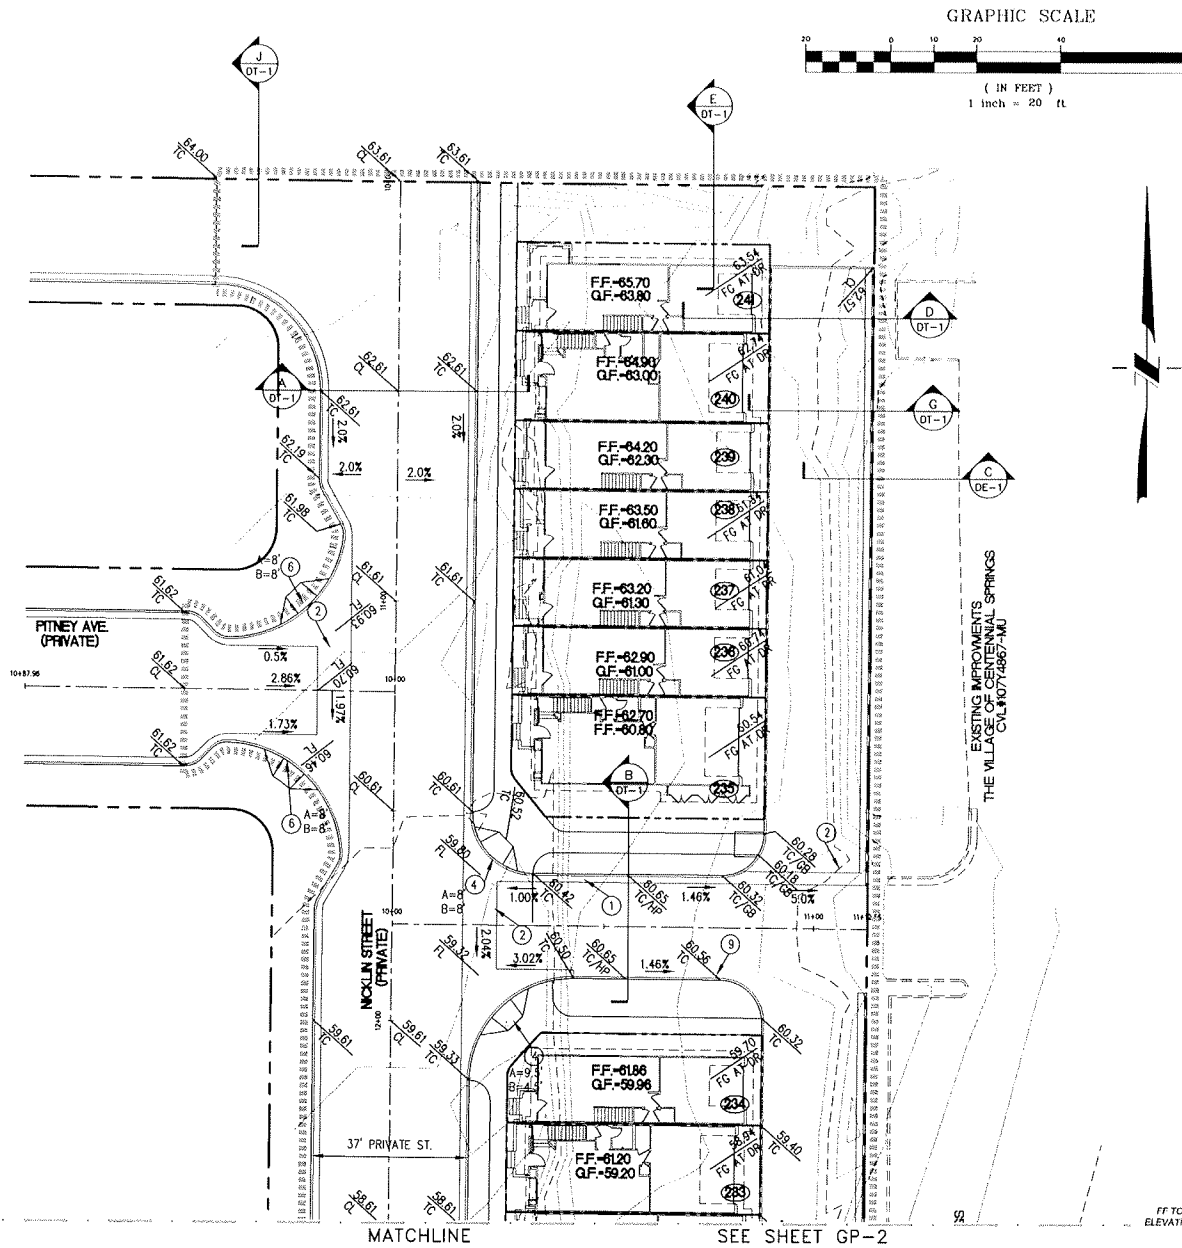

NOTE

NDOT PERMIT REQUIRED FOR ALL WORK IN NDOT RIGHT-OF-WAY



DISCLAIMER


UTILITY LOCATIONS SHOWN HEREON ARE APPROXIMATE ONLY. IT SHALL BE THE CONTRACTOR'S RESPONSIBILITY TO DETERMINE THE EXACT HORIZONTAL AND VERTICAL LOCATION OF ALL EXISTING UNDERGROUND AND OVERHEAD UTILITIES PRIOR TO COMMENCING CONSTRUCTION. NO REPRESENTATION IS MADE THAT ALL EXISTING UTILITIES ARE SHOWN HEREON. THE ENGINEER ASSUMES NO RESPONSIBILITY FOR UTILITIES NOT SHOWN OR UTILITIES NOT SHOWN IN THEIR PROPER LOCATION.

CALL BEFORE YOU DIG: 1 (800) 227-2600



MATCHLINE

SEE SHEET GP-1

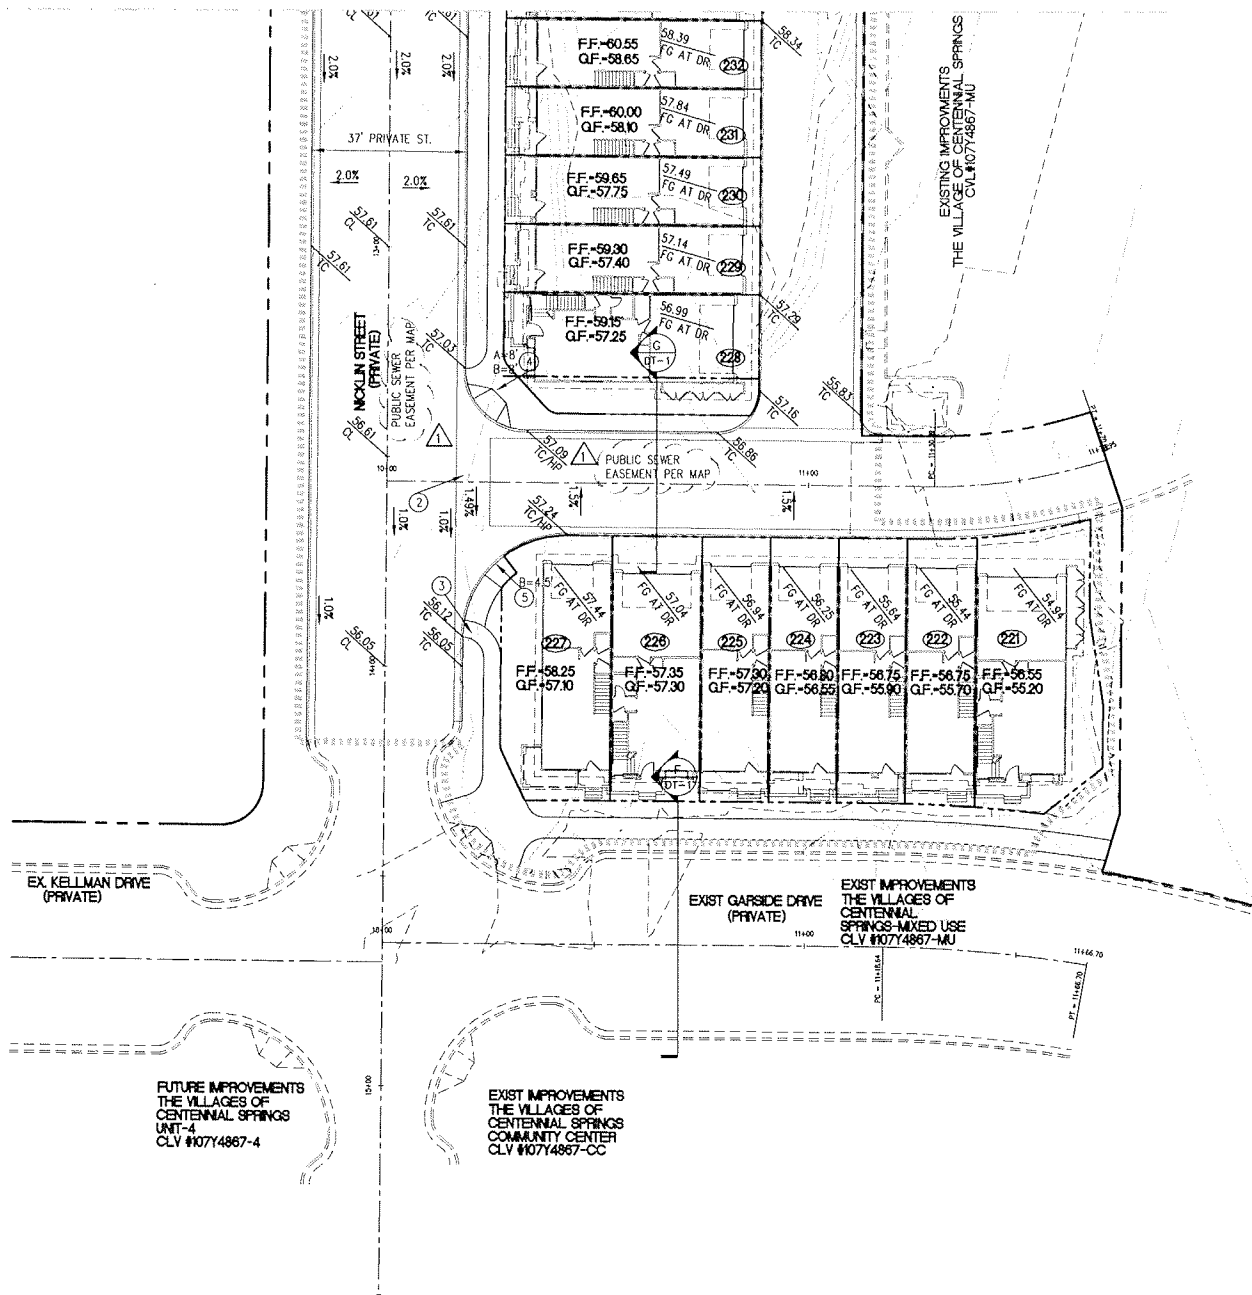

NOTE

NDOT PERMIT REQUIRED FOR ALL WORK IN NDOT RIGHT-OF-WAY

Call before you Dig
Avoid cutting underground utility lines it's easy.

Call 811

OR
1-800-227-2600

CALL BEFORE YOU DO OVERHEAD

1-702-227-2929

FAST

Call before you UnderGround.




1-702-432-5300


DISCLAIMER

UTILITY LOCATIONS SHOWN HEREON ARE APPROXIMATE ONLY. IT SHALL BE THE CONTRACTOR'S RESPONSIBILITY TO DETERMINE THE EXACT HORIZONTAL AND VERTICAL LOCATION OF ALL EXISTING UNDERGROUND AND OVERHEAD UTILITIES PRIOR TO COMMENCING CONSTRUCTION. NO REPRESENTATION IS MADE THAT ALL EXISTING UTILITIES ARE SHOWN HEREON. THE ENGINEER ASSUMES NO RESPONSIBILITY FOR UTILITIES NOT SHOWN OR UTILITIES NOT SHOWN IN THEIR PROPER LOCATION.

CALL BEFORE YOU DIG: 1 (800) 227-2600

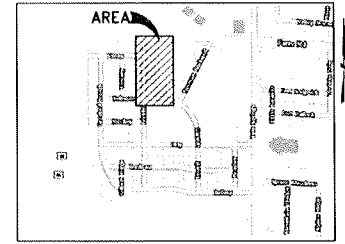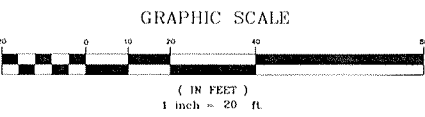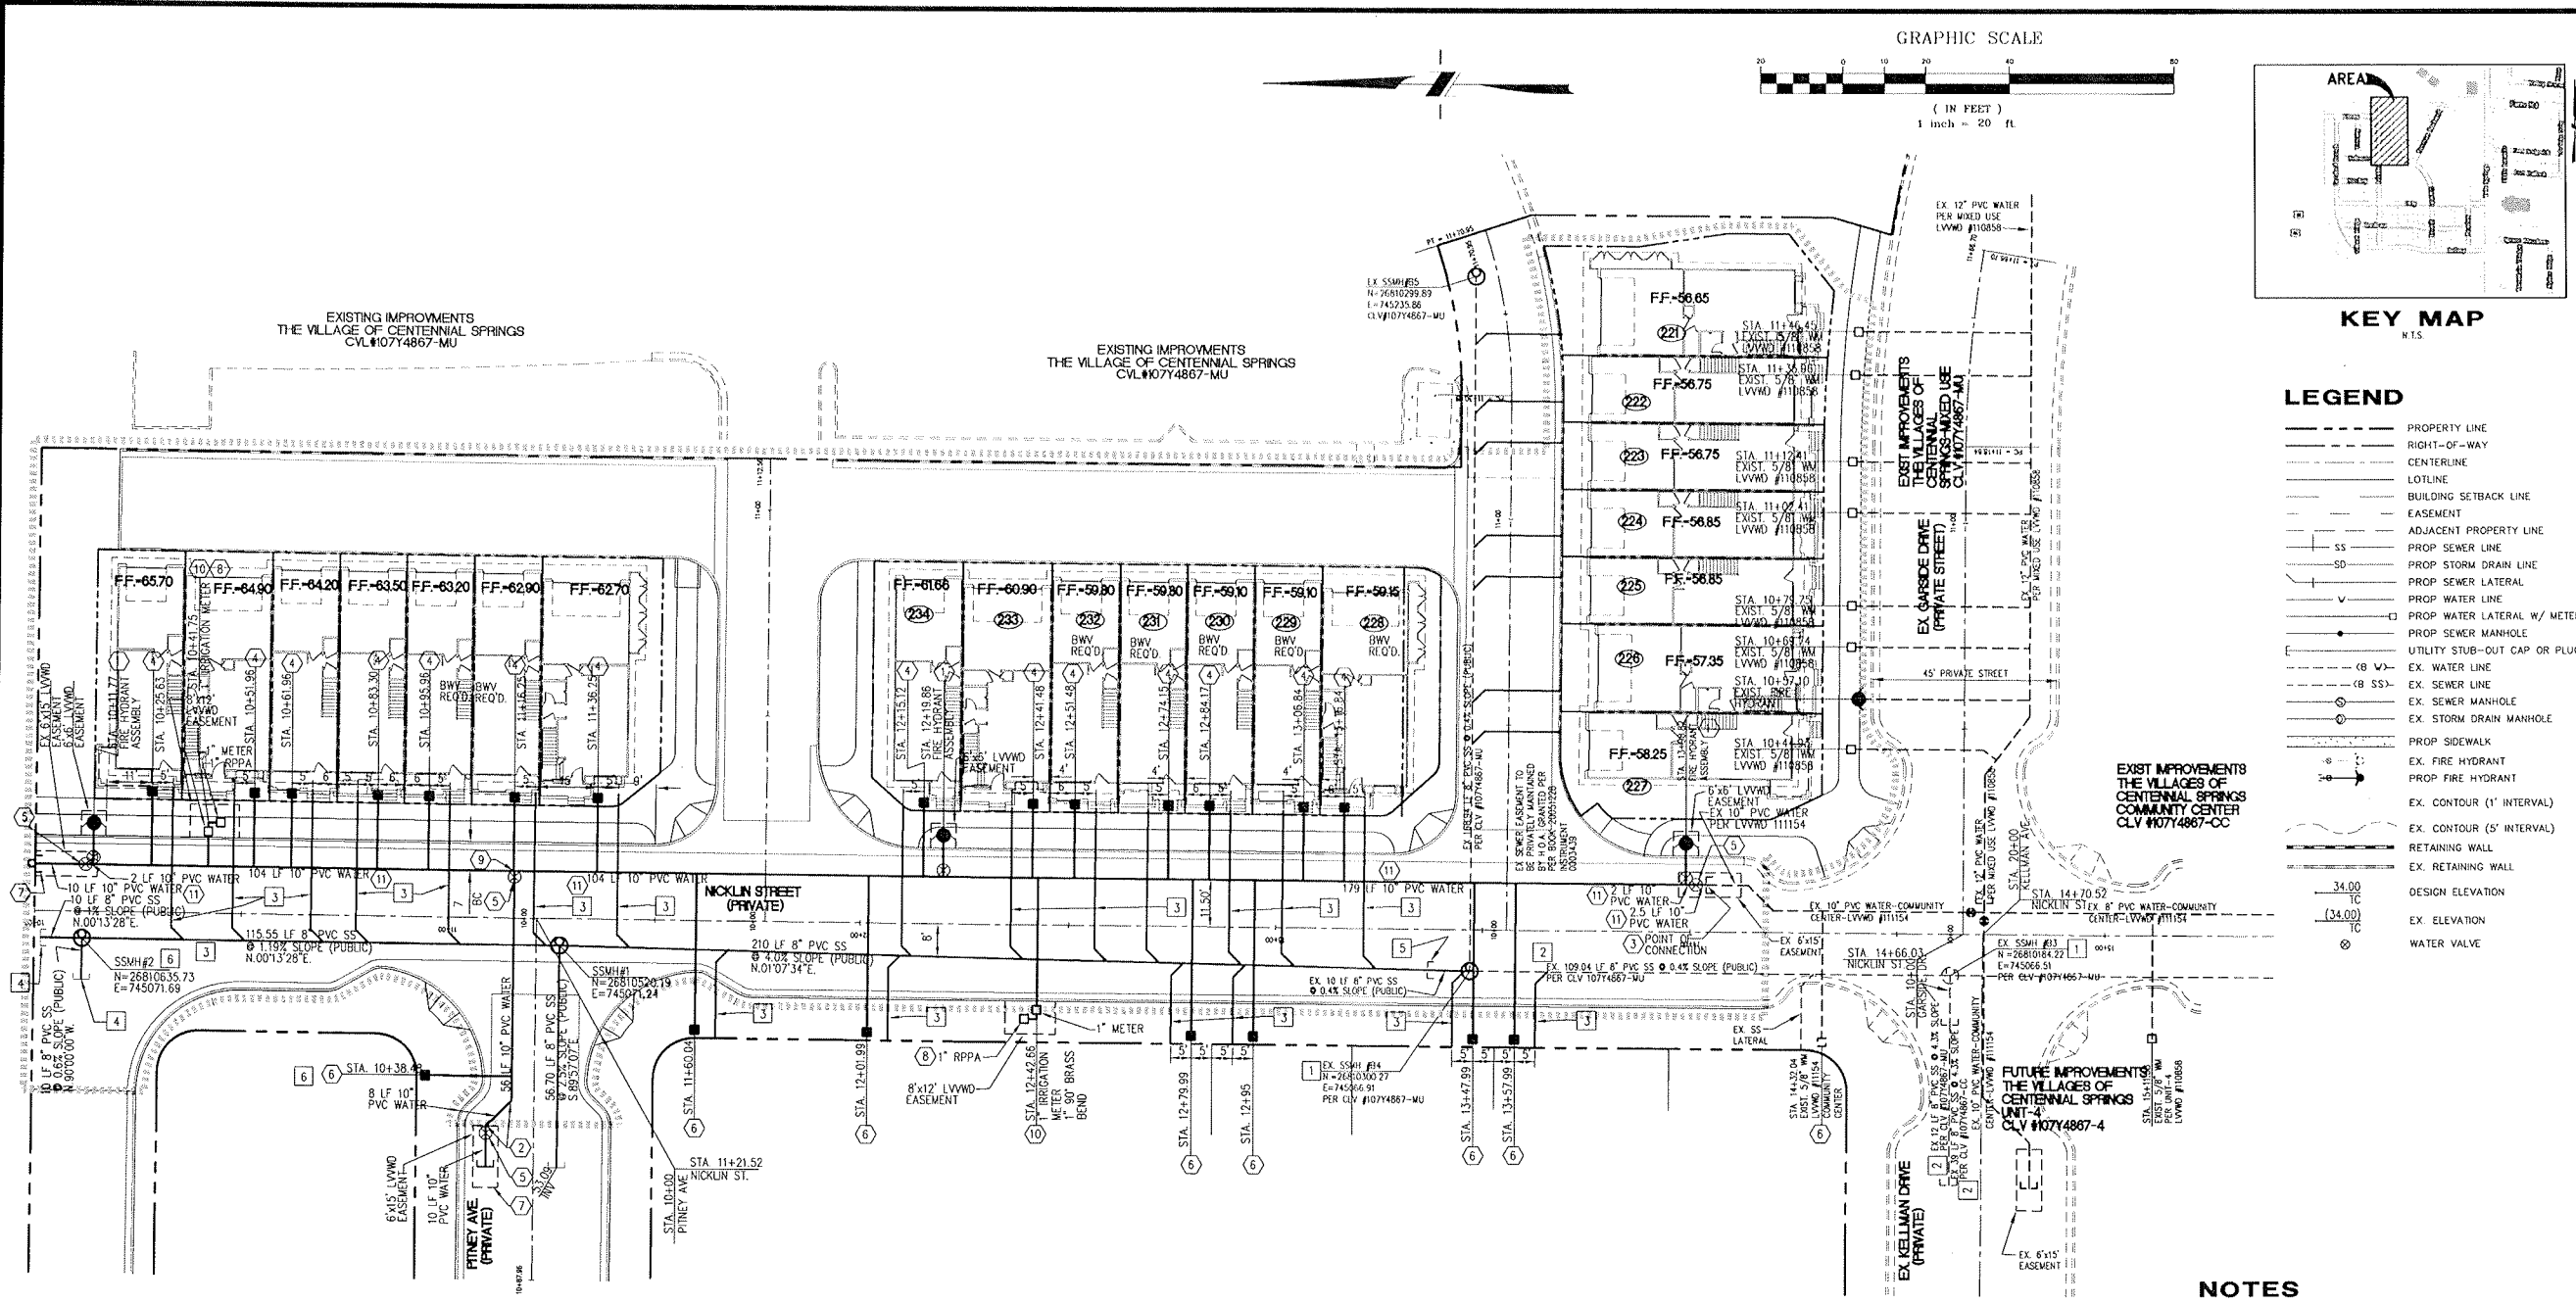

LEGEND

- PROPERTY LINE
- RIGHT-OF-WAY
- CENTERLINE
- LOTLINE
- BUILDING SETBACK LINE
- EASEMENT
- ADJACENT PROPERTY LINE
- PROP SEWER LINE
- PROP STORM DRAIN LINE
- PROP SEWER LATERAL
- PROP WATER LINE
- PROP WATER LATERAL W/ METER
- PROP SEWER MANHOLE
- UTILITY STUB-OUT CAP OR PLUG
- EX. WATER LINE
- EX. SEWER MANHOLE
- EX. STORM DRAIN MANHOLE
- PROP SIDEWALK
- EX. FIRE HYDRANT
- PROP FIRE HYDRANT
- EX. CONTOUR (1' INTERVAL)
- EX. CONTOUR (5' INTERVAL)
- RETAINING WALL
- EX. RETAINING WALL
- EX. ELEVATION
- WATER VALVE

NOTES

ALL PRIVATE STREETS, DRIVE ISLES AND COMMON LOTS ARE P.U.E.'S. PUBLIC SEWER EASEMENTS & PUBLIC DRAINAGE EASEMENT TO BE PRIVATELY MAINTAINED BY THE H.O.A. SEE HORIZONTAL CONTROL SHEET FOR CURVE DATA.

SEWER FLOW CONTRIBUTION

21 UNITS X 250 GDP/UNIT =	5,250 GDP AVG.
5,250 GDP X 3.4 PEAKING FACTOR =	17,850 GDP PEAK

CITY OF LAS VEGAS FIRE DEPARTMENT APPROVAL

BY _____ DATE _____

APPROVED FOR CONSTRUCTION
(PROJECT No. _____)

LAS VEGAS VALLEY WATER DISTRICT DATE _____

FIRE FLOW DATA

FIRE FLOW REQUIREMENT IS 1500 GALLONS PER MINUTE AT 20 PSI RESIDUAL PRESSURE.

BASED ON:

SQUARE FOOTAGE:	2,500	SQUARE FEET
LARGEST AREA BETWEEN 4-HOUR AREA SEPARATION WALLS:	2,500	SQUARE FEET
BUILDING HEIGHT:	35	FEET
TYPE OF CONSTRUCTION:	V-B	
OCCUPANCY:	SINGLE FAMILY RESIDENTIAL	
SPRINKLER SYSTEM:	NO	

REVIEWED BY: _____ DATE: _____

ENGINEER'S NOTES

INSTALL PIPELINE MARKER BALLS IN TRENCH ABOVE EACH HORIZONTAL ELBOW FITTING, PER UDACS PLATE NO. 27 ESN-602

THIS PROPERTY MAY HAVE STATIC WATER PRESSURE IN EXCESS OF 80 PSI. THE UNIFORM PLUMBING CODE REQUIRES THAT INDIVIDUAL, ON-SITE (PRIVATE), PRESSURE-REDUCING VALVES BE INSTALLED WHENEVER THE PRESSURE EXCEEDS 80 PSI. PRVS ARE THE DEVELOPER'S RESPONSIBILITY, AND WILL NOT BE INSPECTED OR INCLUDED IN THE ACCEPTANCE OF LVVWD FACILITIES ESN-041.

APPROVAL OF THESE PLANS FOR THE WATER STUBOUT INSTALLATION WILL NOT BE CONSIDERED AS A COMMITMENT FOR WATER SERVICE TO THIS PROPERTY ESN-001.

ENGINEER'S NOTES

EXISTING UTILITY LOCATIONS SHOWN HEREIN ARE APPROXIMATE ONLY. IT SHALL BE THE CONTRACTOR'S RESPONSIBILITY TO DETERMINE THE EXACT VERTICAL & HORIZONTAL LOCATION OF ALL EXISTING UNDER-GROUND UTILITIES PRIOR TO COMMENCING CONSTRUCTION. NO REPRESENTATION IS MADE THAT ALL EXISTING UTILITIES ARE SHOWN HEREON. THE ENGINEER ASSUMES NO RESPONSIBILITY FOR UTILITIES NOT SHOWN OR UTILITIES NOT SHOWN IN THEIR PROPER LOCATION. ALL DISCREPANCIES MUST BE IMMEDIATELY REPORTED TO THE ENGINEER. CALL BEFORE YOU DIG 1-800-227-2800.

LVVWD NOTES

REDUCED PRESSURE PRINCIPLE ASSEMBLY (RPPA) SHALL BE INSTALLED PER THE UDACS PLATE NO. 11A. NO WATER SHALL BE TAKEN FROM A SERVICE REQUIRING BACKFLOW PREVENTION UNTIL THE REDUCED PRESSURE PRINCIPLE ASSEMBLY HAS BEEN SUCCESSFULLY TESTED BY THE LVVWD.

ANY BLOCK WALL OR OTHER FENCE MATERIAL SHALL BE DESIGNED AND CONSTRUCTED AROUND THE OUTSIDE OF THE EASEMENT(S) TO ALLOW THE DISTRICT DIRECT ACCESS FROM THE ADJACENT RIGHT-OF-WAY. EASEMENTS SHALL BE CLEARLY MARKED OR STAKED PRIOR TO THE START OF CONSTRUCTION ESN-026.

WATER NOTES

MARK	DESCRIPTION
1	INSTALL FIRE HYDRANT ASSEMBLY PER UDACS PLATE NO. 7
2	INSTALL 45" BEND (SAME SIZE AS MAIN)
3	REMOVE EXISTING BLOWOFF & CONNECT TO EXISTING MAIN PER UDACS PLATE 4A
4	INSTALL 1" SERVICE SADDLE & 5/8" METER PER UDACS PLATE 1B
5	INSTALL GATE VALVE (SAME SIZE AS MAIN)
6	INSTALL FUTURE USE LATERAL PER SECTION 214.03 OF THE UDACS INSTALL WITH 1" SERVICE SADDLE & 5/8" METER PER UDACS PLATE 1B
7	INSTALL 2" BLOWOFF ASSEMBLY PER UDACS PLATE 4A
8	INSTALL 1" RPPA PER UDACS PLATE 11A
9	INSTALL 10"x10" TEE
10	INSTALL 1" IRRIGATION SERVICE & 1" METER PER UDACS PLATE 1D WATER PIPE INSTALLED WITHIN THE ROW TO BE TYPE "K" COPPER
11	INSTALL 10" WATER LINE (PVC, C-900 CL 150) PER UDACS PLATE 8B

SEWER NOTES

MARK	DESCRIPTION
1	EXISTING 48" SD-1A MANHOLE (PUBLIC)
2	EXISTING 8" PVC SEWER LINE (PUBLIC)
3	INSTALL 4" PVC SEWER LATERAL PER DCSWCS PLATE #50-17 (PRIVATE)
4	STUB 10 LF 8" PVC SEWER & CAP FOR FUTURE USE (PUBLIC)
5	REMOVE CAP & CONNECT TO EXISTING MANHOLE (PUBLIC)
6	INSTALL 48" SD-1A SEWER MANHOLE (PUBLIC)
7	INSTALL 8" PVC SEWER LINE (PUBLIC)

NOTE

SEE HC-1 SHEET FOR SIGHT VISIBILITY ZONES

BASIS OF BEARINGS

NORTH 001°30'00" EAST, BEING THE EAST LINE OF THE SOUTHEAST QUARTER (SE1/4) OF SECTION 17, TOWNSHIP 19 SOUTH, RANGE 60 EAST, M.D.M., SAID LINE ALSO BEING THE CENTERLINE OF TULE SPRINGS ROAD AS SHOWN BY PLAT THEREON ON FILE IN BOOK 81, PAGE 85 IN THE CLARK COUNTY, NEVADA RECORDER'S OFFICE.

BENCHMARK

OLV90 16W4 CITY OF LAS VEGAS BENCHMARK, RIVET & PLATE IN TOP OF CURB AT THE NORTHEAST CORNER OF FARM ROAD AND TULE SPRINGS ROAD (FORMERLY DURANGO DRIVE) 774.7072 METERS 2541.69 FEET

SANITARY SEWER MANHOLE TABLE

NO.	SIZE	TYPE	R/W	INV. OUT	INV. IN	STATION	OFFSET	STREET
EXSSMH B3	48"	SD-1A	55.224	41.82	42.02	14+63.05	9.97 RT	NICKLIN
EXSSMH B4	48"	SD-1A	56.474	42.49	42.69	13+47.01	10.01 RT	NICKLIN
EXSSMH B5	48"	SD-1A	55.324	43.38	43.58	-	-	-
SSMH1	48"	SD-1A	60.754	51.49	51.69	11+27.10	6.50 RT	NICKLIN
SSMH2	48"	SD-1A	63.124	53.89	-	10+11.53	6.50 RT	NICKLIN

Call before you Dig

Call 811

1-800-227-2800

Call before you Overhead

1-702-227-2929

FAST

Call before you Underground

1-702-432-5300

DESIGNED BY: _____

DRAWN BY: _____

CHECKED BY: _____

PROJECT DATE: APRIL 2014

NO. _____

REVISION _____

THE VILLAGE OF CENTENNIAL SPRINGS - BROWNSTONES

CITY OF LAS VEGAS

UTILITY PLAN

OWNER/DEVELOPER:

SHEK CAPITAL

1455 CLIFF SHADOWS PKWY, STE #220

1-415-764-5511

PROFESSIONAL ENGINEER

STATE OF NEVADA

BARREN BENCH

CIVIL

DP-12314

NO. 10571

1915 N. Green Valley Pkwy

Suite 200

Henderson, NV 89074

Tel (702) 355-3846

LAND SURVEYING

NEVADA, INC.


ENGINEERING · PLANNING

SHEET


UT-1

8 OF 10

AGENCY DWG. NO.

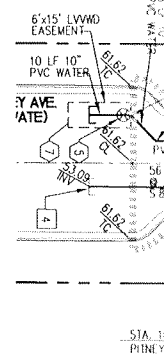


(PRIVATE STREET)
SCALE : 1"=20'

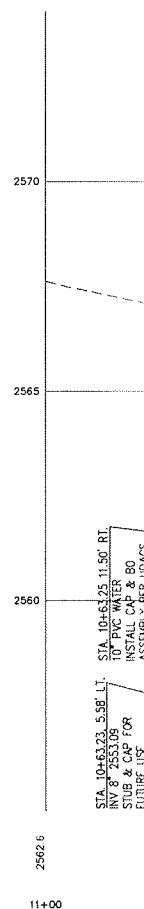

STA: 10+00 TO STA: 12+50
(PRIVATE STREET)
HORIZONTAL SCALE : 1"=20'
VERTICAL SCALE : 1"=2'

MATCHLINE STA: 12+50 SEE SHEET PP-1

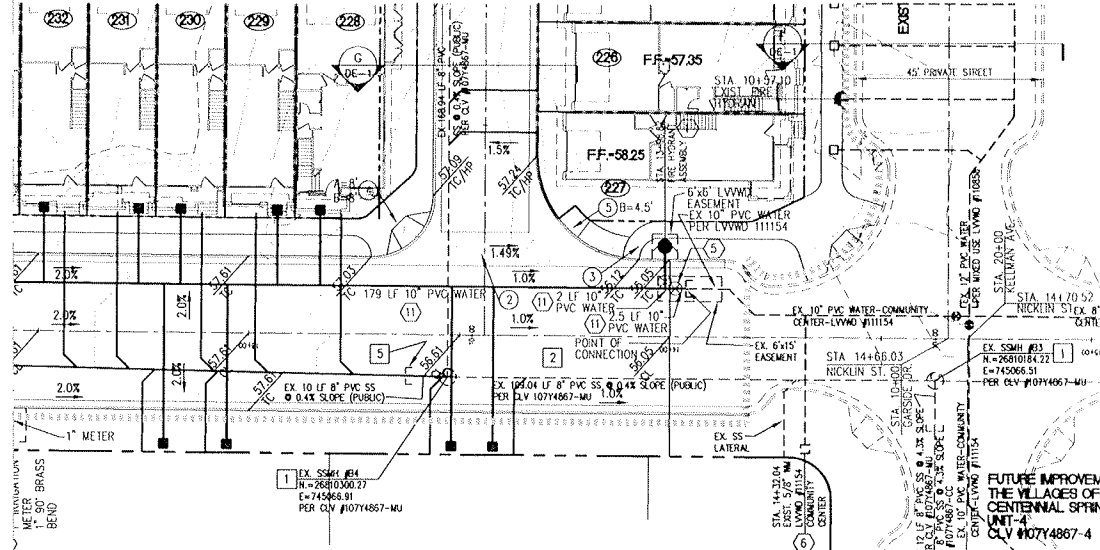


NICKLIN ST. - PLAN VIEW

(PRIVATE STREET)
SCALE : 1"=20'

SEE SHEET PP-1

MATCHLINE STA: 12+50

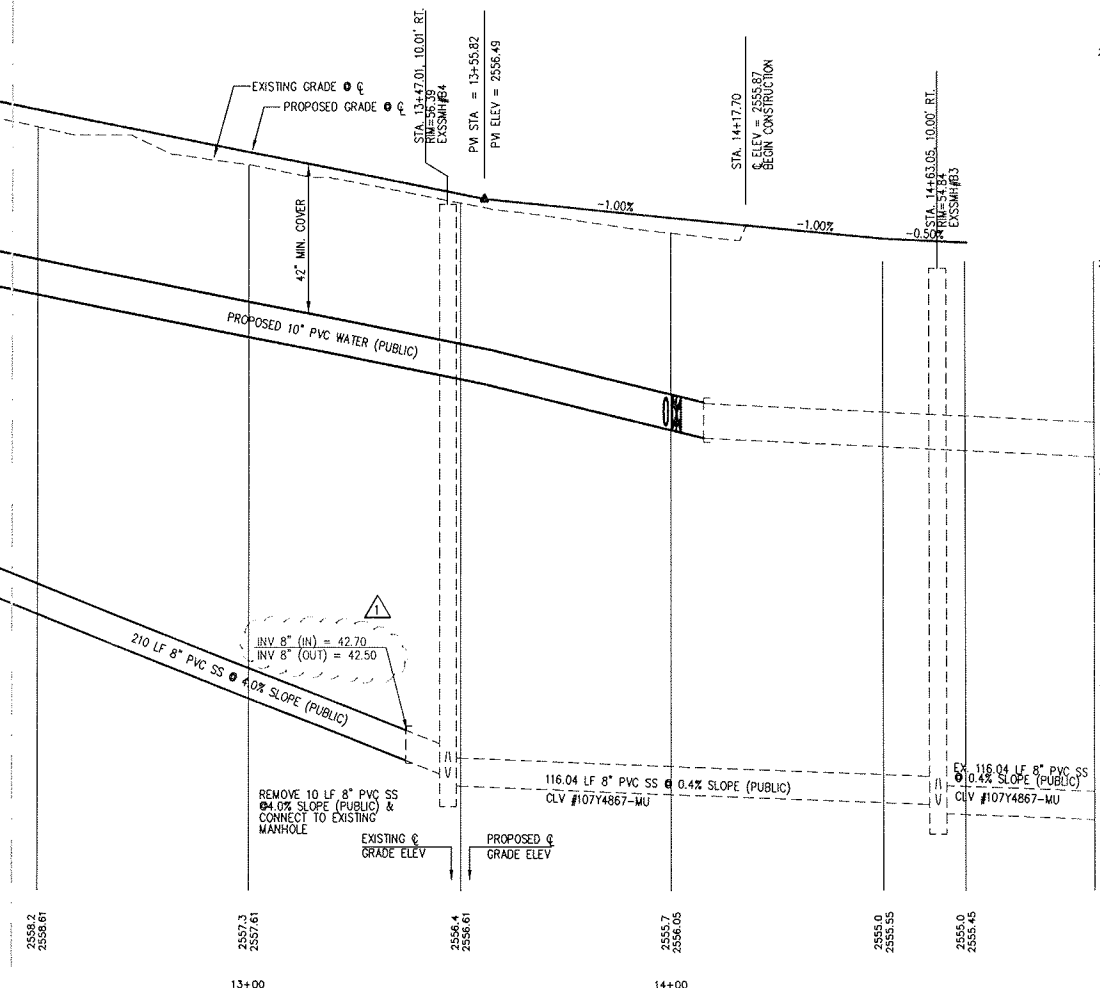

NICKLIN ST. - PROFILE

STA: 12+50 TO STA: 15+00
(PRIVATE STREET)
HORIZONTAL SCALE : 1"=20'
VERTICAL SCALE : 1"=2'