

T 20 S, R 60 E, M.D.B. & M.  
T 20 S, R 61 E, M.D.B. & M.

APPROX. 30.75 ACRES

APPROX. 40.37 ACRES

APPROX. 40.37 ACRES

APPROX. 40.24 ACRES


APPROX. 40.24 ACRES

APPROX. 20.08 ACRES

*changed  
R/S*

STATE OF NEVADA S.S.  
COUNTY OF CLARK

I, CHARLES L. KNAUS, being first duly sworn, depose and say that this map, consisting of one sheet, has been correctly drawn to the designated scale from field notes of a survey made under my supervision and direction between the 15<sup>th</sup> day of April, 1956, and the 10<sup>th</sup> day of May, 1956; that it truly and correctly represents the location and extent of the works used to divert water from the Las Vegas Valley Basin in Clark County by the City of Las Vegas for irrigation purposes under application No. 10987. That the point of diversion, the location and size of the diverting conduit, the location and extent of lands owned or controlled by the applicant upon which water applied for under application No. 10987 is used, together with the area and kind of culture in each 40-acre sub-division, and the location and names of all other works or streams which are crossed by or connected with said works are fully and correctly designated thereon.

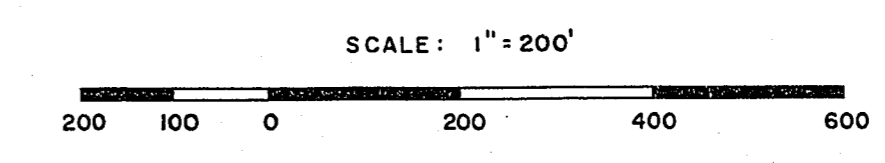

STATE WATER RIGHT SURVEYOR

Subscribed and sworn to before me this \_\_\_\_\_ day of \_\_\_\_\_, 19\_\_

NOTARY PUBLIC IN AND FOR CLARK COUNTY, NEVADA.

My commission expires \_\_\_\_\_

CITY OF LAS VEGAS, NEVADA  
ENGINEERING DEPT.

MAP TO ACCOMPANY  
PROOF OF BENEFICIAL USE UNDER  
APPLICATION NO. 10987  
FOR IRRIGATION  
BY THE CITY OF LAS VEGAS, NEVADA  
FROM LAS VEGAS VALLEY WATER BASIN

DRAWN BY: H.Bell	CHECKED BY:	APPROVED:	FIELD BOOK REF.
DATE MAY 10, 1956	DATE	DATE	

722-11 (SEE SEPIA)