


MONUMENTATION MAP

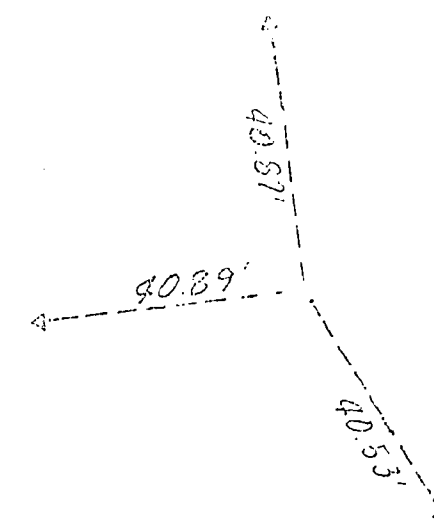

CERTIFICATE

I, RICHARD J. BAUGHMAN, A DULY REGISTERED
LAND SURVEYOR IN THE STATE OF NEVADA, ATTEST
AND CERTIFY THAT THE FINAL MONUMENT AND
TIES THERE TO HAVE BEEN ESTABLISHED AS
SHOWN HEREON.

Richard J. Baughman
RICHARD J. BAUGHMAN
RPE RLS 2162 1-10-86

SET LEAD & TACK IN CONCRETE

058-1241-2-2

058-1241-2

MONUMENTATION MAP



CERTIFICATE







