



PLAN - SCALE 1/2"=1'-0"


NOTE: ADD OR DELETE ONE OR MORE TREADS AND RISERS AS REQUIRED TO MEET EXISTING GRADES. SEE ELEVATIONS ON PLAN SHEETS.

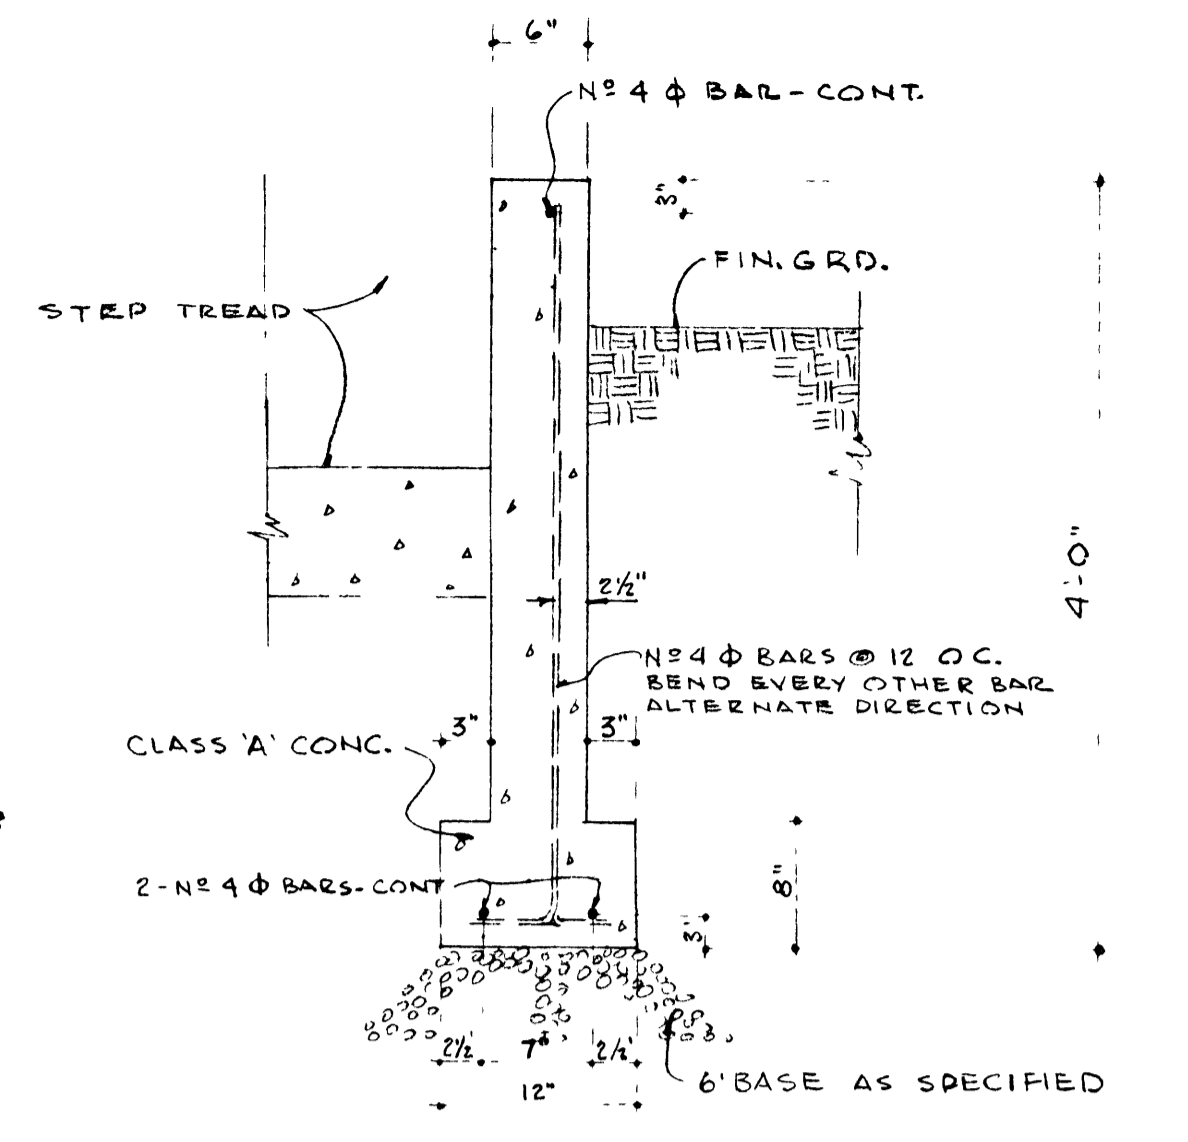


SECTION B-B - SCALE: 1"=1'-0"

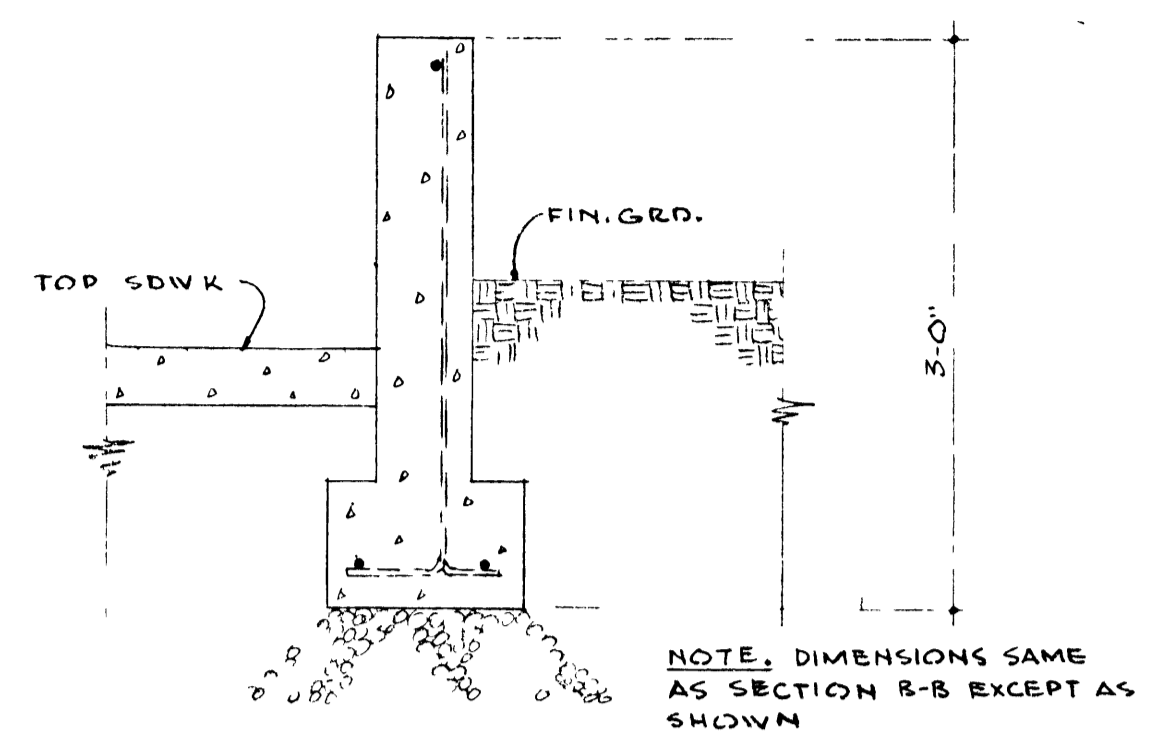

SECTION C-C SCALE: 1"=1'-0"

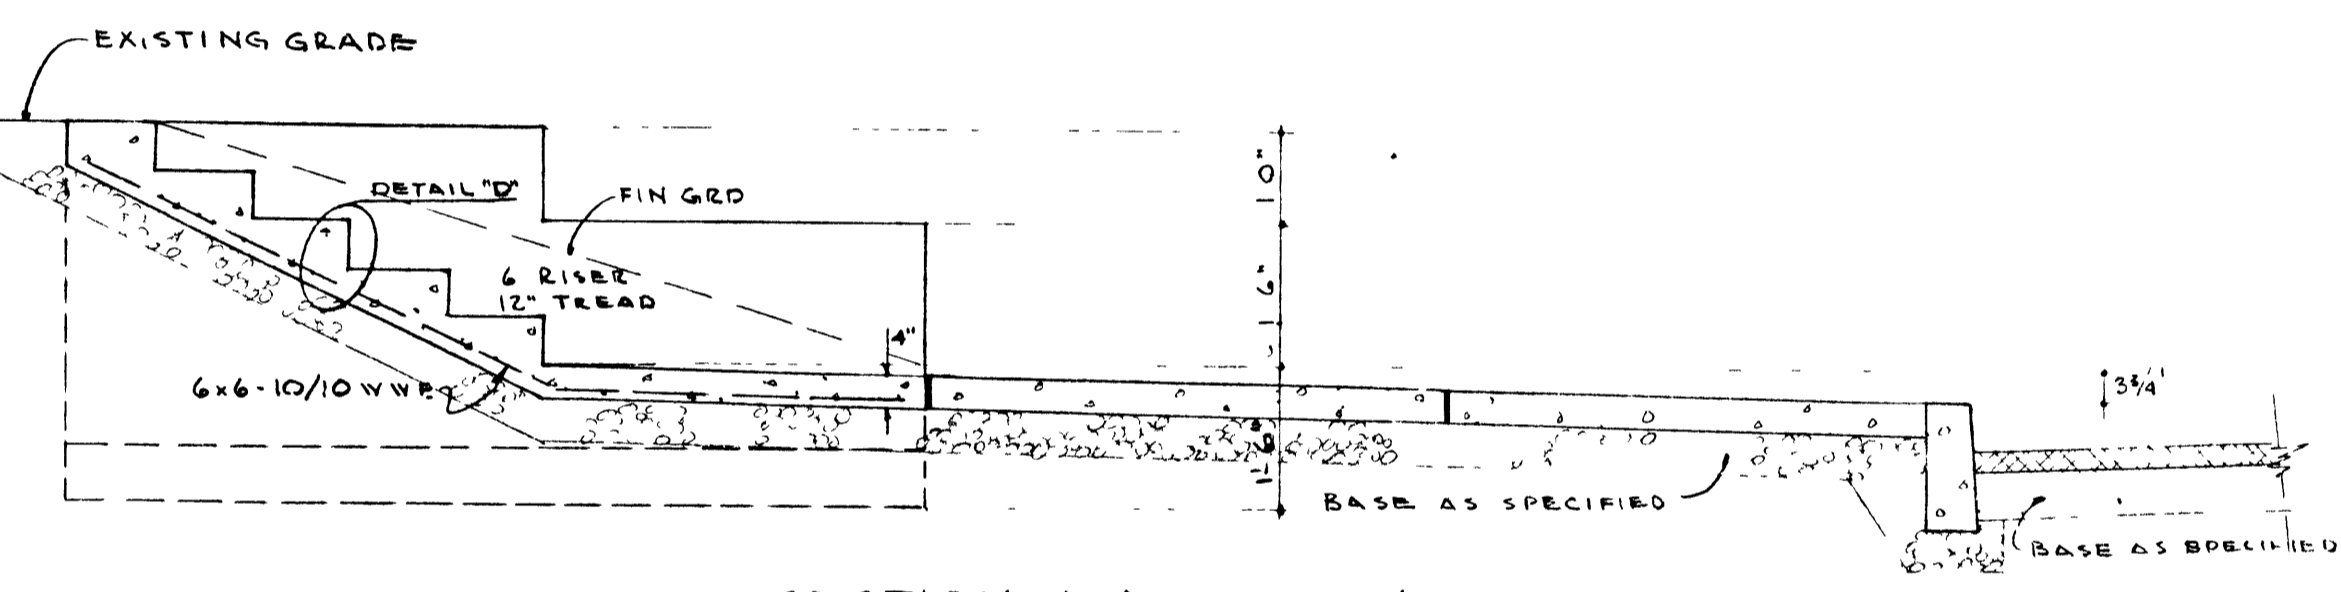


SECTION A-A - SCALE: 1/2"=1'-0"

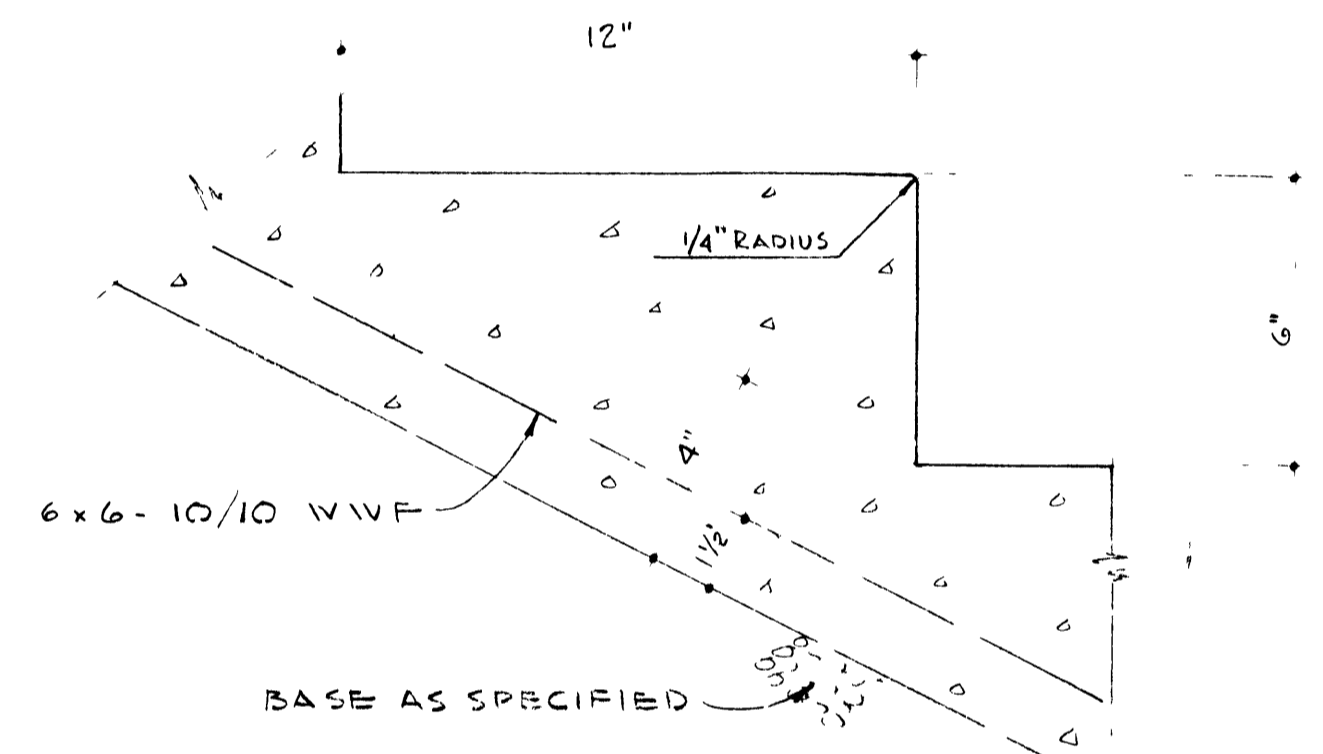

DETAIL "D" SCALE: 3"=1'-0"


TYPICAL STEP DETAIL

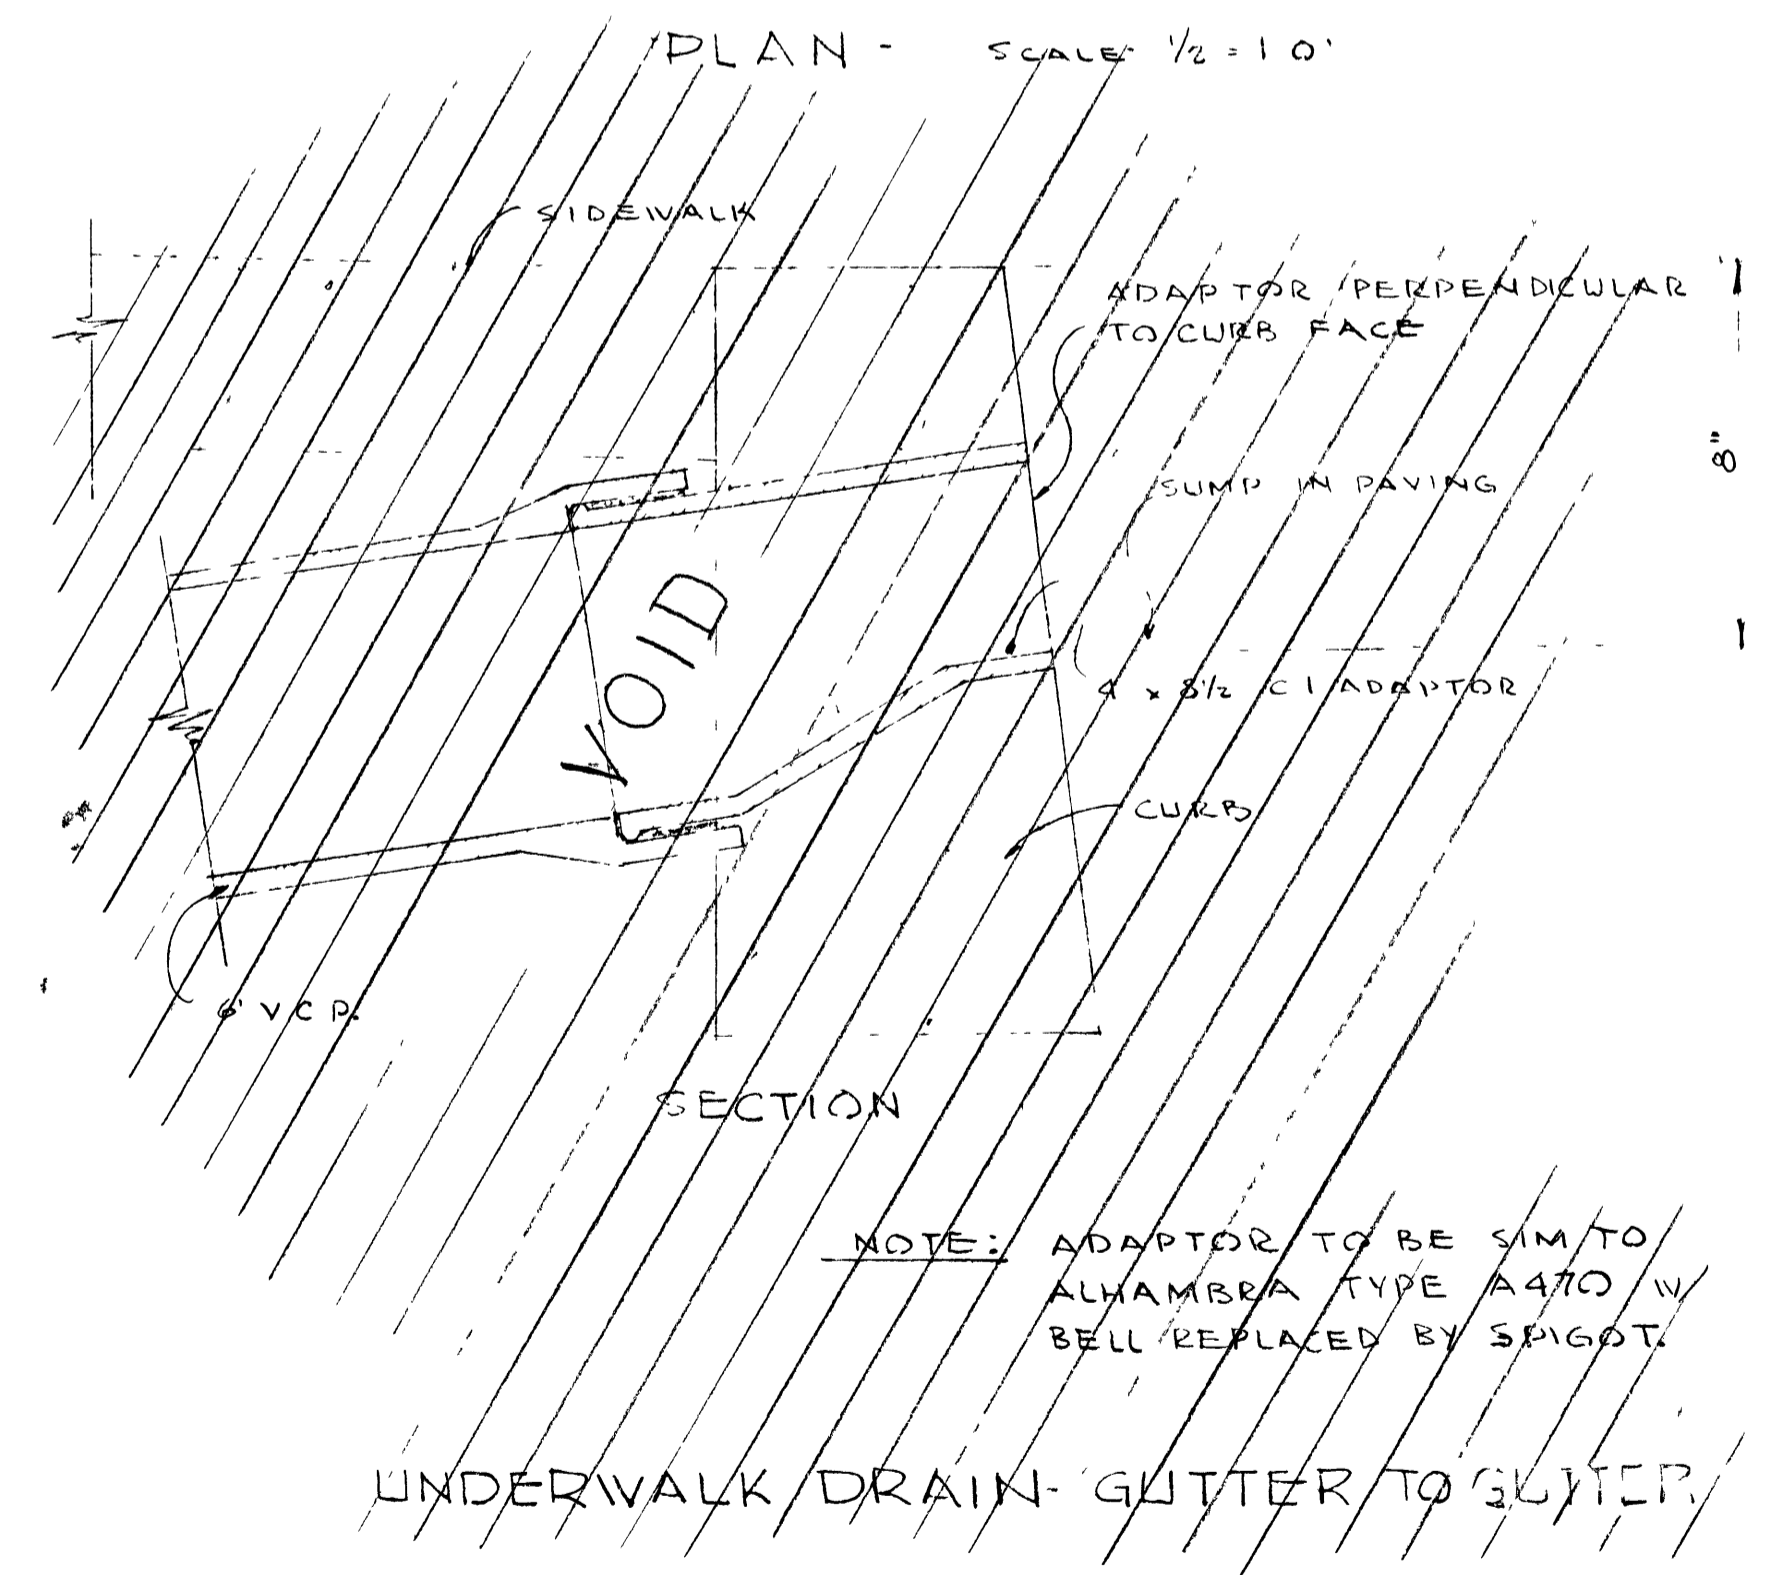

NOTE: ADAPTOR TO BE SIM TO ALHAMBRA TYPE A470 W BELL REPLACED BY SPIGOT


UNDERWALK DRAIN GUTTER TO GUTTER

NOTES: ALL POSTS AND RAILINGS SHALL BE 1 1/2" DIAM EXTRA STRONG PIPE. PAINT ALL POSTS AND RAILINGS WITH 2 COATS OF APPROVED ALUMINUM PAINT.

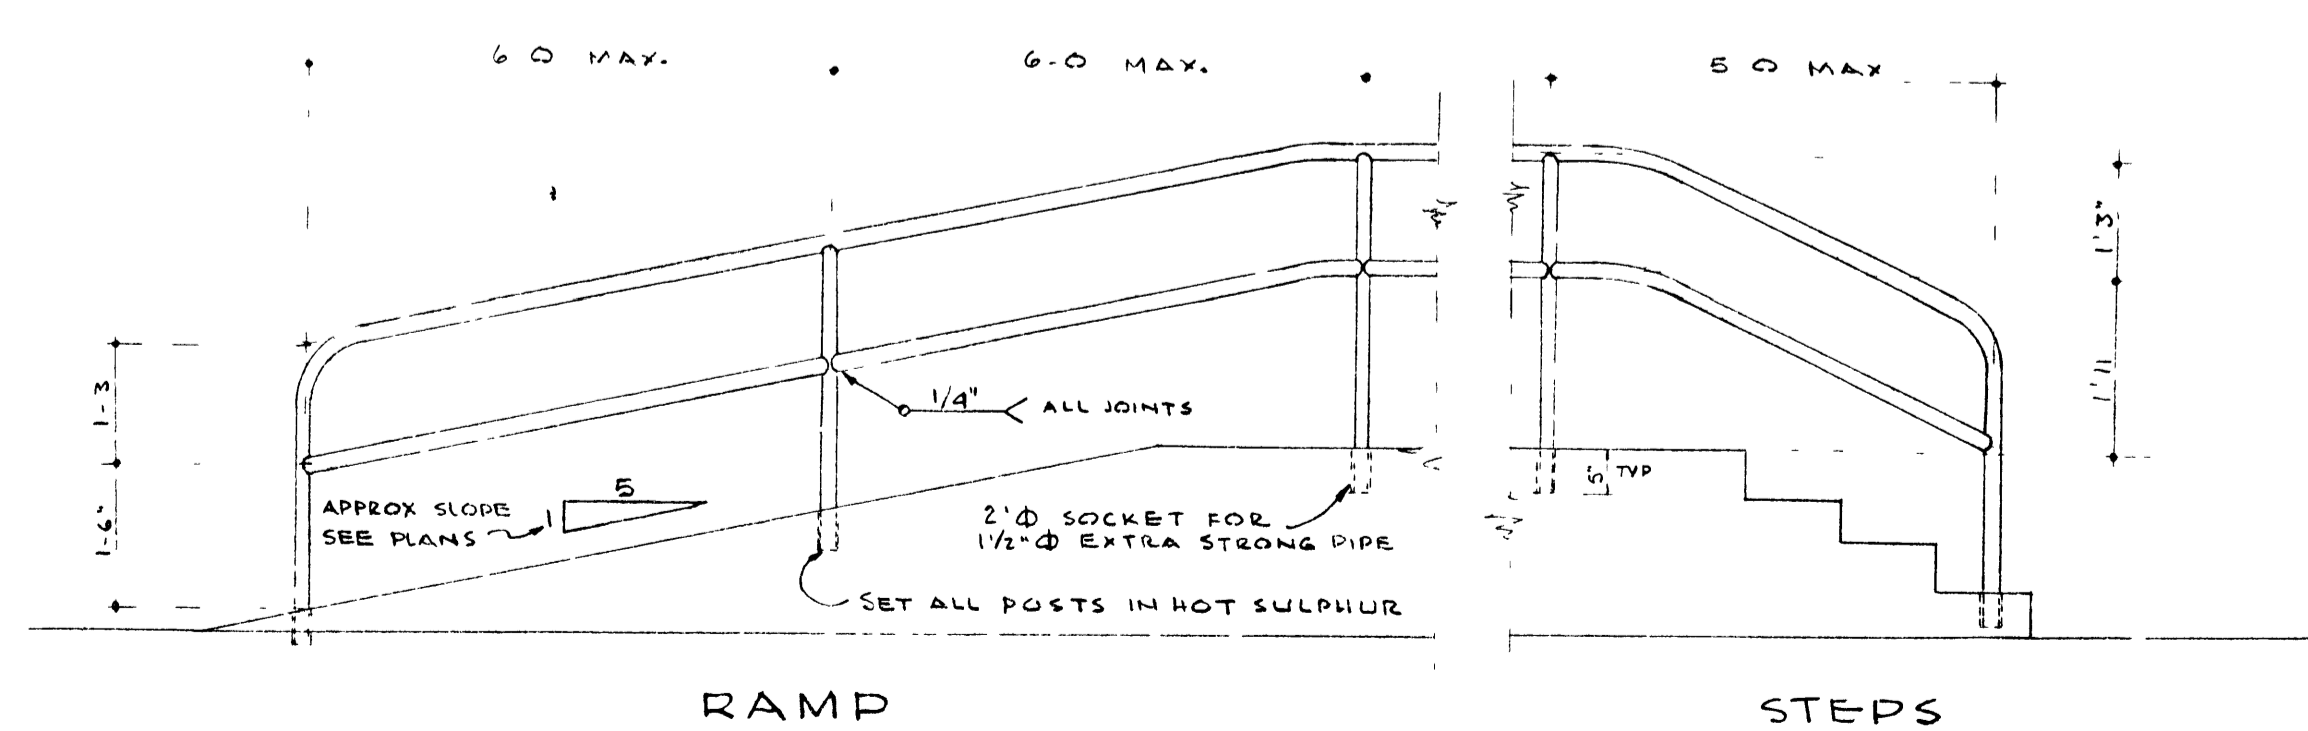

TYPICAL PIPE RAIL DETAIL SCALE: 1/2"=1'-0"

ALL POSTS ON HORIZONTAL SURFACE SHALL BE A MAXIMUM OF 6'-0" C.C.

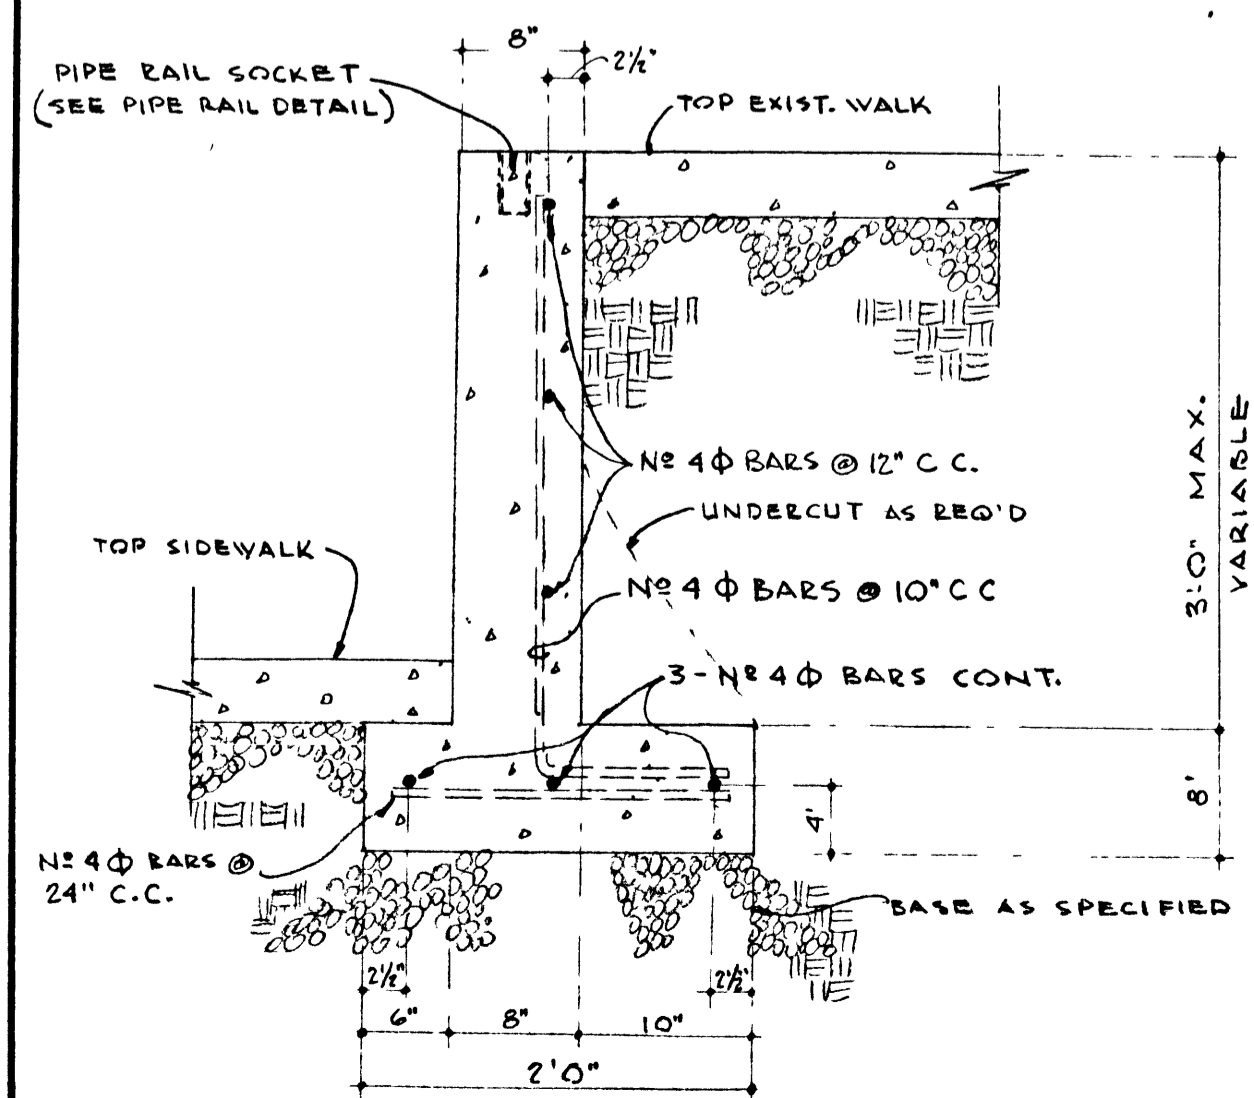

TYPICAL RETAINING WALL SCALE: 1"=1'-0"

CITY OF LAS VEGAS NEVADA ENGINEERING DEPT.		
MISCELLANEOUS DETAILS S&D 100-95		
DES. J.R.	DATE	SC. (H)
DR. J.R.		SC. (V)
CHK. G.W.		F. BK. NO.
APPROVED BY CITY ENGR.		P.J. O. NO. W-101
		DRAWING NO.
		107-V6