

REV	DATE	BY	REVISION
1	11-2-89	J.U.	ADD THE MEANDERING CHANNEL UNDERPASS AT 17+00

PROJECT
PECCOLE RANCH



TITLE
GRAND CANYON ROAD STREET PLAN AND PROFILE

NO. 3804
BY J.U.
DATE 7-89
SCALE HORIZ. 1"=40'
VERT. 1"=4'

1 SHEET
OF 58 SHEETS
107Y-4070-1

DATE 11-2-89
LAS VEGAS VALLEY WATER DISTRICT

CONSULTING ENGINEERS - PLANNERS
2300 PASEO DEL PRADO, BUILDING A, SUITE 100
LAS VEGAS, NEVADA 89102 PHONE (702) 873-7550

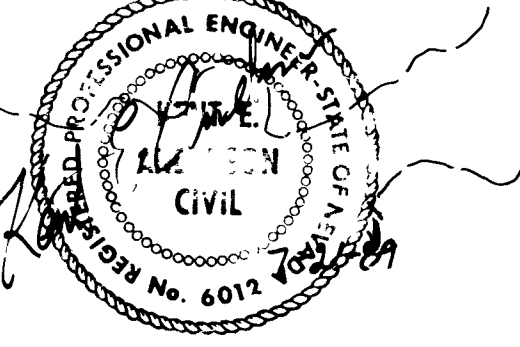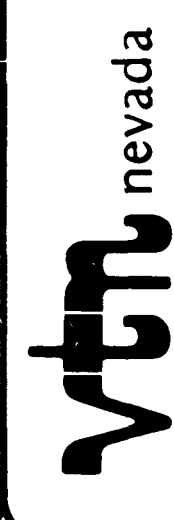

6362

