


CALL BEFORE YOU DIG

CAN YOU DIG IT!

1-800-227-2600

(48Hrs. Advance Notice Required)


H# 38847 DWG# 107V5477 GAS

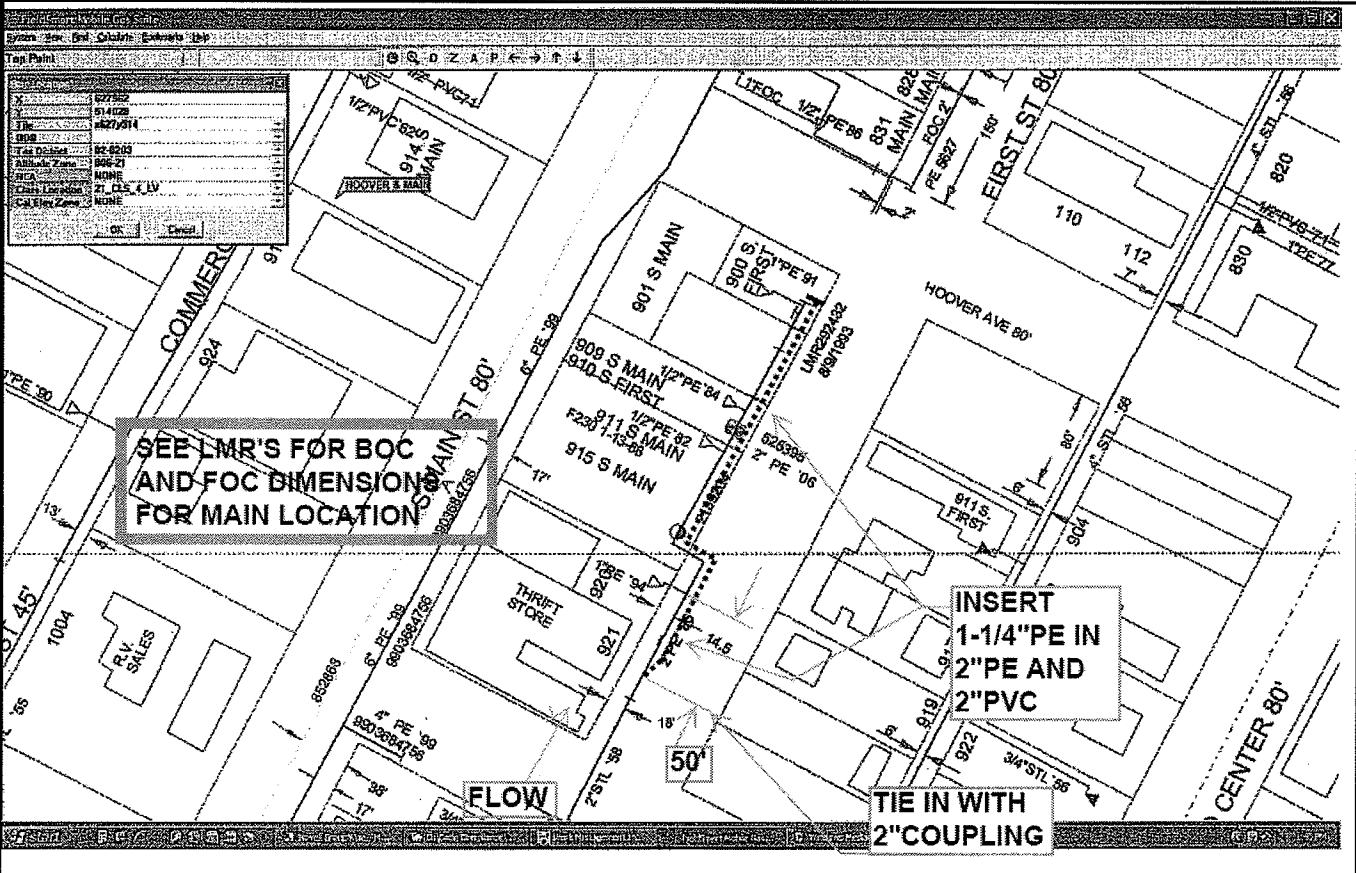

APPROVALS:

[Signature] 7/13/2010
 City DATE

WR: 1205753
T-R-S:
EST START DATE: 07/13/10
PUPOSE OF WORK: Replace damaged main by Inserting into existing main



SOUTHWEST GAS CORPORATION
 (702) 365-2173

LOCATION:
 Hoover and First St.