


13-101

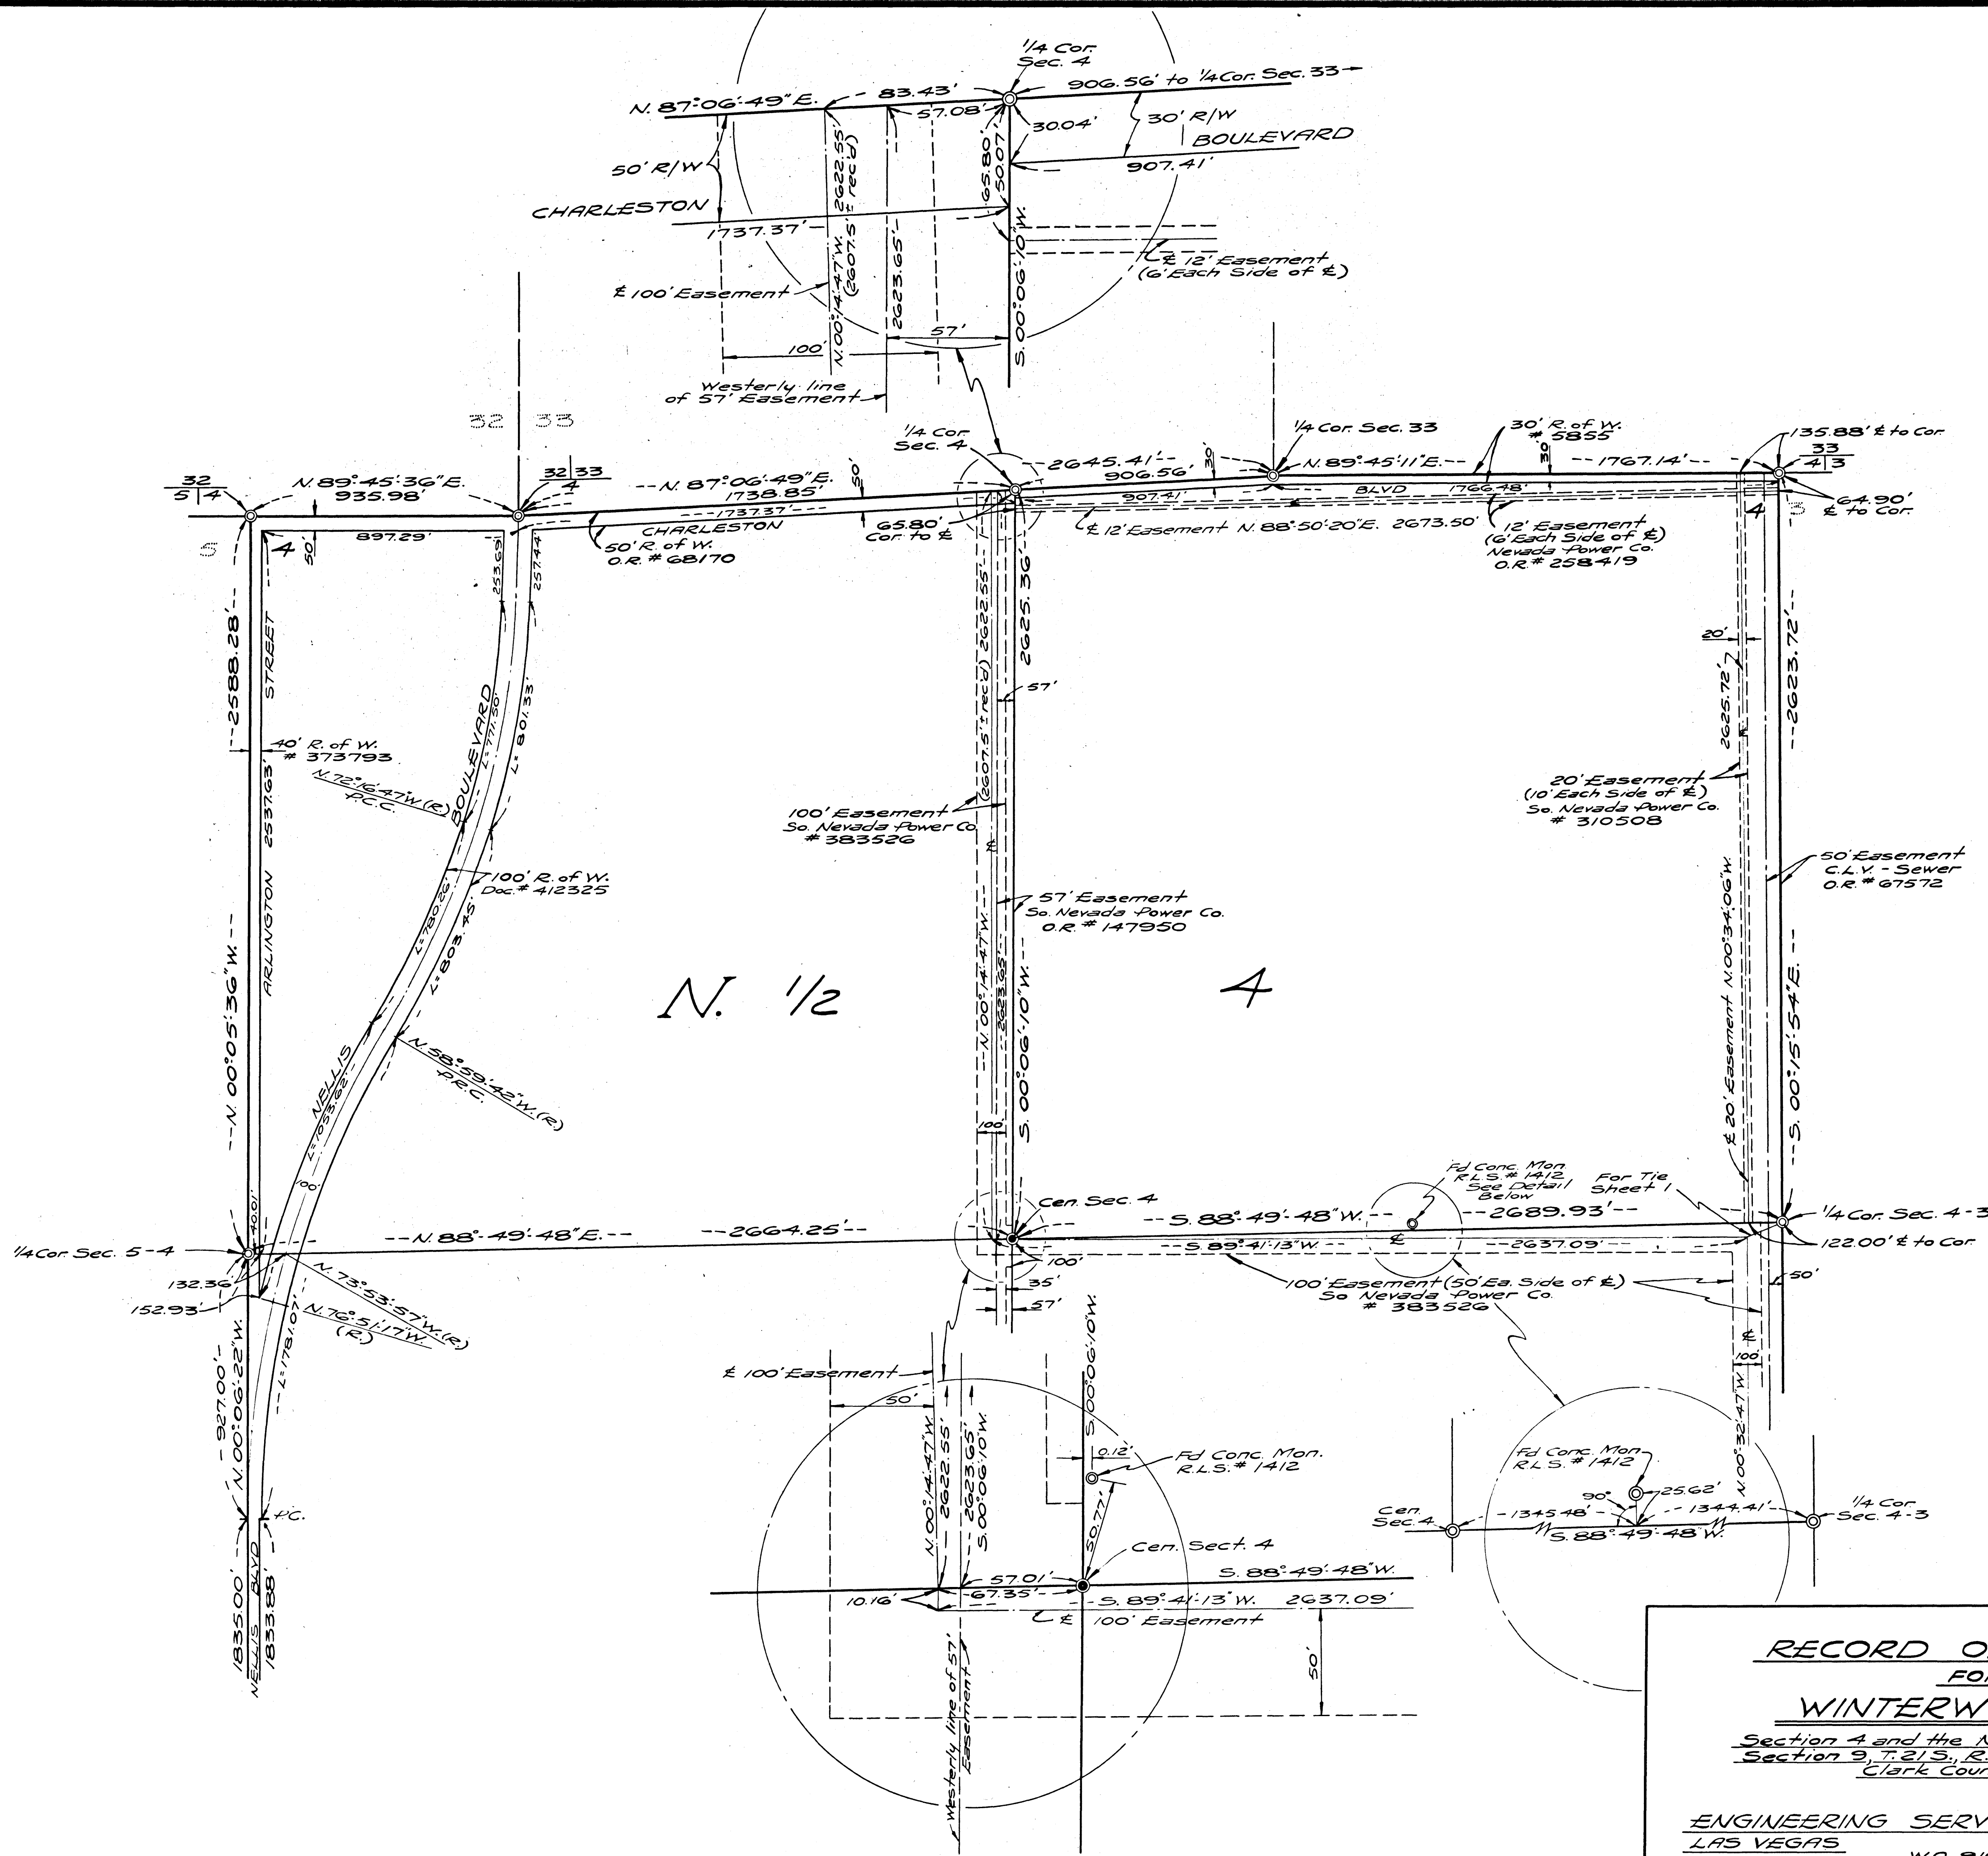

**RECORD OF SURVEY  
FOR  
WINTERWOOD, INC.**

Section 4 and the North Half (N 1/2) of  
Section 9, T. 21 S., R. 62 E., M. D. B. # M.,  
Clark County, Nevada

**ENGINEERING SERVICE CORPORATION**  
LAS VEGAS NEVADA

W.O. 9101-6