


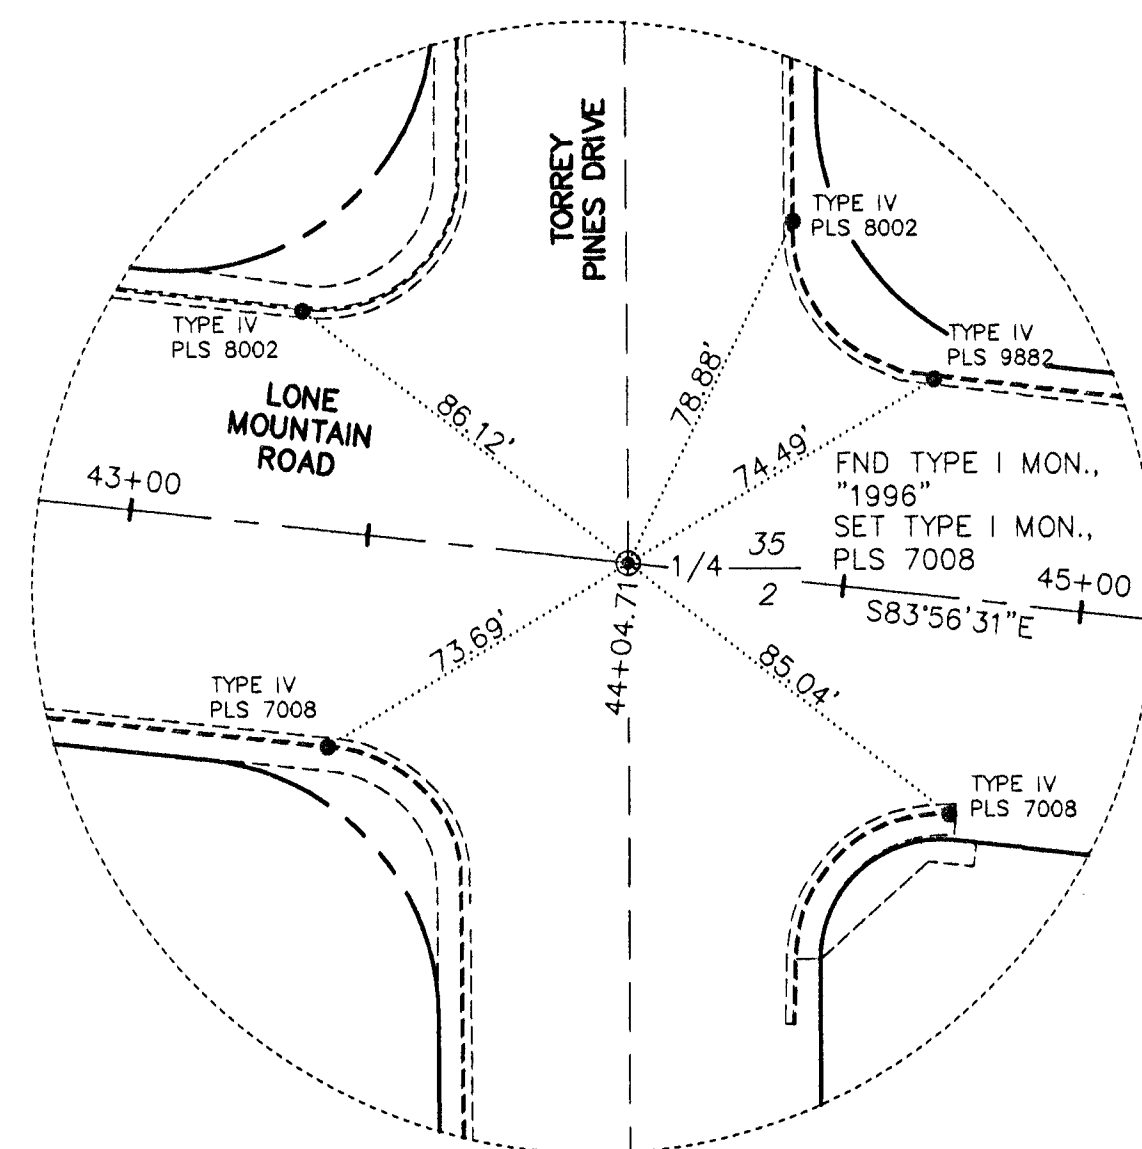


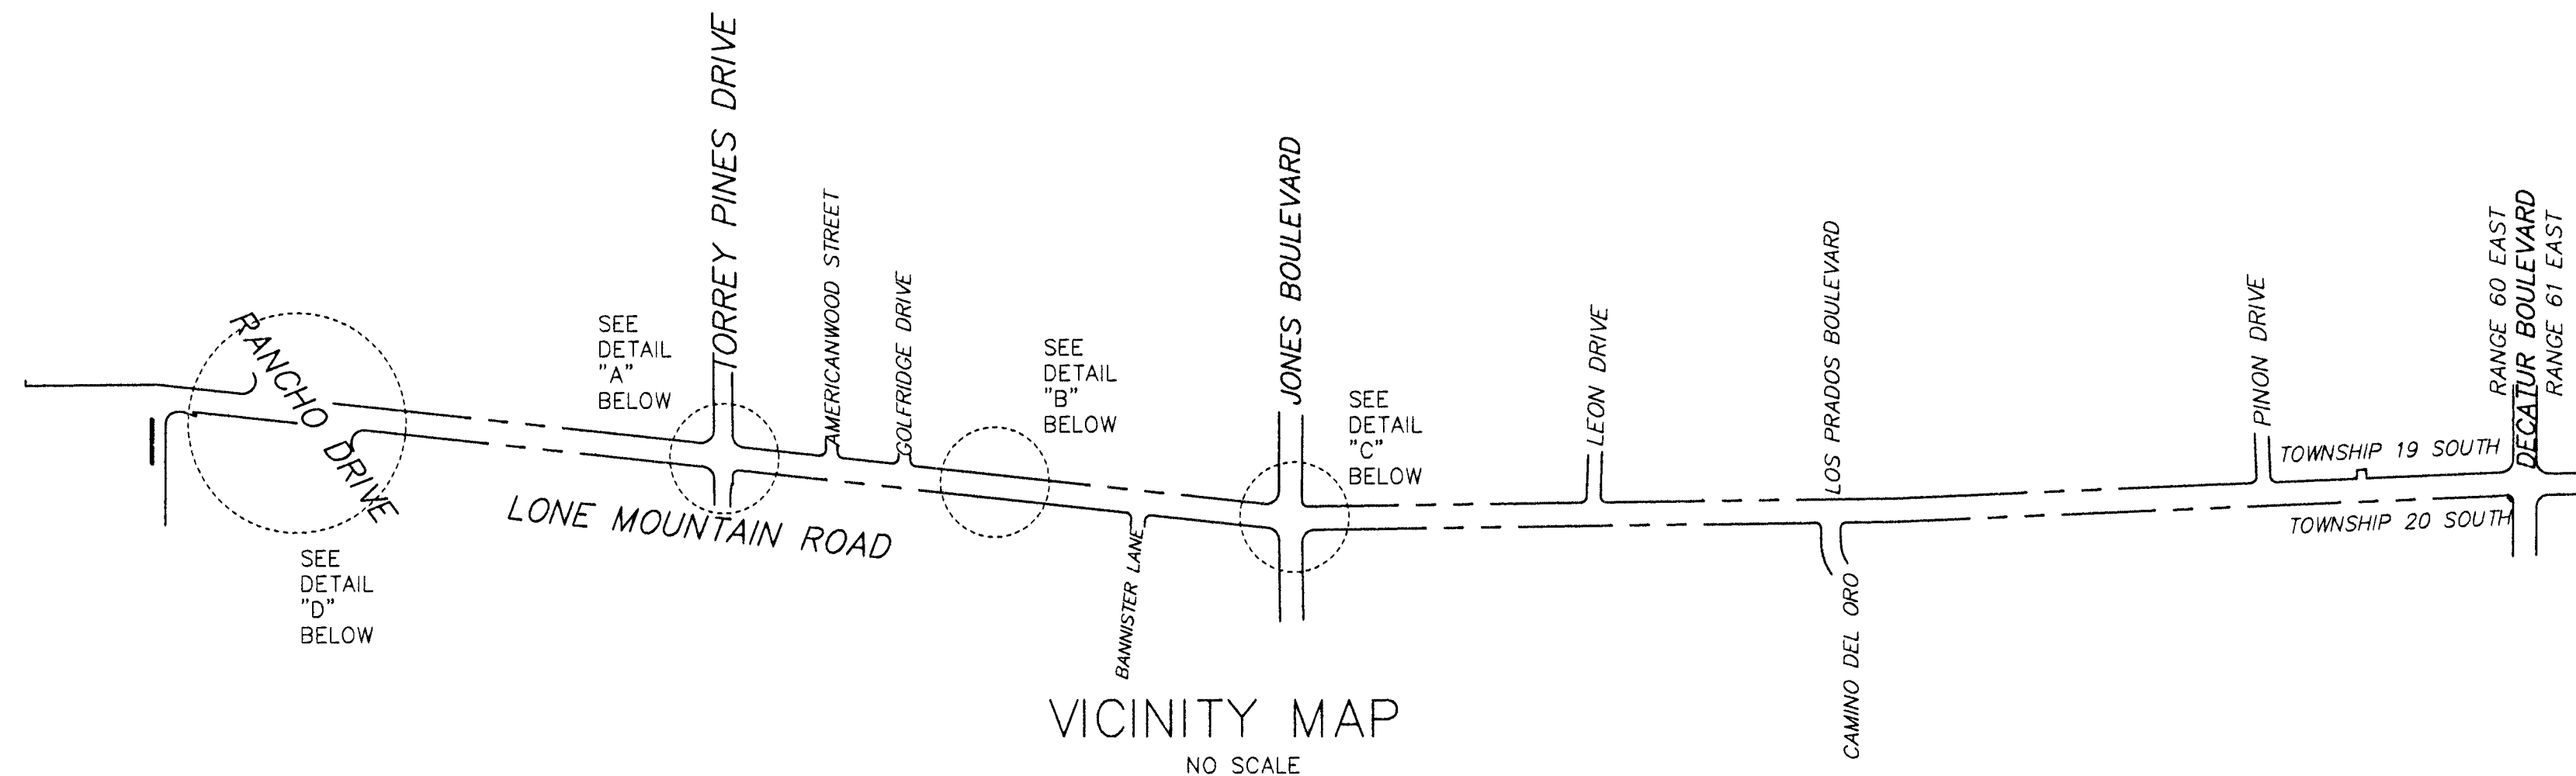


DETAIL "A"

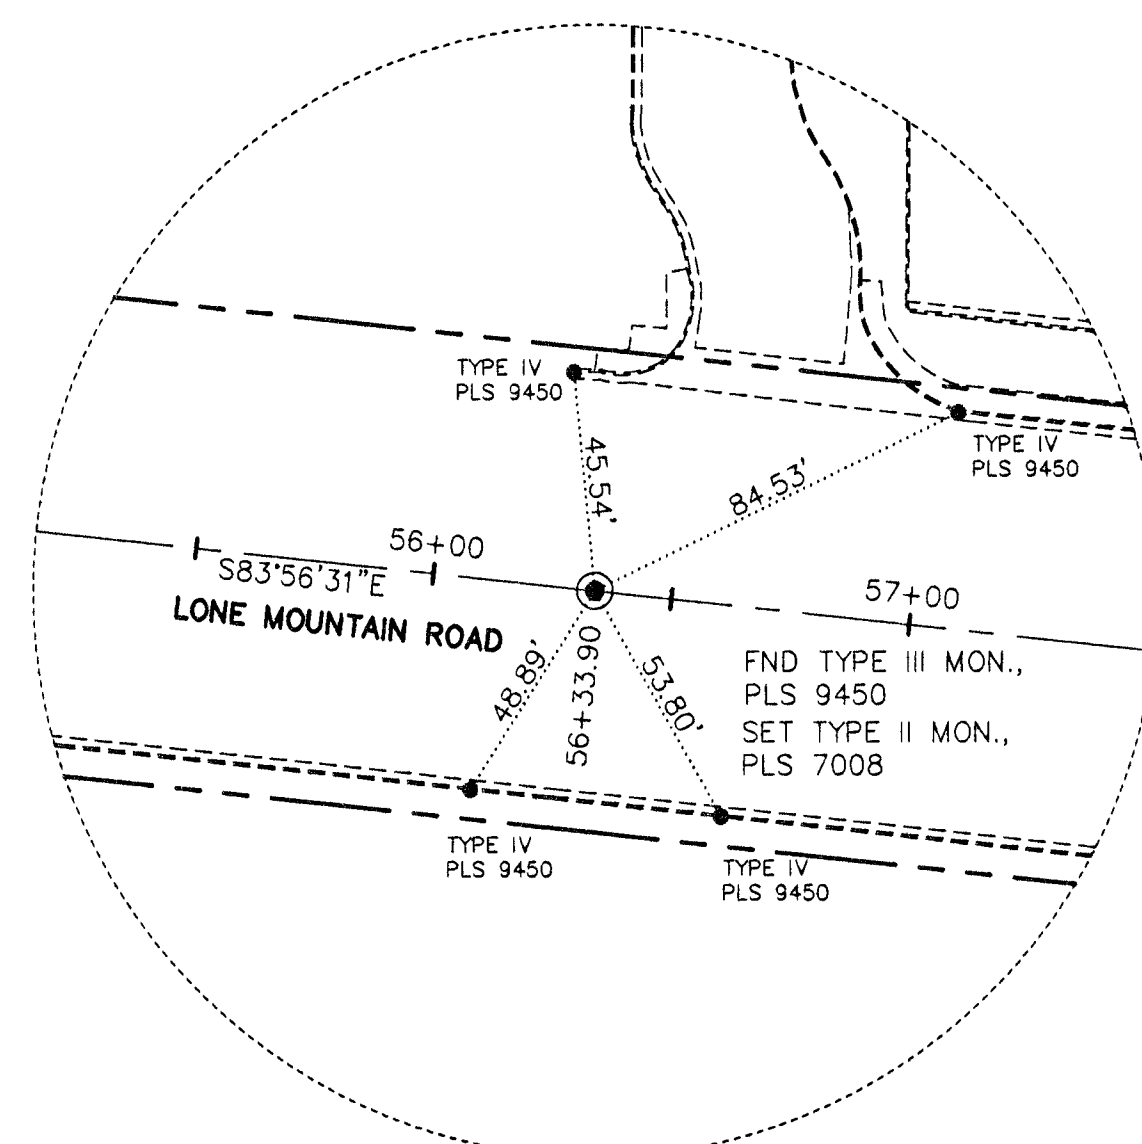


DETAIL "B"

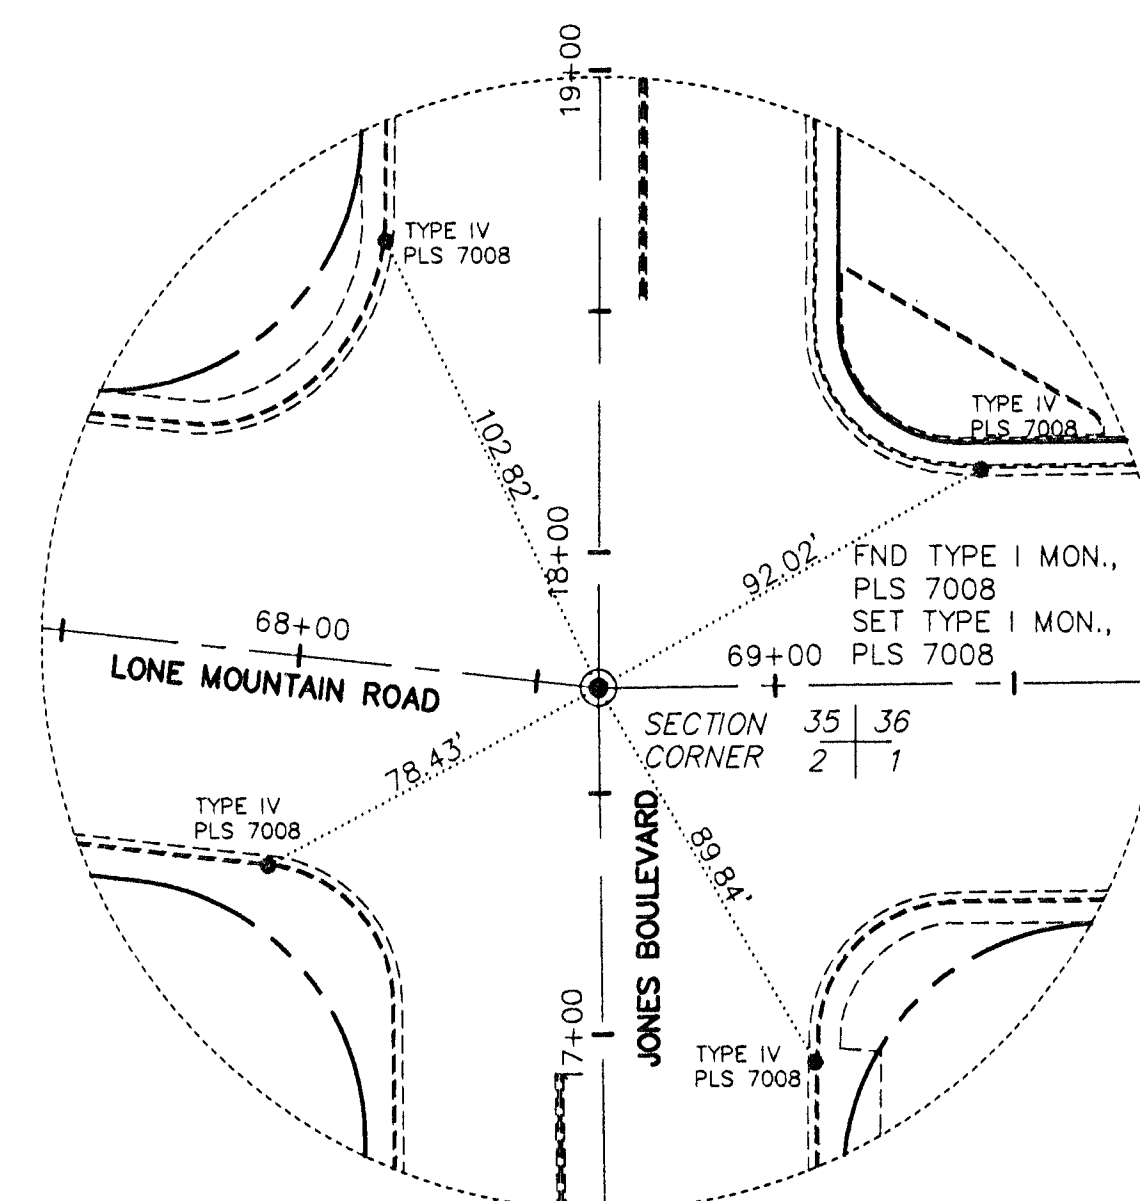

DETAIL "C"

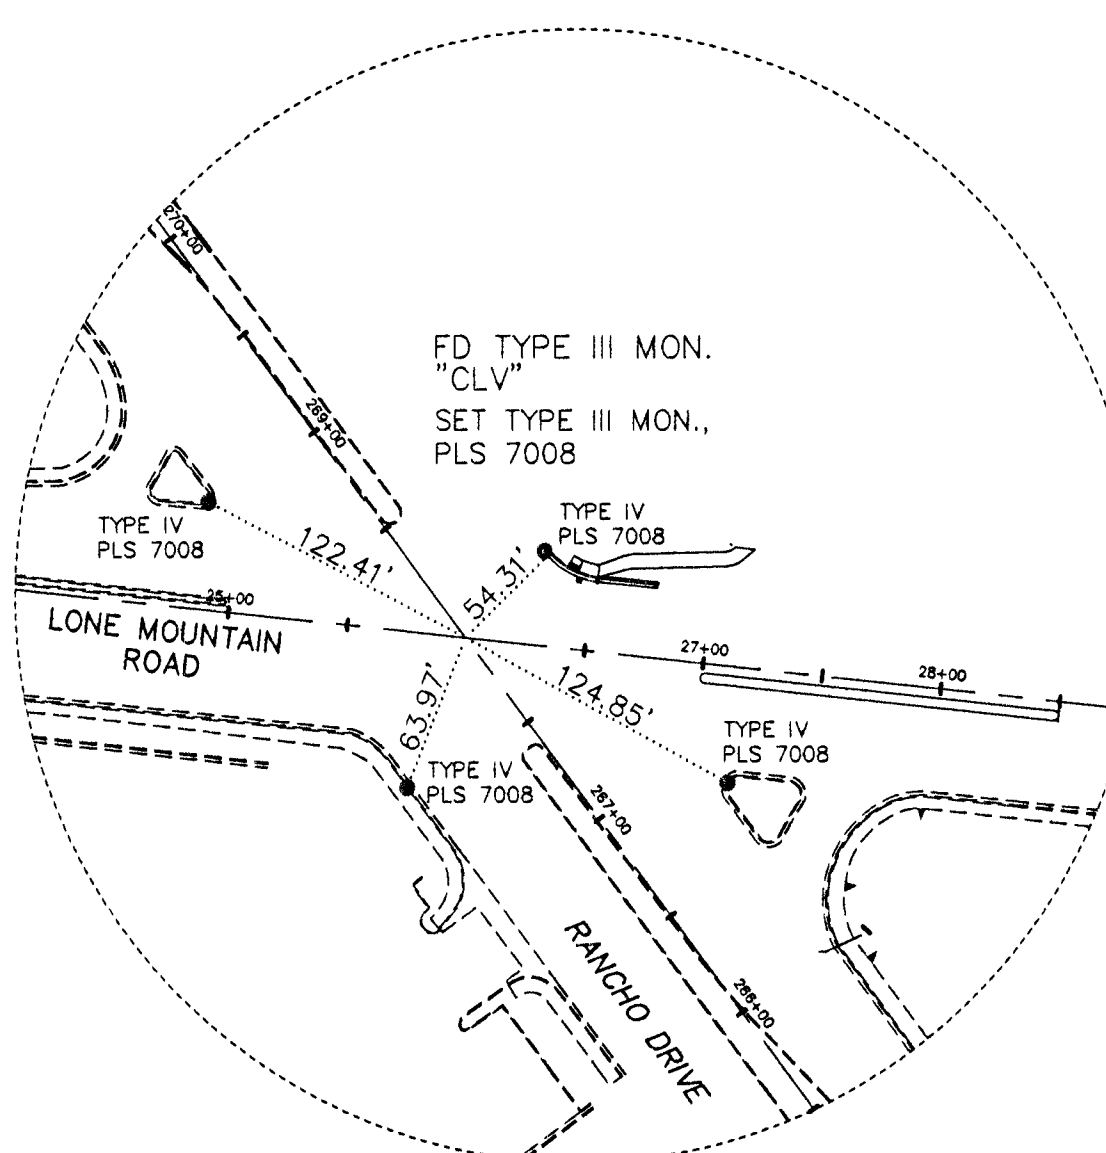

DETAIL "D"

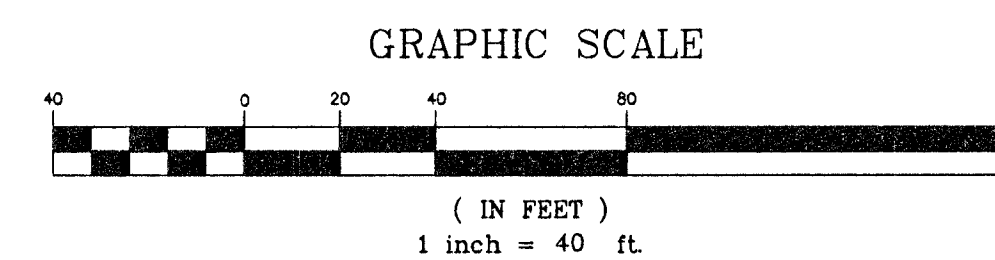


SURVEYOR'S CERTIFICATE

I, GERALD L. WIRTHLIN, A PROFESSIONAL LAND SURVEYOR IN THE STATE OF NEVADA, DO HEREBY CERTIFY THAT:

1. THIS PLAT REPRESENTS THE RESULTS OF A SURVEY CONDUCTED UNDER MY DIRECT SUPERVISION AT THE INSTANCE OF LAS VEGAS PAVING CORP.
2. THE LANDS SURVEYED LIE WITHIN THE SOUTH 1/2 OF SECTIONS 35 and 36, T.19 S., R.60 E., and THE NORTH 1/2 OF SECTIONS 1 and 2, T.20 S., R.60 E., M.D.M..
3. THIS PLAT COMPLIES WITH THE APPLICABLE STATE STATUTES AND ANY LOCAL ORDINANCES IN EFFECT ON THE DATE THAT THE GOVERNING BODY GAVE ITS FINAL APPROVAL.
4. THE MONUMENTS DEPICTED ON THE PLAT WILL BE OF THE CHARACTER SHOWN, OCCUPY THE POSITIONS INDICATED BY June 29, 2012
5. THIS SURVEY WAS COMPLETED ON 6/29/2012
6. CERTIFY THAT THE MONUMENTS HAVE BEEN SET AND THE TIE DISTANCES ESTABLISHED AS SHOWN HEREON

GERALD L. WIRTHLIN
PROFESSIONAL LAND SURVEYOR
NEVADA CERTIFICATE No. 7008

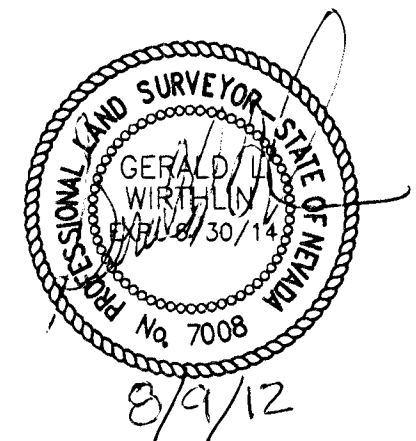

BASIS OF BEARINGS

THE BASIS OF BEARINGS FOR THIS SURVEY IS N00°08'16"E, BEING THE BEARING BETWEEN CLARK COUNTY GIS MONUMENT "909" and GIS MONUMENT "803" AS SHOWN IN FILE 88, PAGE 53 OF RECORDED SURVEYS, OFFICIAL RECORDS, CLARK COUNTY, NEVADA.

LEGEND

- SET MONUMENT AS INDICATED
- SET/FND TYPE IV REFERENCE MONUMENT
- CURB LINE
- CENTERLINE
- RIGHT OF WAY LINE
- TIE LINE

RECORDER'S NOTE

ANY SUBSEQUENT CHANGES TO THIS MAP SHOULD BE EXAMINED AND MAY BE DETERMINED BY REFERENCE TO THE COUNTY RECORDER'S CUMULATIVE MAP INDEX. N.R.S. 278.5695

AMENDED RECORD OF SURVEY MONUMENTATION MAP A PORTION OF THE SOUTH 1/2 OF SECTIONS 35 and 36, T.19 S., R.60 E. A PORTION OF THE NORTH 1/2 OF SECTIONS 1 and 2, T.20 S., R.60 E. M.D.M. CLARK COUNTY, NEVADA		No. <u>01715</u> FILED AT THE REQUEST OF: LAS VEGAS PAVING CORP. DATE: <u>07/02/2012</u> AT <u>11:54</u> A.M. FILE: <u>186</u> PAGE: <u>0006</u> OF SURVEYS OFFICIAL RECORDS BOOK No. <u>20120702</u> CLARK COUNTY, NEVADA RECORDS DEBBIE CONWAY, RECORDER FEE: <u>\$24.00</u> DEPUTY <u>SCA</u>
LAS VEGAS PAVING CORPORATION LAS VEGAS PAVING CORP. GERALD "CROCKETT" WIRTHLIN PLS #7008 055-761		649-0009 OFFICE 353-4363 MOBILE

186-0086

C.P. # 23100