


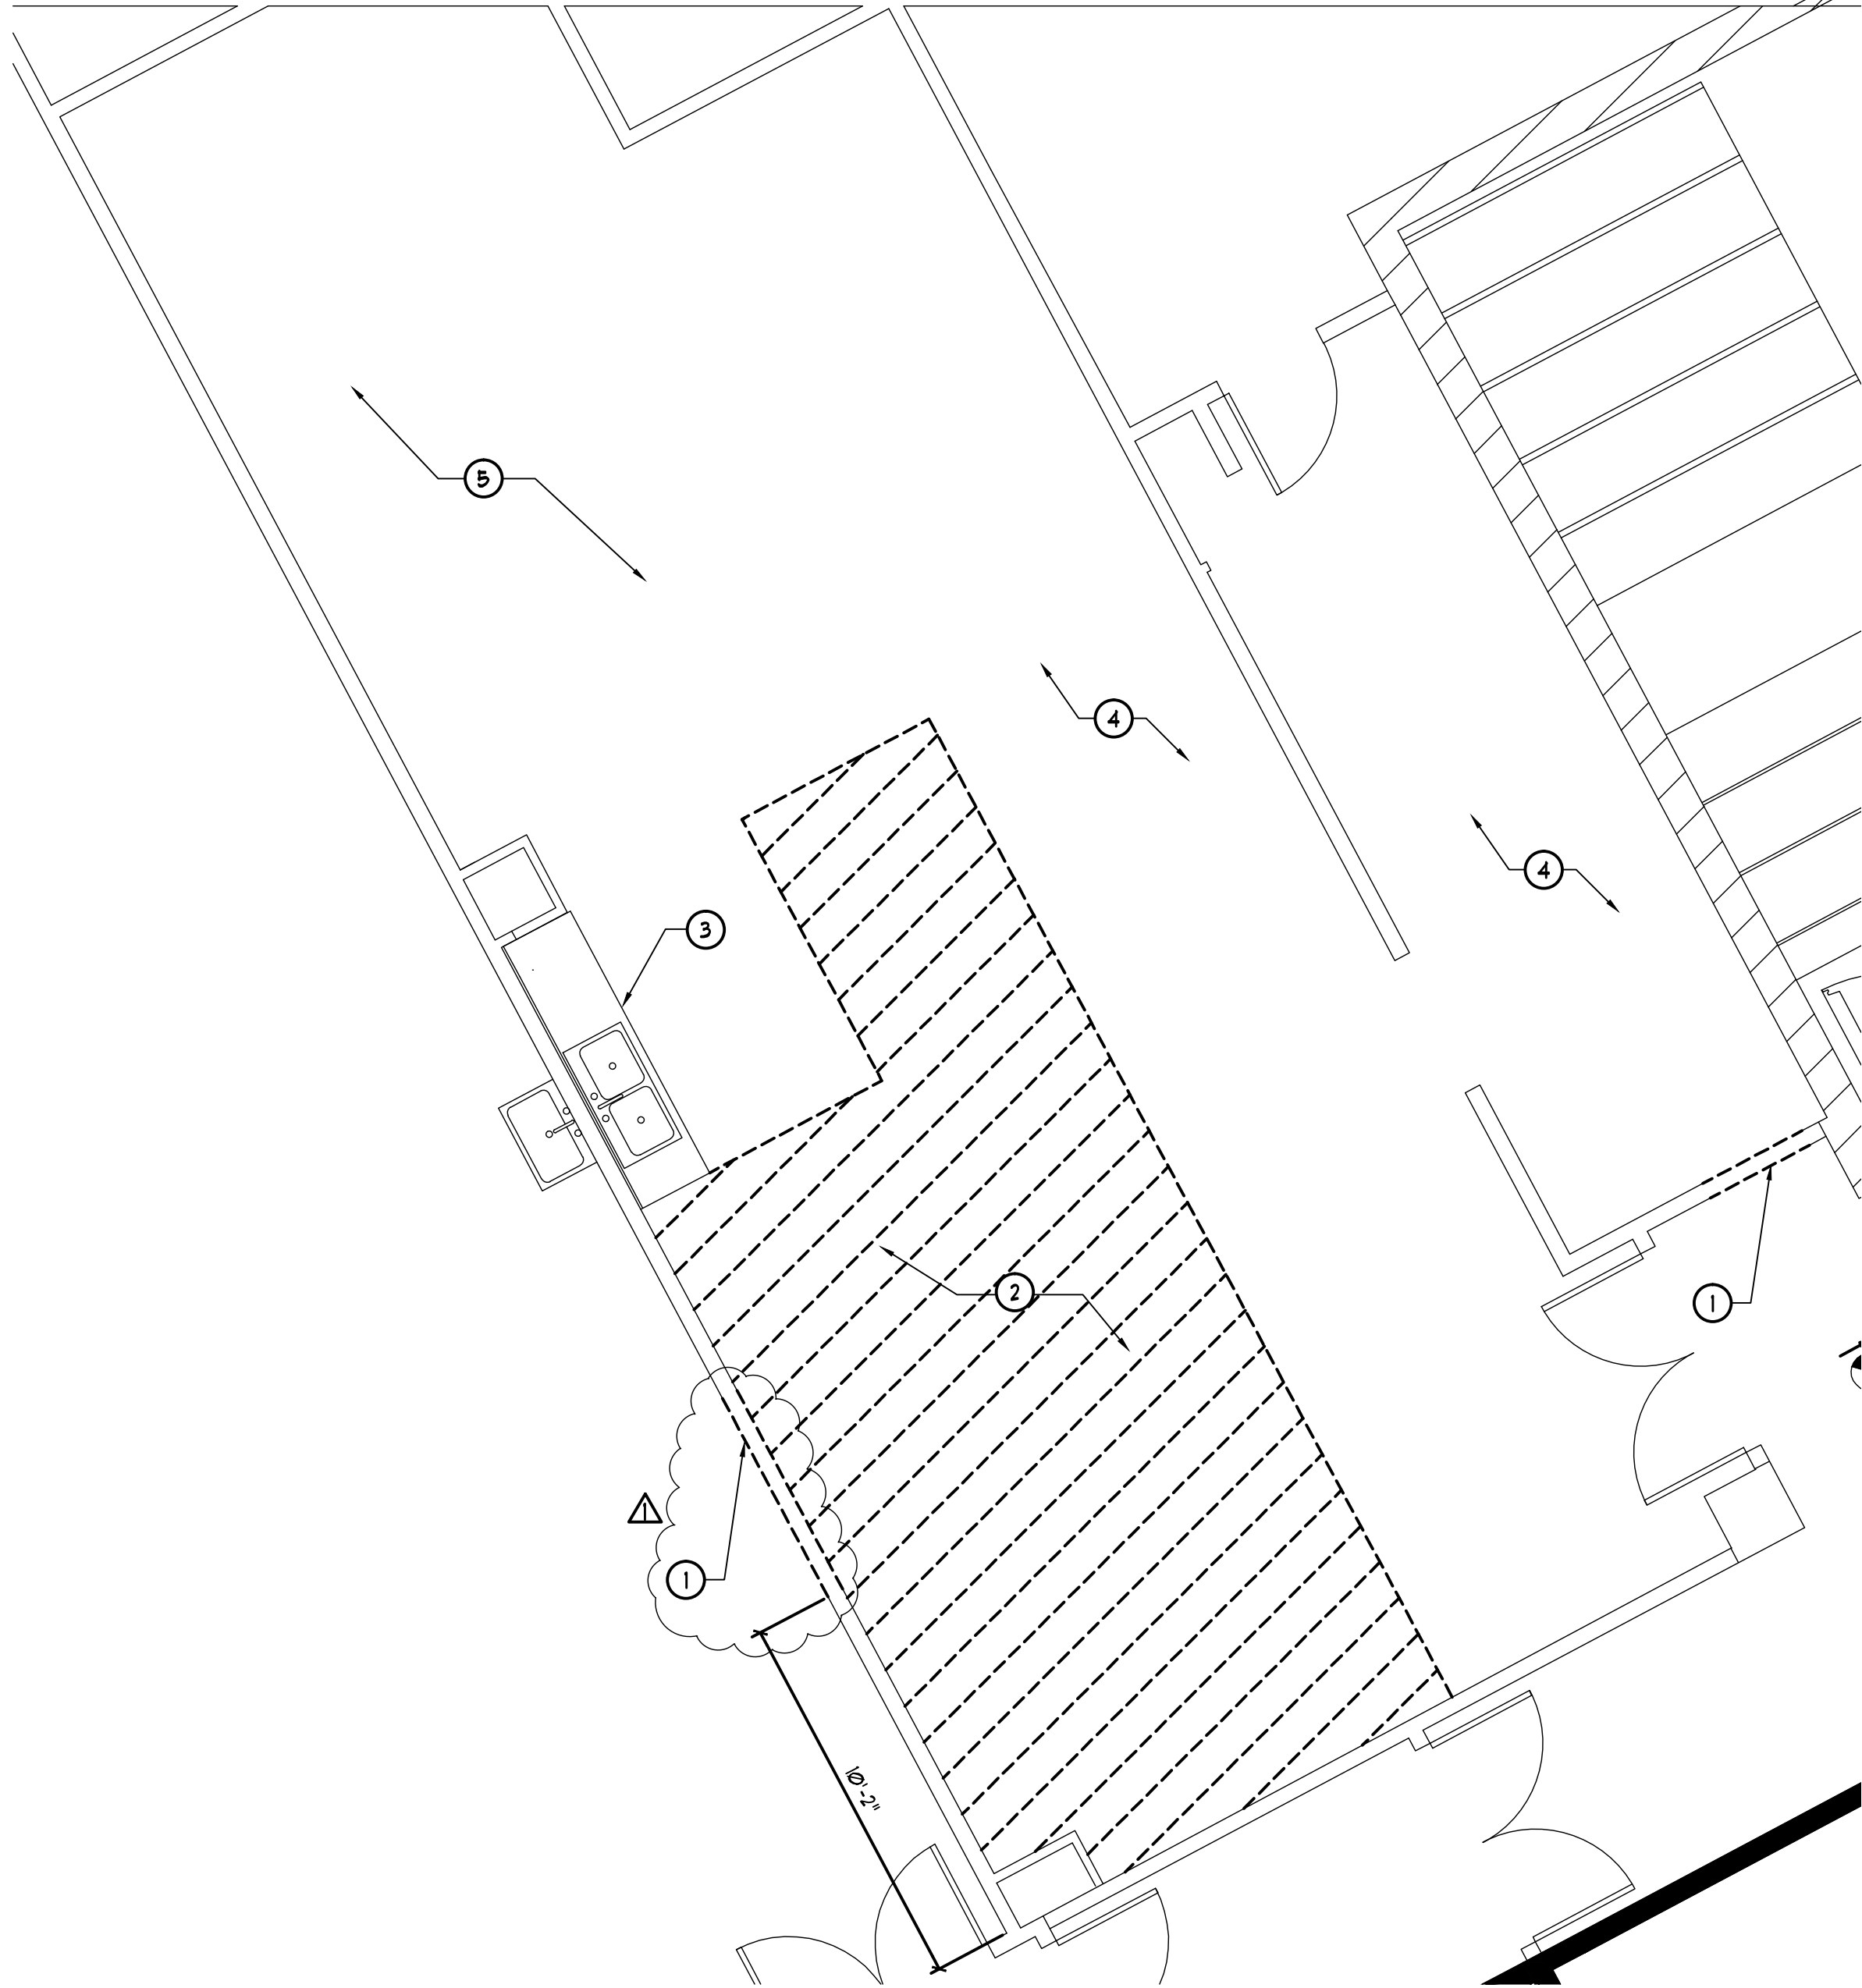


Basement Demolition Plan


Scale: 1/4" = 1'-0"

Demolition Plan Notes

- 1 REMOVE PORTION OF WALL AS REQUIRED FOR NEW DOOR
- 2 REMOVE AREA OF CARPET AS SHOWN - PREP FOR NEW FLOOR
- 3 EXISTING CASEWORK TO REMAIN - PROTECT DURING CONSTRUCTION
- 4 EXISTING RESILIENT FLOORING TO REMAIN - PROTECT DURING CONSTRUCTION
- 5 EXISTING CARPET TO REMAIN - PROTECT DURING CONSTRUCTION

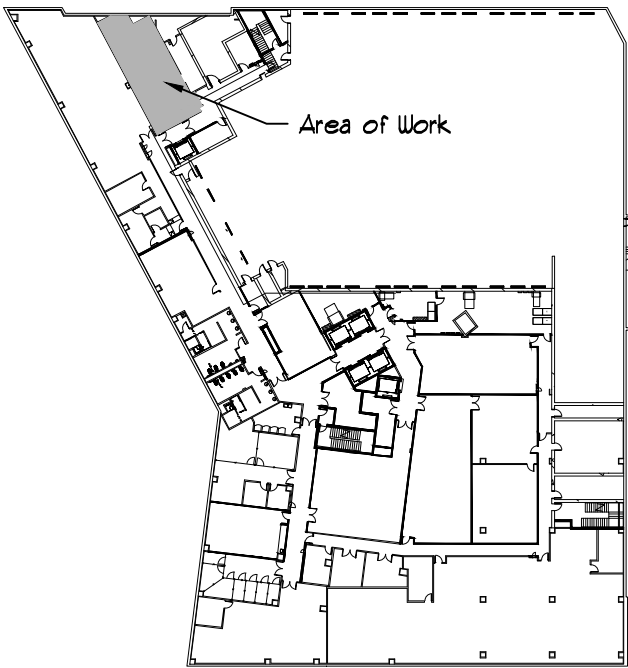

Key Plan

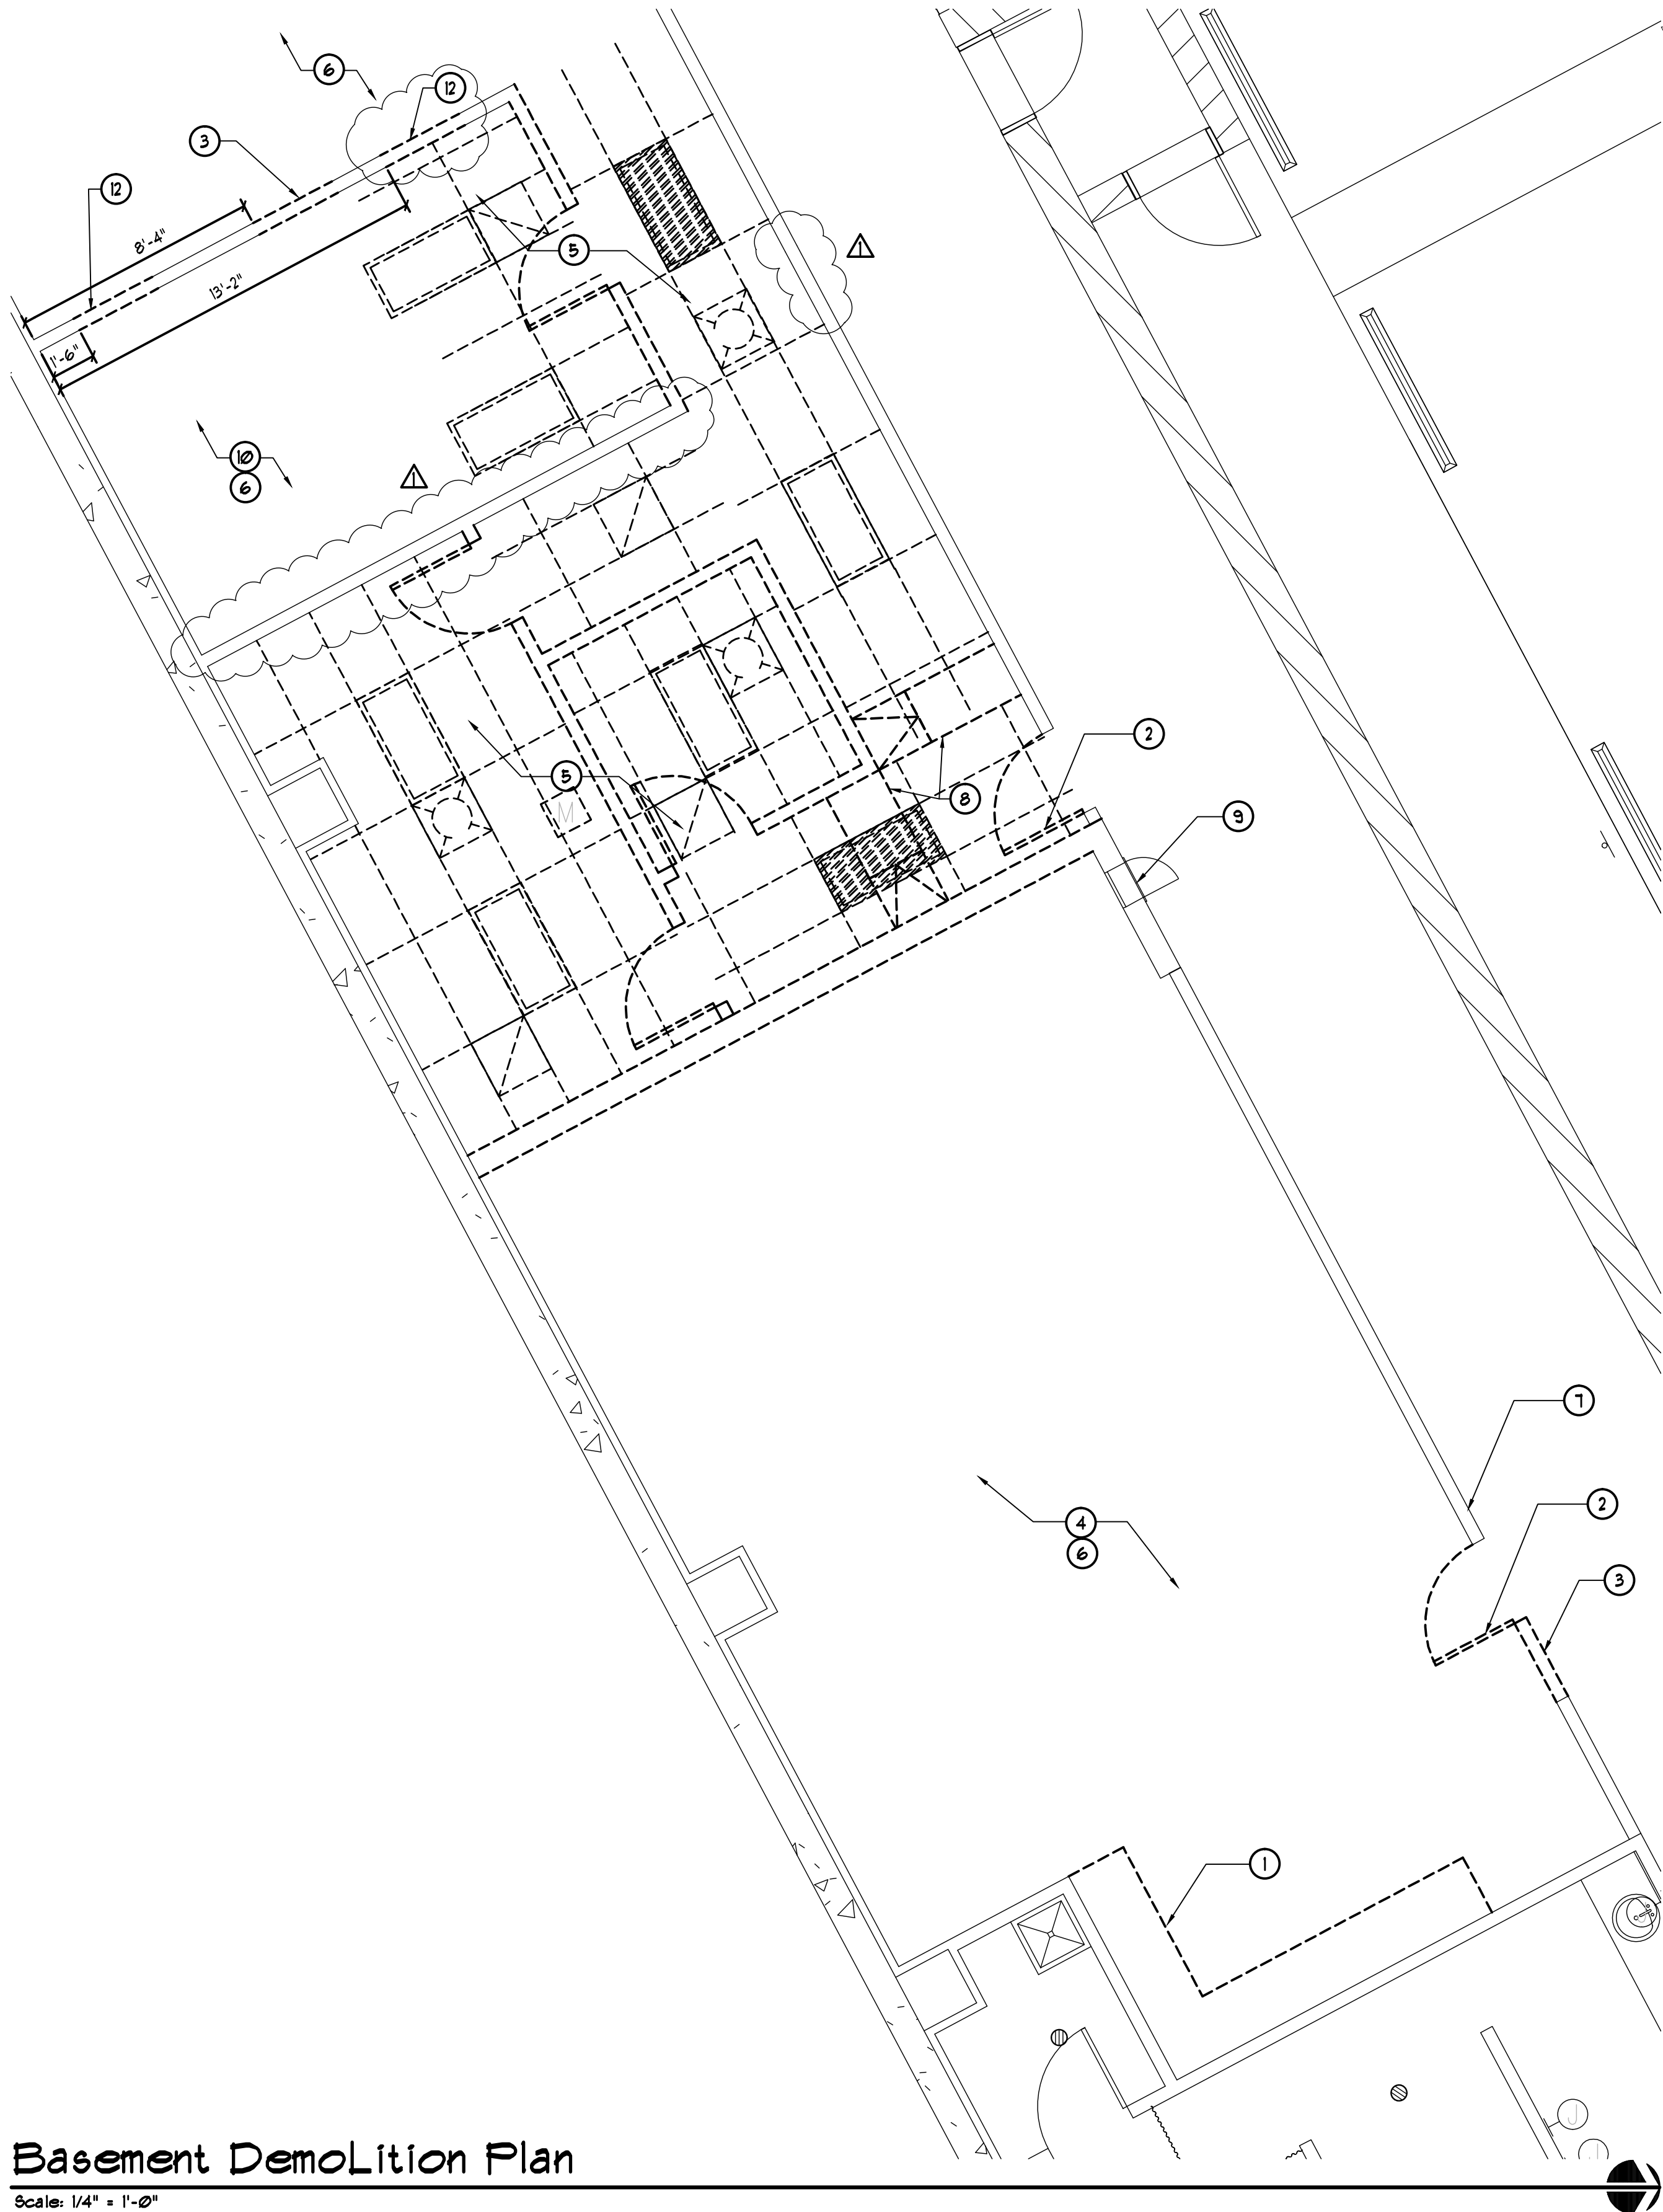

Basement Demolition Plan


Scale: 1/4" = 1'-0"

Demolition General Notes

- 1. PROVIDE BARRIER PROTECTION BETWEEN WORK AREA AND EXISTING PRINT SHOP TO PREVENT DUST MIGRATION. REVIEW PLAN WITH PRINT SHOP MANAGER PRIOR TO START OF WORK
- 2. COMPLETE ALL WORK ASSOCIATED WITH THE NEW MAILROOM PRIOR TO STARTING WORK ON THE NEW FITNESS CENTER

Demolition Plan Notes

- 1 EXISTING COUNTER TO BE REMOVED - PATCH/PAINT WALL AS REQUIRED
- 2 EXISTING DOOR AND FRAME TO BE REMOVED - SALVAGE HARDWARE AND DOOR
- 3 REMOVE PORTION OF WALL AS REQUIRED FOR NEW DOOR(S)
- 4 REMOVE EXISTING RESILIENT FLOORING AND BASE - PREP FOR NEW FLOOR
- 5 REMOVE EXISTING WALLS, CARPET, BASE, CEILING, ETC IN DEMOLITION AREA. SALVAGE EXISTING DOORS, HARDWARE, CEILING TILES, LIGHTS, REGISTERS, T-STAT, ETC.
- 6 PROTECT CEILING, LIGHTS, ETC IN THIS AREA
- 7 EXISTING CARD READER - DISCONNECT FROM DOOR TO BE REMOVED
- 8 EXISTING CASEWORK TO BE REMOVED
- 9 EXISTING FIRE EXTINGUISHER CABINET - PROTECT DURING CONSTRUCTION
- 10 EXISTING CARPET TO REMAIN - PROTECT DURING CONSTRUCTION
- 11 NOT USED
- 12 REMOVE PORTION OF WALL AS REQUIRED FOR NEW WINDOW - RELOCATED ELECTRICAL/LOW VOLTAGE OUTLETS AS REQUIRED

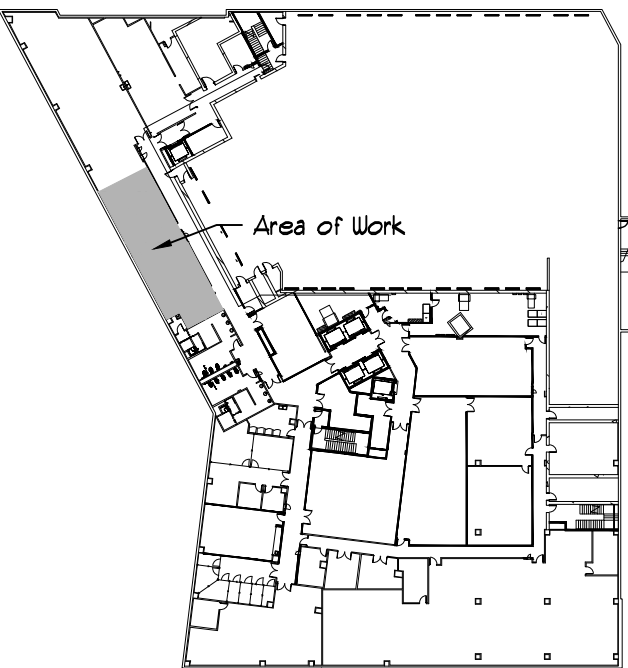

Key Plan



REVISIONS
Owner Revision 10/31/12

CONSULTANT

City Hall Fitness Center
495 South Main Street
Demolition Plans

STAMP

OWNER: CITY OF LAS VEGAS
Department of Operations & Maintenance

3104 East Bonanza Road
LAS VEGAS, NEVADA 89101
PHONE: (702) 229-6220
FAX: (702) 382-0619
TDD: (702) 386-9106

DRAWN map

DATE October 2012

SCALE

RID NO

CLV DWG NO 521-298-FC

SHT NO

D1

Department of Operations and Maintenance

ALL RIGHTS ARE RESERVED BY THE CITY OF LAS VEGAS. NO PART OF THIS DOCUMENT IS TO BE REPRODUCED OR TRANSMITTED IN ANY FORM OR BY ANY MEANS, ELECTRONIC OR MECHANICAL, INCLUDING PHOTOCOPYING, RECORDING, OR BY ANY INFORMATION STORAGE AND RETRIEVAL SYSTEM, WITHOUT THE WRITTEN PERMISSION OF THE CITY OF LAS VEGAS. 