

PLANNING AND DEVELOPMENT DEPARTMENT  
SCANNING COVER SHEET

Case No: V-0017-77

APN: 139-31-204-001

Location: East side of Bedford Rd btwn Meadows Ln  
and Mayflower Ln

Applicant: Ernest A. Becker

Project Name:

To allow a single family dwelling on a 3,678 sq ft lot where 6,500 sq ft is required; and located 2' from the north side property line and 4' from the south side property line where 5' is required; and permit the roof overhang to the north side property line where 2' is required.




Show street  
loop ends

030-120-018

ROI  
C-1

ROI  
C-1

ROI  
C-1

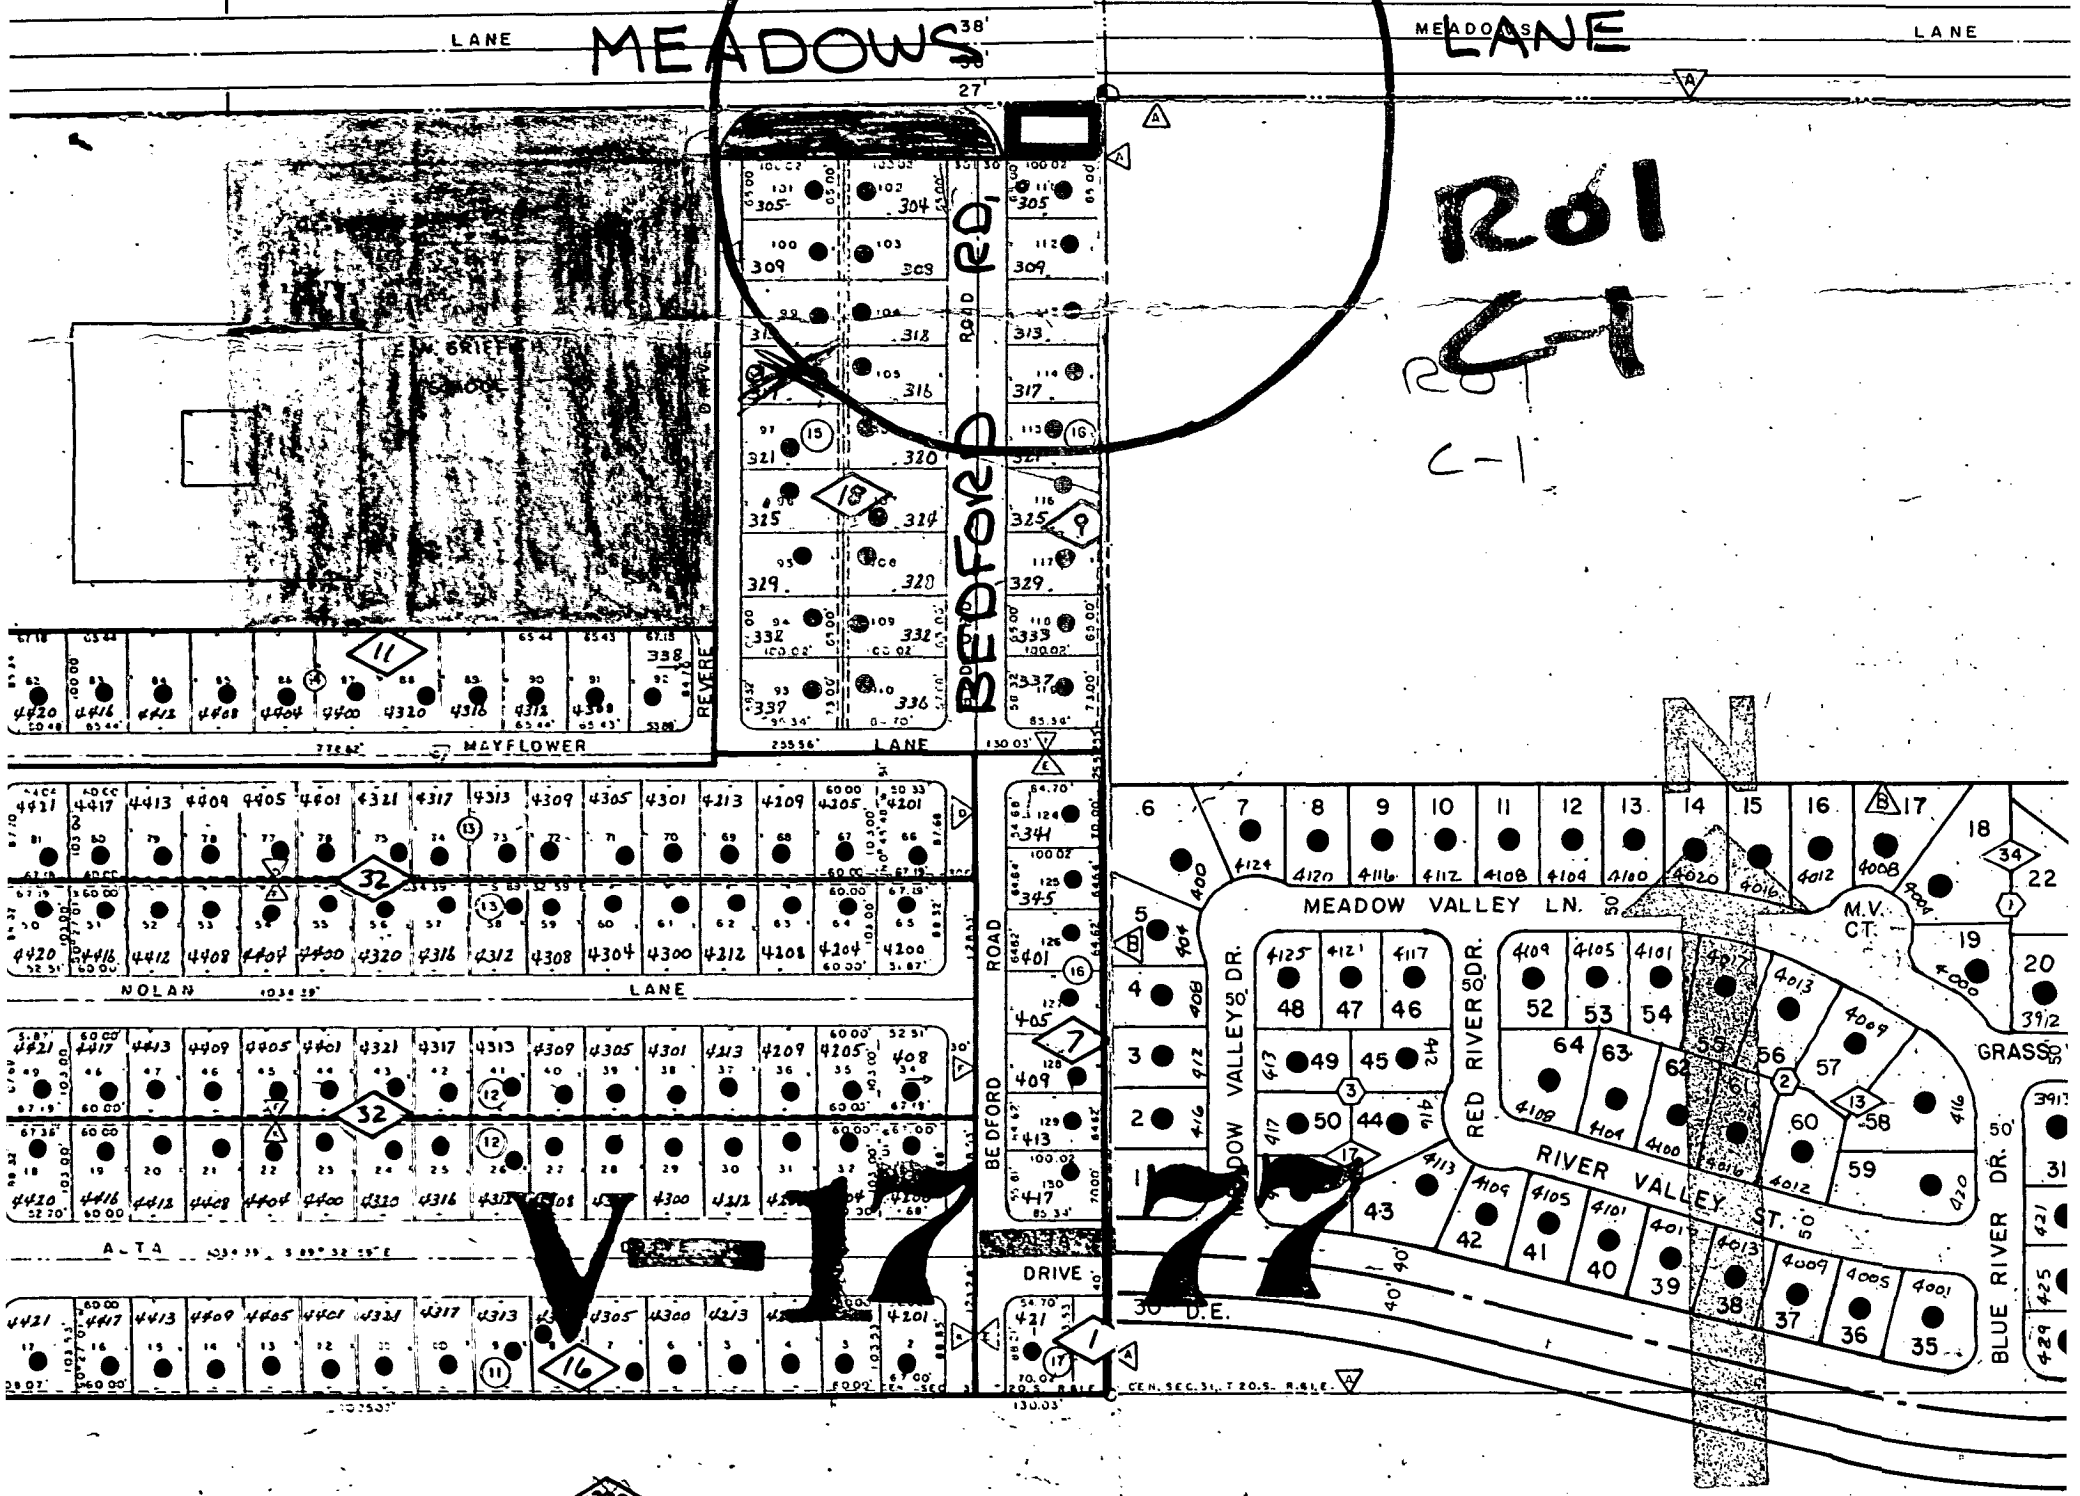

V

S 1/2 NW 1/4 SEC. 31 T20S, R61E

CITY OF LAS VEGAS NEVA.  
PLANNING DEPT.

REV OCT 13 2000

64