


P:\2020\20201011_MountainView Hosp ED Exp\CAD\Construction_Garage\20201011_C5-0_LAY.dwg-C5.0 Site Layout Plan Feb 14, 2023 oparsley

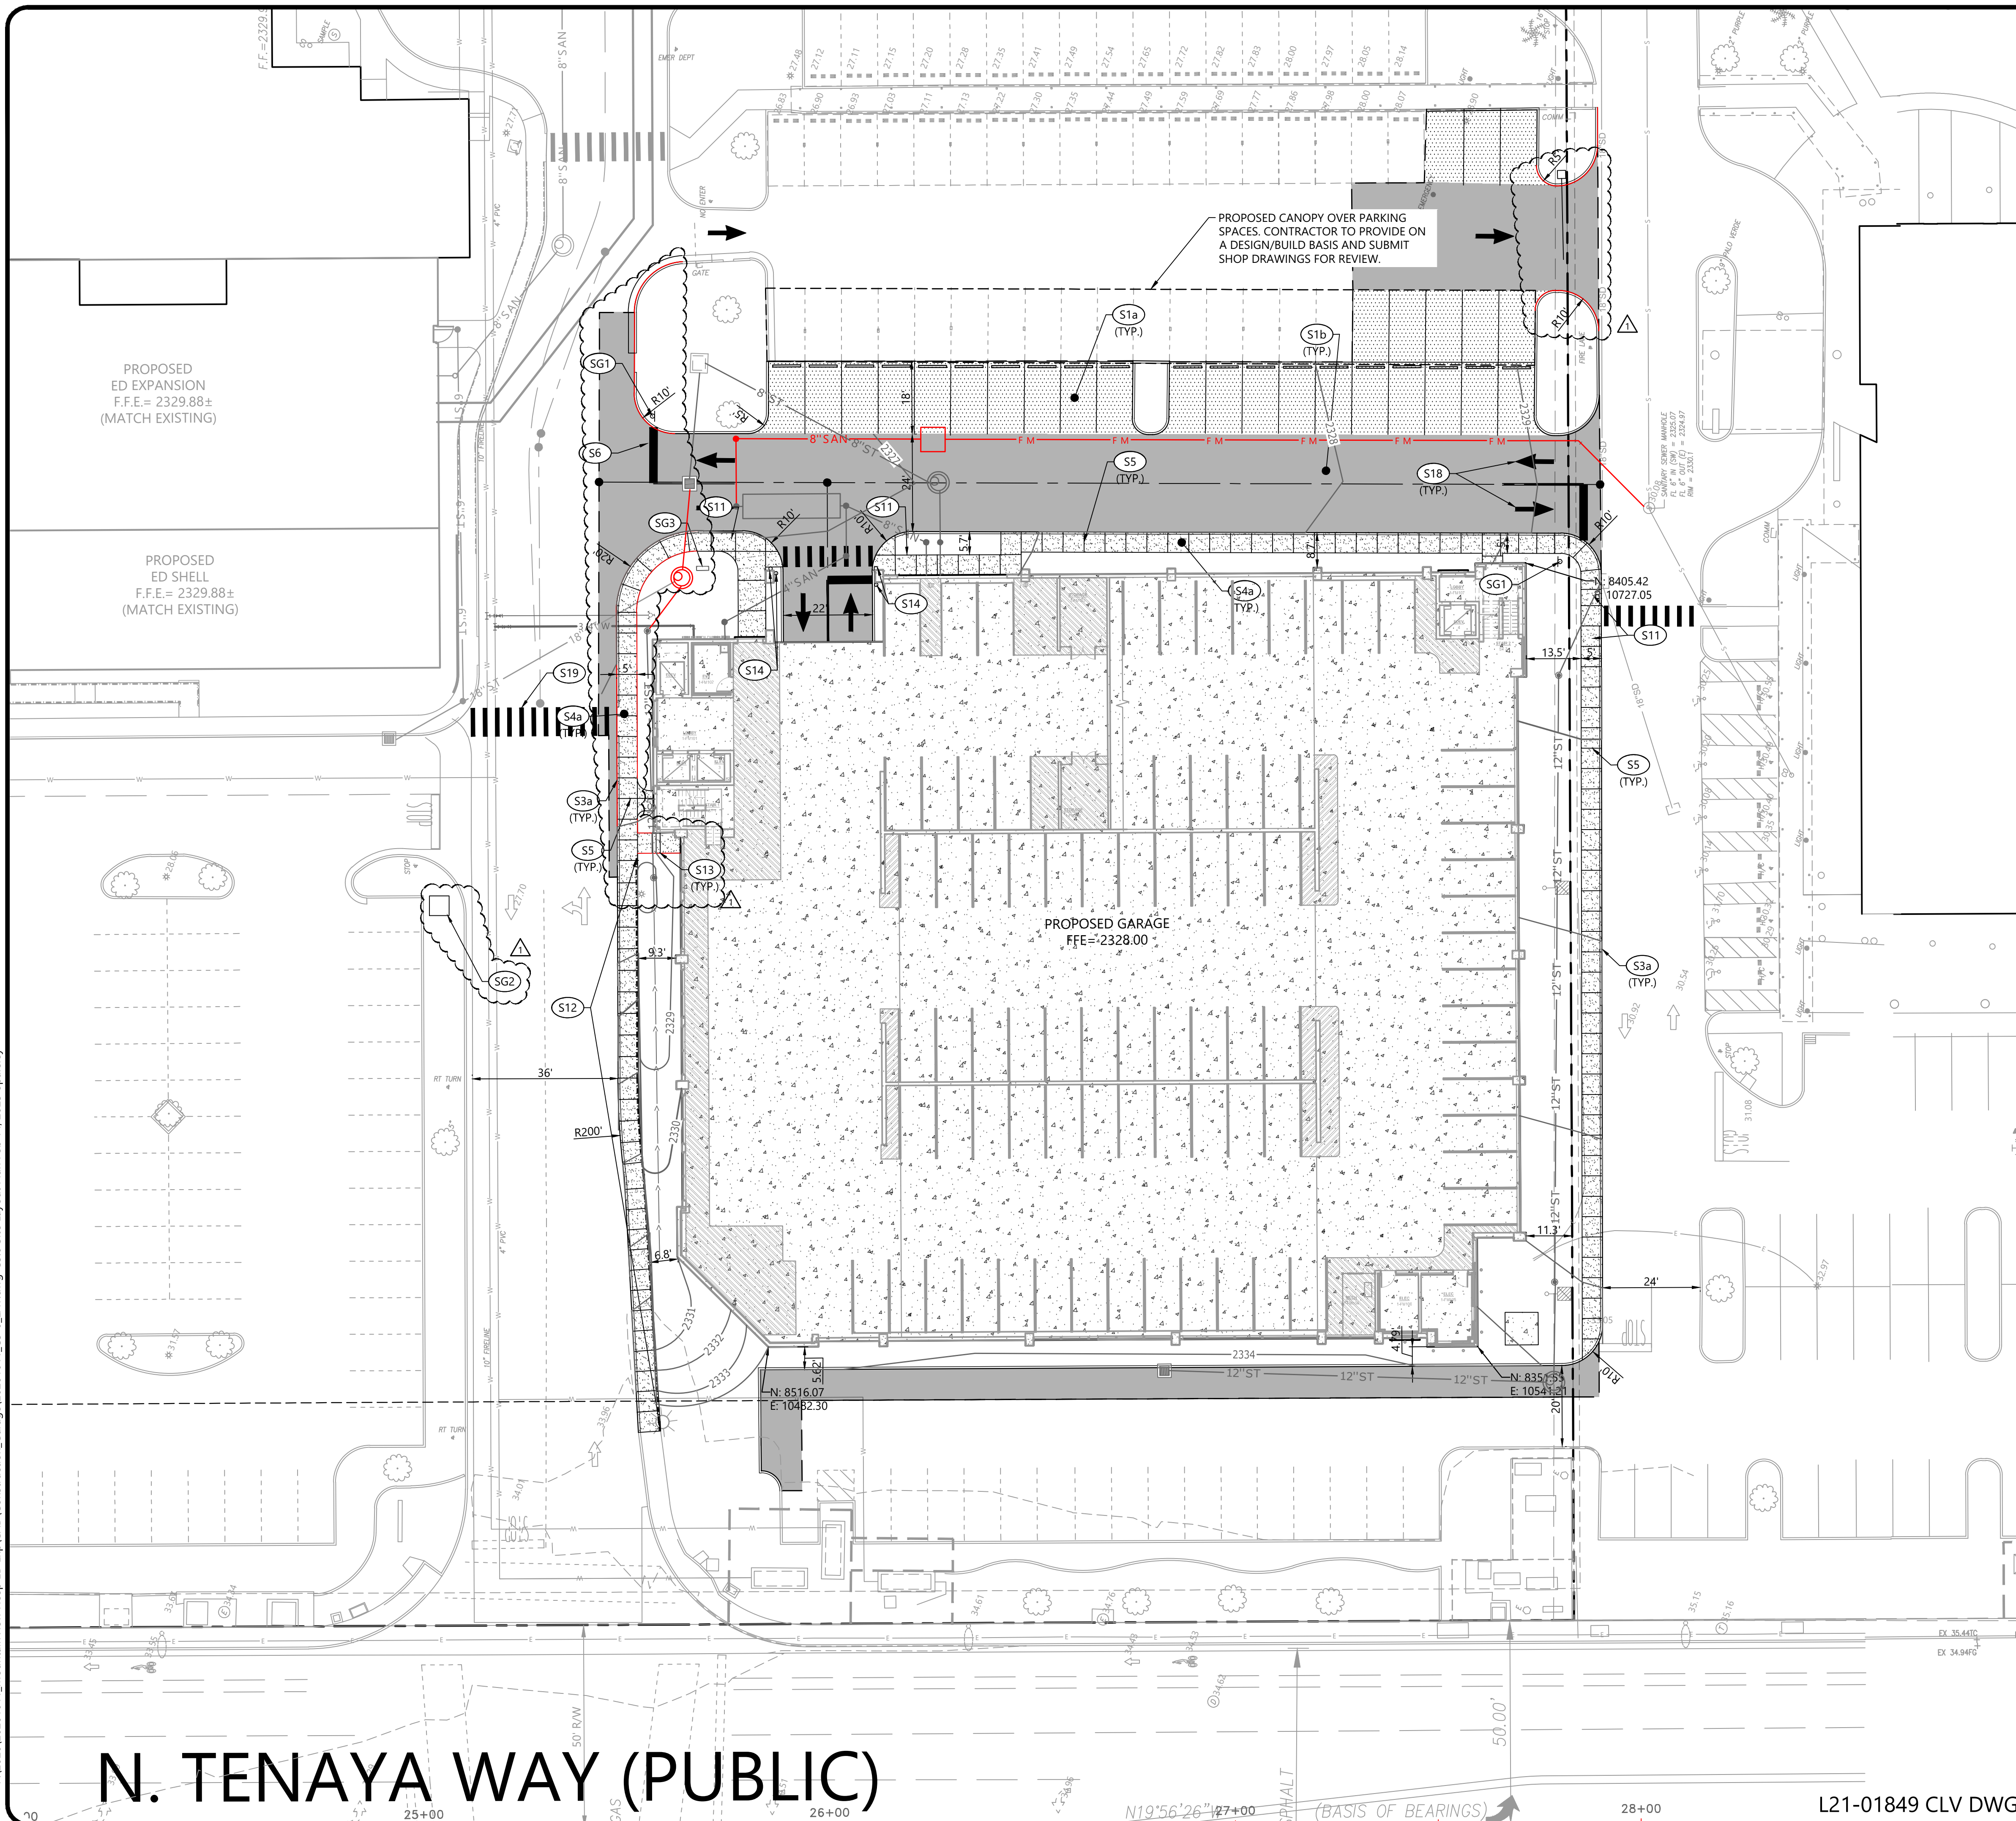

SITE LAYOUT KEYNOTES		
CODE	DESCRIPTION	DET #/SHT #
(S1a)	ASPHALT PAVEMENT - LIGHT DUTY	1 / C8.0
(S1b)	ASPHALT PAVEMENT - HEAVY DUTY	1 / C8.0
(S3a)	CONCRETE POST CURB	5 / C8.0
(S4a)	CONCRETE SIDEWALK	3 / C8.0
(S5)	SIDEWALK JOINTS	4 / C8.0
(S6)	PAINTED STOP BAR (24")	10 / C8.0
(S11)	ACCESSIBLE CURB RAMP	6 / C8.0
(S12)	ELEVATED WALK WITH HANDRAIL	7 / C8.0
(S13)	CONCRETE STAIRS	7 / C8.1
(S14)	BOLLARD	9 / C8.0
(S18)	DIRECTIONAL ARROWS	12 / C8.0
(S19)	PEDESTRIAN CROSSWALK	11 / C8.0




SITE SIGNAGE KEYNOTES		
CODE	DESCRIPTION	DET #/SHT #
(SG1)	"STOP" SIGN	6 / C8.1
(SG2)	MONUMENT SIGN	SEE ARCH PLANS
(SG3)	PARKING COUNTER	SEE ARCH PLANS

PROPOSED FEATURES LEGEND

BUILDING	
CONCRETE PAVEMENT	
CONCRETE SIDEWALK	
HEAVY DUTY PAVEMENT	
LIGHT DUTY PAVEMENT	
PAINTED STRIPE	
CONCRETE CURB	
CENTERLINE	
LIGHT POLE LOCATION	

NOTE:

1. SEE SHEET C2.0 FOR GENERAL NOTES.

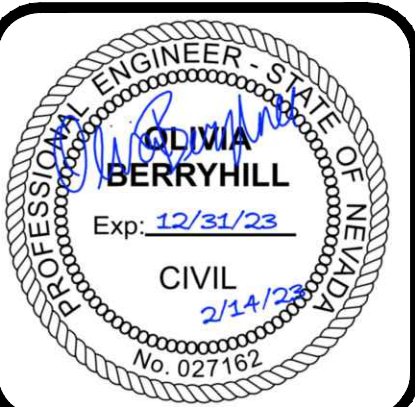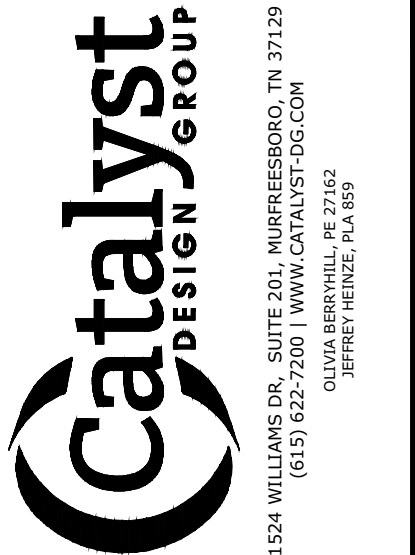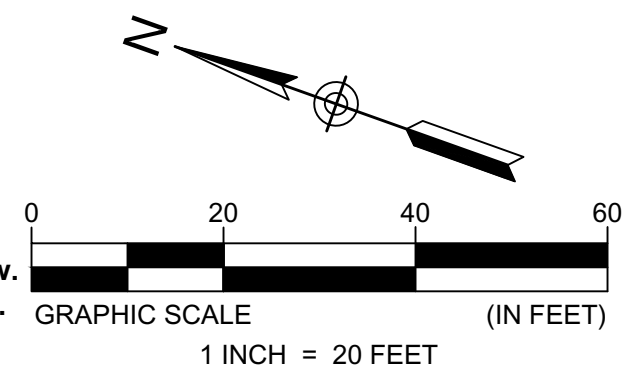

MOUNTAINVIEW HOSPITAL
PARKING GARAGE

LAS VEGAS, NEVADA

NO.	DATE	DESCRIPTION
1	02/14/2023	CITY REVISION 1

DRAWING TITLE
SITE LAYOUT
PLAN

SHEET 11 OF 18

PROJECT NUMBER
20201011

DRAWING NUMBER

C5.0

N. TENAYA WAY (PUBLIC)

L21-01849 CLV DWG #107V6543-PG