

**RESOLUTION**

**WHEREAS**, various sections of TITLE 11 of the Las Vegas Municipal Code allow for additions to and corrections of the Schedules which are established in the respective sections to be effected by Resolution; and

**WHEREAS**, it has been determined and recommended by the City Traffic Engineer that the following additions and corrections be made in said Schedules;

**NOW, THEREFORE**, be it resolved by the City Council of the City of Las Vegas, Nevada, that the following Schedules pertaining to TITLE 11 of the City Code be amended as follows:

**Schedule 25-IV** be amended to **remove** the following 45 MPH Speed Limit Zone:

<u>STREET</u>	<u>FROM</u>	<u>TO</u>	<u>SIDE</u>
Centennial Pkwy	Shaumber Rd	Centennial Center Blvd	B

**Schedule 25-II** be amended to **add** the following 35 MPH Speed Limit Zone:


<u>STREET</u>	<u>FROM</u>	<u>TO</u>	<u>SIDE</u>
Centennial Pkwy	Shaumber Rd	Hualapai Wy	B

**Schedule 25-II** be amended to **add** the following 35 MPH Speed Limit Zone:

<u>STREET</u>	<u>FROM</u>	<u>TO</u>	<u>SIDE</u>
Centennial Pkwy	Durango Dr	Centennial Center Blvd	B


**Schedule 25-III** be amended to **add** the following 40 MPH Speed Limit Zone:


<u>STREET</u>	<u>FROM</u>	<u>TO</u>	<u>SIDE</u>
Centennial Pkwy	Hualapai Wy	Durango Dr	B

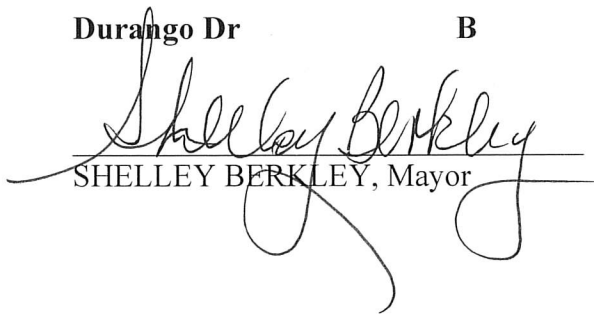  
 \_\_\_\_\_  
 SHELLEY BERKLEY, Mayor

ATTEST:

  
 \_\_\_\_\_  
 Dr. LuAnn Holmes, MMC  
 City Clerk


Approved as to Form:  
  
 \_\_\_\_\_  
 Gillian Block Segerblom Date  
 Deputy City Attorney

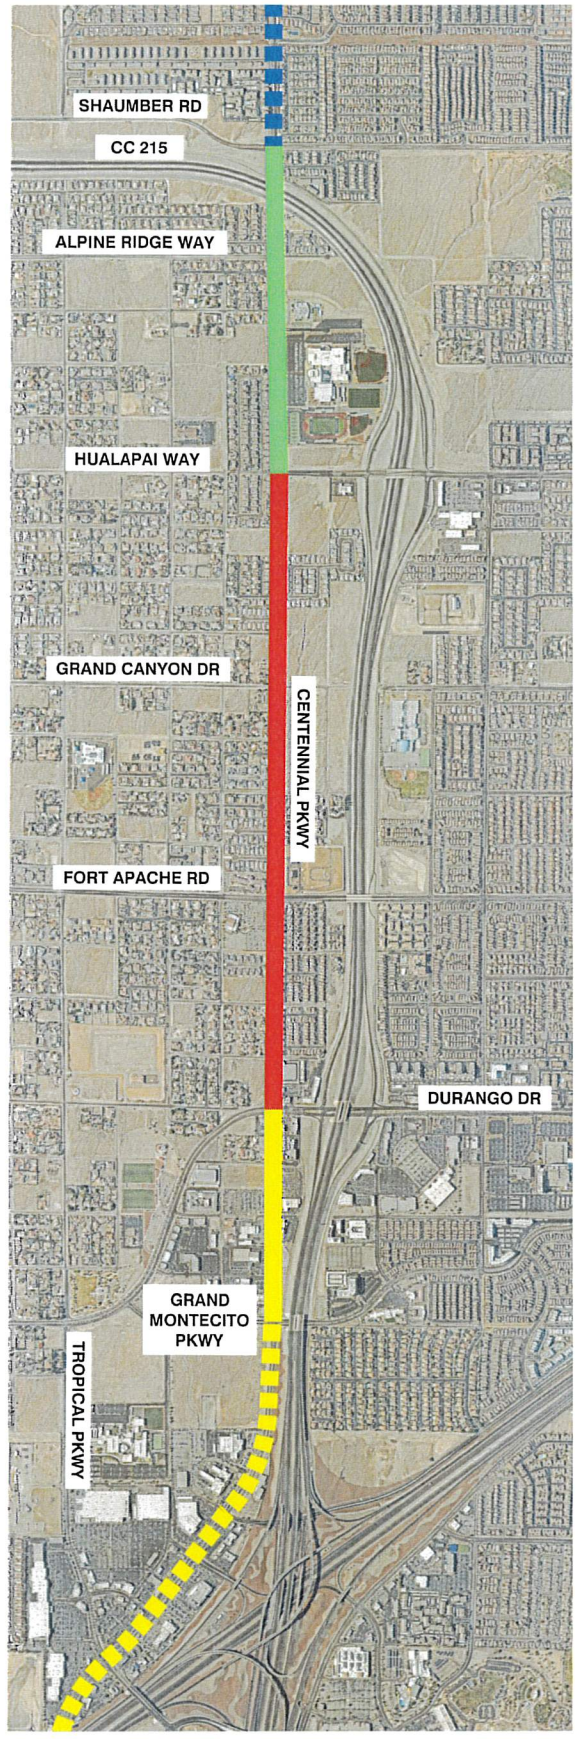

- LEGEND**
- DECREASE SPEED LIMIT  
45 MPH TO 35 MPH
  - DECREASE SPEED LIMIT  
40 MPH TO 35 MPH
  - DECREASE SPEED LIMIT  
45 MPH TO 40 MPH
  - EXISTING 25 MPH
  - EXISTING 30 MPH



C:\USER\BIBRICK\MAN\ENGINEERING - CITY OF LAS VEGAS\DESIGN\TOP\CENTENNIAL PKWY SPEED LIMIT.DWG

	<b>DEPARTMENT OF PUBLIC WORKS</b>	
	TRANSPORTATION ENGINEERING	
	DATE: 4/30/2026	DRAWN BY: BEB
SHEET: 1 OF 1		

**CENTENNIAL PKWY PROPOSED SPEED LIMITS**  
**SHAUMBER RD TO GRAND MONTECITO PKWY**