

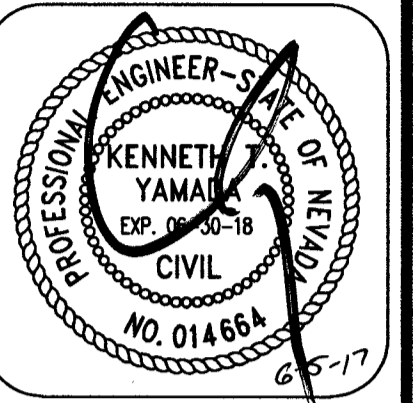


COLLINS ENGINEERS
 3130 S. DURANGO DR., SUITE 404
 LAS VEGAS, NV 89117
 PHONE: (702) 248-8000
 FAX: (702) 248-8070
 WWW.COLLINSENGR.COM

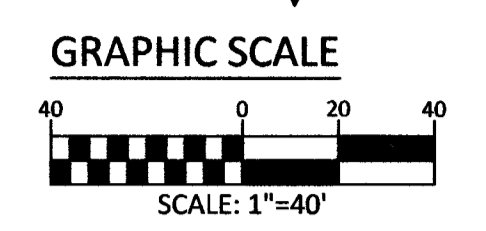

**LAKE MEAD BLVD STREET IMPROVEMENTS
 (I-215 TO DESERT FOOTHILLS)
 SIGNAGE AND STRIPING PLAN**
 LAKE MEAD BLVD
 CITY OF LAS VEGAS


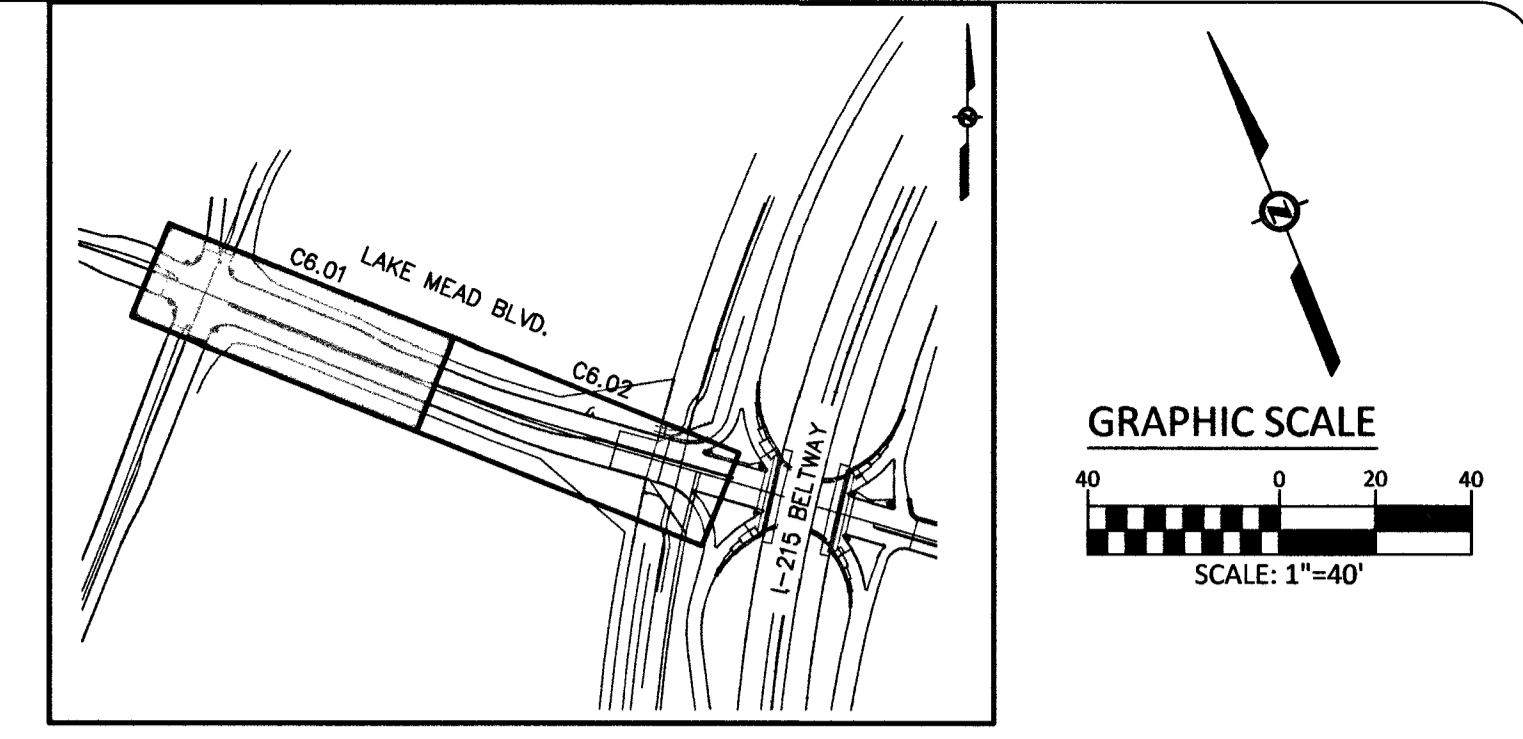


BASIS OF BEARING
 NORTH 89°45'05" EAST BEING THE SOUTH LINE OF THE SOUTHWEST QUARTER (SW 1/4) OF SECTION 35, TOWNSHIP 20 SOUTH, RANGE 59 EAST, M.D.M., AS SHOWN BY MAP ON FILE IN FILE 91, PAGE 28 OF PARCEL MAPS IN THE CLARK COUNTY RECORDER'S OFFICE, CLARK COUNTY, NEVADA

BENCHMARK
 U.S.C&G.S BRASS DISC SET IN ROCK ON THE EAST SIDE OF CHARLESTON BOULEVARD AND SOUTH OF THE RED ROCK DETENTION BASIN.
 CLV BM NO.: D368 3
 ELEVATION: 989.599 METERS (NAV088)
 3426.71 FEET

LEGAL DESCRIPTION
 LYING WITHIN SECTIONS 14, 22, 23, 26 AND 27, TOWNSHIP 20 SOUTH, RANGE 59 EAST, M.D.M., CITY OF LAS VEGAS, CLARK COUNTY NEVADA.

PROPOSED SIGNAGE

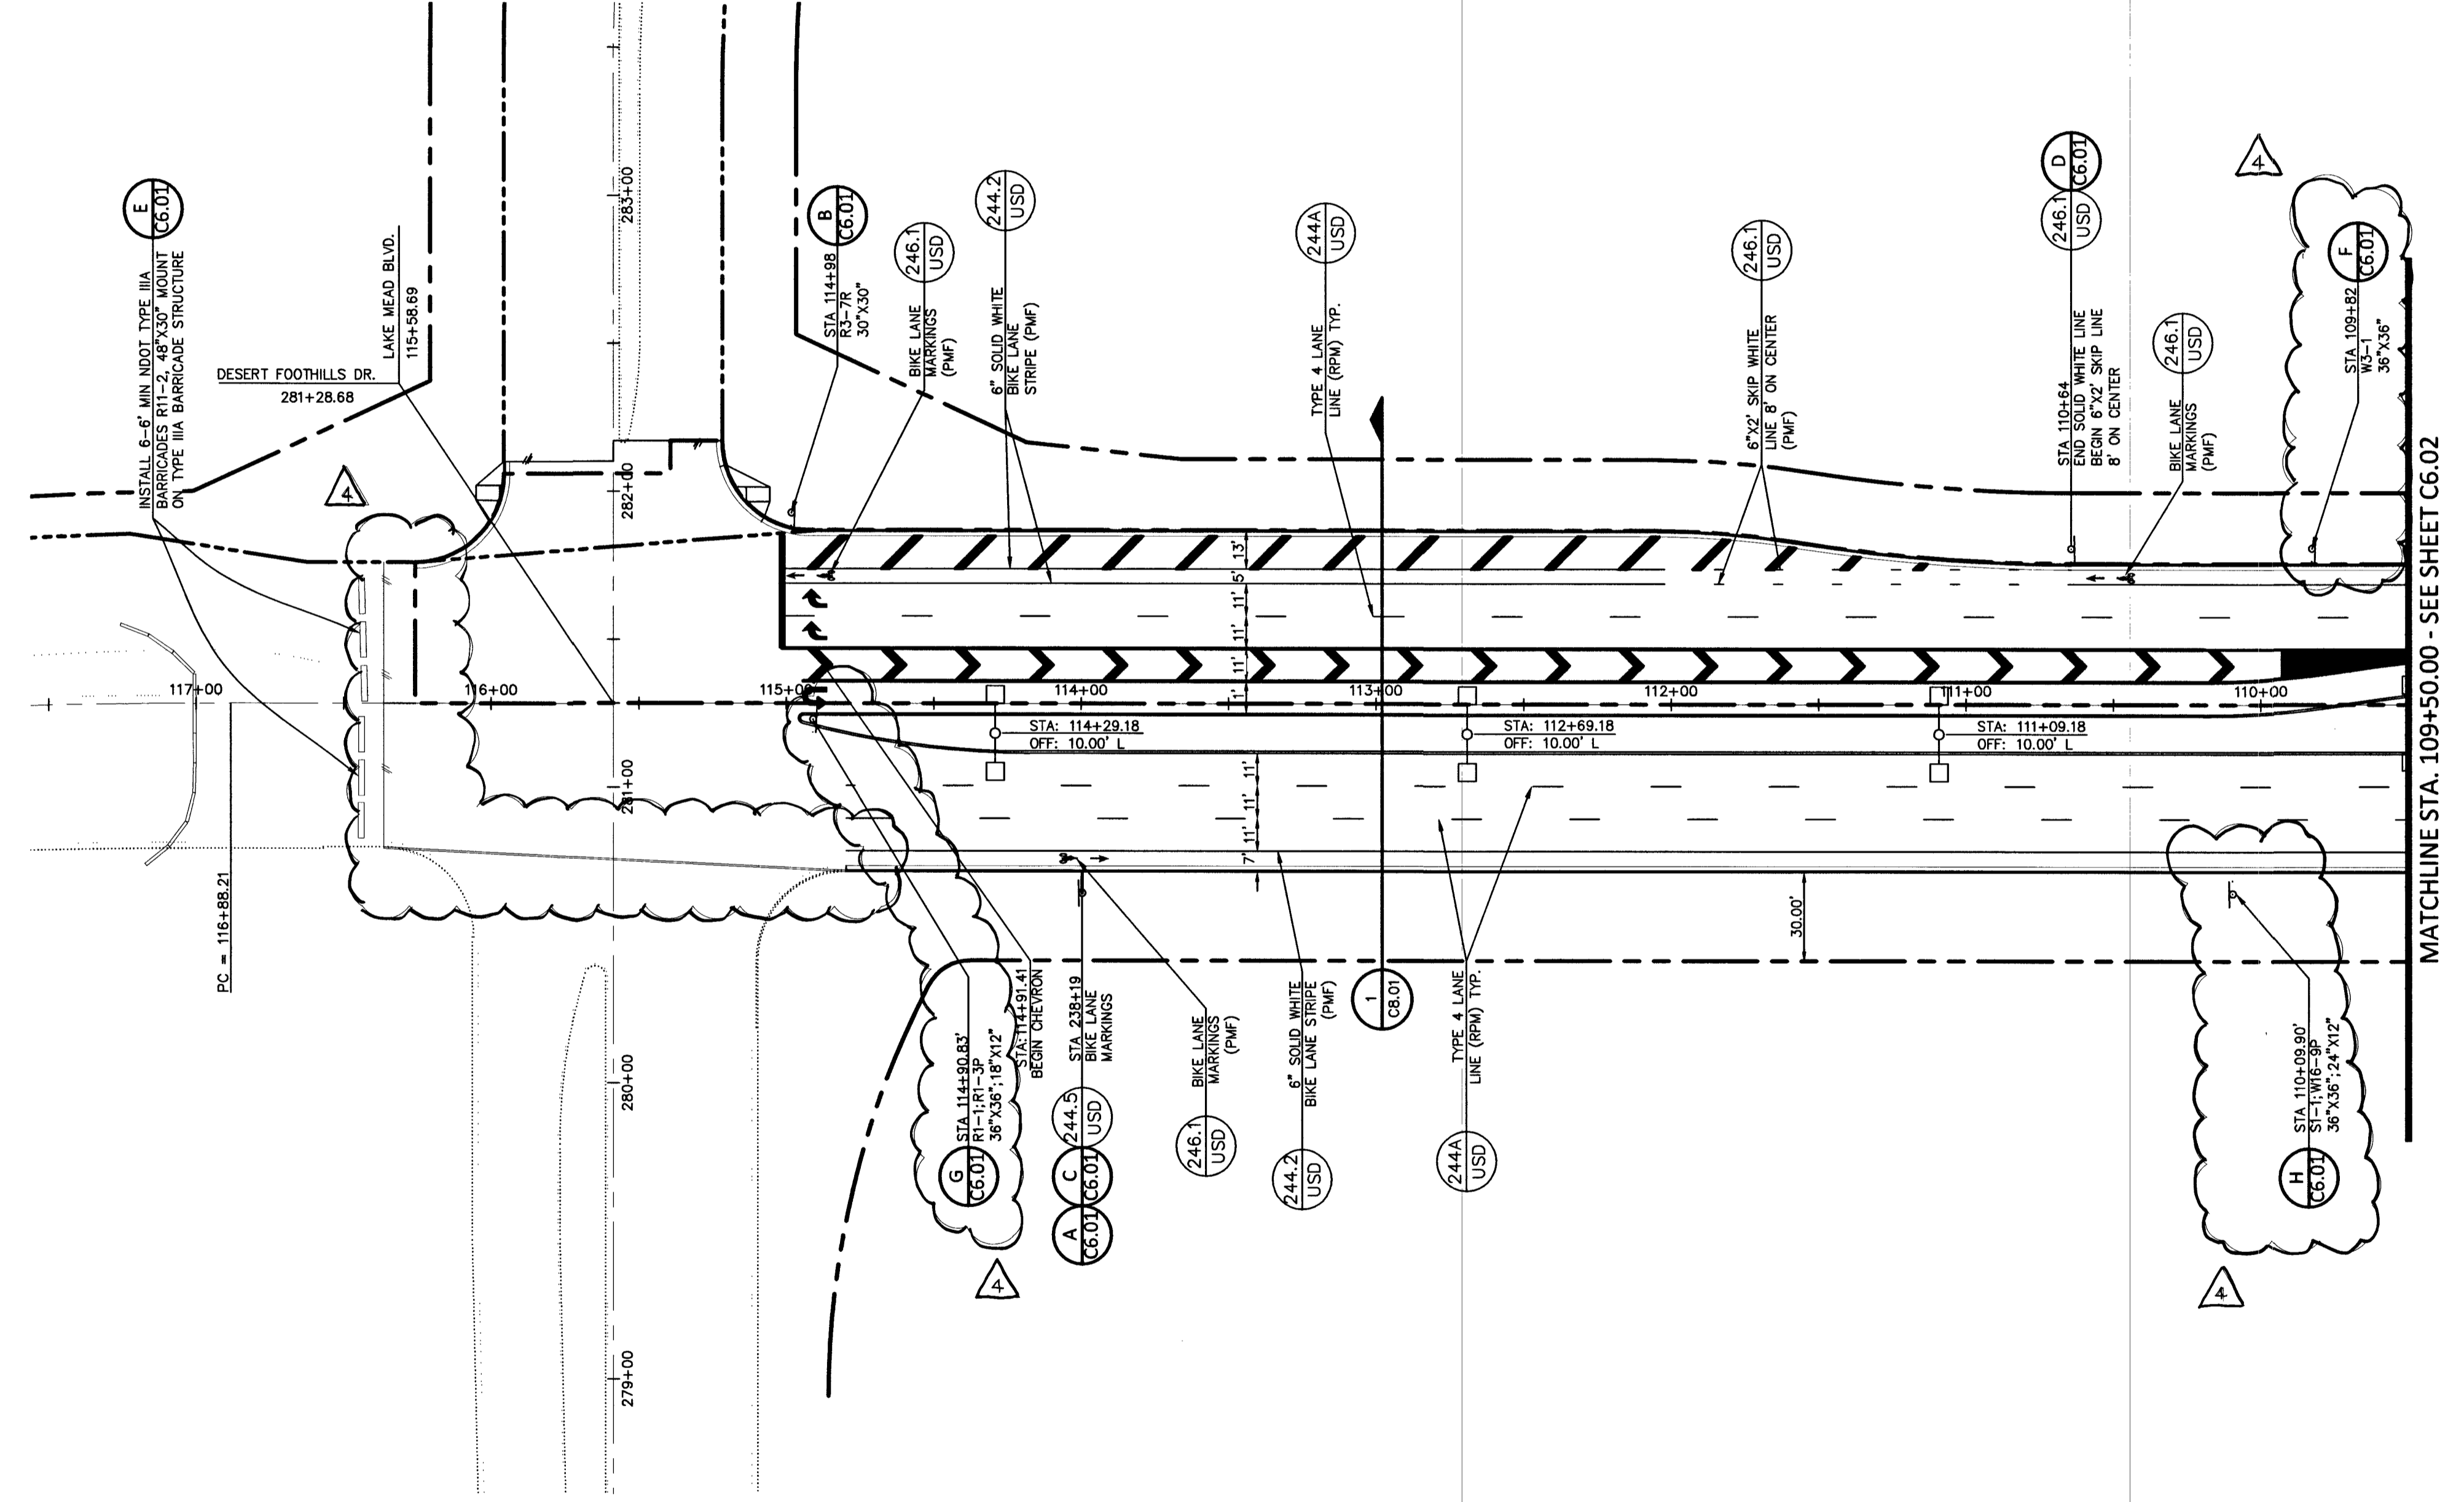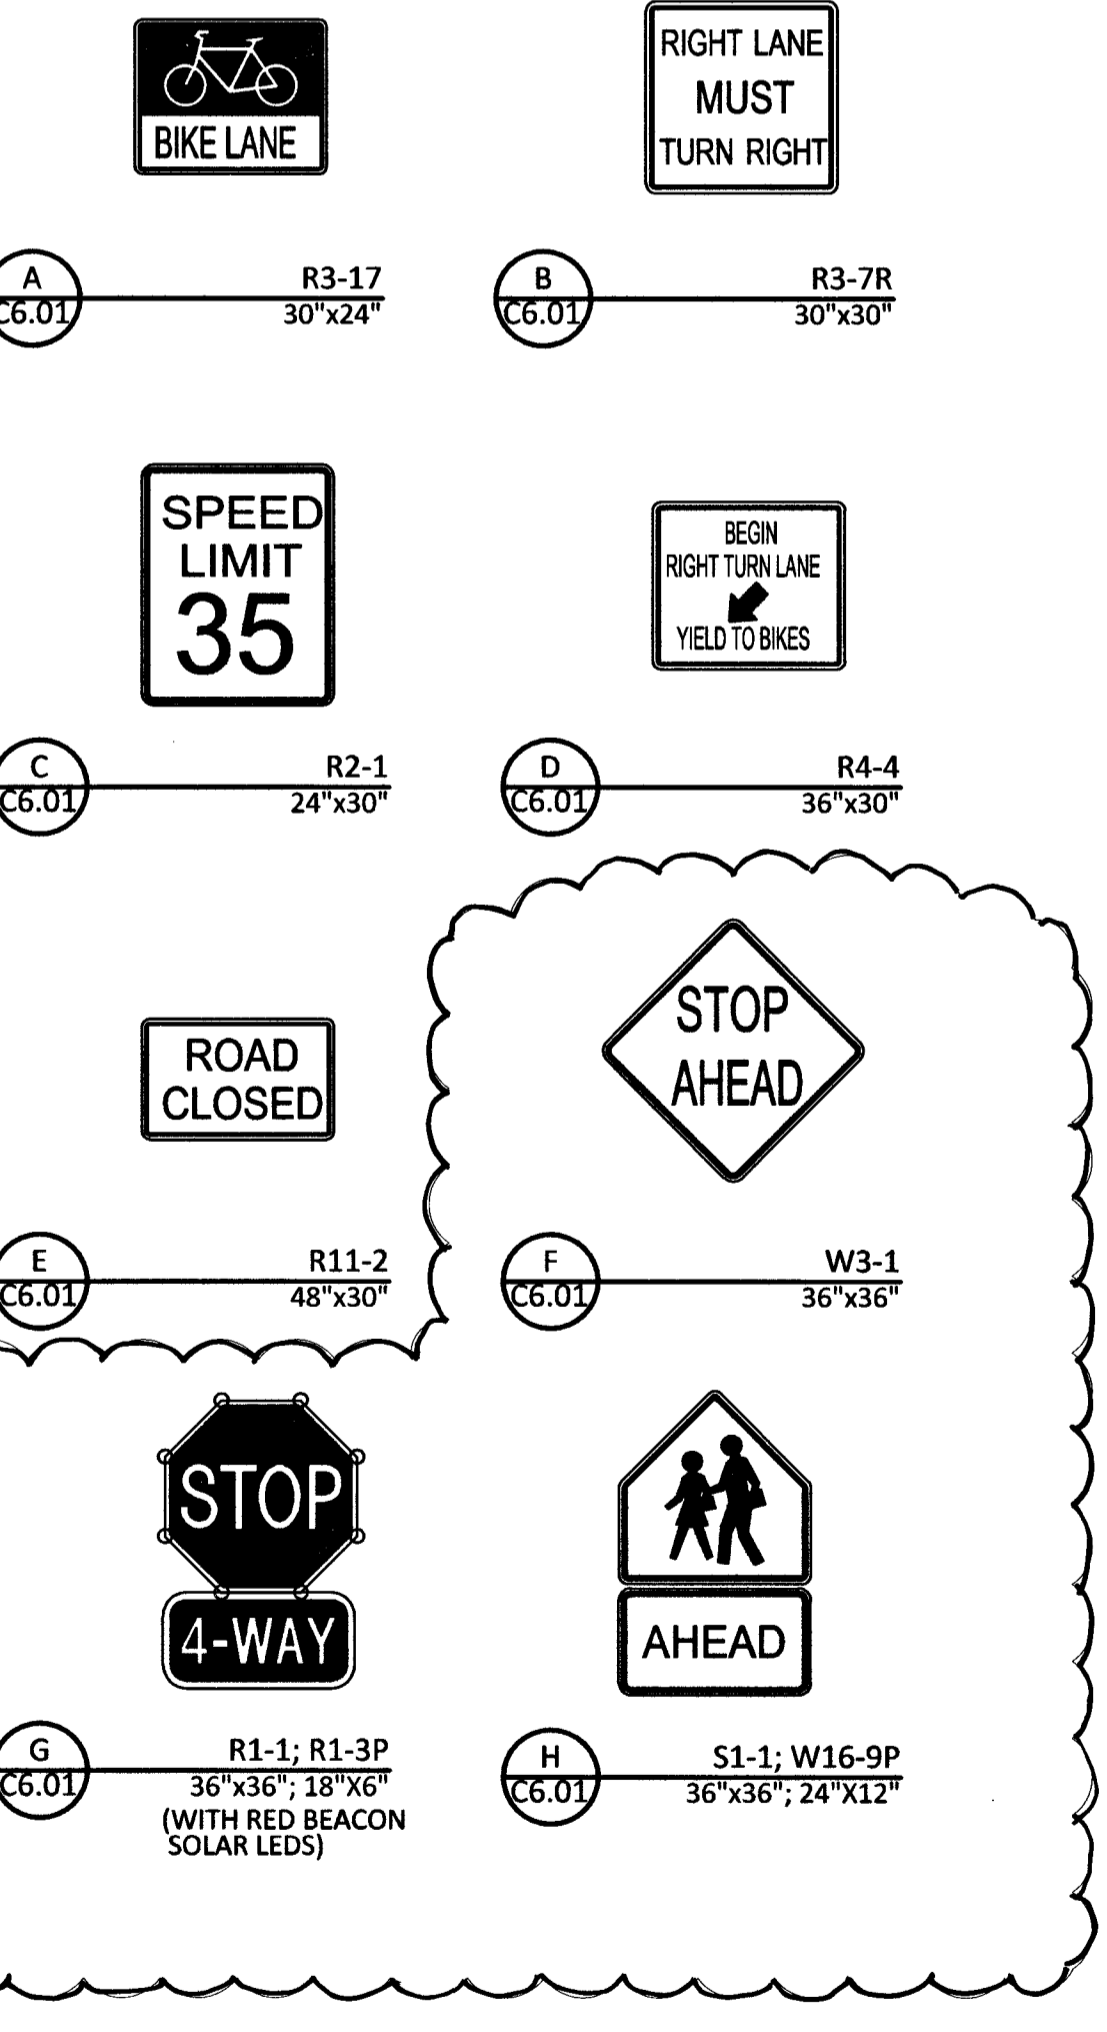

CALL BEFORE YOU DIG
 AVOID CUTTING UNDERGROUND UTILITY LINES. IT'S COSTLY.

CALL BEFORE YOU DO OVERHEAD WORK
 AVOID HITTING OVERHEAD POWER LINES. IT'S COSTLY.

CALL 1-800-227-2600

COLLINS ENGINEERS ASSUMES NO RESPONSIBILITY FOR EXISTING UTILITY LOCATIONS AND ELEVATIONS. THE UTILITIES SHOWN ON THIS DRAWING HAVE BEEN PLOTTED FROM THE BEST AVAILABLE INFORMATION. IT IS, HOWEVER, THE CONTRACTOR'S RESPONSIBILITY TO FIELD VERIFY THE LOCATION AND ELEVATION OF ALL UTILITIES PRIOR TO THE COMMENCEMENT OF ANY CONSTRUCTION. CONTRACTOR TO FIELD VERIFY ALL EXISTING SITE CONDITIONS PRIOR TO CONSTRUCTION. IF A CONFLICT EXISTS BETWEEN WHAT IS SHOWN ON THESE DRAWINGS AND WHAT EXISTS IN THE FIELD, THE CONTRACTOR IS TO NOTIFY THE ARCHITECT OR ENGINEER IMMEDIATELY.

LEGEND

EXISTING	PROPOSED	EXISTING	PROPOSED
(0.00)	0.00% SLOPE	---	AC PAVEMENT
XX	0.00' ELEVATION TAG	---	6" TYPE "A" CURB
⊕	STORM MANHOLE	---	24" TYPE "C" CURB & GUTTER
⊖	DROP INLET	---	30" ROLL CURB
---	CONTOUR	---	PL-RIGHT-OF-WAY
---	RETAINING WALL	---	PL-ADJACENT CENTERLINE
---	SCREEN WALL	---	EASEMENT LINE
		---	FLOW LINE
		---	SAWCUT LINE

NO.	4	DESCRIPTION	CLARIFY STREETLIGHTING, END PAVEMENT AND DRAINAGE INLET IMPROVEMENTS
DESIGN BY			
DATE			
CEI PROJECT:	9346		
DESIGN BY:	J. SALDIVAR		
DRAWN BY:	J. SALDIVAR		
CHECKED BY:	K. YAMADA		
DATE:	09/01/16		
SCALE:	1" = 40'		
SHEET NUMBER	C6.01		
SHEET 12 OF 16			