

NOTICES TO PUBLISH

Las Vegas, Nevada

Date: June 18, 2001

TO: LAS VEGAS REVIEW-JOURNAL

FROM: CITY CLERK

SUBJECT: PUBLICATION OF NOTICE OF PUBLIC HEARING - MASTER PLAN OF
STREETS AND HIGHWAYS - MSH-0001-01

Please publish the attached LEGAL NOTICES

ON THE FOLLOWING DATE: Friday, June 22, 2001 (one time) *D*

and send me three copies of the Affidavit of Publication at your earliest convenience.

(No later than seven (7) days following final publication.)

-

Bernie K. Berger

CHIEF DEPUTY CITY CLERK

cc: Finance Department - Accounts Payable
City Attorney - (on Ordinances)
Planning & Development Department
Front Desk



012777


NOTICE OF PUBLIC HEARING
JULY 5, 2001

NOTICE IS HEREBY GIVEN THAT on Thursday, JULY 5, 2001, at the hour of 1:00 P.M. in the Council Chambers, 400 Stewart Avenue, Las Vegas, Nevada, the City Council will consider the following Master Plan of Streets and Highways:

MSH-0001-01 - CITY OF LAS VEGAS - Request to Amend the Master Plan of Streets and Highways TO ADD DISCOVERY DRIVE BETWEEN MARTIN L KING AND GRAND CENTRAL PARKWAY AS AN 80-FOOT WIDE RIGHT-OF-WAY, AND TO ADD GRAND CENTRAL PARKWAY AS A 100-FOOT WIDE ARTERIAL FROM CHARLESTON BOULEVARD TO OGDEN AVENUE, Ward 5 (Weekly).

ANY AND ALL INTERESTED PERSONS may appear and be heard at said meeting or, prior thereto, may file written objections thereto or approvals thereof with the City Clerk, 1st Floor, City Hall.

BARBARA JO RONEMUS, CITY CLERK

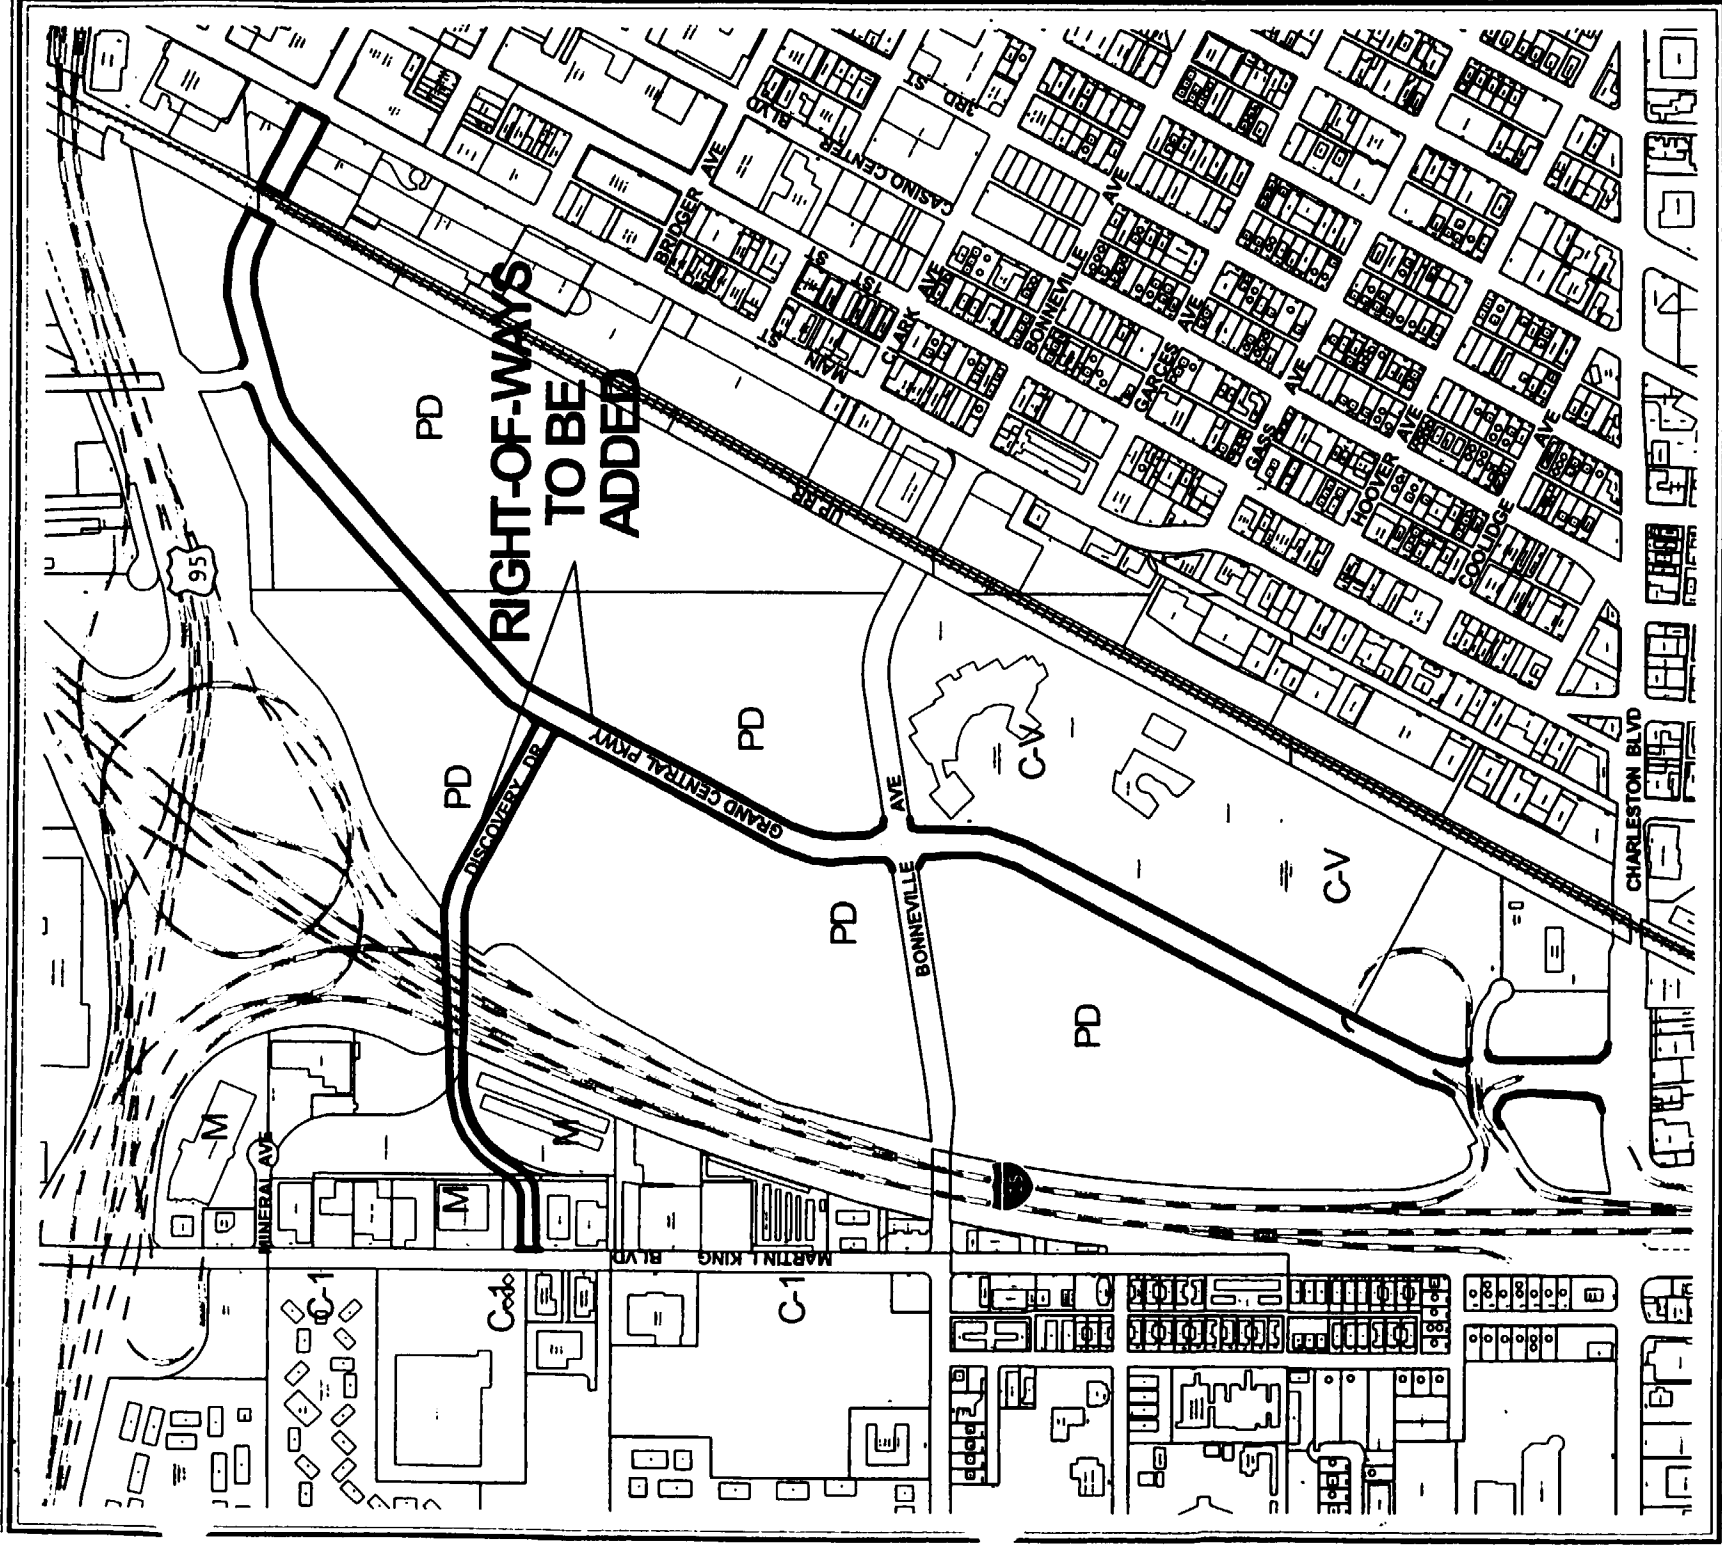

CASE: MSH-0001-01
RADIUS: SPECIAL

