

PECCOLE RANCH PHASE II LOT 21B

Recorded in Book 76 Page 90 of Plats

200 Scale Map Location: Q-6-5

Fire Dept. District Map # 2515:51, 52

MASTER SITE ADDRESS: 10002 HOMESTRETCH DR

BLOCK 1	LOT	1	9920	GARAMOUND AVE	E/W	PUBLIC STREET
		2	9916			
		3	9912			
		4	9908			
		5	9904			
		6	9900			
		7	9824			
		8	9820			
		9	9816			
		10	9812			
BLOCK 1	LOT	11	1652	ENCARTA ST	N/S	PUBLIC STREET
		12	1656			
		13	1660			
		14	1664			
		15	1700			
		16	1704			
		17	1708			
		18	1712			
BLOCK 1	LOT	19	1713	SHIFTING WINDS ST	N/S	PUBLIC STREET
		20	1709			
		21	1705			
		22	1701			
		23	1669			
		24	1665			
		25	1661			
		26	1657			
		27	1653			
BLOCK 2	LOT	28	1652	SHIFTING WINDS ST	N/S	PUBLIC STREET
		29	1660			
		30	1664			
		31	1668			
		32	1700			
		33	1704			
		34	1708			
		35	1712			
		36	1716			
		37	1720			
		38	1724			
BLOCK 3	LOT	39	9801	RANCH HAND AVE	E/W	PUBLIC STREET
		40	9805			
		41	9809			
		42	9813			
		43	9817			
		44	9821			
		45	9901			
		46	9905			
		47	9909			
		48	9913			
		49	9917			
		50	9921			

PECCOLE RANCH PHASE II LOT 21B

BLOCK 3	LOT	51	9925	RANCH HAND AVE	E/W	PUBLIC STREET
		52	10001			
		53	10005			
		54	10009			
		55	10013			
		56	10017			
		57	10021			
		58	10025			
		59	10029			
BLOCK 3	LOT	60	1721	BROADMERE ST	N/S	PUBLIC STREET
		61	1717			
		62	1713			
		63	1709			
		64	1705			
		65	1701			
		66	1665			
		67	1661			
		68	1657			
		69	1653			
BLOCK 3	LOT	70	10024	GARAMOUND AVE	E/W	PUBLIC STREET
		71	10020			
		72	10016			
		73	10012			
		74	10008			
		75	10004			
		76	10000			
BLOCK 4	LOT	115	10025	LONG CATTLE AVE	E/W	PUBLIC STREET
		116	10021			
		117	10017			
		118	10013			
		119	10009			
		120	10005			
		121	10001			
		122	9921			
		123	9917			
		124	9913			
BLOCK 4	LOT	125	1705	WALRUS ST	N/S	PUBLIC STREET
		126	1709			
		127	1713			
BLOCK 4	LOT	128	9916	RANCH HAND AVE	E/W	PUBLIC STREET
		129	9920			
		130	9924			
		131	10000			
		132	10004			
		133	10008			
		134	10012			
		135	10016			
		136	10020			
		137	10024			
BLOCK 5	LOT	77	10021	GARAMOUND AVE	E/W	PUBLIC STREET

PECCOLE RANCH PHASE II LOT 21B

BLOCK 5	LOT	78	10017	GARAMOUND AVE	E/W	PUBLIC STREET
		79	10013			
		80	10009			
		81	10005			
		82	10001			
		83	9925			
		84	9921			
		85	9917			
		86	9913			
		87	9909			
		88	9905			
89	9901					
90	9825					
BLOCK 5	LOT	91	1657	ENCARTA ST	N/S	PUBLIC STREET
		92	1661			
		93	1665			
		94	1701			
		95	1705			
		96	1709			
		97	1713			
BLOCK 5	LOT	98	1712	WALRUS ST	N/S	PUBLIC STREET
		99	1708			
		100	1704			
		101	1700			
BLOCK 5	LOT	102	9900	LONG CATTLE AVE	E/W	PUBLIC STREET
		103	9904			
		104	9908			
		105	9912			
		106	9916			
		107	9920			
		108	10000			
		109	10004			
		110	10008			
		111	10012			
		112	10016			
		113	10020			
		114	10024			
		Common Area	A			
Common Area	B	9903	HOMESTRETCH DR	E/W	PUBLIC STREET	
	C	9803				

Street with no addresses: ELK STREAM STREET (N/S)

ORIGINAL DATE: 11/01/1996

**CITY OF LAS VEGAS
PLANNING & DEVELOPMENT DEPARTMENT**



KYLE C WALTON, SENIOR PLANNER

PECCOLE RANCH PHASE II LOT 21B

BLOCK 5	LOT	78	10017	GARAMOUND AVE	E/W	PUBLIC STREET
		79	10013			
		80	10009			
		81	10005			
		82	10001			
		83	9925			
		84	9921			
		85	9917			
		86	9913			
		87	9909			
		88	9905			
89	9901					
90	9825					
BLOCK 5	LOT	91	1657	ENCARTA ST	N/S	PUBLIC STREET
		92	1661			
		93	1665			
		94	1701			
		95	1705			
		96	1709			
		97	1713			
BLOCK 5	LOT	98	1712	WALRUS ST	N/S	PUBLIC STREET
		99	1708			
		100	1704			
		101	1700			
BLOCK 5	LOT	102	9900	LONG CATTLE AVE	E/W	PUBLIC STREET
		103	9904			
		104	9908			
		105	9912			
		106	9916			
		107	9920			
		108	10000			
		109	10004			
		110	10008			
		111	10012			
		112	10016			
		113	10020			
		114	10024			
		Common Area	A			
Common Area	B	9903	HOMESTRETCH DR	E/W	PUBLIC STREET	
	C	9803				

per Darlene Reeder

Street with no addresses: ELK STREAM STREET (N/S)

ORIGINAL DATE: 11/01/1996

CITY OF LAS VEGAS
PLANNING & DEVELOPMENT DEPARTMENT



KYLE C WALTON, SENIOR PLANNER

PECCOLE RANCH PHASE II LOT 21B

BLOCK 3	LOT	51	9925	RANCH HAND AVE	E/W	PUBLIC STREET
		52	10001			
		53	10005			
		54	10009			
		55	10013			
		56	10017			
		57	10021			
		58	10025			
		59	10029			
BLOCK 3	LOT	60	1721	BROADMERE ST	N/S	PUBLIC STREET
		61	1717			
		62	1713			
		63	1709			
		64	1705			
		65	1701			
		66	1665			
		67	1661			
		68	1657			
69	1653					
BLOCK 3	LOT	70	10024	GARAMOUND AVE	E/W	PUBLIC STREET
		71	10020			
		72	10016			
		73	10012			
		74	10008			
		75	10004			
		76	10000			
BLOCK 4	LOT	115	10025	LONG CATTLE AVE	E/W	PUBLIC STREET
		116	10021			
		117	10017			
		118	10013			
		119	10009			
		120	10005			
		121	10001			
		122	9921			
		123	9917			
		124	9913			
BLOCK 4	LOT	125	1705	WALRUS ST	N/S	PUBLIC STREET
		126	1709			
		127	1713			
BLOCK 4	LOT	128	9916	RANCH HAND AVE	E/W	PUBLIC STREET
		129	9920			
		130	9924			
		131	10000			
		132	10004			
		133	10008			
		134	10012			
		135	10016			
		136	10020			
137	10024					
BLOCK 5	LOT	77	10021	GARAMOUND AVE	E/W	PUBLIC STREET

PECCOLE RANCH PHASE II LOT 21B

Recorded in Book 76 Page 90 of Plats

200 Scale Map Location: Q-6-5

Fire Dept. District Map # 2515:51, 52

MASTER SITE ADDRESS: 10002 HOMESTRETCH DR

4-23-97

BLOCK 1	LOT	1	9920	GARAMOUND AVE	E/W	PUBLIC STREET
		2	9916			
		3	9912			
		4	9908			
		5	9904			
		6	9900			
		7	9824			
		8	9820			
		9	9816			
		10	9812			
BLOCK 1	LOT	11	1652	ENCARTA ST	N/S	PUBLIC STREET
		12	1656			
		13	1660			
		14	1664			
		15	1700			
		16	1704			
		17	1708			
		18	1712			
BLOCK 1	LOT	19	1713	SHIFTING WINDS ST	N/S	PUBLIC STREET
		20	1709			
		21	1705			
		22	1701			
		23	1669			
		24	1665			
		25	1661			
		26	1657			
		27	1653			
BLOCK 2	LOT	28	1652	SHIFTING WINDS ST	N/S	PUBLIC STREET
		29	1660			
		30	1664			
		31	1668			
		32	1700			
		33	1704			
		34	1708			
		35	1712			
		36	1716			
		37	1720			
38	1724					
BLOCK 3	LOT	39	9801	RANCH HAND AVE	E/W	PUBLIC STREET
		40	9805			
		41	9809			
		42	9813			
		43	9817			
		44	9821			
		45	9901			
		46	9905			
		47	9909			
		48	9913			
		49	9917			
50	9921					



HUNSAKER & ASSOCIATES
NEVADA, INC.

PLANNING
ENGINEERING
SURVEYING

IRVINE
LAS VEGAS
RIVERSIDE
SAN DIEGO

970307.01308

CERTIFICATE OF AMENDMENT

March 4, 1997

Ms. Rita Lumos, P.L.S.
City of Las Vegas Surveyor

DOCUMENT: Peccole Ranch Phase II Lot 21B filed in Book 76 of Plats at Page 90


LEGAL DESCRIPTION: A part of the W 1/2 of Sec. 6, T21S.,
R60E, M.D.M., Clark County, Nevada

RECORDING DATE: November 1, 1996

CAPTION: The data to be amended is the street name from Home
Stretch Drive to Homestretch Drive

I, Charles W. Muncy, a professional land surveyor, registered in
the State of Nevada, hereby certify that the above is correct and
does not change the location of any lot lines as platted.

Charles W. Muncy
Charles W. Muncy, P.L.S.
Nevada Certificate No. 3161

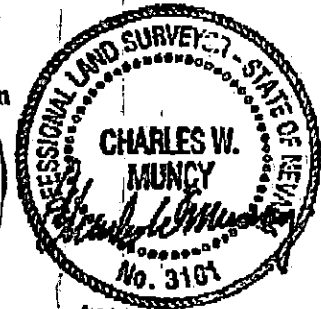

LMAR. 4, 1997

I hereby certify that I have examined the Certificate of
Amendment and that the changes to the original document
specified therein are provided for in applicable sections of NRS
278.010 to 278.630 inclusive, NRS 725.340 to 625.380 inclusive,
and local ordinances adopted pursuant thereto, and I am satisfied
that this Certificate of Amendment so amends or corrects the
document as to make it technically correct.

Rita Lumos 3/5/97
Rita Lumos, P.L.S.
City of Las Vegas Surveyor
Nevada Certificate No. 5094+

WHEN RECORDED, MAIL TO:

Hunsaker & Associates Nevada, Inc.
401 North Buffalo Dr.
Las Vegas, Nevada 89128

pcU506-12 (unadmin) 00000000

LARRY W. BROSS

401 N. Buffalo Drive
Suite 100

Las Vegas, Nevada
89128

(702) 242-4200 PH

(702) 242-2100 FX

www.hunsaker.com

CLARK COUNTY, NEVADA
JUDITH A. VANDEVER, RECORDER
RECORDED AT REQUEST OF:

HUNSAKER & ASSOCIATES NEVADA INC

03-07-97 14:26 BJB 1

OFFICIAL RECORDS

BOOK: 970307 INST: 01308

FEE: 7.00 PL TYPE PL BOOK PAGE 276,000


961101

**FINAL MAP OF
PECCOLE RANCH PHASE III LOT 21B**
(A RESIDENTIAL SUBDIVISION)
BEING ALL OF LOT 21 B, AS SHOWN IN BOOK 71, OF PLATS, PAGE 76 AND ALSO
BEING A PORTION OF THE WEST HALF (W 1/2) OF SECTION 6, TOWNSHIP 21 SOUTH, RANGE 60 EAST, M.D.M.
CITY OF LAS VEGAS, CLARK COUNTY, NEVADA.

SCALE 1" = 50'

TOTAL LOTS: 137 LOTS
TOTAL ACREAGE: 19.81 ACR.


BASIS OF BEARINGS:
BEING THE WEST LINE OF THE NORTHWEST QUARTER (NW 1/4) TOWNSHIP 21 SOUTH, RANGE 60 EAST, M.D.M., CITY OF CLARK COUNTY, NEVADA AS SHOWN ON FILE 00, OF A PAGE 55 OFFICIAL RECORDS OF CLARK COUNTY NEVADA, BEARS: NORTH 01°21'00" EAST.

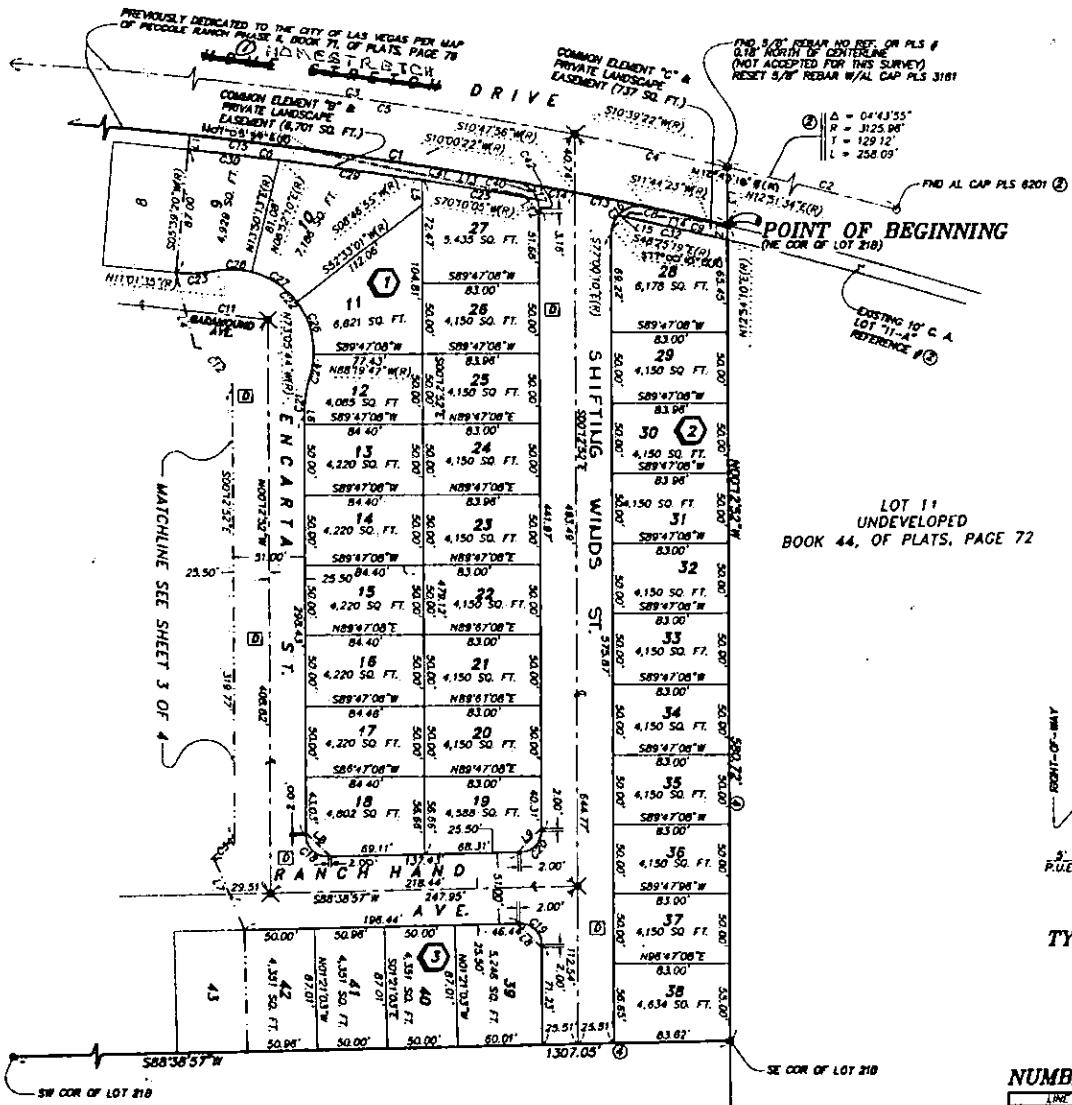

LEGEND:

- ✕ SET REBAR W/AL CAP PLS # 3161 WITH REFERENCE MONUMENTS
- SET REBAR W/AL CAP PLS # 3161
- FOUND MONUMENT AS NOTED
- (M) MEASURED BEARING AND/OR DISTANCE
- (C) CALCULATED BEARING AND/OR DISTANCE
- (R) RADIAL BEARING
- ① REFERENCE BEARING AND/OR DISTANCE
- ② HEREBY DEDICATED TO THE CITY OF LAS VEGAS
- LOT LINE
- UNIT BOUNDARY LINE
- - - CENTERLINE
- - - SIGHT VISIBILITY RESTRICTION EASEMENT*
- ① BLOCK NUMBERS
- ▭ COMMON ELEMENT AND PRIVATE LANDSCAPE EASEMENT

* - LID IMPROVEMENTS OR LANDSCAPING FEATURES TALLER THAN 85" ARE ALLOWED IN SUCH EASEMENT AREAS.

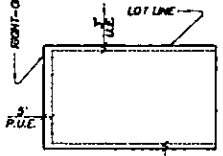

TYPICAL P.U.E. & U.E.
N.T.S.

REFERENCE:

- ① PARCEL MAP FILE 00, PAGE 55
- ② PLATS BOOK 44, PAGE 72
- ③ RECORD OF SURVEY FILE 30, PAGE 00
- ④ PLATS BOOK 71, PAGE 76

NOTES:

1. ALL REAR LOT CORNERS SHALL BE SET WITH A NAIL AND T.I.P.L.S. 3161 ON BLOCK BULL AND ALL FRONT AND SIDE LOT CORNERS ADJOINING PUBLIC RIGHT-OF-WAY SHALL BE MARKED BY THE SAUCING OF THE BACK OF CURBS ON THE PROLONGATION OF THE PROPERTY LINES.
2. ALL COMMON ELEMENTS AND PRIVATE LANDSCAPE EASEMENTS SHALL BE MAINTAINED BY THE HOMEOWNERS ASSOCIATION.
3. DIRECT VEHICULAR ACCESS TO HOME STRETCH DRIVE AND HALLWAY WAY THRU COMMON ELEMENTS FROM ADJUTING LOTS IS PROHIBITED.

CURVE TABLE:

NUMBERED CURSES:

LINE	DIRECTION	DISTANCE
1.1	N02°38'20"E	10.00
1.2	N00°12'51"W	10.23
1.3	S00°12'51"W	41.08
1.4	N14°13'07"E	24.80
1.5	S00°12'51"W	17.83
1.6	N00°12'51"W	4.30
1.7	S11°09'01"W	24.80

CANYON VISTA PHASE I
BOOK 76 PAGE 16

PECCOLE RANCH PHASE III LOT 21B

(A RESIDENTIAL SUBDIVISION)
 BEING ALL OF LOT 21 B, AS SHOWN IN BOOK 71, OF PLATS, PAGE 76 AND ALSO
 BEING A PORTION OF THE WEST HALF (W 1/2) OF SECTION 6, TOWNSHIP 21 SOUTH, RANGE 60 EAST, M.D.M.
 CITY OF LAS VEGAS, CLARK COUNTY, NEVADA.

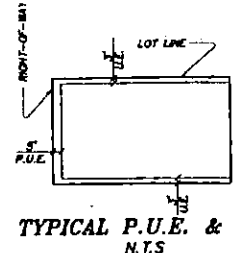

SCALE 1" = 50'

TOTAL LOTS: 137 LOTS
 TOTAL ACREAGE: 19.81 ACRES


BASIS OF BEARINGS:
 BEING THE WEST LINE OF THE NORTHWEST QUARTER (NW 1/4) OF SECTION 6, TOWNSHIP 21 SOUTH, RANGE 60 EAST, M.D.M. CITY OF LAS VEGAS, CLARK COUNTY, NEVADA AS SHOWN ON FILE 38, PAGE 81 OF PARCEL MAPS, PAGE 58 OFFICIAL RECORDS OF CLARK COUNTY, NEVADA, WHICH BEARS NORTH 01°21'03" EAST.

- LEGEND:**
- ✕ SET REBAR W/AL CAP PLS # 3161 WITH REFERENCE MONUMENTS
 - SET REBAR W/AL CAP PLS # 3161
 - FOUND MONUMENT AS NOTED
 - (M) MEASURED BEARING AND/OR DISTANCE
 - (C) CALCULATED BEARING AND/OR DISTANCE
 - (R) RADIAL BEARING
 - ① REFERENCE BEARING AND/OR DISTANCE HEREBY DEDICATED TO THE CITY OF LAS VEGAS
 - LOT LINE
 - UNIT BOUNDARY LINE
 - CENTERLINE
 - SIGHT VISIBILITY RESTRICTION EASEMENT
 - ⑦ BLOCK NUMBERS
 - ▭ COMMON ELEMENT AND PRIVATE LANDSCAPE EASEMENT

- REFERENCES:**
- ① PARCEL MAP FILE 68, PAGE 8
 - ② PLATS BOOK 44, PAGE 72
 - ③ RECORD OF SURVEY FILE 38, PAGE 81
 - ④ PLATS BOOK 71, PAGE 76

- NOTES:**
1. ALL REAR LOT CORNERS SHALL BE SET WITH A NAIL AND TAG P.L.S. STIP ON BLOCK WALL AND ALL FRONT AND SIDE LOT CORNERS ADJOINING PUBLIC RIGHT-OF-WAY SHALL BE MARKED BY THE SURVEYING OF THE BACK OF CURBS ON THE PROLONGATION OF THE PROPERTY LINE.
 2. ALL COMMON ELEMENTS AND PRIVATE LANDS AFE EASEMENTS SHALL BE MAINTAINED BY THE HOMEOWNERS AS INDICATED.
 3. DIRECT VEHICULAR ACCESS TO HOME STREET, DRIVE AND HUALAPAI BAY THROUGH COMMON ELEMENT FROM ADJUTING LOTS IS PROHIBITED.

* NO IMPROVEMENTS OR LANDSCAPERS FEATURES TALLER THAN 60" ARE ALLOWED IN SUCH EASEMENT AREAS.

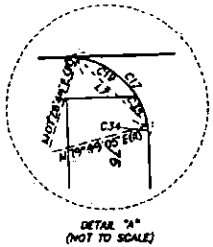


CURVE TABLE:


NUMBERED COURSES:

LINE	DIRECTION	DISTANCE

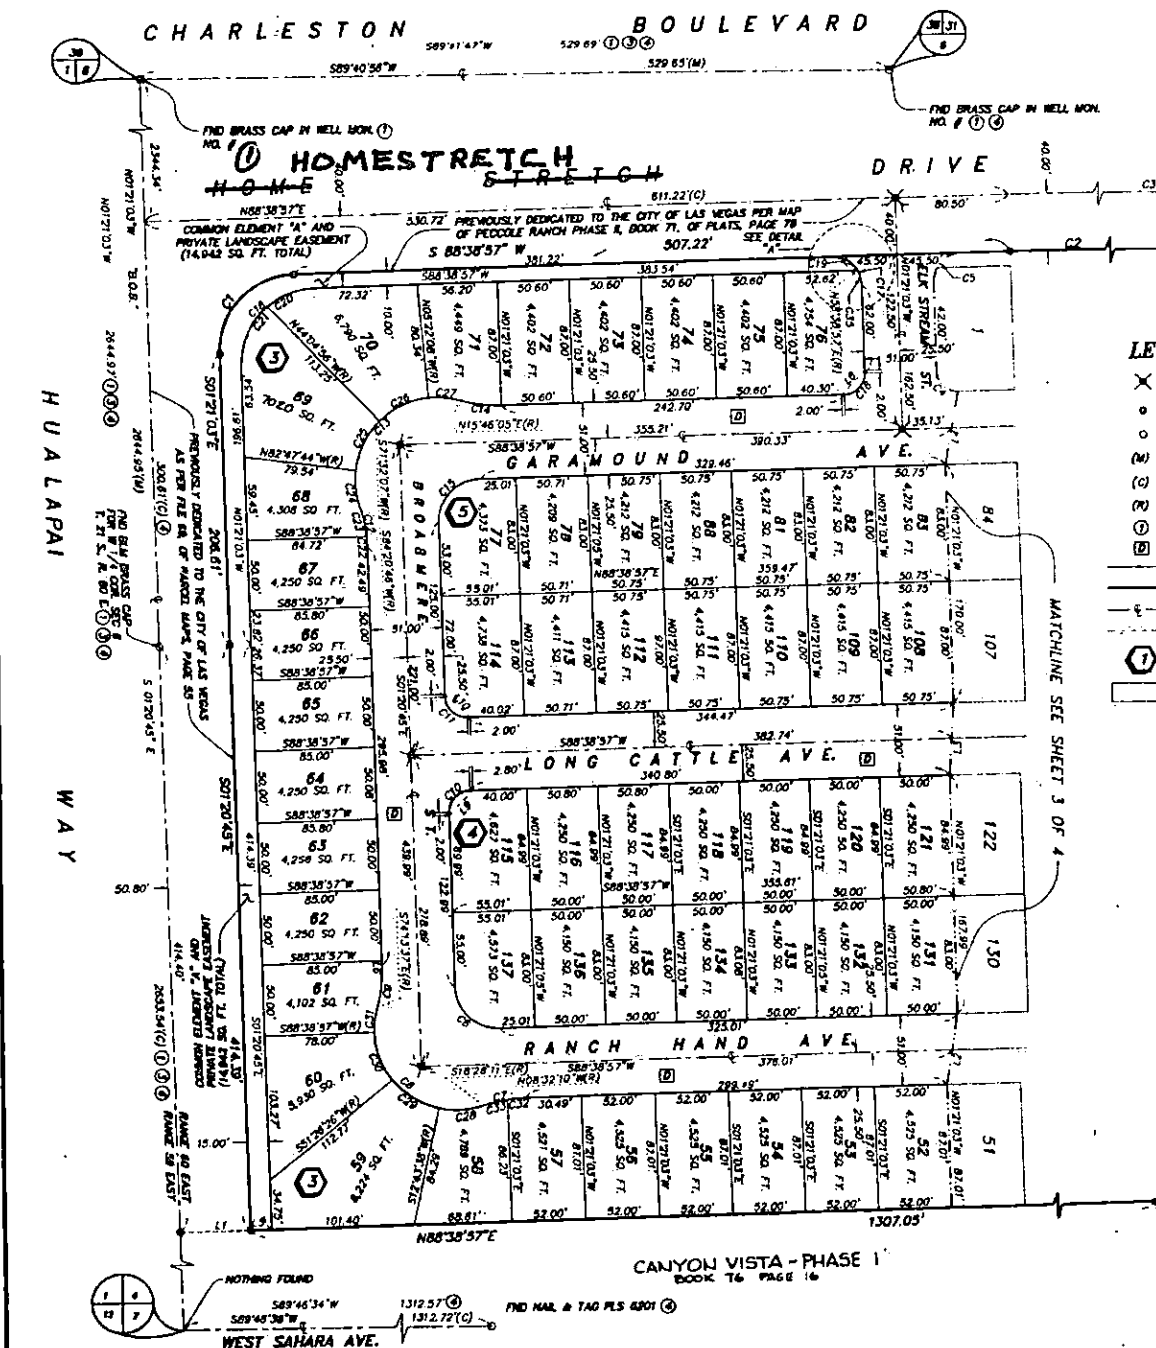


① Certificate of Amendment
 3/7/97 CORRECTION OF 2 WORD STREET NAME TO ONE (HOMESTRETCH DR)

FINAL MAP OF PECCOLE RANCH PHASE III LOT 21B

(A RESIDENTIAL SUBDIVISION)
 BEING ALL OF LOT 21 B, AS SHOWN IN BOOK 71, OF PLATS, PAGE 76 AND ALSO
 BEING A PORTION OF THE WEST HALF (W 1/2) OF SECTION 6, TOWNSHIP 21 SOUTH, RANGE 60 EAST, M.D.M.
 CITY OF LAS VEGAS, CLARK COUNTY, NEVADA.

* - NO IMPROVEMENTS OR LANDSCAPE FEATURES TALLER THAN 30' ARE ALLOWED IN SUCH EASEMENT AREAS.

SCALE 1" = 50'

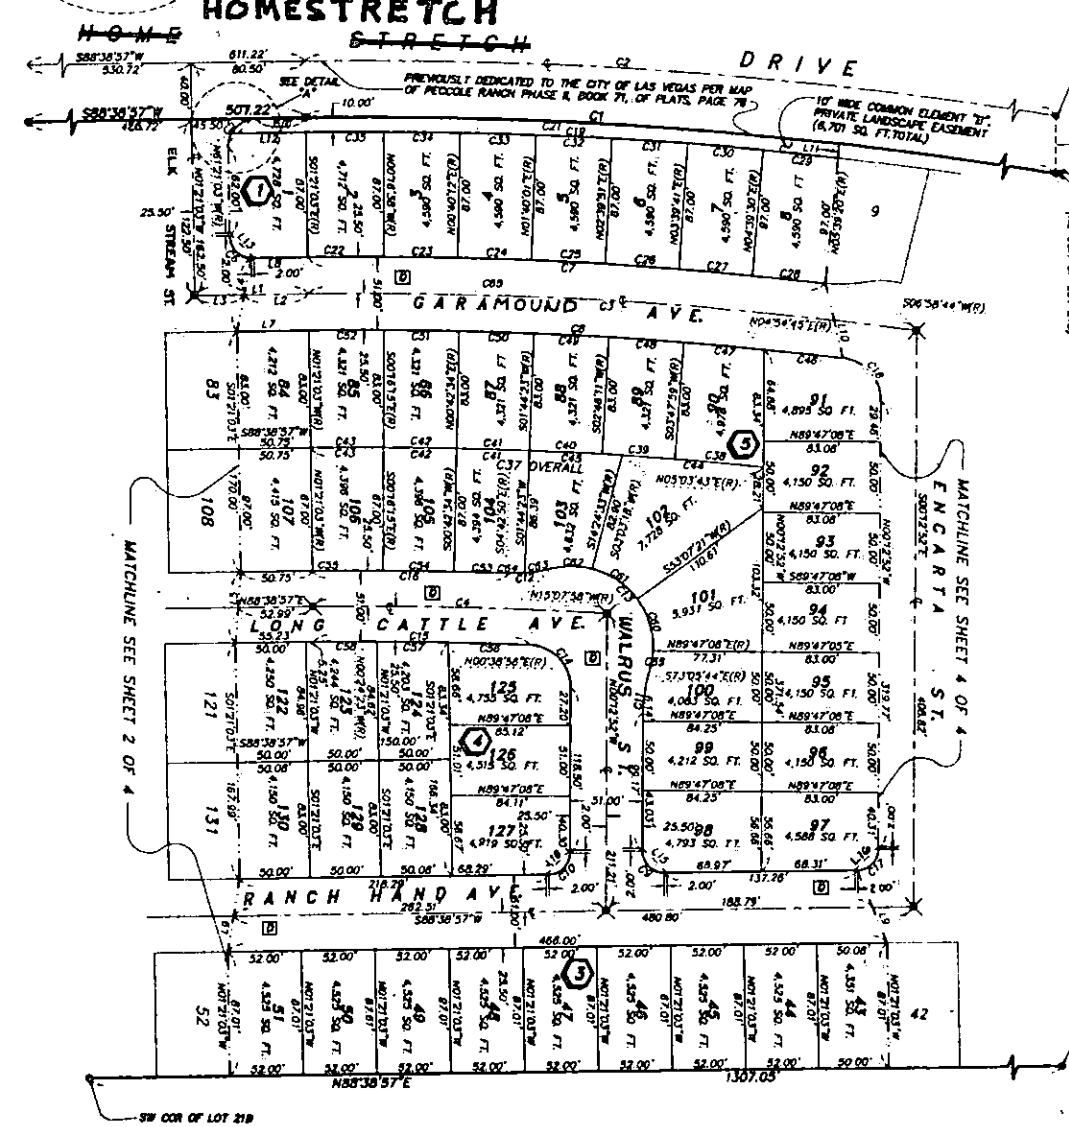

NO 5/8" REBAR NO REF. OR PLS #
 0.16" NORTH OF CENTERLINE
 (NOT ACCEPTED FOR THIS SURVEY)
 RESET 5/8" REBAR W/AL CAP PLS 3181


POINT OF BEGINNING
 (NE COR OF LOT 21B)

LEGEND:

- ✕ SET REBAR W/AL CAP PLS # 3181 WITH REFERENCE MONUMENTS
- SET REBAR W/AL CAP PLS # 3181
- FOUND MONUMENT AS NOTED
- MEASURED BEARING AND/OR DISTANCE
- CALCULATED BEARING AND/OR DISTANCE
- RADIAL BEARING
- REFERENCE BEARING AND/OR DISTANCE
- HEREBY DEDICATED TO THE CITY OF LAS VEGAS
- LOT LINE
- UNIT BOUNDARY LINE
- CENTERLINE
- SIGHT VISIBILITY RESTRICTION EASEMENT
- ⓪ FLOOR NUMBERS
- ▭ COMMON ELEMENT AND PRIVATE LANDSCAPE EASEMENT

NOTES:

1. ALL REAR LOT CORNERS SHALL BE SET WITH A NAIL AND TAG P.L.S. 3181 ON BLOCK WALL AND ALL FRONT AND SIDE LOT CORNERS ALONGING PUBLIC RIGHT-OF-WAY SHALL BE MARKED BY THE SAWCUTTING OF THE BACK OF CURBS ON THE PROLONGATION OF THE PROPERTY LINES.
2. ALL COMMON ELEMENTS AND PRIVATE LANDSCAPE EASEMENTS SHALL BE MAINTAINED BY THE HOMEOWNERS ASSOCIATION.

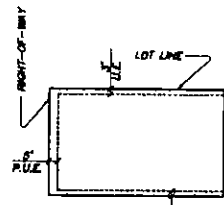

TYPICAL P.U.E. & U.E. N.T.S.

SE COR OF LOT 21B

NUMBERED COURSES:

COURSE	DIRECTION	DISTANCE
1	N89°38'57"E	81.50
2	N89°38'57"E	43.30
3	N89°38'57"E	35.71
4	S10°11'01"W	22.72
5	S61°40'17"W	31.29
6	S69°40'23"W	31.79
7	N89°38'57"E	30.79
8	N89°38'57"E	44.07
9	S81°10'51"W	34.27
10	N11°12'07"E	51.59
11	MDS 39°20'	10.00
12	N89°38'57"E	52.31
13	N40°21'01"W	24.04
14	S41°11'51"W	23.45
15	S74°44'57"E	24.77
16	N44°11'01"E	23.88

TOTAL LOTS: 137 LOTS
 TOTAL ACREAGE: 19.61 ACRES

BASIS OF BEARINGS:
 BEING THE WEST LINE OF THE NORTHWEST QUARTER (NW 1/4) OF SECTION 6, TOWNSHIP 21 SOUTH, RANGE 60 EAST, T.11M., CITY OF LAS VEGAS, CLARK COUNTY, NEVADA AS SHOWN ON P.L.E. DS. OF PARCEL MAPS, PAGE 55 OFFICIAL RECORDS OF CLARK COUNTY NEVADA, MERCH BEARING NORTH 01°21'03" EAST.

REFERENCES:

- ① PARCEL MAP FILE NO. PA1E 53
- ② PLATS BOOK 44, PAGE 72
- ③ RECORD OF SURVEY FILE 38, PAGE 88
- ④ PLATS BOOK 71, PAGE 76

CURVE TABLE:

CURVE	RADIUS	LENGTH	TANGENT	DELTA
C1	3084.08	783.13	364.54	147°17'
C2	2862.50	371.48	364.87	147°17'
C3	2741.50	207.15	103.63	047°01'
C4	20.00	31.42	30.00	00°00'
C5	15.00	21.56	15.00	00°00'
C6	2888.00	363.58	183.42	07°02'
C7	2833.00	372.19	183.26	07°02'
C8	15.00	21.56	15.00	01°18'
C9	15.00	21.56	14.71	03°54'
C10	100.00	29.88	15.00	17°07'
C11	100.00	29.88	14.62	16°39'
C12	50.00	151.56	104.72	122°01'
C13	30.00	46.04	24.63	07°53'
C14	2714.00	132.18	76.11	03°17'
C15	2767.00	134.40	69.21	02°57'
C16	15.00	21.56	14.71	03°54'
C17	30.00	43.68	20.60	03°45'
C18	3075.00	378.02	188.25	07°02'
C19	3084.08	377.23	188.65	07°02'
C20	2988.00	31.00	26.00	01°07'
