

*Amended file copy*

# STAR CANYON

Recorded in Book 81 Page 29 of Plats

200 Scale Map Location: K-36-4

Fire Dept. District Map # 2414:45, 46, 47, 46

MASTER SITE ADDRESS: 10230 ALTA DR

BLOCK 1	LOT	1	10301	SUMMIT CANYON DR	E/W	PRIVATE STREET
		2	10309			
		3	10317			

BLOCK 1	LOT	4	10300	ROCKY MESA CT	E/W	PRIVATE STREET
		5	10308			
		6	10316			
		7	10324			

BLOCK 1	LOT	8	10432	SUMMIT CANYON DR	E/W	PRIVATE STREET
		9	10424			
		10	10416			
		11	10408			
		12	10400			
		13	10340			
		14	10332			
		15	10324			
		16	10316			
		17	10308			
		18	10300			

These 3 lots have been removed from this subdivision and LOT 20 has been reallocated between LOTS 19 and 21, as shown on THE AMENDED PLAT OF A PORTION OF STAR CANYON, recorded 05/17/2001

19 10232  
20 10224  
21 10216

22 10208  
23 10200  
24 10132  
25 10124  
26 10116  
27 10108  
28 10100  
29 10024  
30 10016  
31 10008  
32 10000

BLOCK 1	LOT	33	10217	STONY RIDGE DR	E/W	PRIVATE STREET
		34	10225			
		35	10233			


BLOCK 2	LOT	1	10225	SUMMIT CANYON DR	E/W	PRIVATE STREET
		2	10217			
		3	10209			
		4	10201			
		5	10141			
		6	10133			
		7	10125			
		8	10117			
		9	10109			
		10	10101			

# STAR CANYON

BLOCK 2	LOT	11	501	SPRUCE CANYON ST	N/S	PRIVATE STREET
		12	509			
		13	517			
		14	525			
BLOCK 2	LOT	15	10100	STONY RIDGE DR	E/W	PRIVATE STREET
		16	10108			
		17	10116			
		18	10124			
		19	10132			
		20	10140			
		21	10200			
		22	10208			
		23	10216			
		24	10224			
		25	10232			
Common Area	A		10421	SUMMIT CANYON DR	E/W	PRIVATE STREET
	B		10427			
	C		10403			
Common Area	E		507	MEADOW CANYON LN	N/S	PRIVATE STREET
	F		506			
	G		614			
	H		619			
	I		615			
Common Area	J	563	S	TOWN CENTER DR	N/S	PUBLIC STREET
Common Area	K	603		MEADOW CANYON LN	N/S	PRIVATE STREET
Common Area	L	10231		SUMMIT CANYON DR	E/W	PRIVATE STREET
	M	10002				
Common Area	N	10003		STONY RIDGE DR	E/W	PRIVATE STREET
Common Area	O	491	S	HUALAPAI WAY	N/S	PUBLIC STREET

ORIGINAL DATE: 9/16/1997

CITY OF LAS VEGAS  
PLANNING & DEVELOPMENT DEPARTMENT

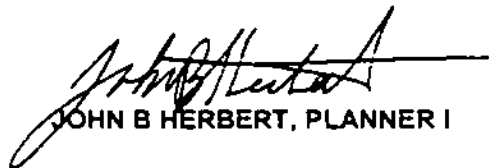  
JOHN B HERBERT, PLANNER I

# THE AMENDED PLAT OF A PORTION OF STAR CANYON

Recorded in Book 99 Page 98 of Plats

200 Scale Map Location: K-36-4

Fire Dept. District Map # 2414:37


MASTER SITE ADDRESS: 10230 SUMMIT CANYON DR

BLOCK 1	LOT	19A	10232	SUMMIT CANYON DR	EW	PRIVATE STREET
		21A	10216			

There are no addresses on MEADOW CANYON LANE (N/S Private Street).

AMENDED DATE: 5/17/2001

CITY OF LAS VEGAS  
PLANNING & DEVELOPMENT DEPARTMENT

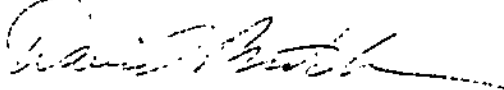

DAVID R BRATCHER, SR PLANNER

# THE AMENDED PLAT OF A PORTION OF STAR CANYON

Recorded in Book 99 Page 98 of Plats

200 Scale Map Location: K-36-4

Fire Dept. District Map # 2414:37


MASTER SITE ADDRESS: 10230 SUMMIT CANYON DR

BLOCK 1	LOT	19A	10232	SUMMIT CANYON DR	E/W	PRIVATE STREET
		21A	10216			

There are no addresses on MEADOW CANYON LANE (N/S Private Street).

AMENDED DATE: 5/17/2001

CITY OF LAS VEGAS  
PLANNING & DEVELOPMENT DEPARTMENT

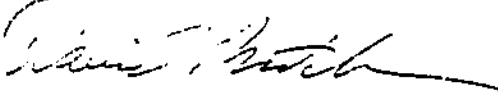

DAVID R BRATCHER, SR PLANNER

FILE COPY

THE AMENDED PLAT OF A PORTION OF

# STAR CANYON

SITUATE IN THE CITY OF LAS VEGAS, CLARK COUNTY, NEVADA, BEING A PORTION OF THE NORTHEAST ONE-QUARTER OF SECTION 36, TOWNSHIP 20 SOUTH, RANGE 59 EAST, M.D.M. MORE PARTICULARLY LOTS 19, 20 & 21 OF BLOCK 1, AS SHOWN ON THAT CERTAIN PLAT OF STAR CANYON, RECORDED IN BOOK 81 OF PLATS ON PAGE 29



**AMENDMENT NOTE:**  
THE PURPOSE OF THIS AMENDED PLAT IS TO REALLOCATE ALL OF THE LOT 20 TO BOTH LOTS 19 & 21.

**LIVE DATA TABLE**


**CURVE DATA TABLE**


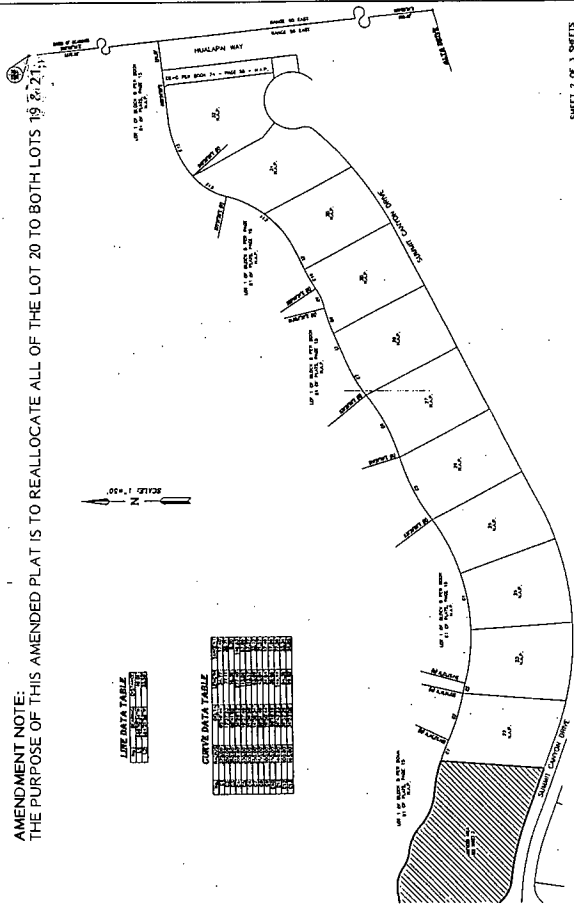 



# Alpha Engineering

50 S. Jones, Suite 202  
Las Vegas, NV 89107  
(702) 877-1300  
Fax: (702) 877-0300

RECEIVED  
MAY 18 2001  
LAND DEVELOPMENT

## Letter of Transmittal

↑  
NOT

To: Darlene Reeder *Planning & Zoning* From: Kelli Galagan  
Co.: City of Las Vegas Date: May 18, 2001  
Job Name: Star Canyon Our File #: 9149-12  
Ship Via Hand Deliver  
Address: *Received 2nd @ 11:00*

### ITEMS:

- 1 Dupe mylar of the recorded amended final map for street addresses
- 2 Bond copies of the recorded amended final map for street addresses
- 1 11 x 17 copy of the recorded amended final map for street addresses

### COMMENTS:

•

DATE RECEIVED	
TIME RECEIVED	
SIGNATURE	
PRINT NAME	

Return Transmittal to:

Kelli Galagan